



HATCH & COVER SECTION DETAIL
 TABLE FIG. 45
 VARDON RECOVERY SYSTEMS CO
 2820 N. ALAMEDA
 COMPTON, CALIF.



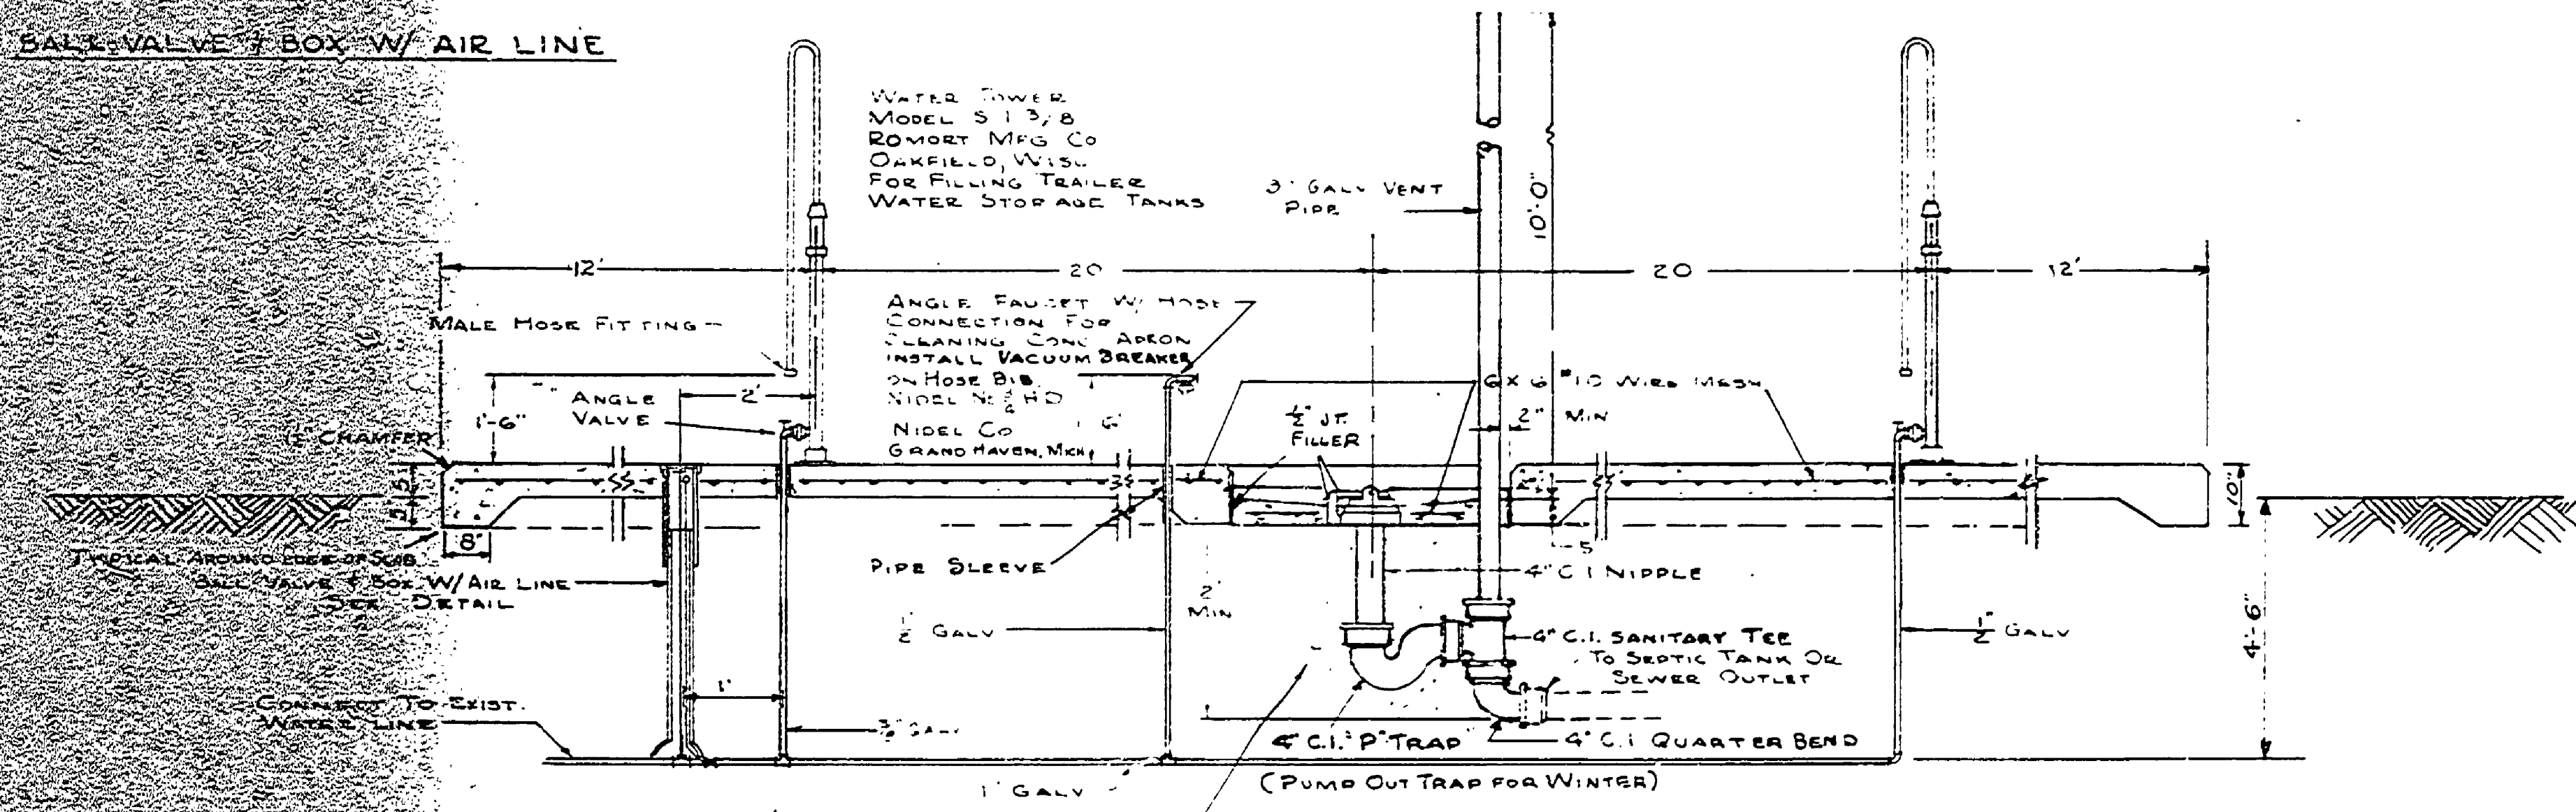


NOTE - CENTER 4' SQ AREA TO BE SAND FILL TO BOTTOM OF SEWER PIPE 12\"/>

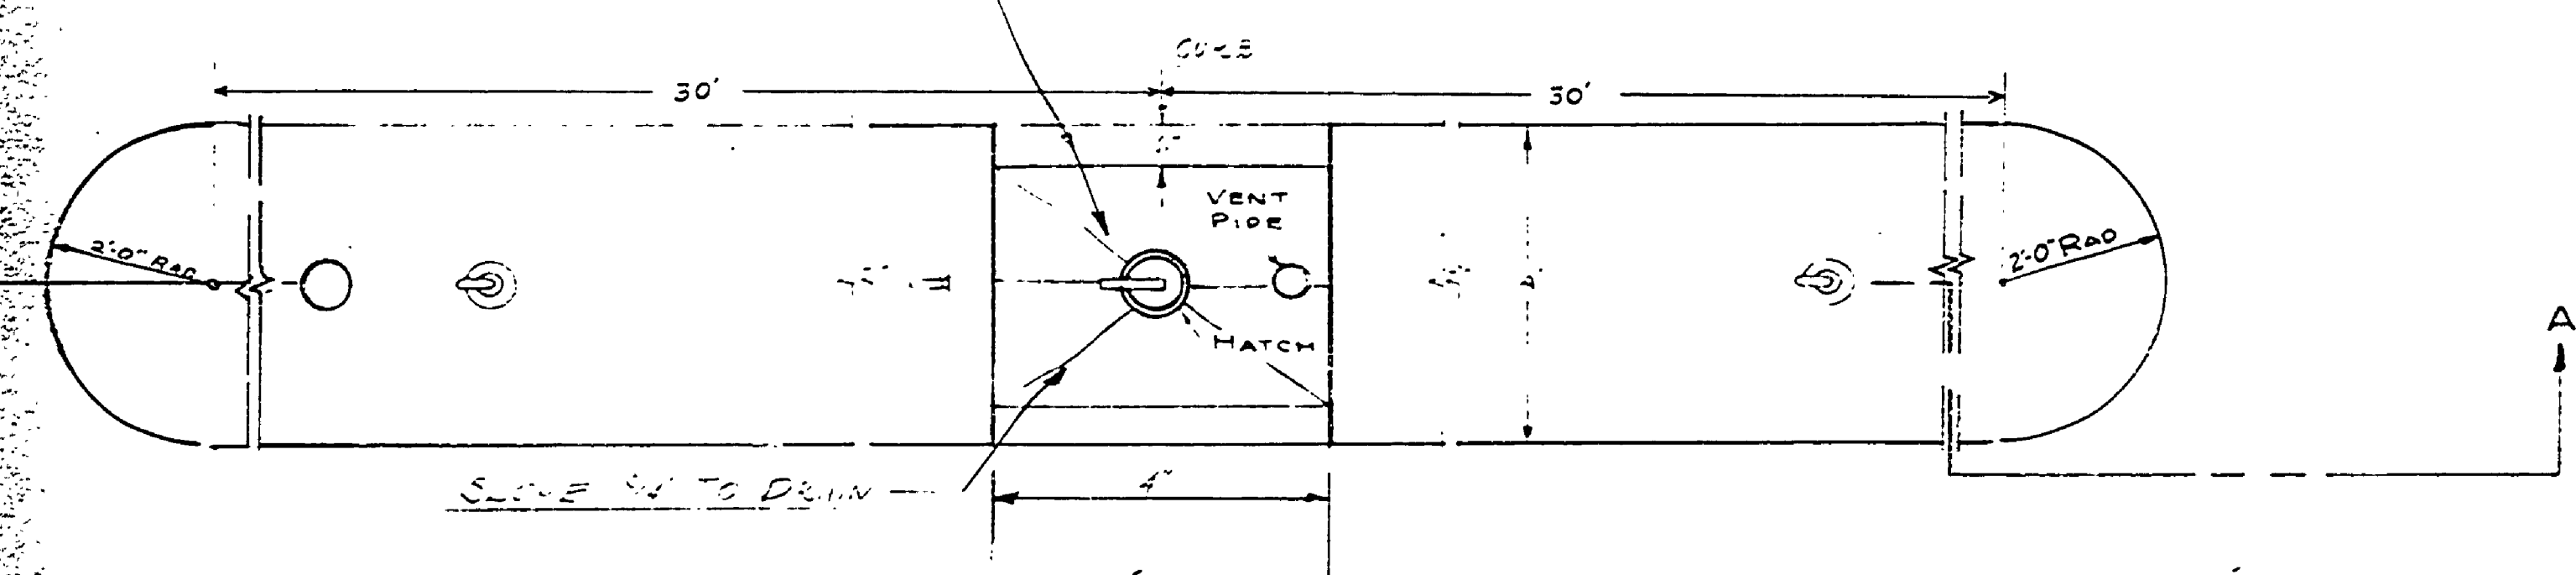

PLAN
WATER SUPPLY AND SEWAGE DISPOSAL ISLAND
 SCALE 1" = 2'

TYP SECTION

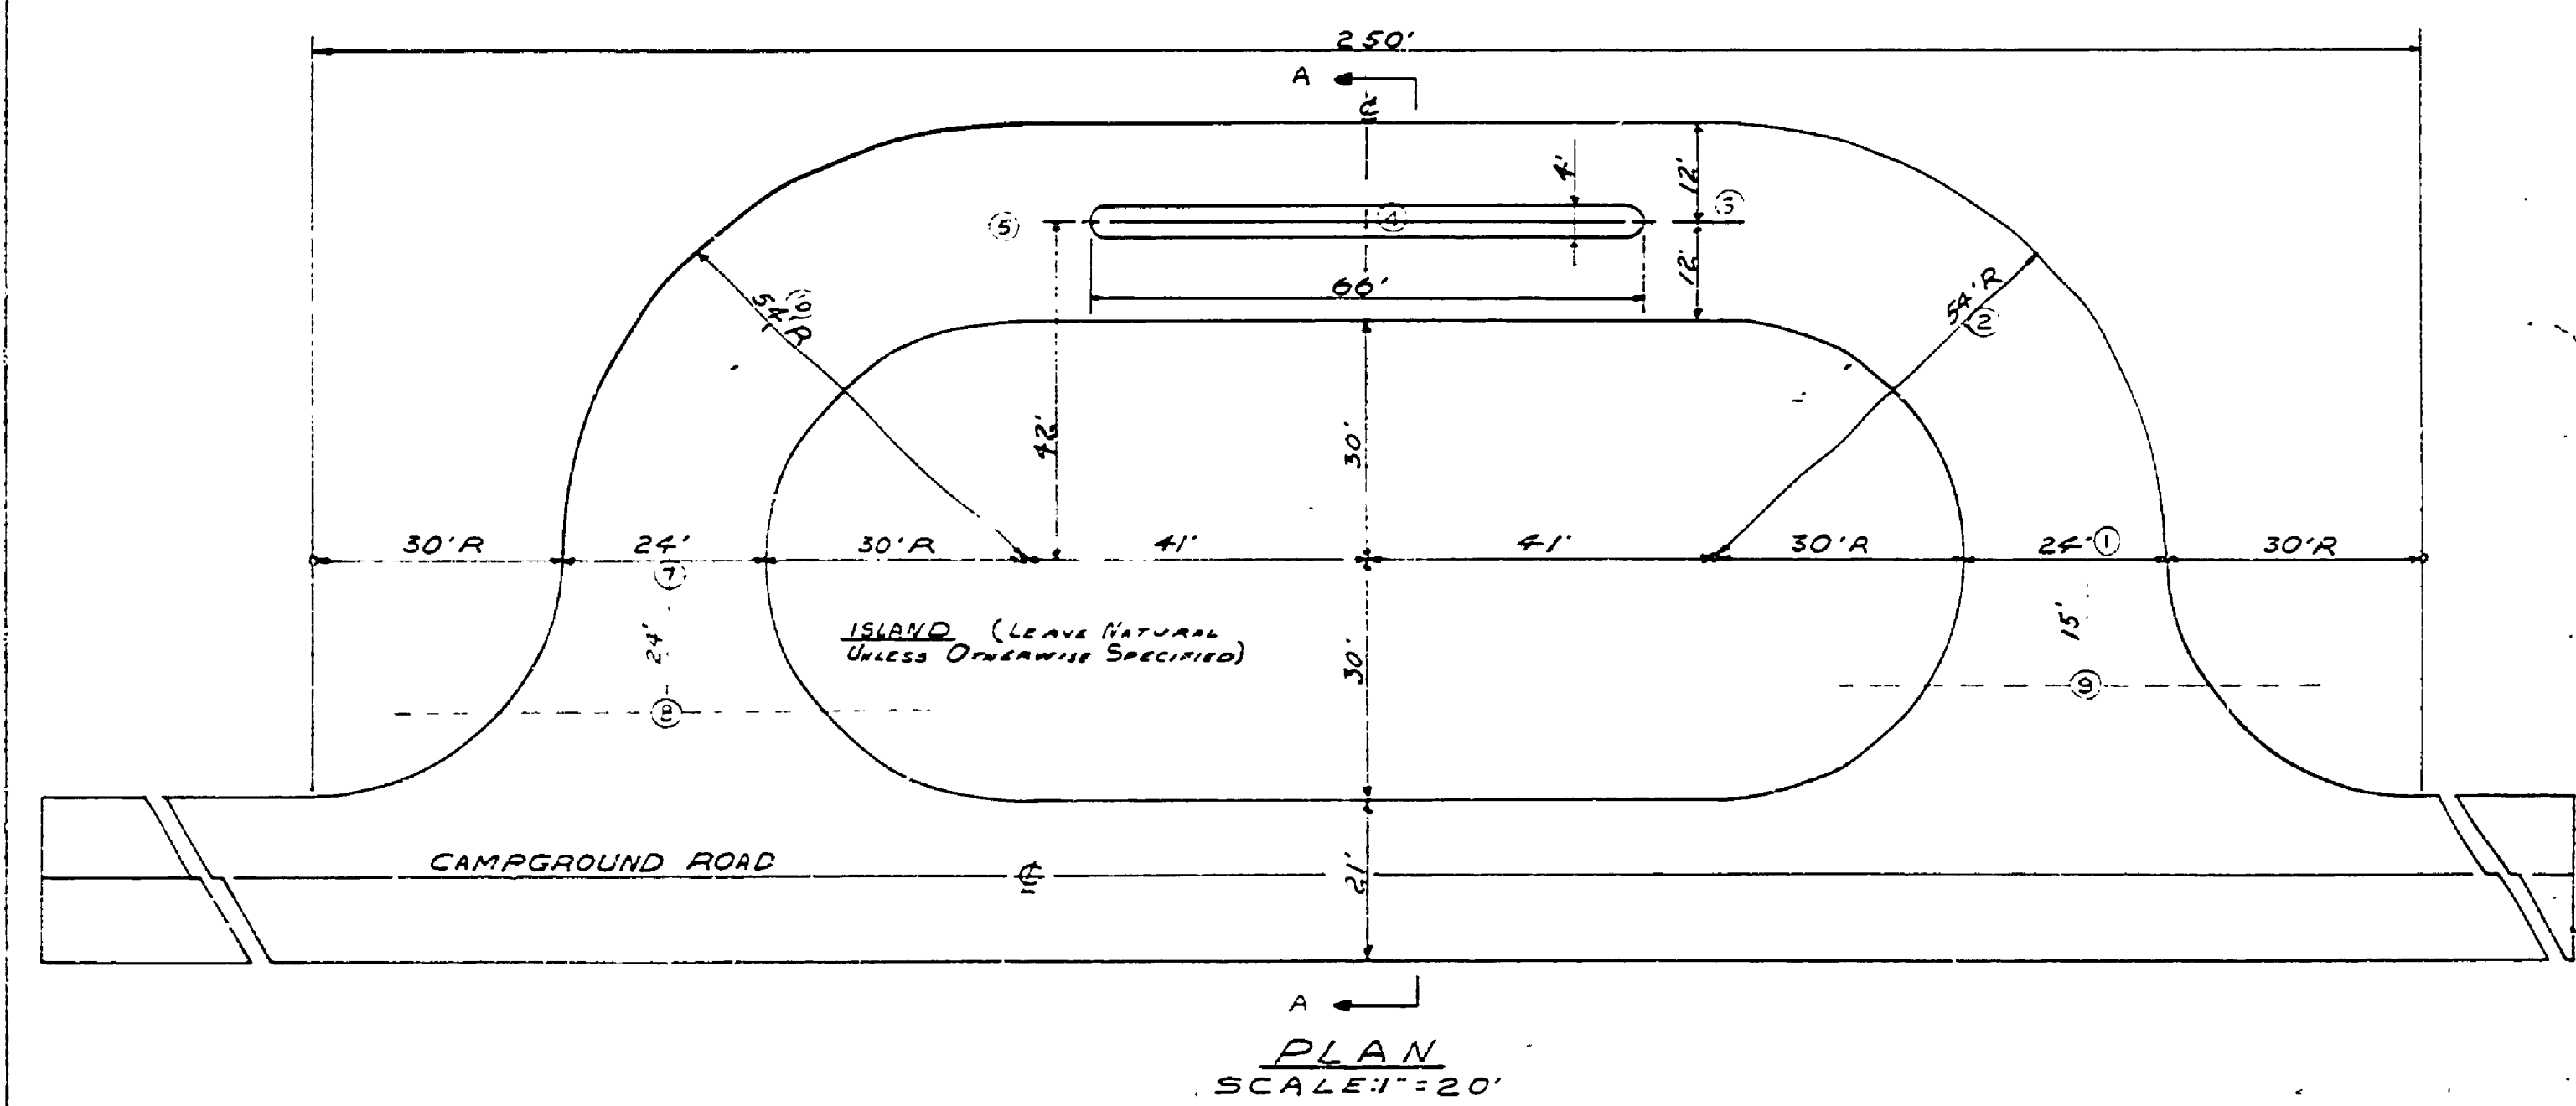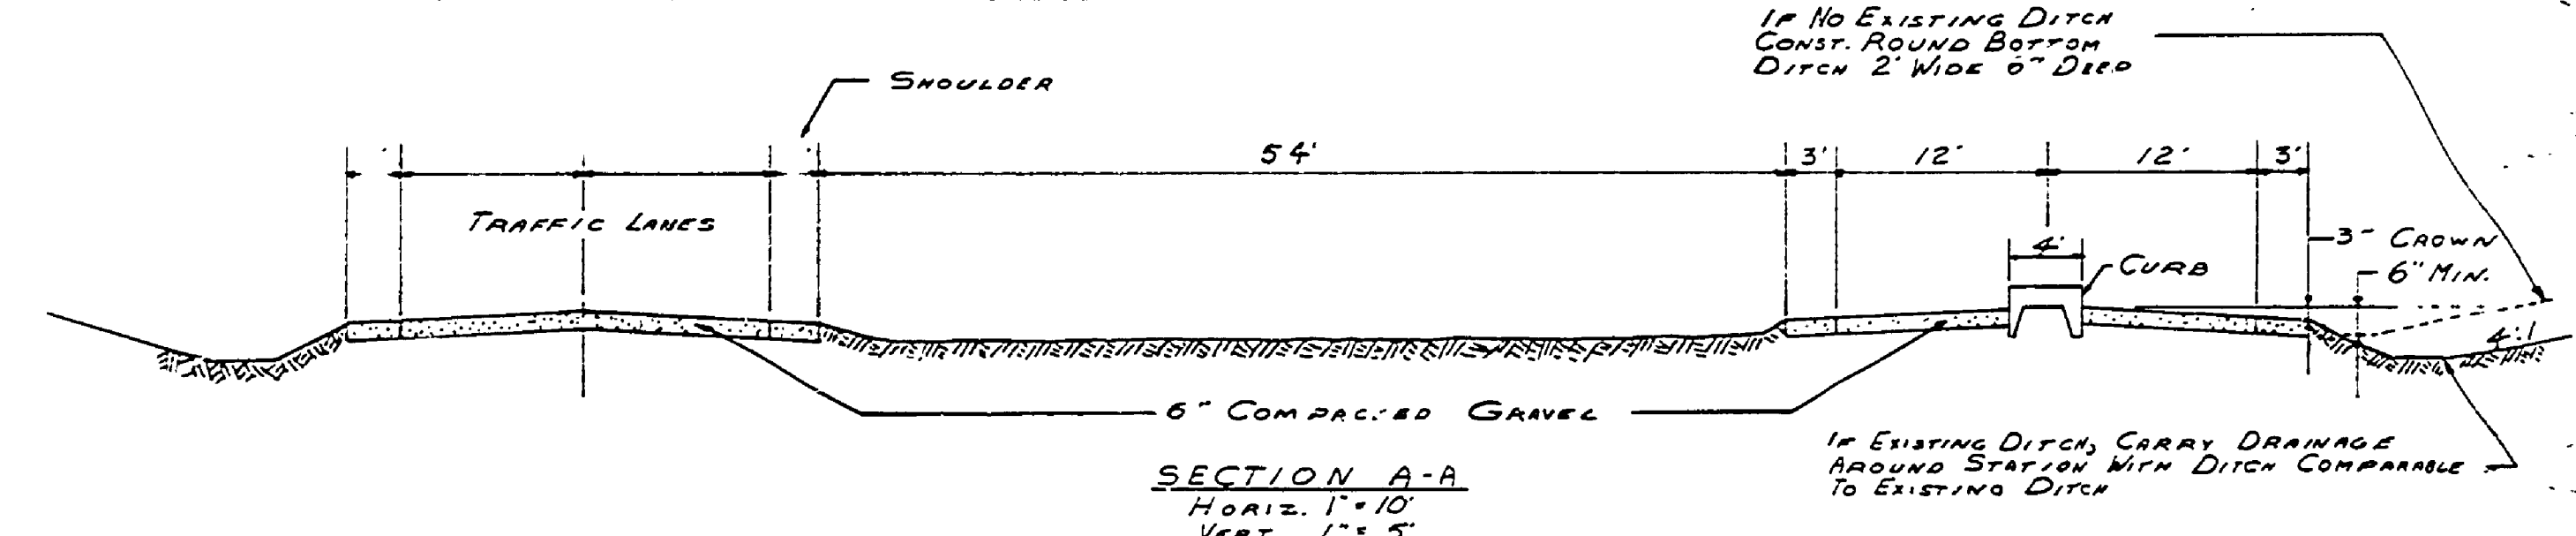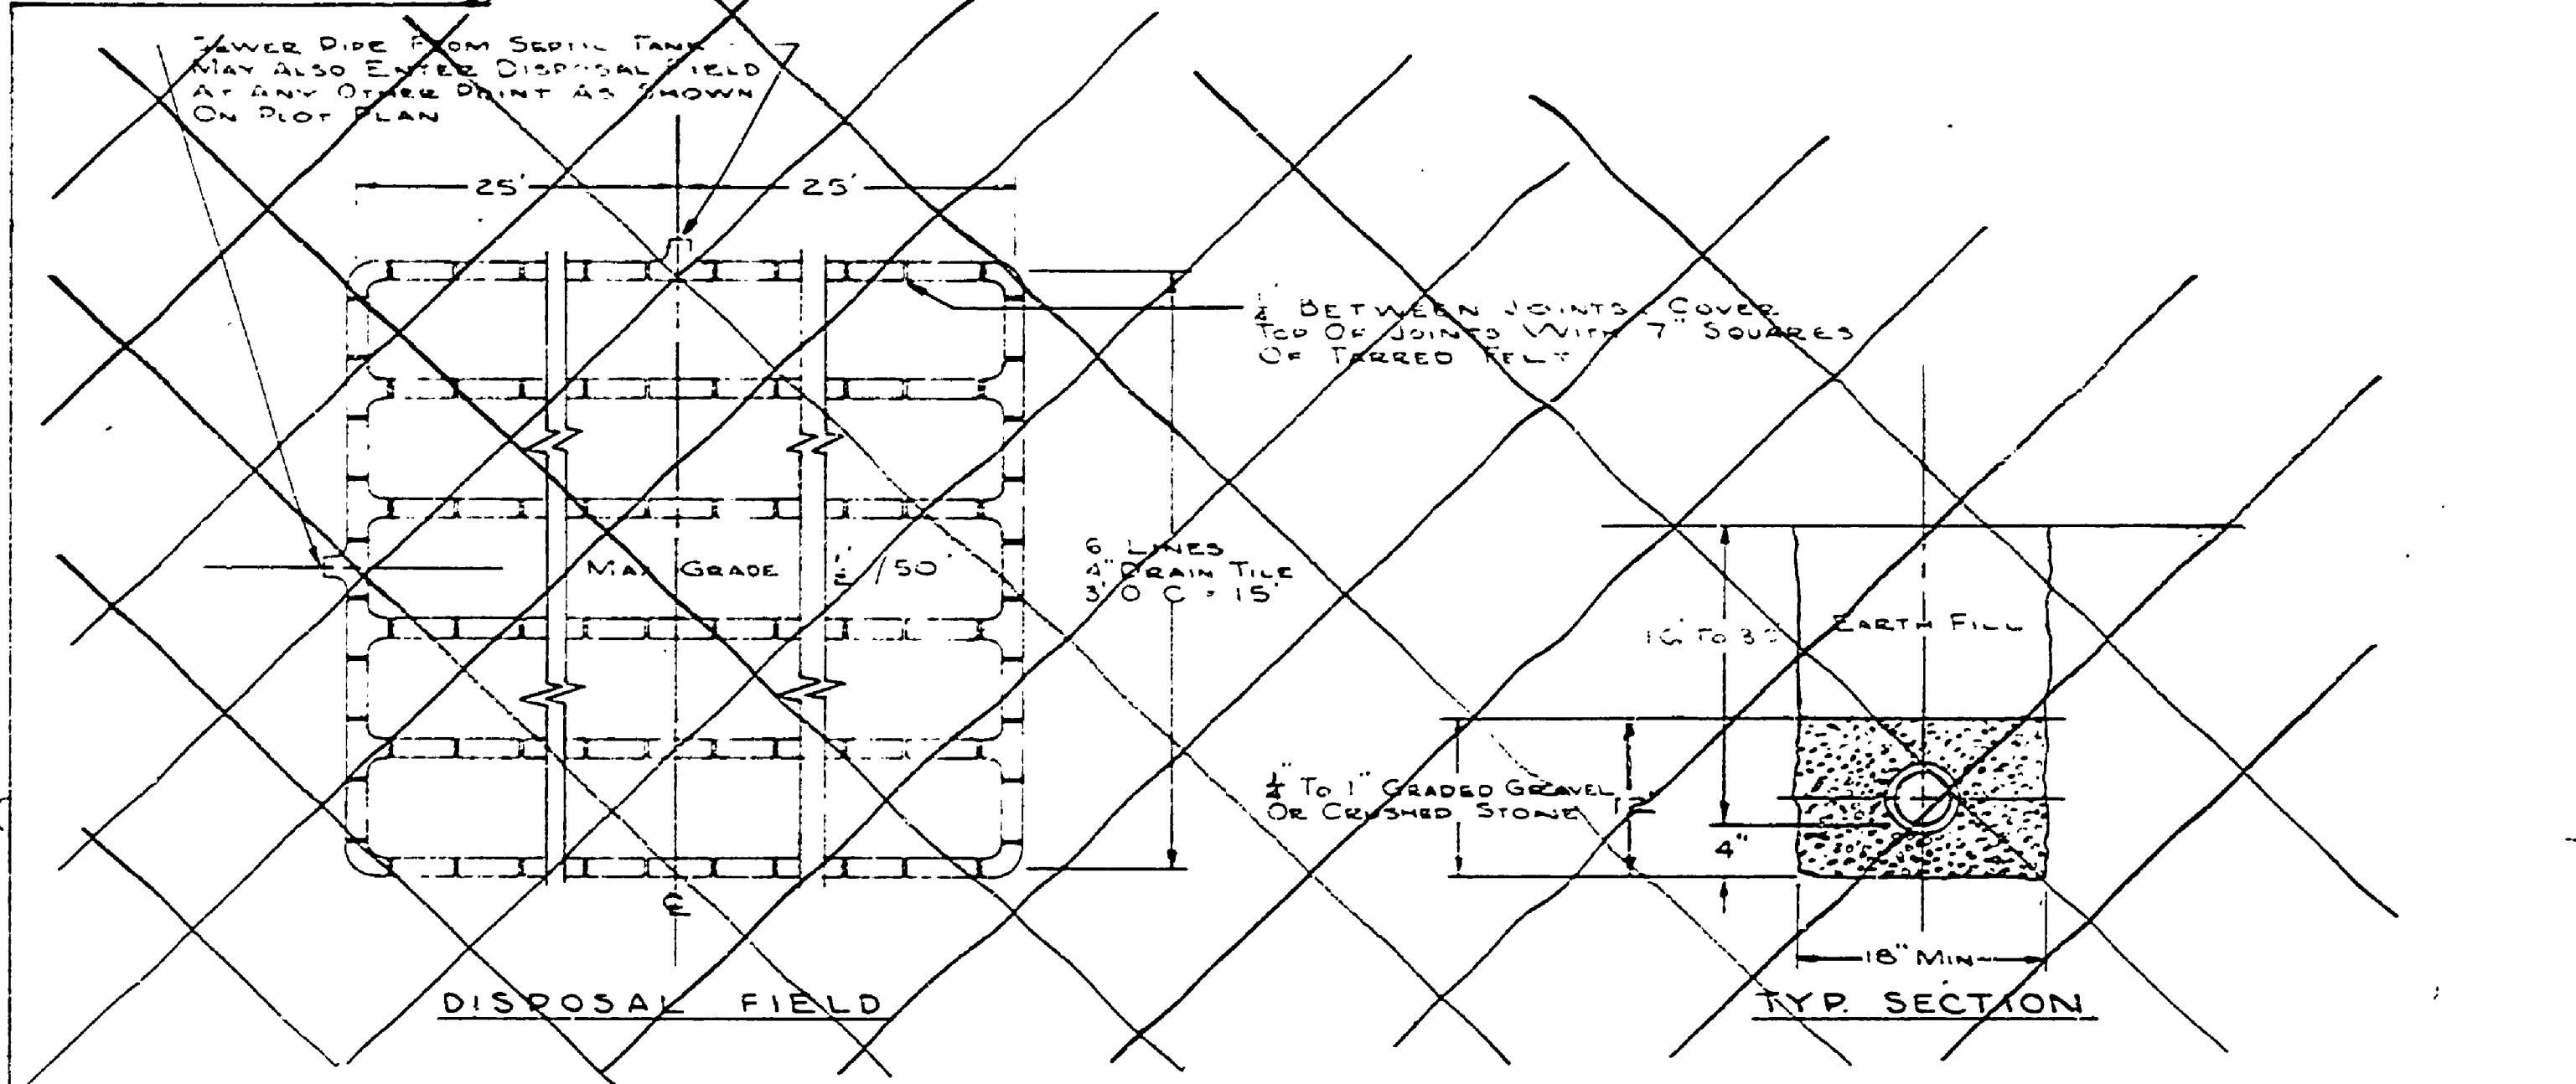

PLAN
 SCALE 1" = 20'

DESIGNED BY	CHECKED BY	DATE	NO. DATE BY REVISIONS	NO. DATE BY REVISIONS	MICHIGAN DEPARTMENT OF CONSERVATION	SANITATION STATION	SHEET NO. 4 OF 5	NORTH HIGGINS LAKE STATE PARK
			1. 5/25/51 J.V. REVISED & REDRAWN	3. JUNE 60 W.H.E. VENT PIPE, VACUUM BREAKER			FOR PROJECT NO. 24-1578	SHEET 4 OF 5 PLAN NO. E-107
			2. 11/18/51 J.V. ADAPTER, BALL VALVE, W/ PERMANENT	4. 5/29/68 W.S. REDESIGN OF STATION PLAN				
				5. 8/30/72 J.E. AS BUILT				