

DRAWN BY: V. C. [Signature]  
 TRACED BY: [Signature]  
 CHECKED BY: J.P.R.  
 DATE: 9-14-60

REVIEWED BY SECTIONS: ARCHITECTURAL, ENGINEERING, LANDSCAPE  
 DATE: 9-14-60, 9-14-60, 9-14-60  
 APPROVED BY: [Signature]  
 ASSISTANT CHIEF IN CHARGE  
 DATE: 23.8.62

PLATE NO.	SHEET NO.	DESCRIPTION	BLDG. NO.
1	5	IN. TEX. WATER & SEWAGE	ALL
2	5	TOILET, LAUNDRY & SHOWER	5
3	5	TOILET	7
4	5	TOILET, LAUNDRY & SHOWER	11
5	5	RESIDENCE, WORKSHOP & GARAGE	1-3 & 9
6	5	SHELTER	6
7	6	BATHHOUSE	5
8	6	WEST CAMPGROUND D. F.	
9	6	EAST CAMPGROUND D. FOUNTAINS	

INDIAN LAKE STATE PARK

SCALE - AS SHOWN

MICHIGAN DEPARTMENT OF CONSERVATION  
 PARKS AND RECREATION DIVISION

INDIAN LAKE STATE PARK  
 UTILITY MAP  
 WATER & SEWAGE SYSTEM

SHEET NO. 5 OF 6

PLAN NO. U-1

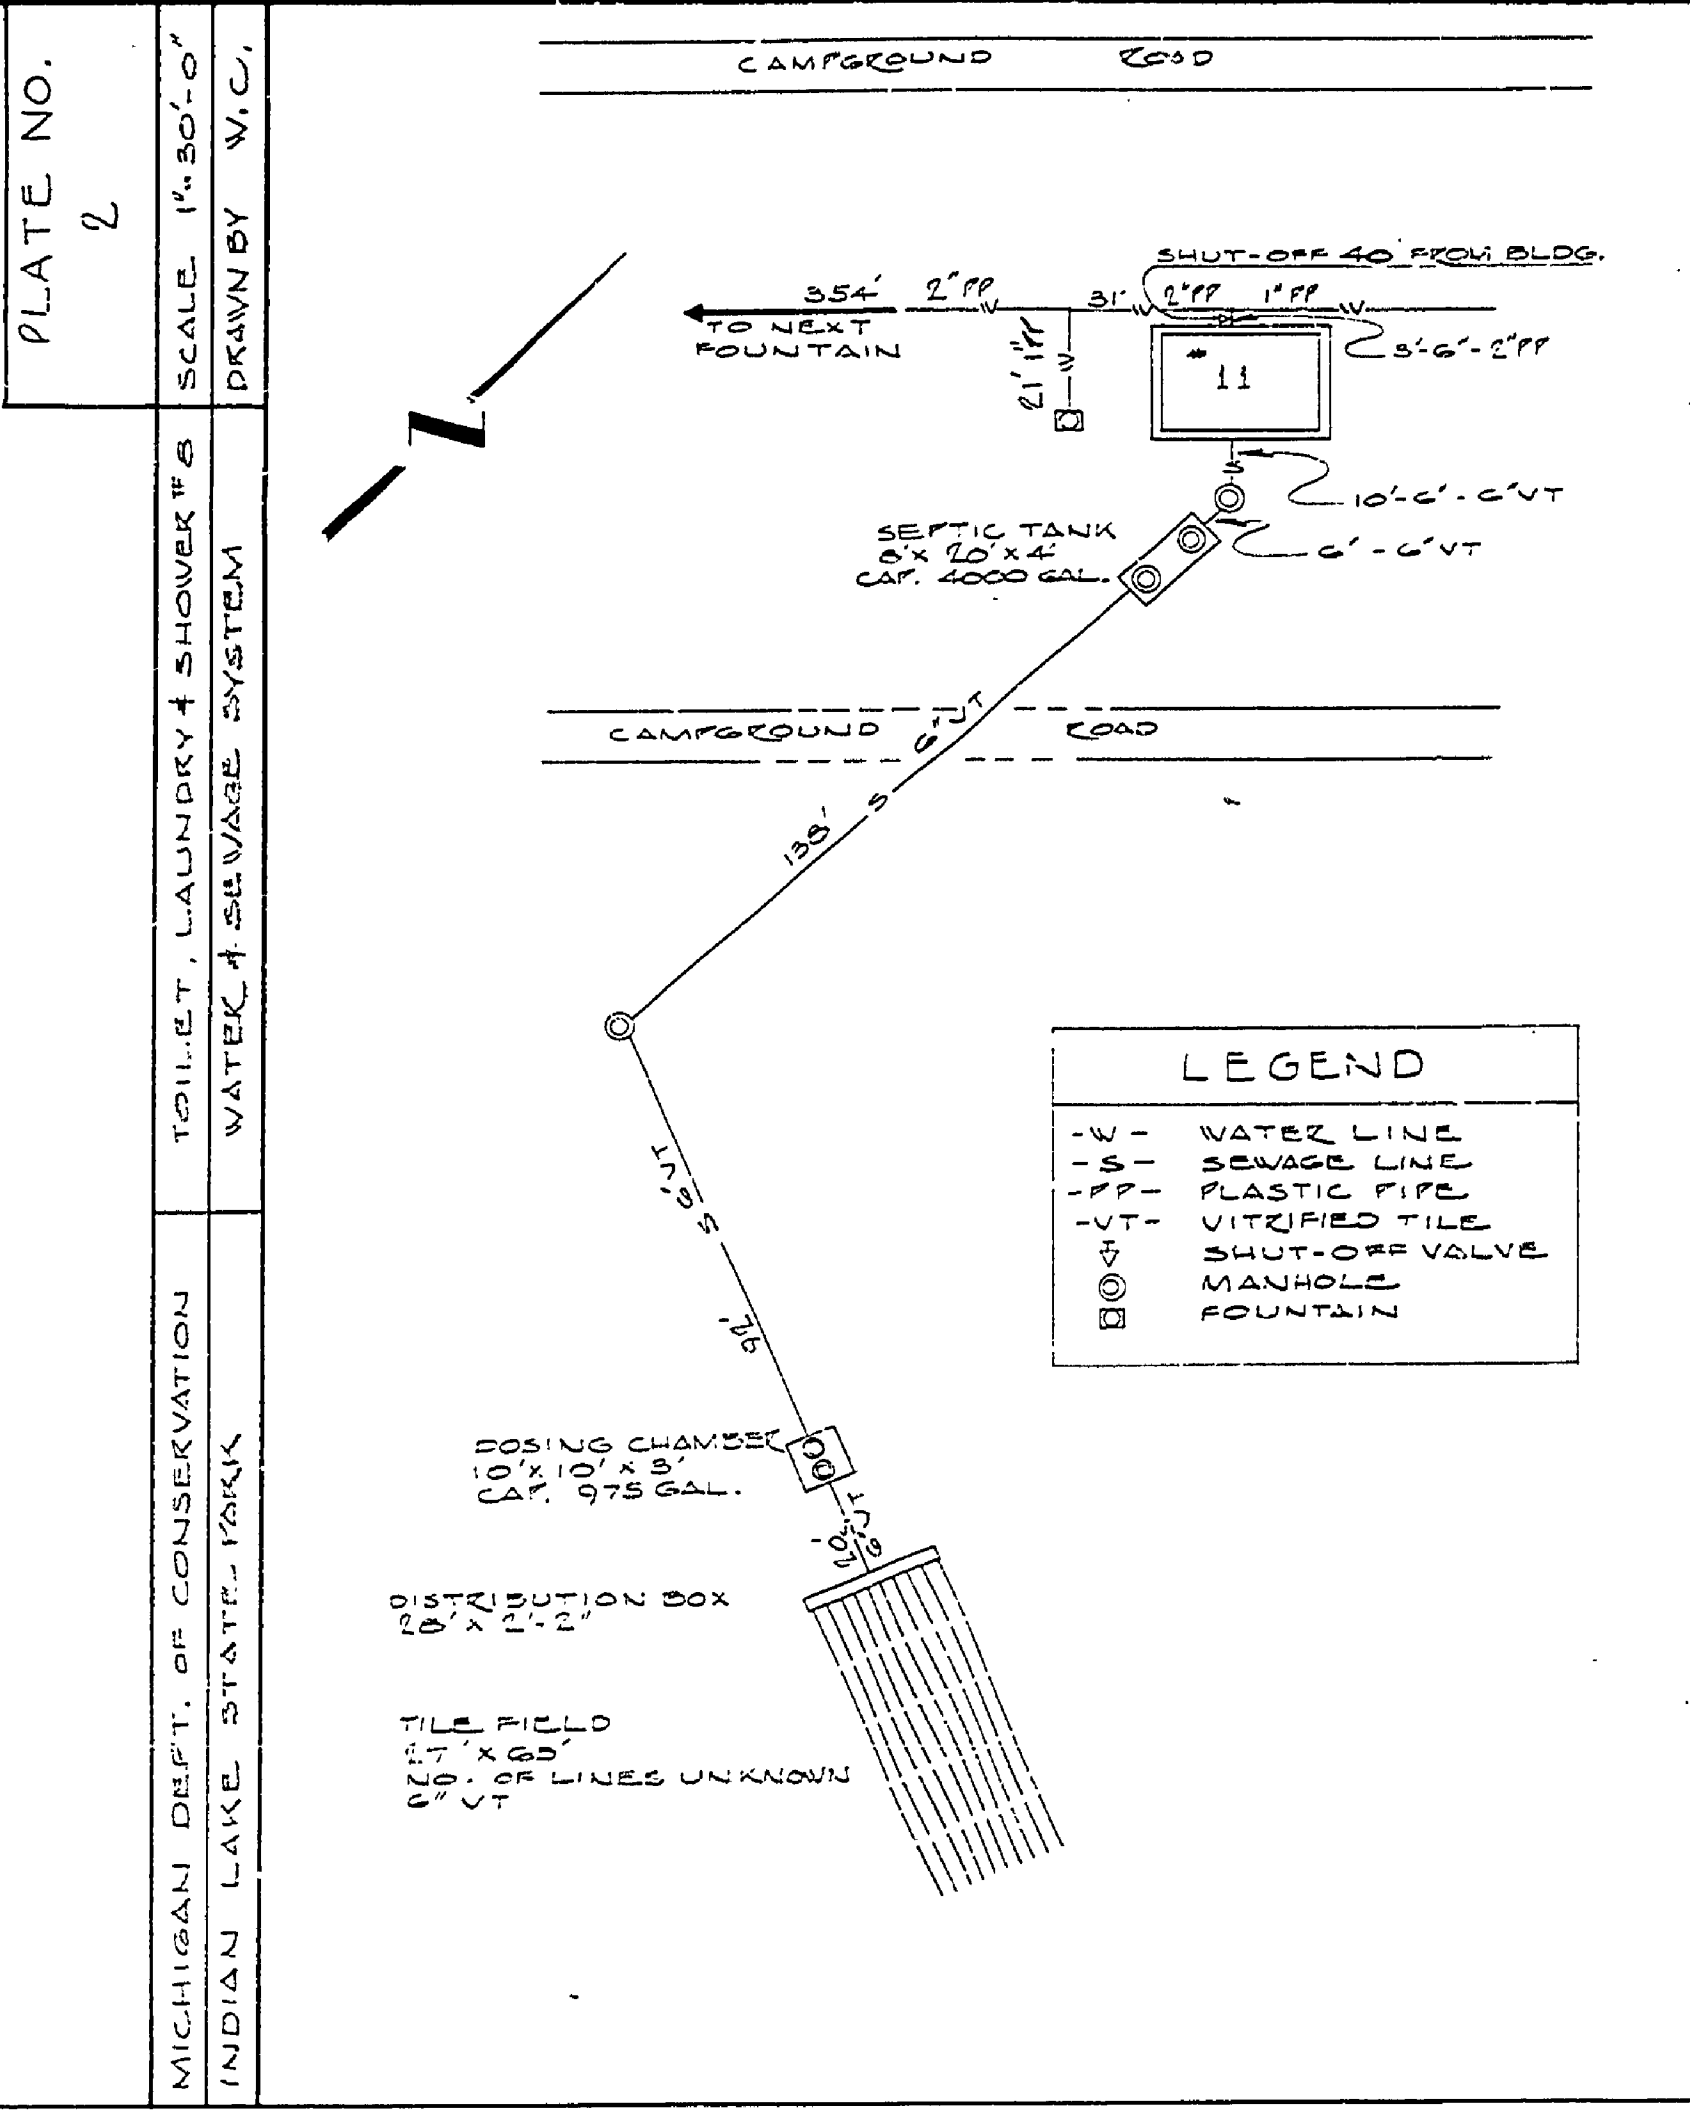
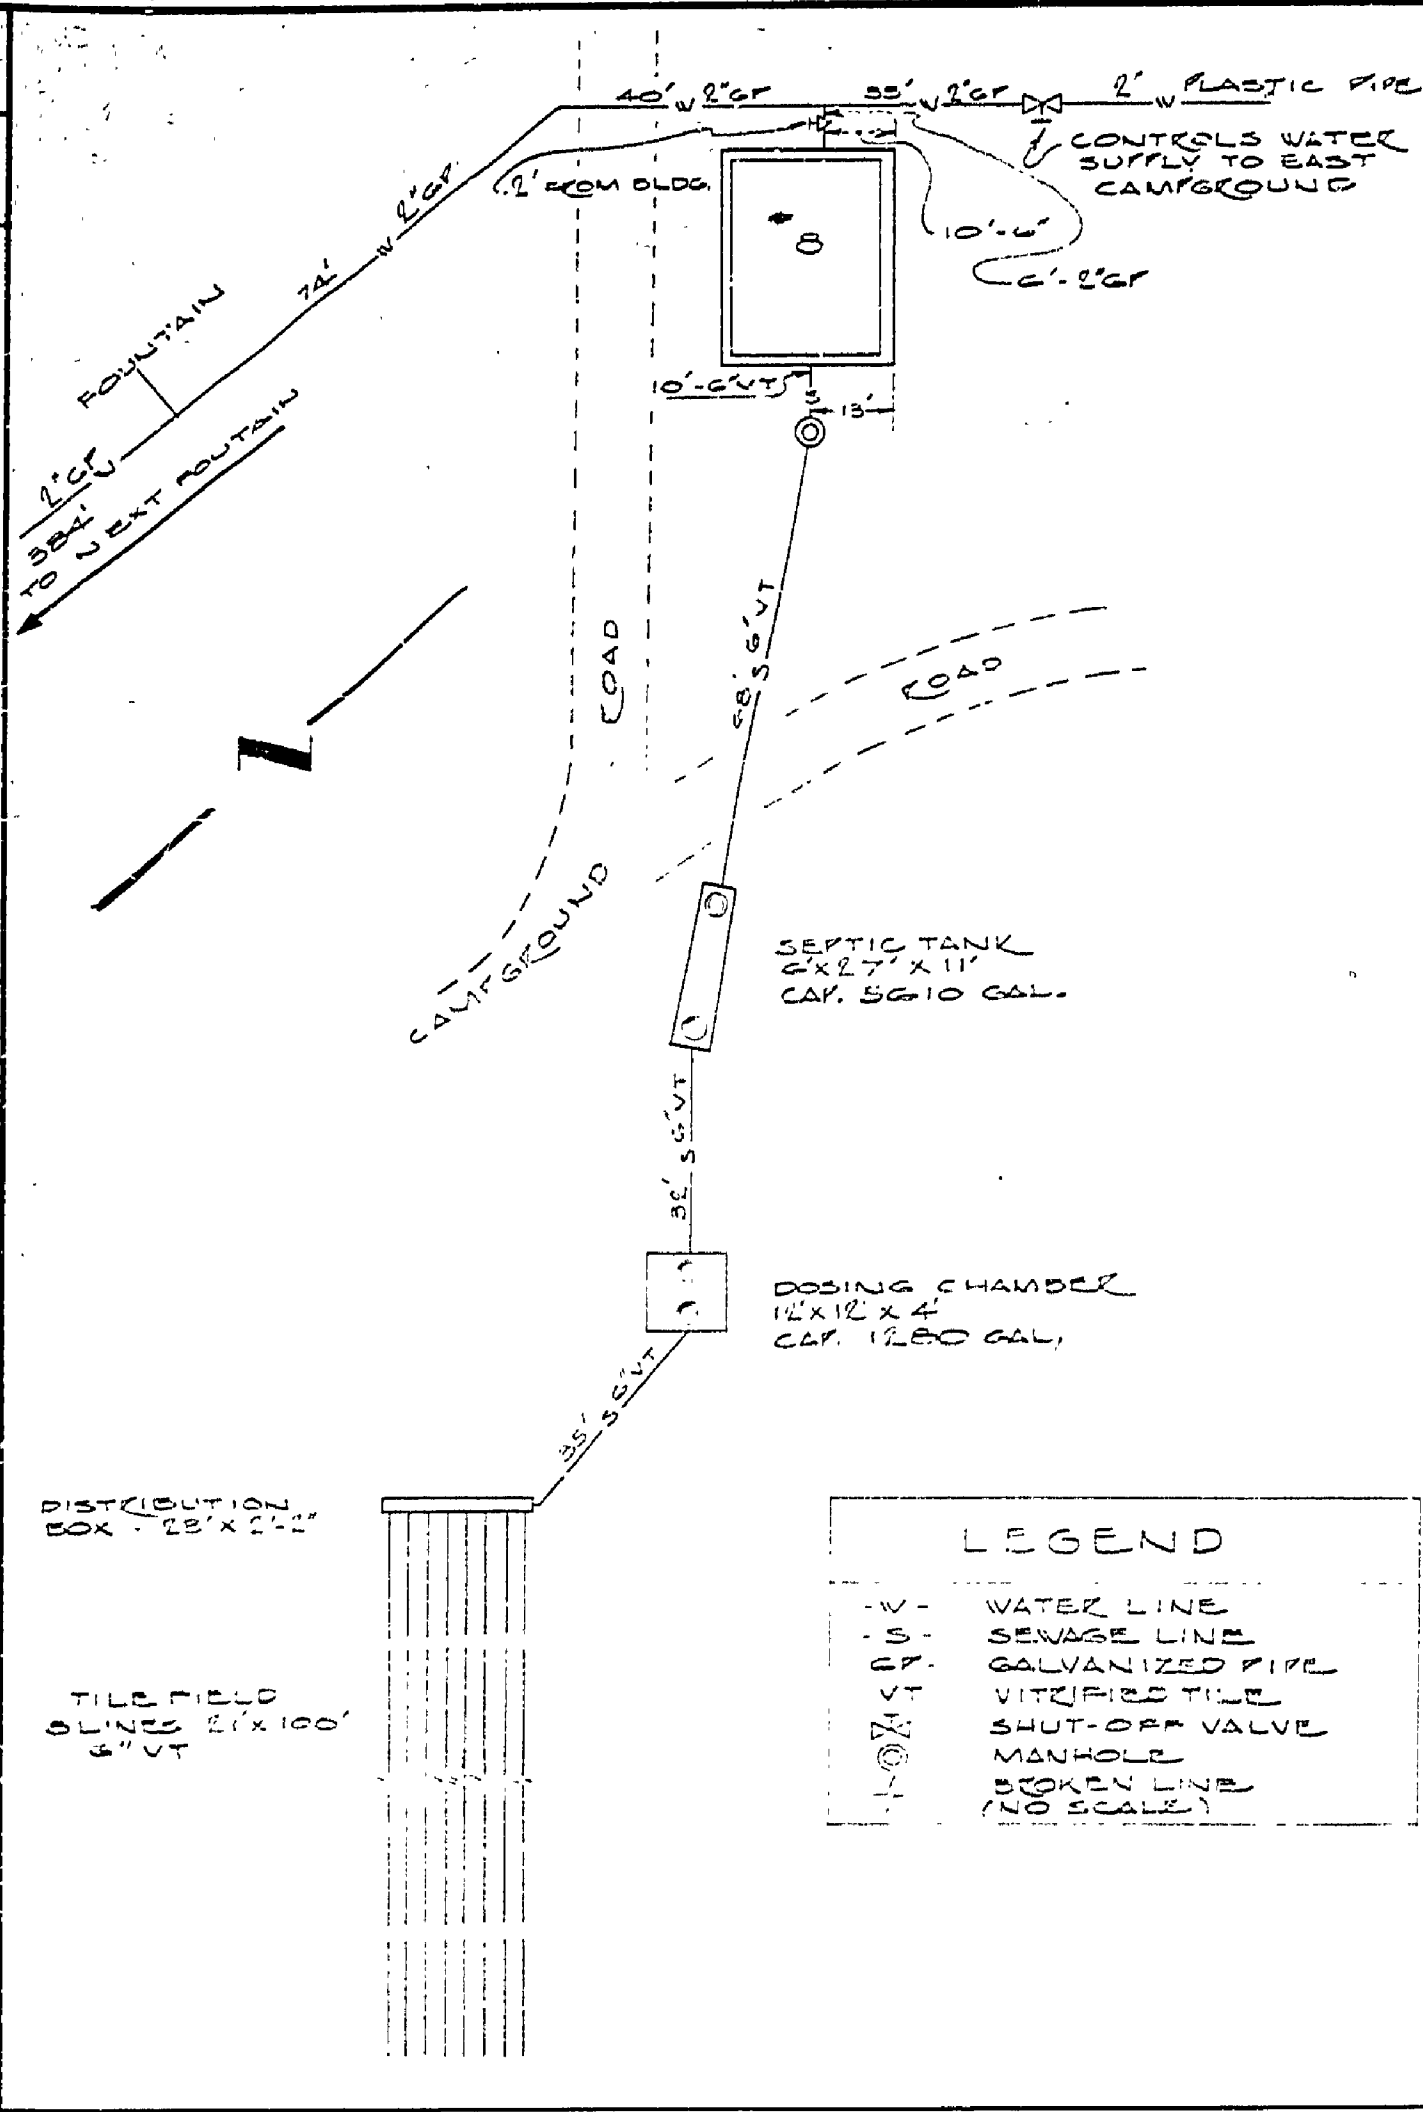


PLATE NO. 4  
 SCALE 1"=40'-0"  
 DRAWN BY V.C.

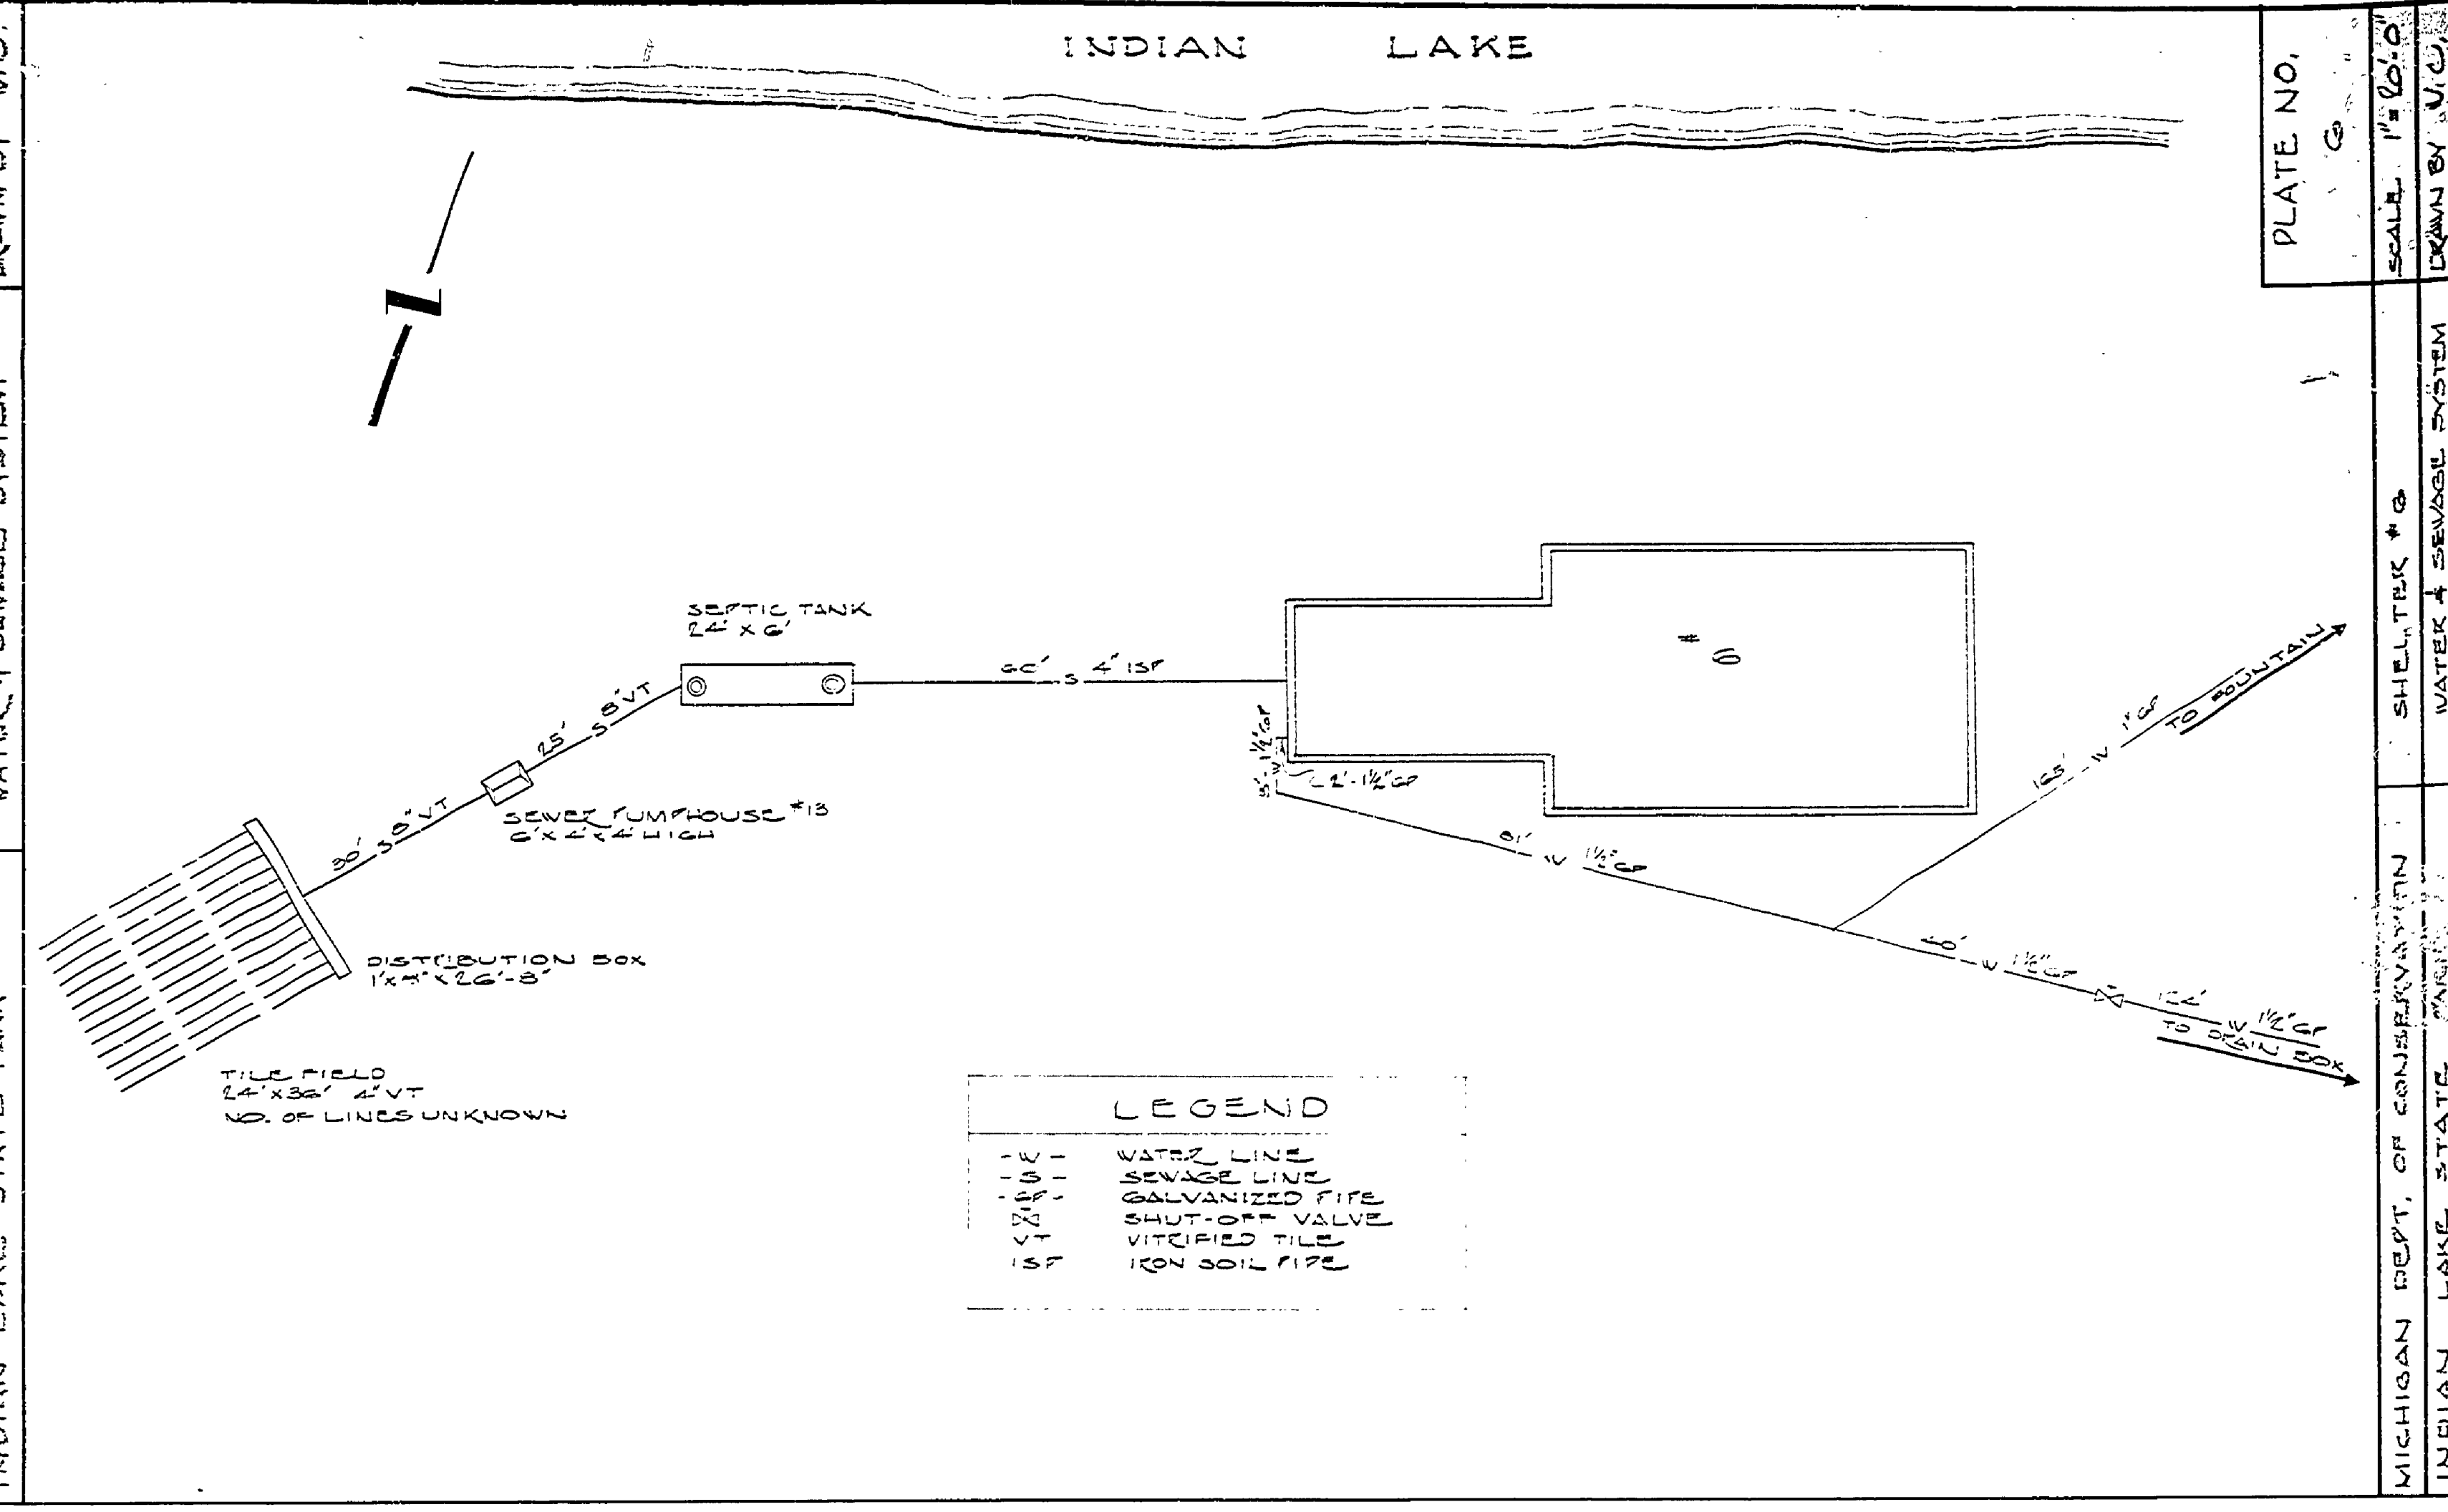


PLATE NO. 6  
 SCALE 1"=20'-0"  
 DRAWN BY V.C.

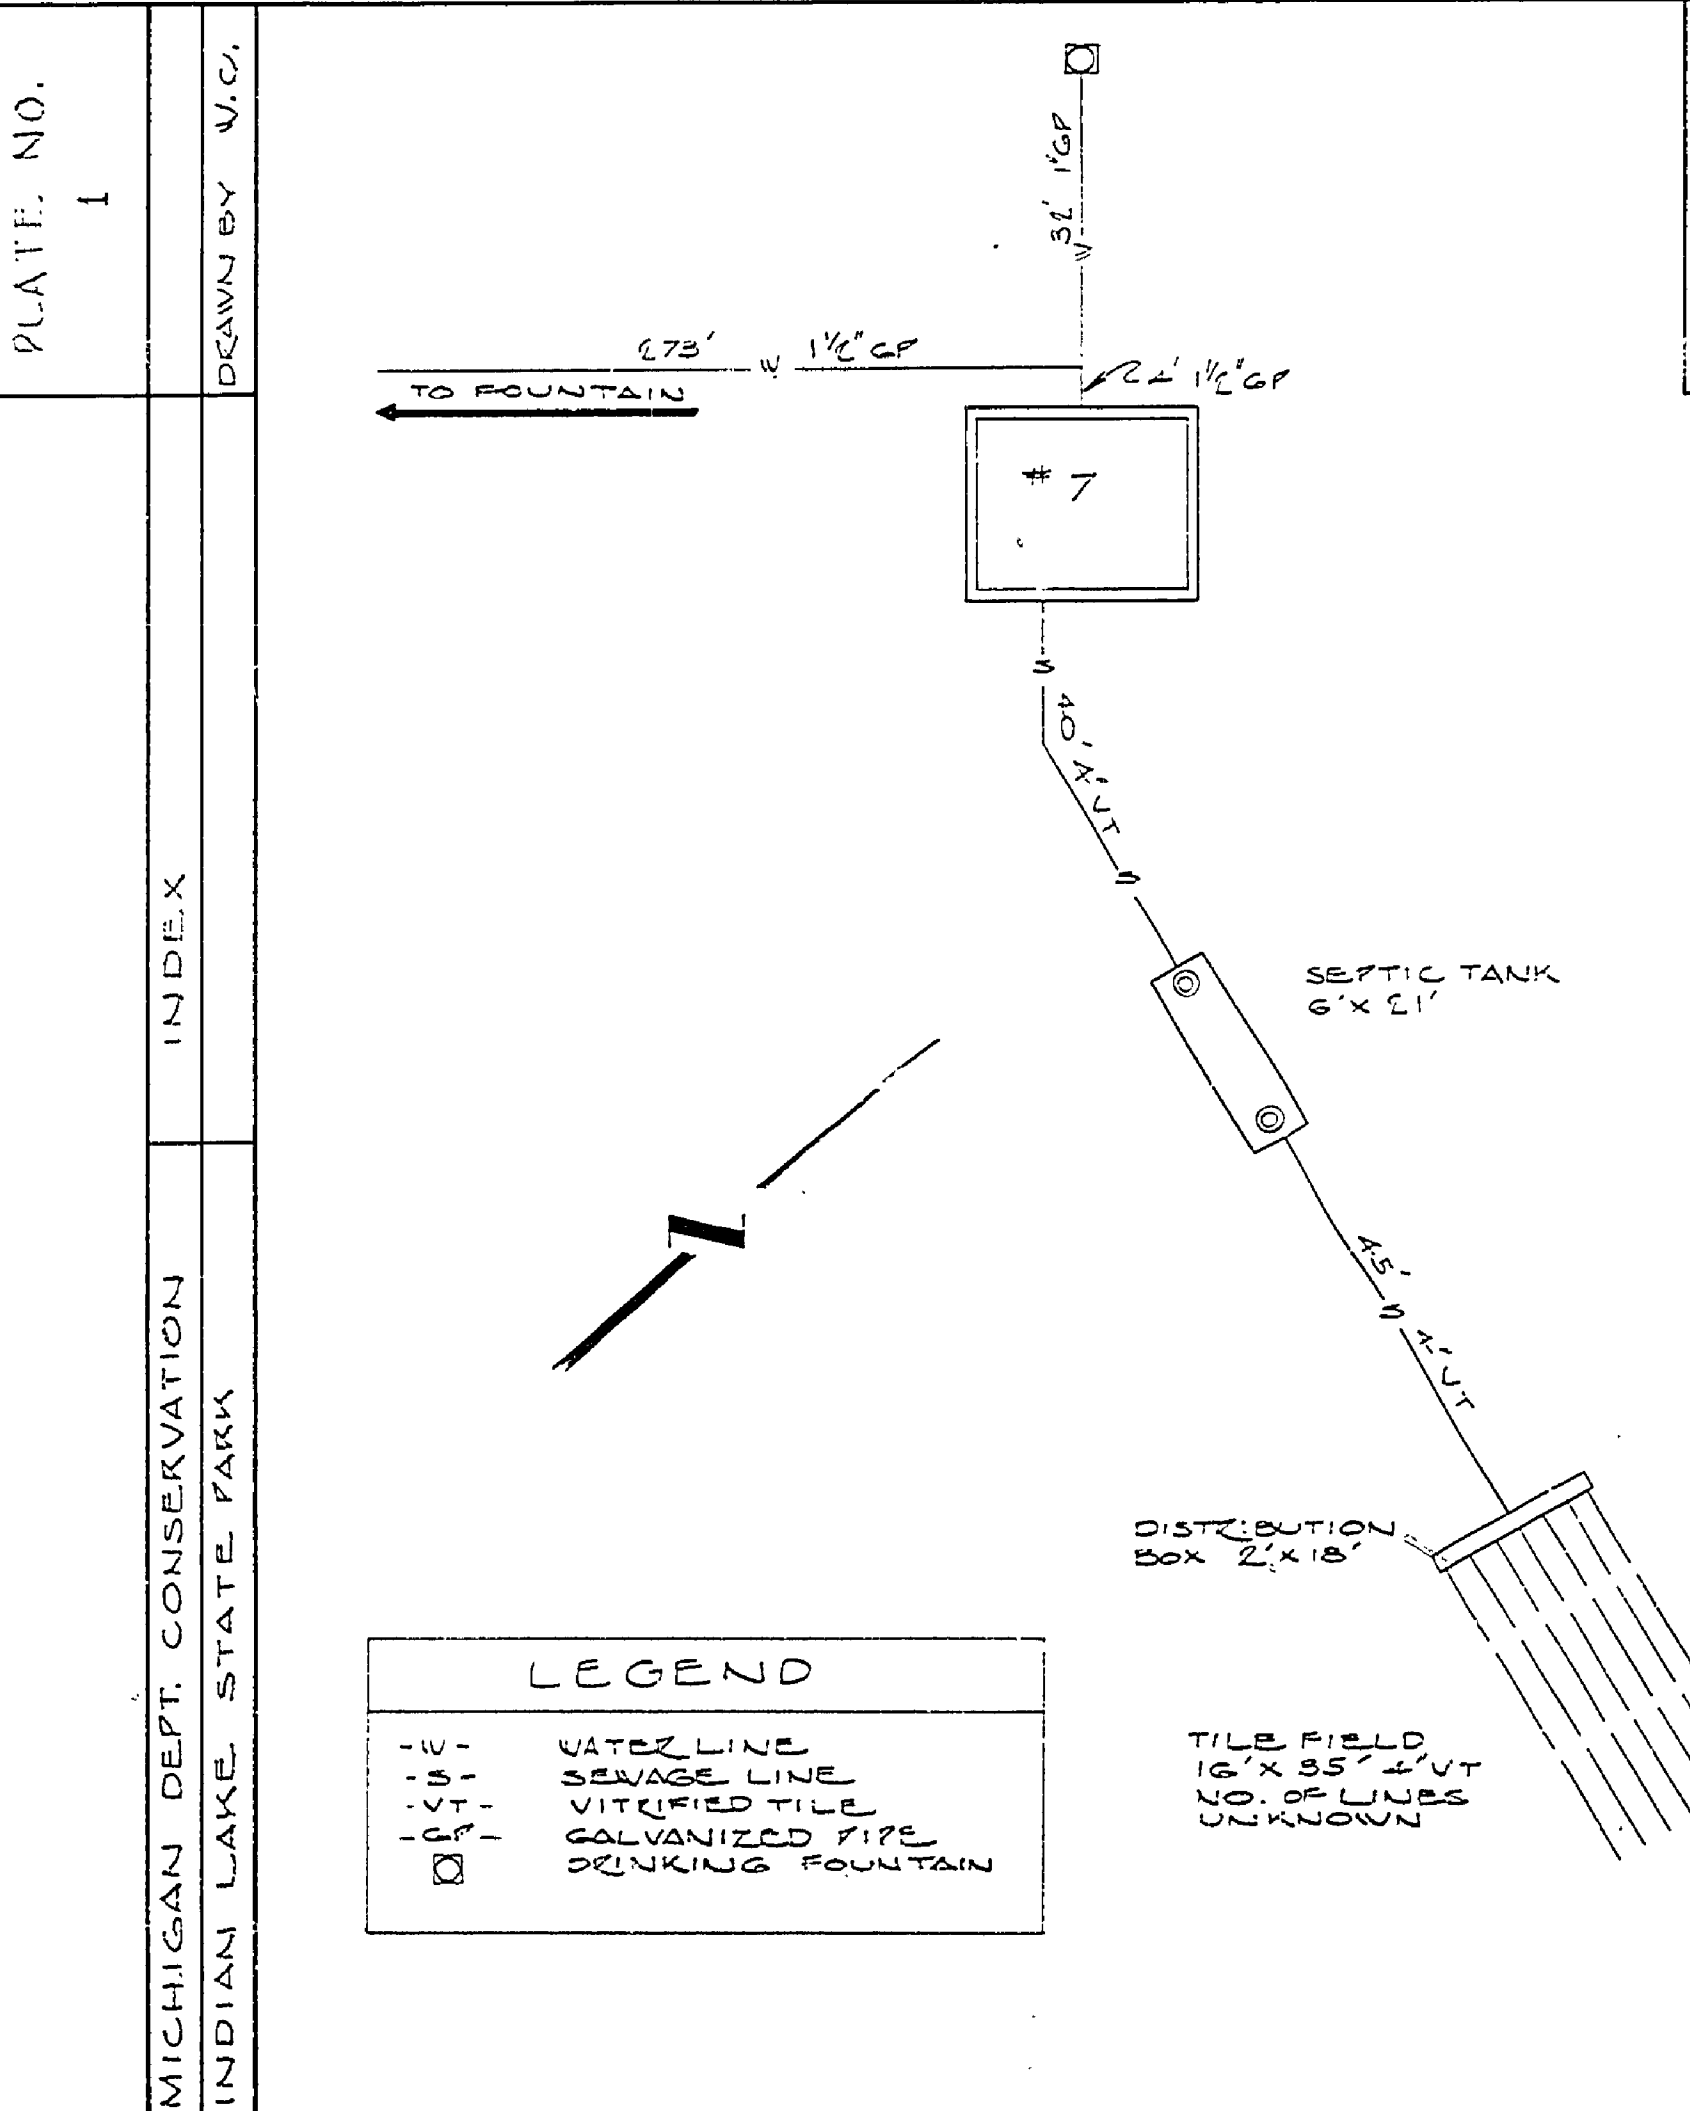


PLATE NO. 3  
 SCALE 1"=20'-0"  
 DRAWN BY V.C.

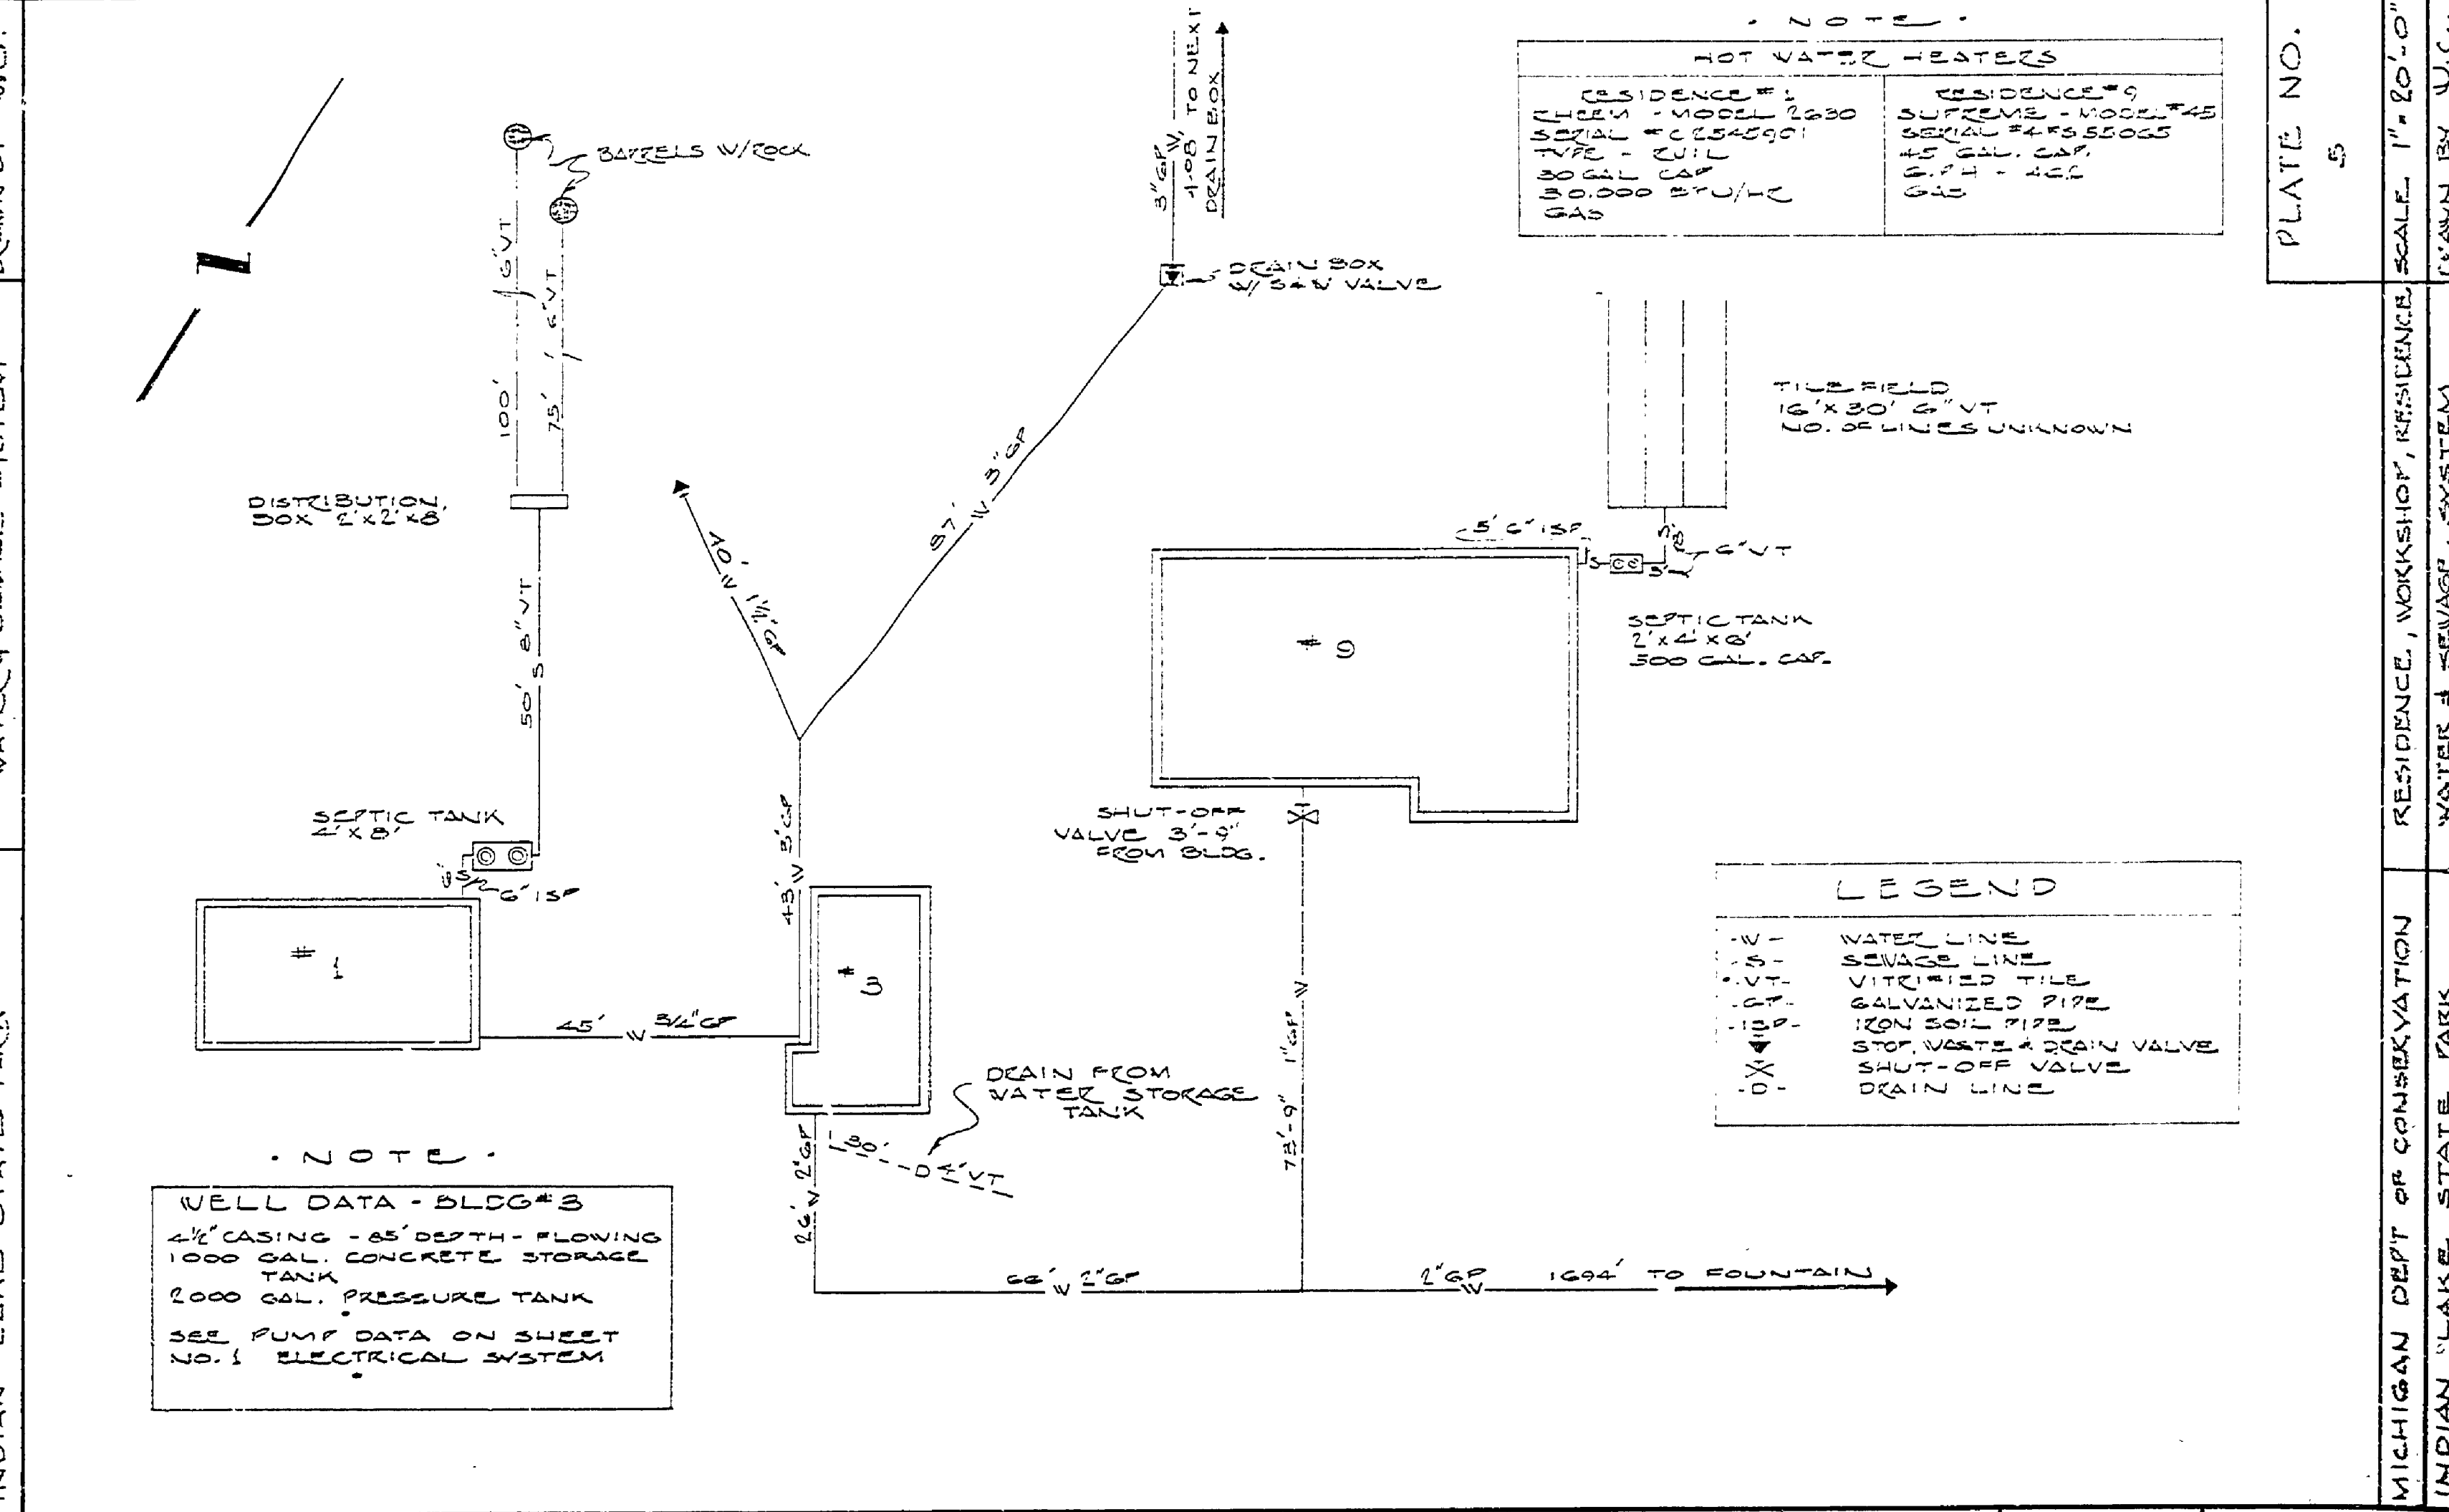


PLATE NO. 5  
 SCALE 1"=20'-0"  
 DRAWN BY V.C.