



FLOOR PLAN
Scale: 1/4" = 1'-0"

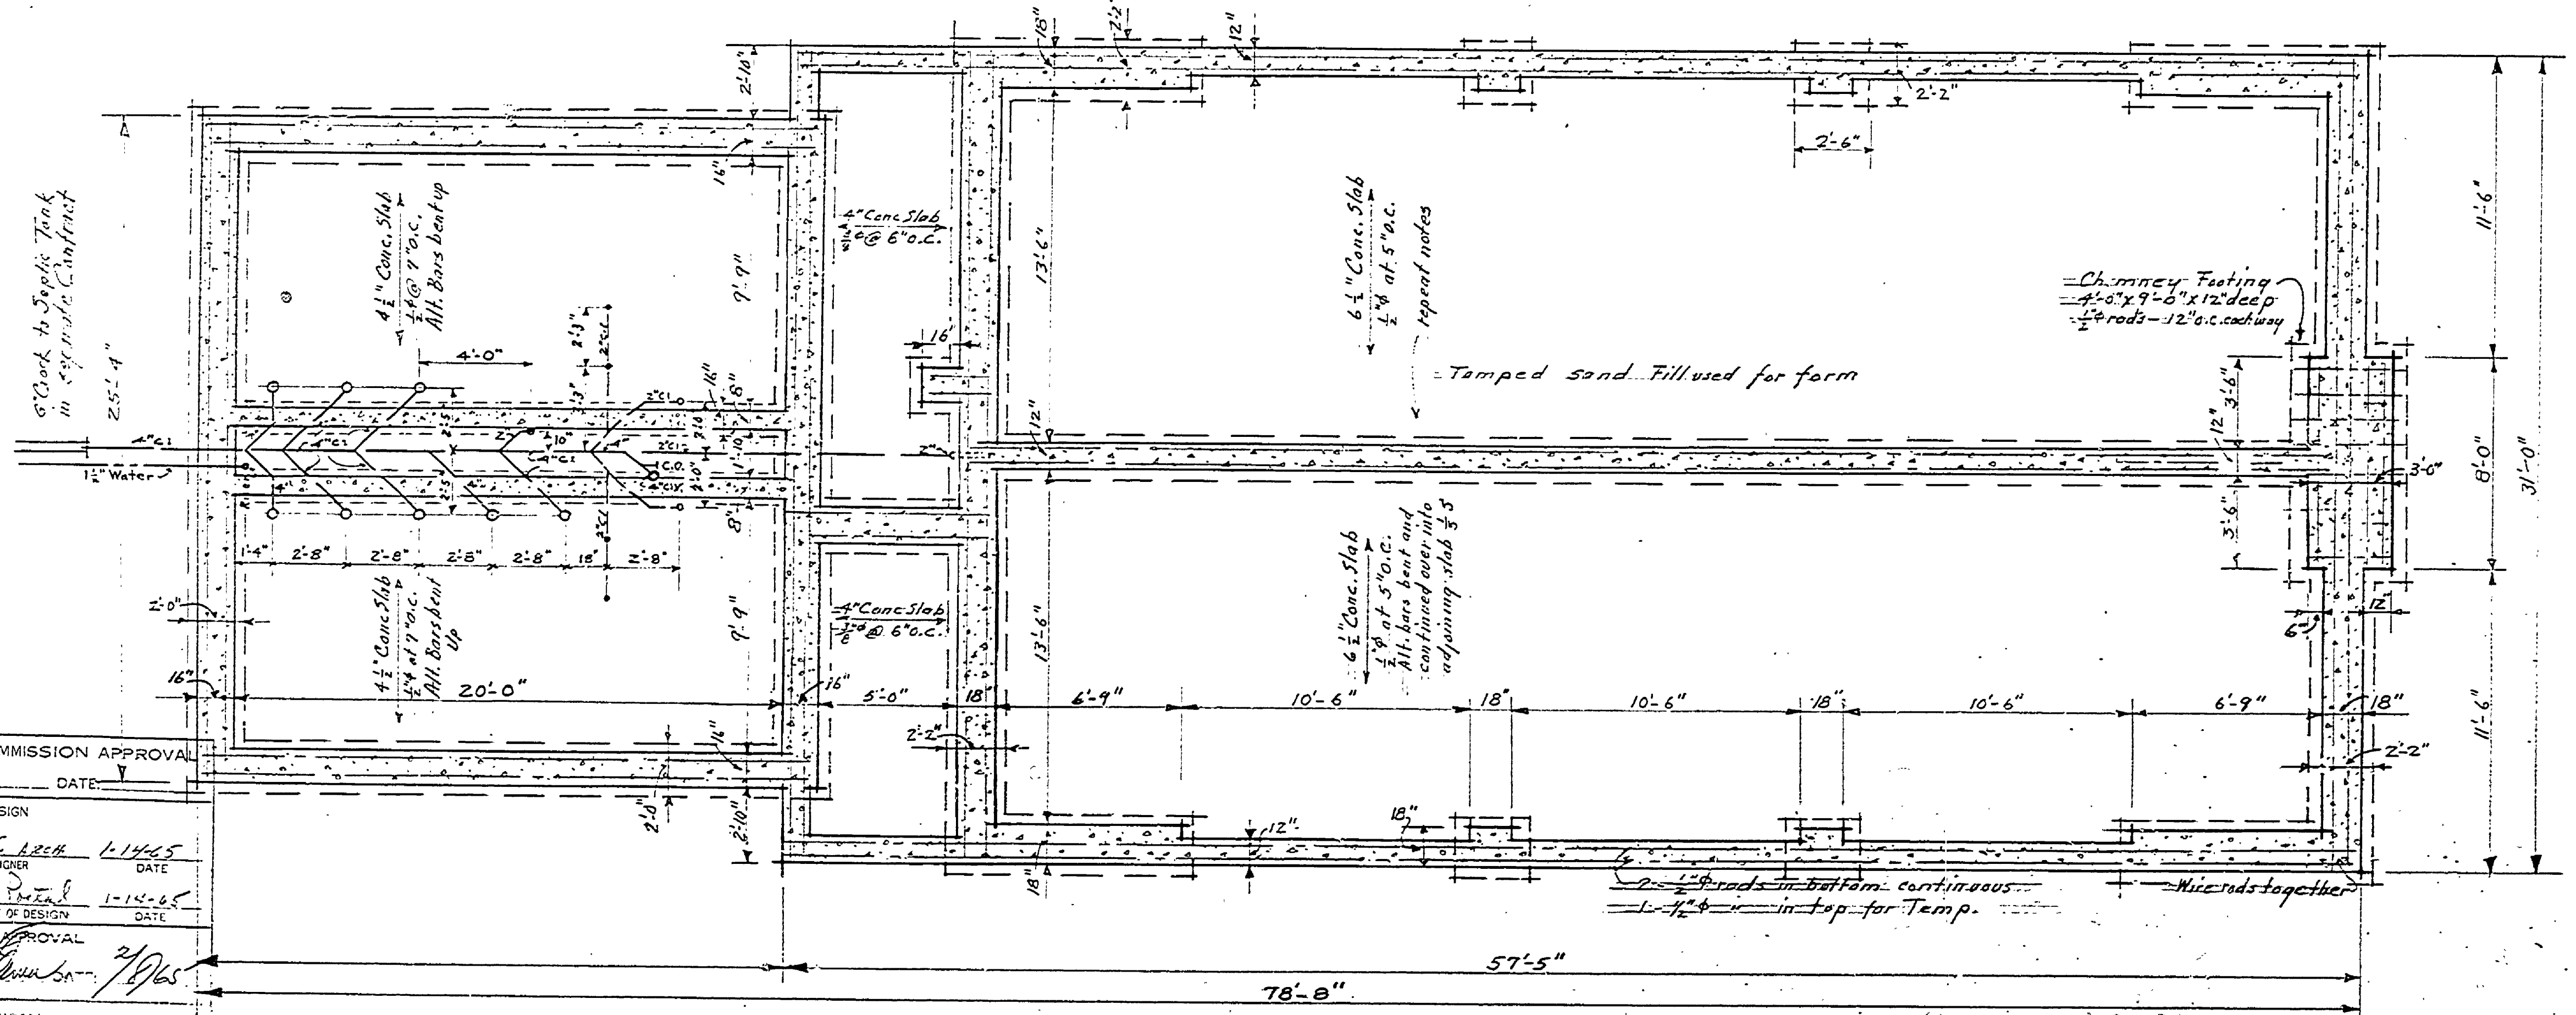


FOUNDATION & SEWER PLAN
Scale: 1/4" = 1'-0"

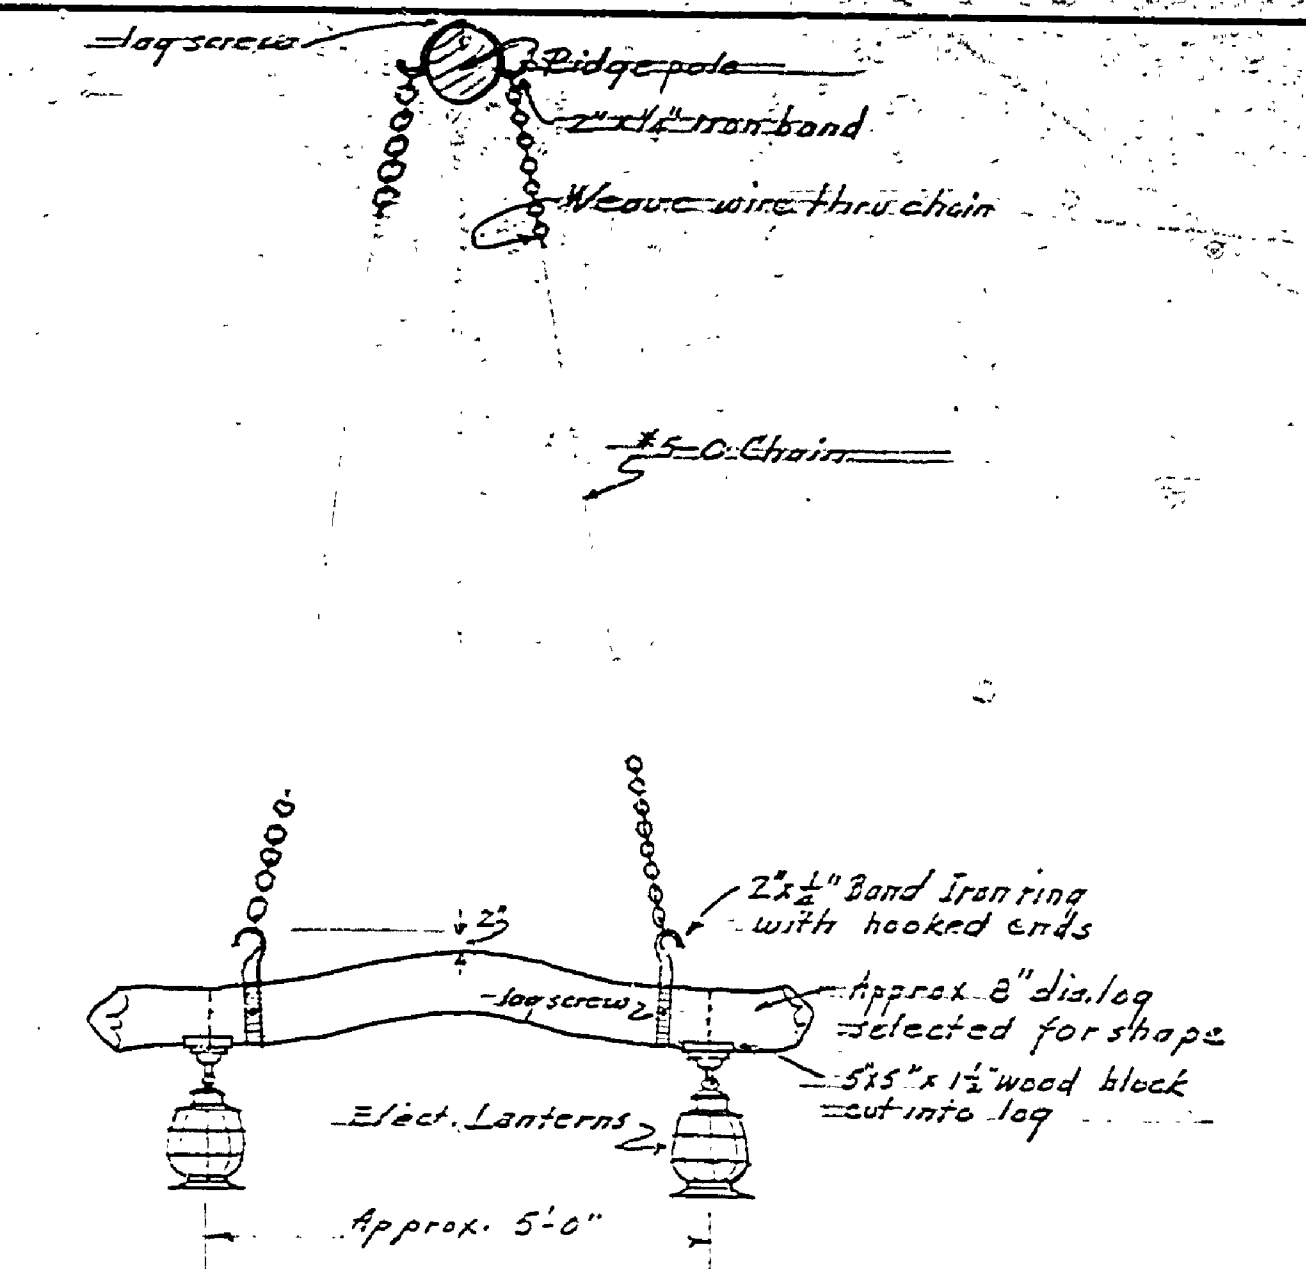


DETAIL OF ELECTRIC FIXTURE FOR PAVILION
3 Required
Scale: 1/2" = 1'-0"

Note: All Iron Work to be made by C.C.R. Blacksmiths

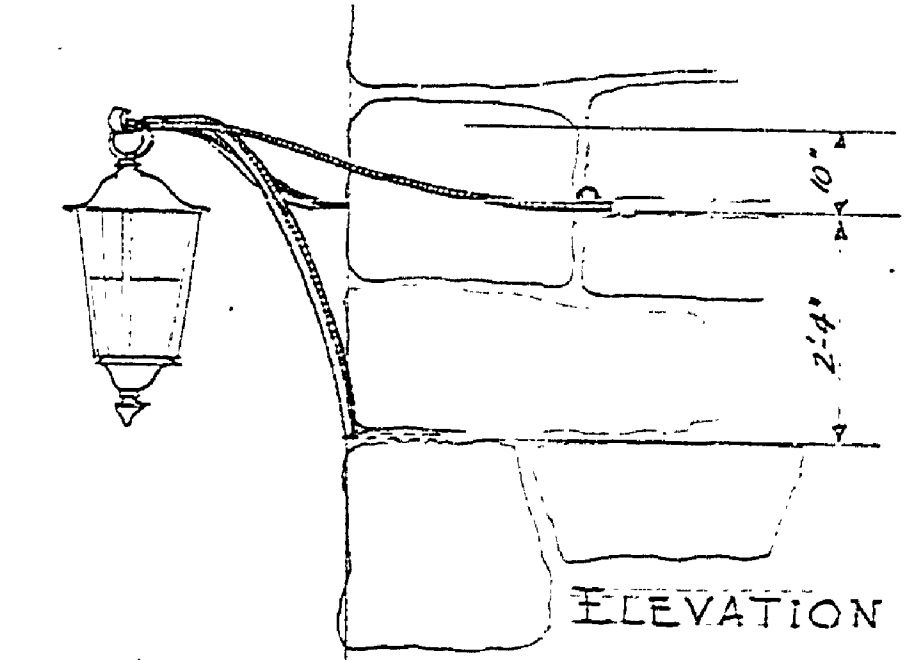

ELEVATION

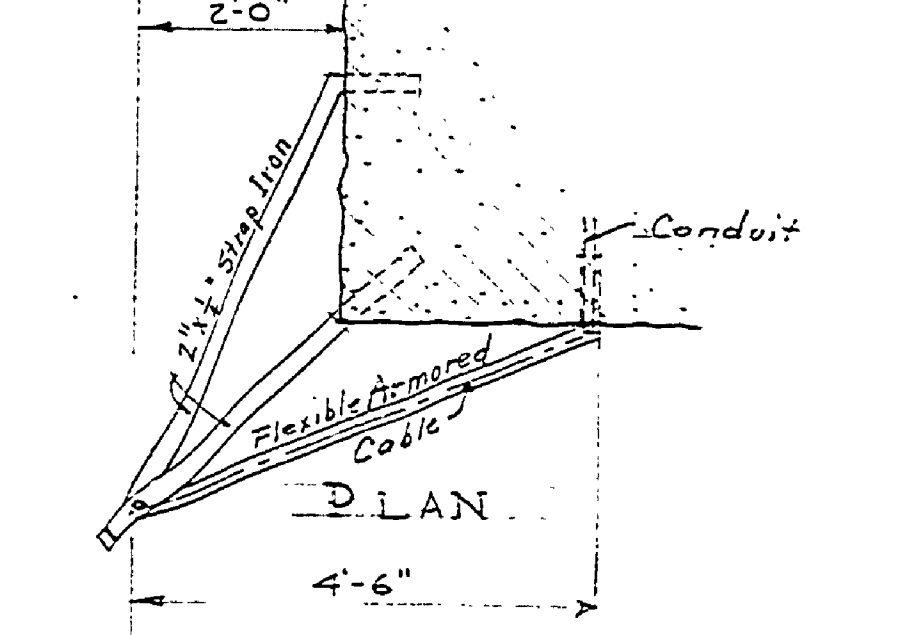

PLAN

DETAIL OF EXTERIOR FIXTURES
2 Required
Scale: 1/2" = 1'-0"

REVISED FITS N.O.C.
1. DOORS & WINDOWS IN SHELTER
2. EXT. DOORS ON TOIL ENTRANCES

CONSERVATION COMMISSION APPROVAL		
BY:	DATE:	
RECOMMENDED FOR APPROVAL:	DESIGNER:	DATE:
RECOMMENDED FOR APPROVAL:	IN CHARGE OF DESIGN:	DATE:
SECTION APPROVAL		
BY:	DATE:	
MICHIGAN DEPARTMENT OF CONSERVATION		
APPROVED:	DATE:	
PLAN NO.	PROJECT NUMBER	SHEET

DEPARTMENT OF THE INTERIOR NATIONAL PARK SERVICE And MICHIGAN DEPARTMENT OF CONSERVATION CO-OPERATING			
BRANCH OF PLANNING	STATE PARK DIVISION	SHEET NO. 1	
SYMBOL		FOX RIVER CCC 1215	
NUMBER		COMBINATION BUILDING	
DRAWN BY		INDIAN LAKE STATE PARK	
CHECKER	PROJECT SUPERINTENDENT	DESIGNED	DATE
DATE		DATE	
RECOMMENDED FOR CONSTRUCTOR		SUBMITTED	
DATE		DATE	
APPROVED FOR CONSTRUCTION		APPROVED	
DATE		DATE	

A-97