


DRAWN BY M.D.S.	REVIEWED BY SECTIONS	APPROVED BY	NO.	DATE BY	REVISIONS	DATE BY
TRACED BY	ARCHITECTURAL	DATE	1		4	
CHECKED BY	ENGINEERING	ASSISTANT CHIEF IN CHARGE	2		5	
DATE 8-28-76	LANDSCAPE	OF DESIGN DATE	3		6	

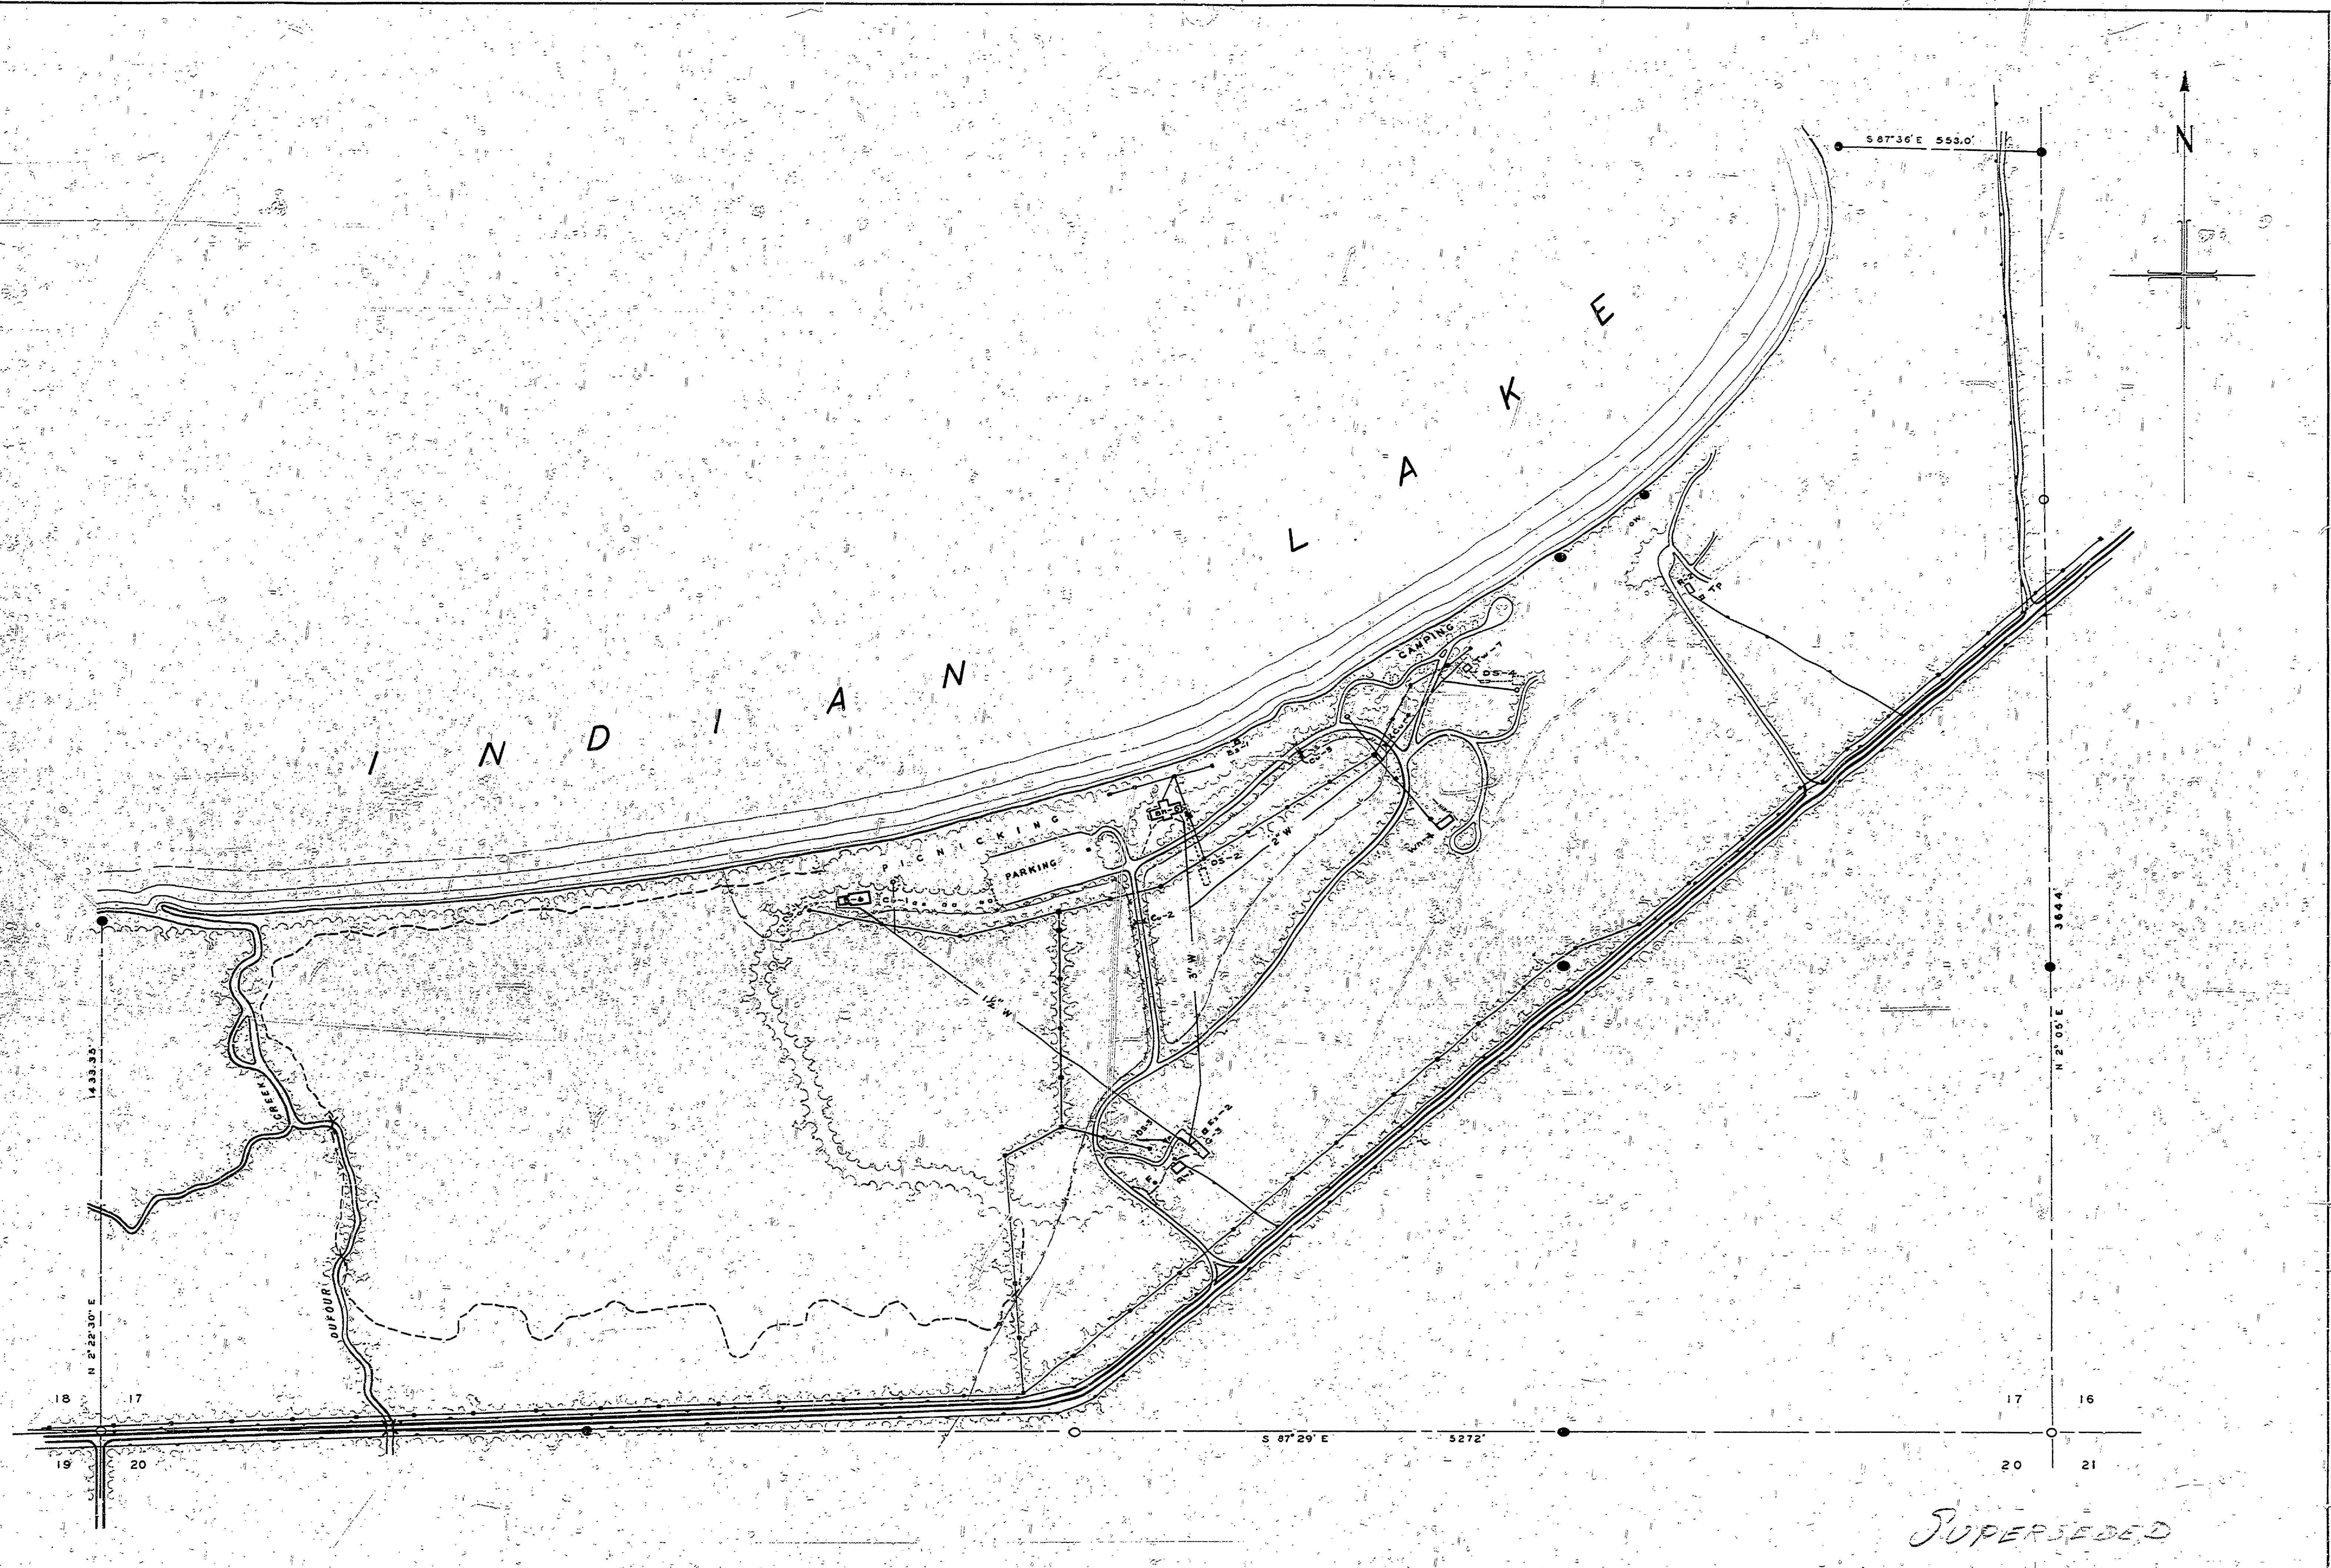

SCALE 1 IN. = 200 FT.

SCHOOLCRAFT COUNTY

THOMPSON TWP. T.41N. R.16W

MICHIGAN  
DEPARTMENT OF CONSERVATION  
PARKS AND RECREATION DIVISION

INDIAN LAKE STATE PARK  
RECORD MAP

SHEET  
NO. 1  
OF 1

PLAN NO.  
R-5

*SUPERSEDED*