

LEGEND:


ROADS--
 EXISTING ————
 PROPOSED - - - -
 THIS PROJECT ————
 FUTURE · · · · ·
 OBLITERATE ······



SCALE 1" = 100'

REVIEWED BY: *[Signature]*
 IN CHARGE - PARK DESIGN DATE

APPROVED BY: *[Signature]* 12-10-69
 CHIEF - PARKS DIVISION DATE

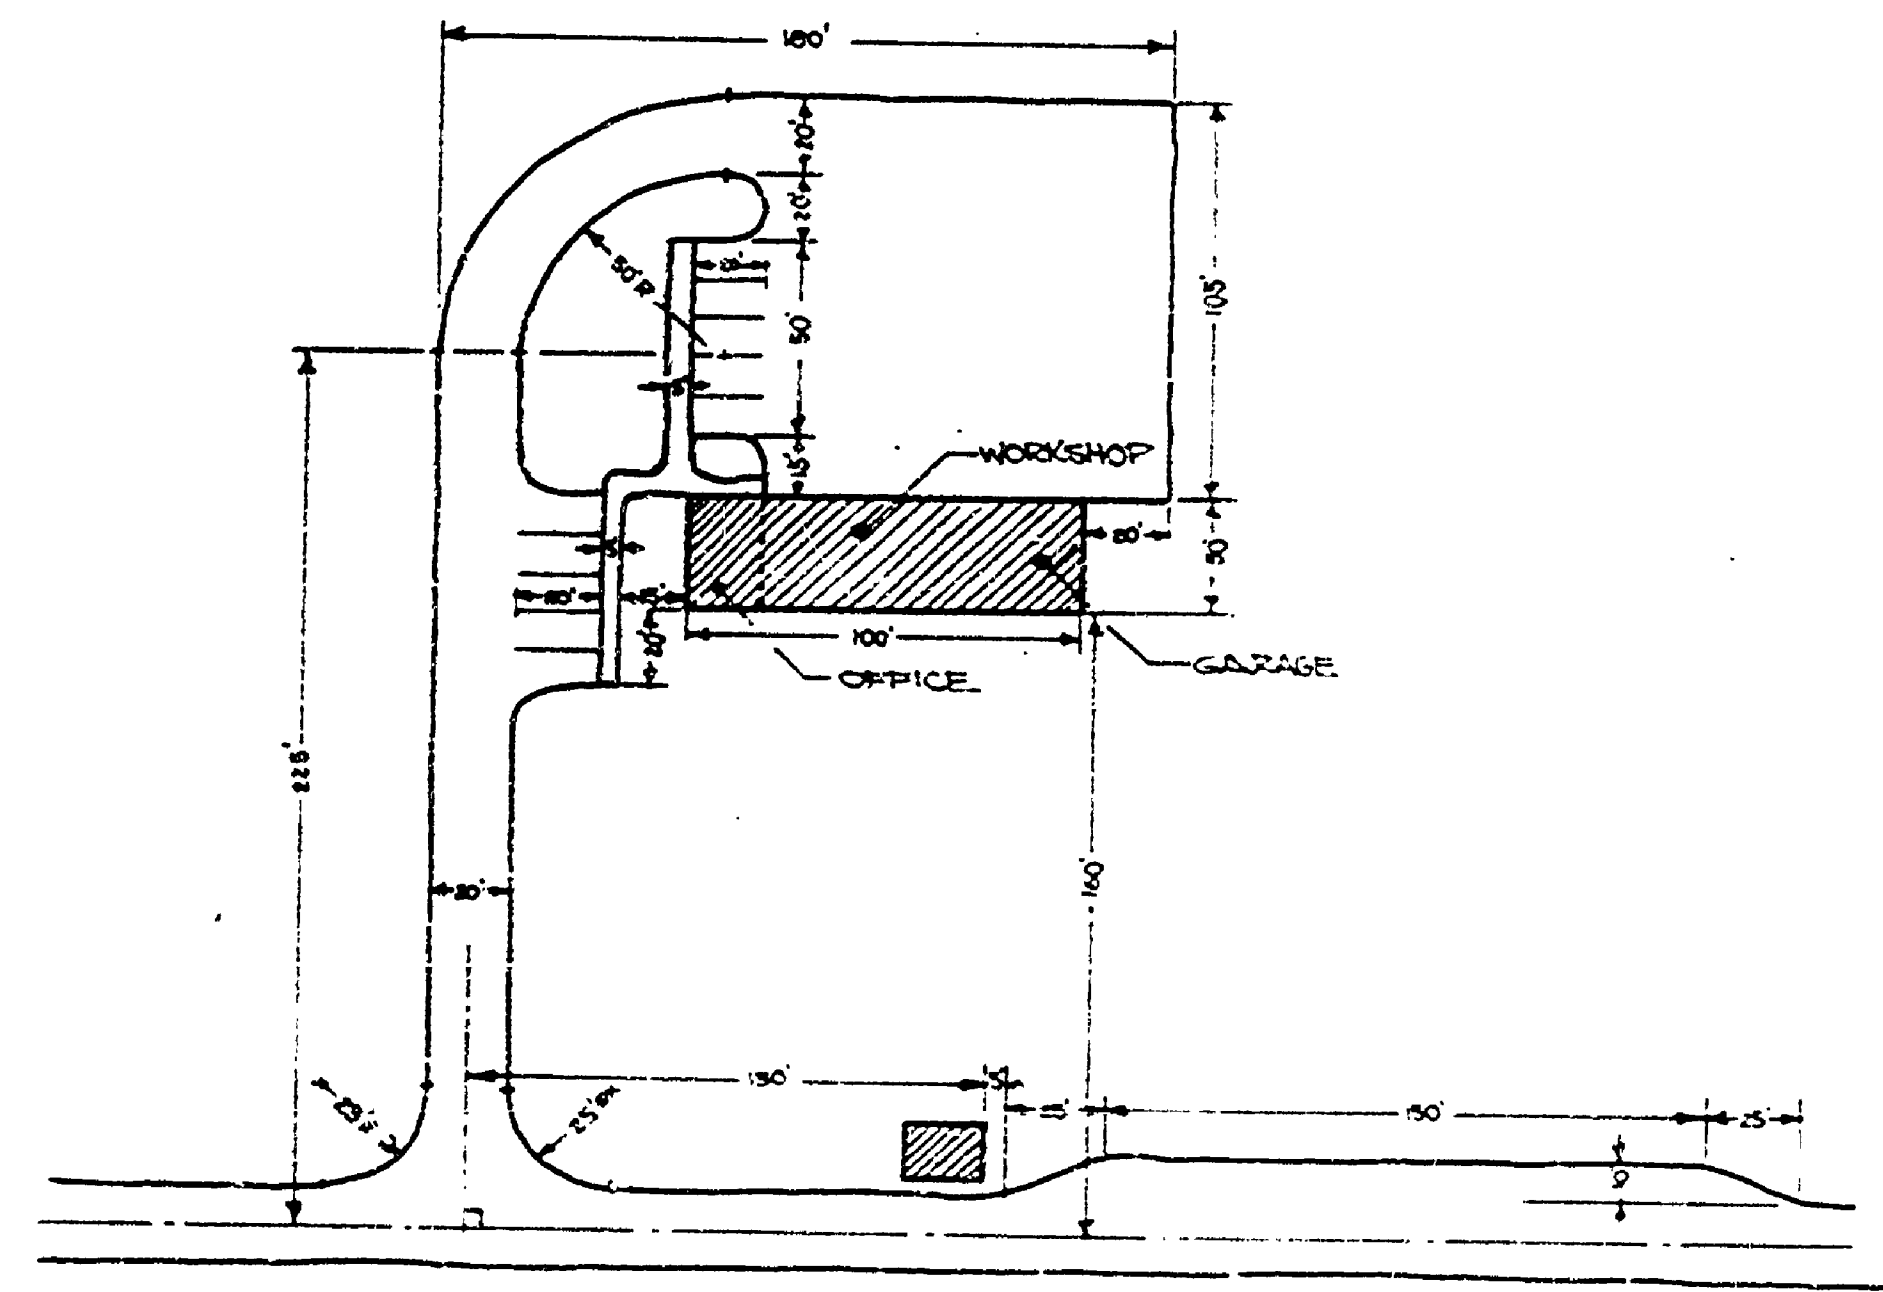

| | | | | | | | | | | | | | | | |
|-------------|-------------|----------|-------|-----|---------|--------|---------------------------------|-----|------|----|-----------|--|------------------|--------------|----------------------------------|
| SURVEYED BY | DESIGNED BY | DRAWN BY | 10/69 | NO. | DATE | BY | REVISIONS | NO. | DATE | BY | REVISIONS | MICHIGAN DEPARTMENT OF NATURAL RESOURCES | WELLS STATE PARK | AREA OF PARK | SITE PLAN OFFICE, SHOP, & GARAGE |
| WESLER | WESLER | KESLER | 10/69 | 1. | 2-10-69 | D.M.A. | MOVED SERVICE AREA 100' NORTH | 3. | | | | | | | |
| | | | | 2. | 2-29-72 | R.C.W. | UPDATED DRAWING TO FIELD SURVEY | 4. | | | | | | | |