


Set Standard Monument
 4' Cedar N. 45° W. 9.5'
 8' W. Pine S. 78° E. 11.2'
 10' Spruce N. 10° W. 3.0'

Set Standard Monuments
 on S. side of fence Posts.

SECTION 34.

New Wire fence
 1315.47'

Standard Monument Set
 in Line of fence. in C of Road.

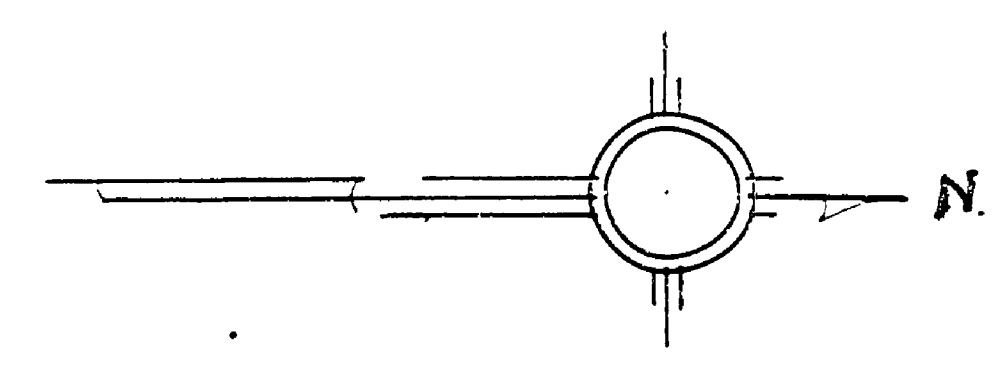

References to Monument May 1935
 Double Cedar N. 45° W. 38.0 Ft
 6' Cedar N. 33.4'
 6' Spruce S. 20° W. 44.8'
 R.R. Spike in G. Rd.
 Replaced by Standard Monument W. Line of Park

References to old Monument May 1935
 5' Black Birch old blazes E. 2.6 Ft
 7' Cedar S. 45° E. 22.7 Ft
 4' Square Cedar Post.

Old Monument, ca wood Stake,
 Replaced by Standard Monument.
 10' Cedar-dead S. 40° W. 44.2'
 4' Ash N. 40° E. 23.8'

SECTION LINE

SECTION 35.

New Location M. 35

1352.5'

4' Popal N. 8° W. 5.2'
 State park Sign N. 4° W. 34.5'
 2' double Cedar S. 25° W. 13.8'

SECTION 26.

Present M. 35

Sett Line

GREEN BAY

SECTION LINE

Map Showing
 Boundary and Monuments
 of
 WELLS STATE PARK
 Cedar River, Mich.

TOWN-35 N-R-25 W.

DEPARTMENT OF THE INTERIOR NATIONAL PARK SERVICE And MICHIGAN DEPARTMENT OF CONSERVATION CO-OPERATING			
BRANCH OF PLANNING		STATE PARK DIVISION	
SYMBOL	MAP SHOWING BOUNDARY and MONUMENTS OF J.W. WELLS	SHEET NO.	
NUMBER		FILE NO.	
DRAWN BY	STATE PARK, Cedar River		
CHECKED	PROJECT SUPERINTENDENT	DESIGNED	
DATE		DATE	
RECOMMENDED FOR CONSTRUCTION		SUBMITTED	
DATE	FIFTH REGIONAL INSPECTOR	DATE	SUPV. OF STATE PARKS
APPROVED FOR CONSTRUCTION		APPROVED	
DATE	FIFTH REGIONAL OFFICER N.P.S.	DATE	REG. CONSERVATION COM'N.