


DESIGNED BY: W. COULSTON	REVIEWED BY SECTIONS:	DATE:	APPROVED BY:	NO. DATE BY	REVISIONS:	DATE BY
TRACED BY:	ARCHITECTURAL	J.I.R. 3-24-66	<i>[Signature]</i>	1		
CHECKED BY:	ENGINEERING	J.I.R. 3-24-66	ASSISTANT CHIEF IN CHARGE	2		
DATE:	LANDSCAPE	J.I.R. 3-24-66	OF DESIGN	3		
				4		
				5		
				6		

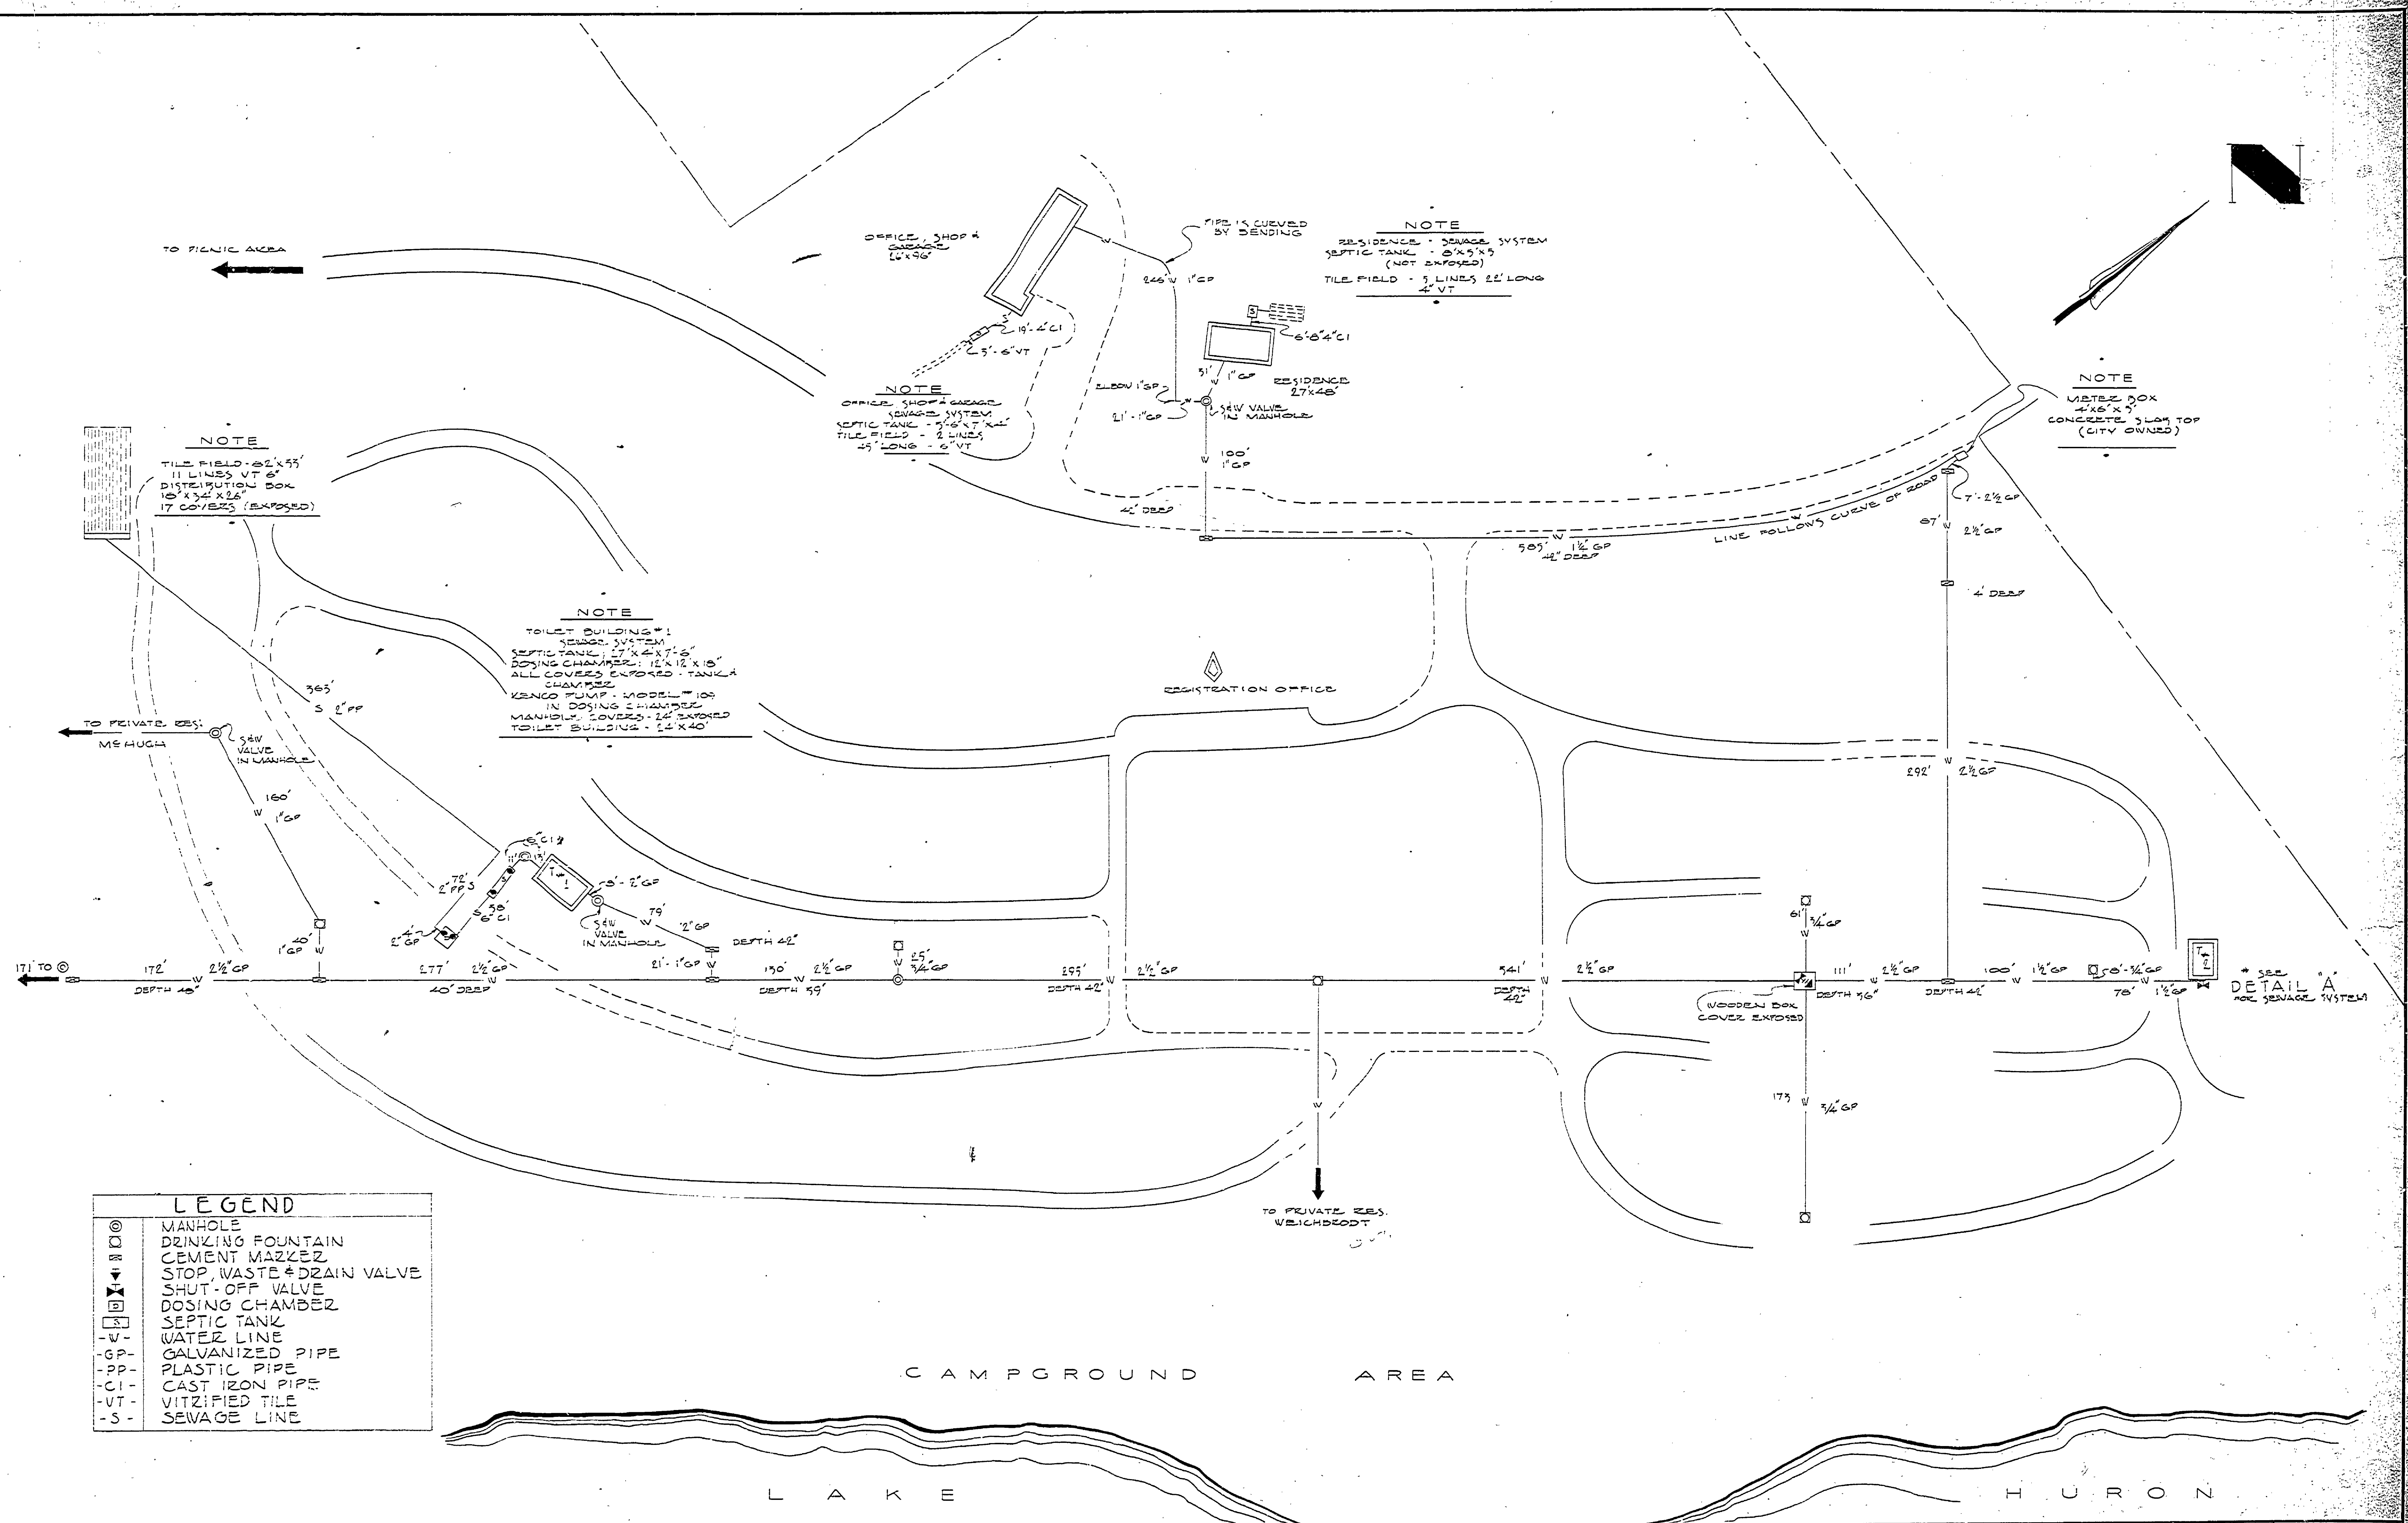

**LEGEND**

⊙	MANHOLE
⊕	DRINKING FOUNTAIN
⊖	CEMENT MAZZEZ
⊗	STOP WASTE & DRAIN VALVE
⊘	SHUT-OFF VALVE
⊙	DOSING CHAMBER
⊙	SEPTIC TANK
-W-	WATER LINE
-GP-	GALVANIZED PIPE
-PP-	PLASTIC PIPE
-CI-	CAST IRON PIPE
-VT-	VITRIFIED TILE
-S-	SEWAGE LINE