


ORCHARD BEACH STATE PARK
DISPOSAL SYSTEM
LUDINGTON-S.P.2- MICHIGAN


DATE 4 Dec 39 Dr. By H.C.H.-S.S. PLAN AT MICH S.23.045-3

LAKE MICHIGAN

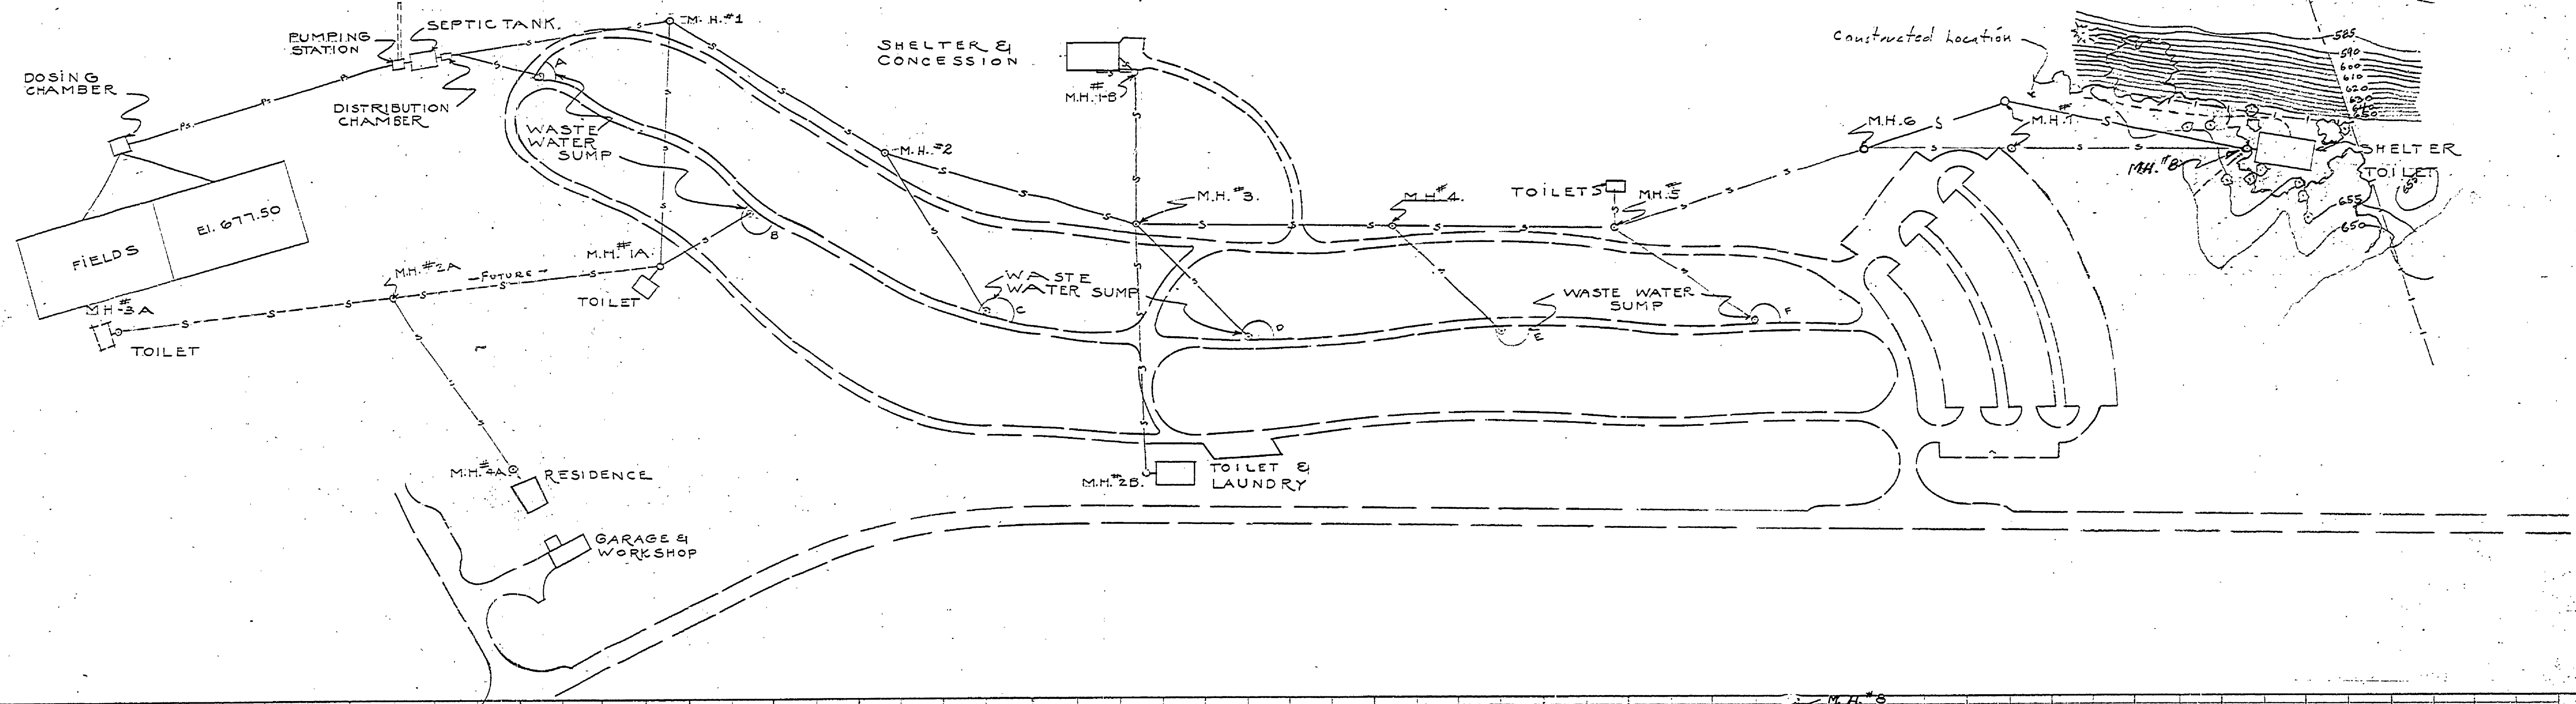

DATE
BY
CHECKED
DATE
NO. OF ANY CHECKS
PLAN
SURVEYED
DESIGNED
NOTED
NO.

DATE
BY
CHECKED
DATE
NO. OF ANY CHECKS
PROFILE
SURVEYED
DESIGNED
NOTED
NO.

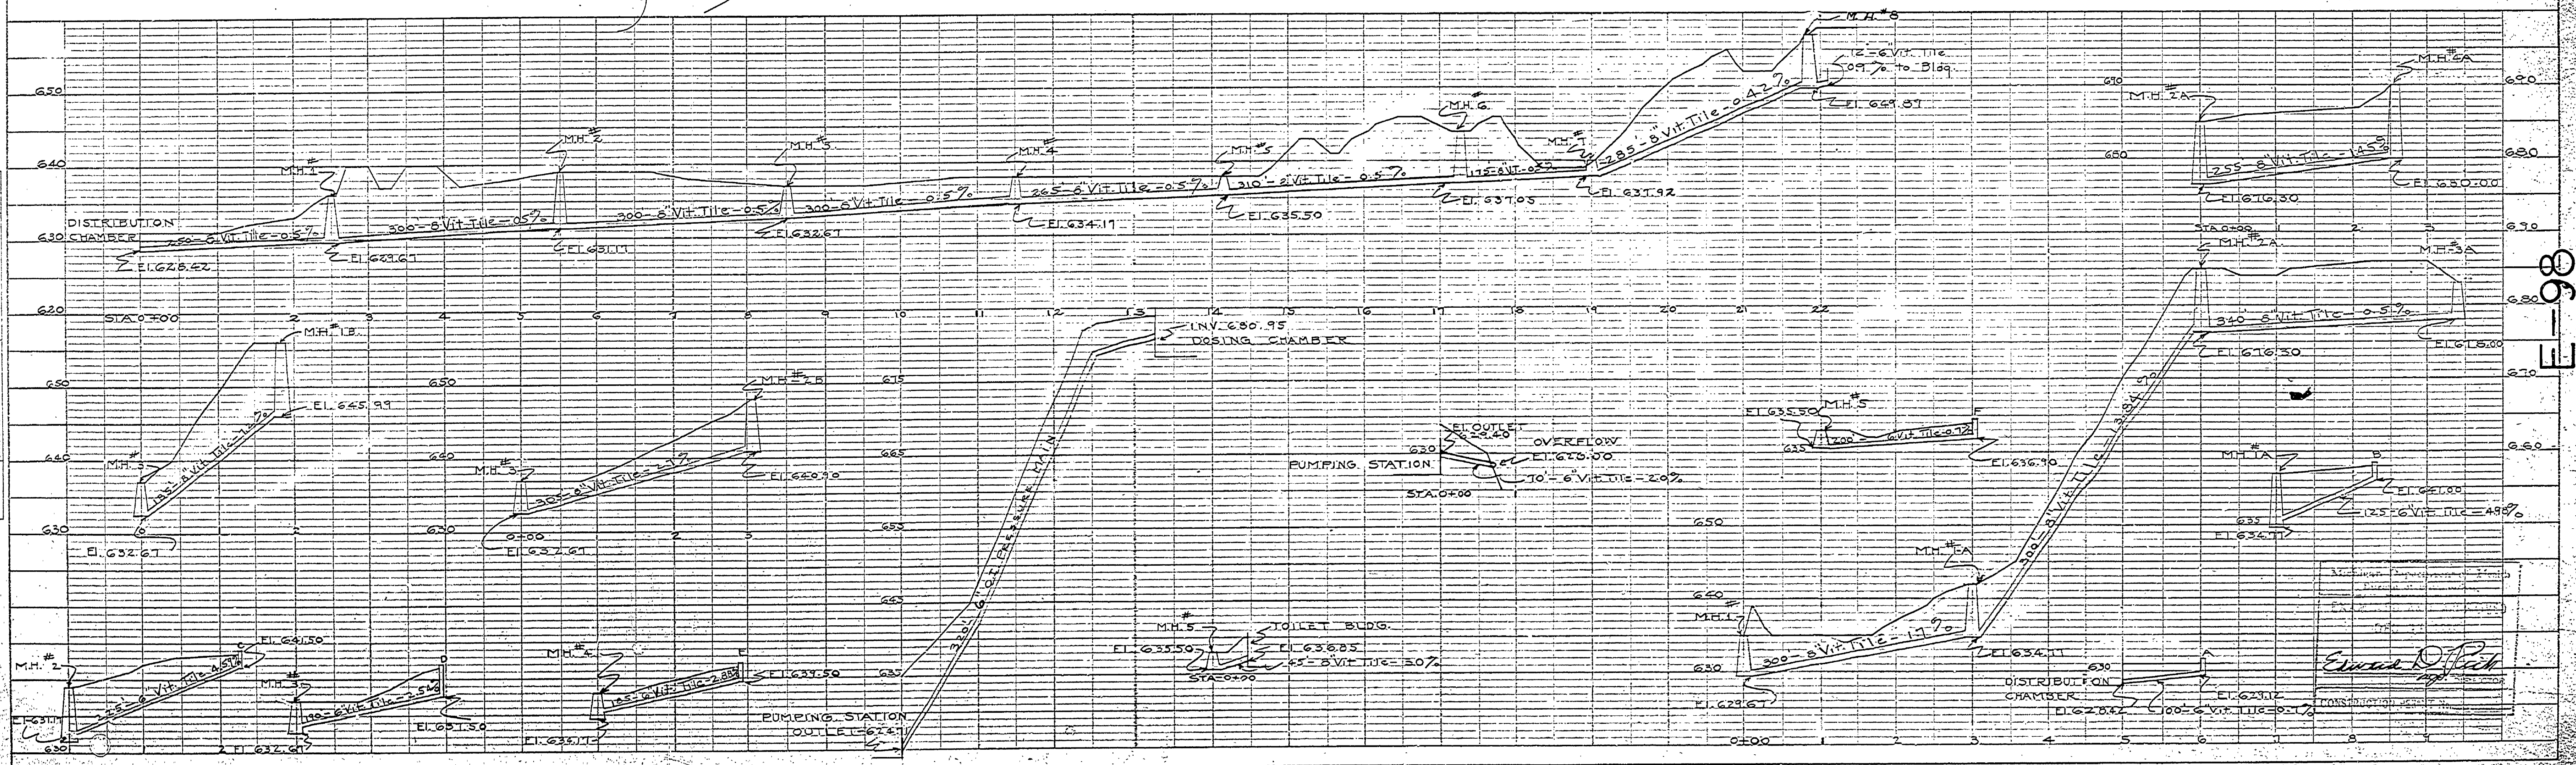

66-11