


PROPOSED PUBLIC SERVICE BUILDING FOR  
**EDWARD E. HARTWICK PINE PARK**  
DEPARTMENT OF CONSERVATION  
REV. 9/29 J. E. R.

INSURANCE No. 3

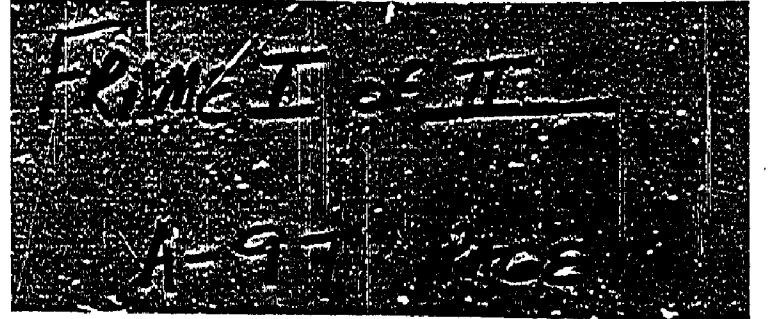

INSURANCE No. 3  
CHANGE FROM ORIGINAL

977 A-97

HARTWICK  
PINES

P-17  
Page 1