


DESIGNED BY	DATE	REVIEWED	DATE	APPROVED	DATE	NO.	DATE	BY	REVISIONS	DATE	BY
B.H.G.	Nov. 63	ARCHITECTURAL	11-17-63	<i>[Signature]</i>	11-17-63	1	10-64	B.P.P.	Final - after Completion of Const.	4	
D.M.C.	Nov. 63	ENGINEERING	11-14-63	<i>[Signature]</i>	11-17-63	2				5	
B.H.G.	Dec. 63	LANDSCAPE	12-17-63	<i>[Signature]</i>	12-17-63	3				6	

**LEGEND**

---W---	Existing Water Line
-W-	Proposed Water Line
⊕	Proposed Drinking Fountain
△	Proposed Concrete Marker
-S-	Proposed Sewer Line
⊙	Proposed Manhole
1" G.P.	Existing 3" Plastic Pipe
2" G.P.	Proposed 2" Galv. Pipe

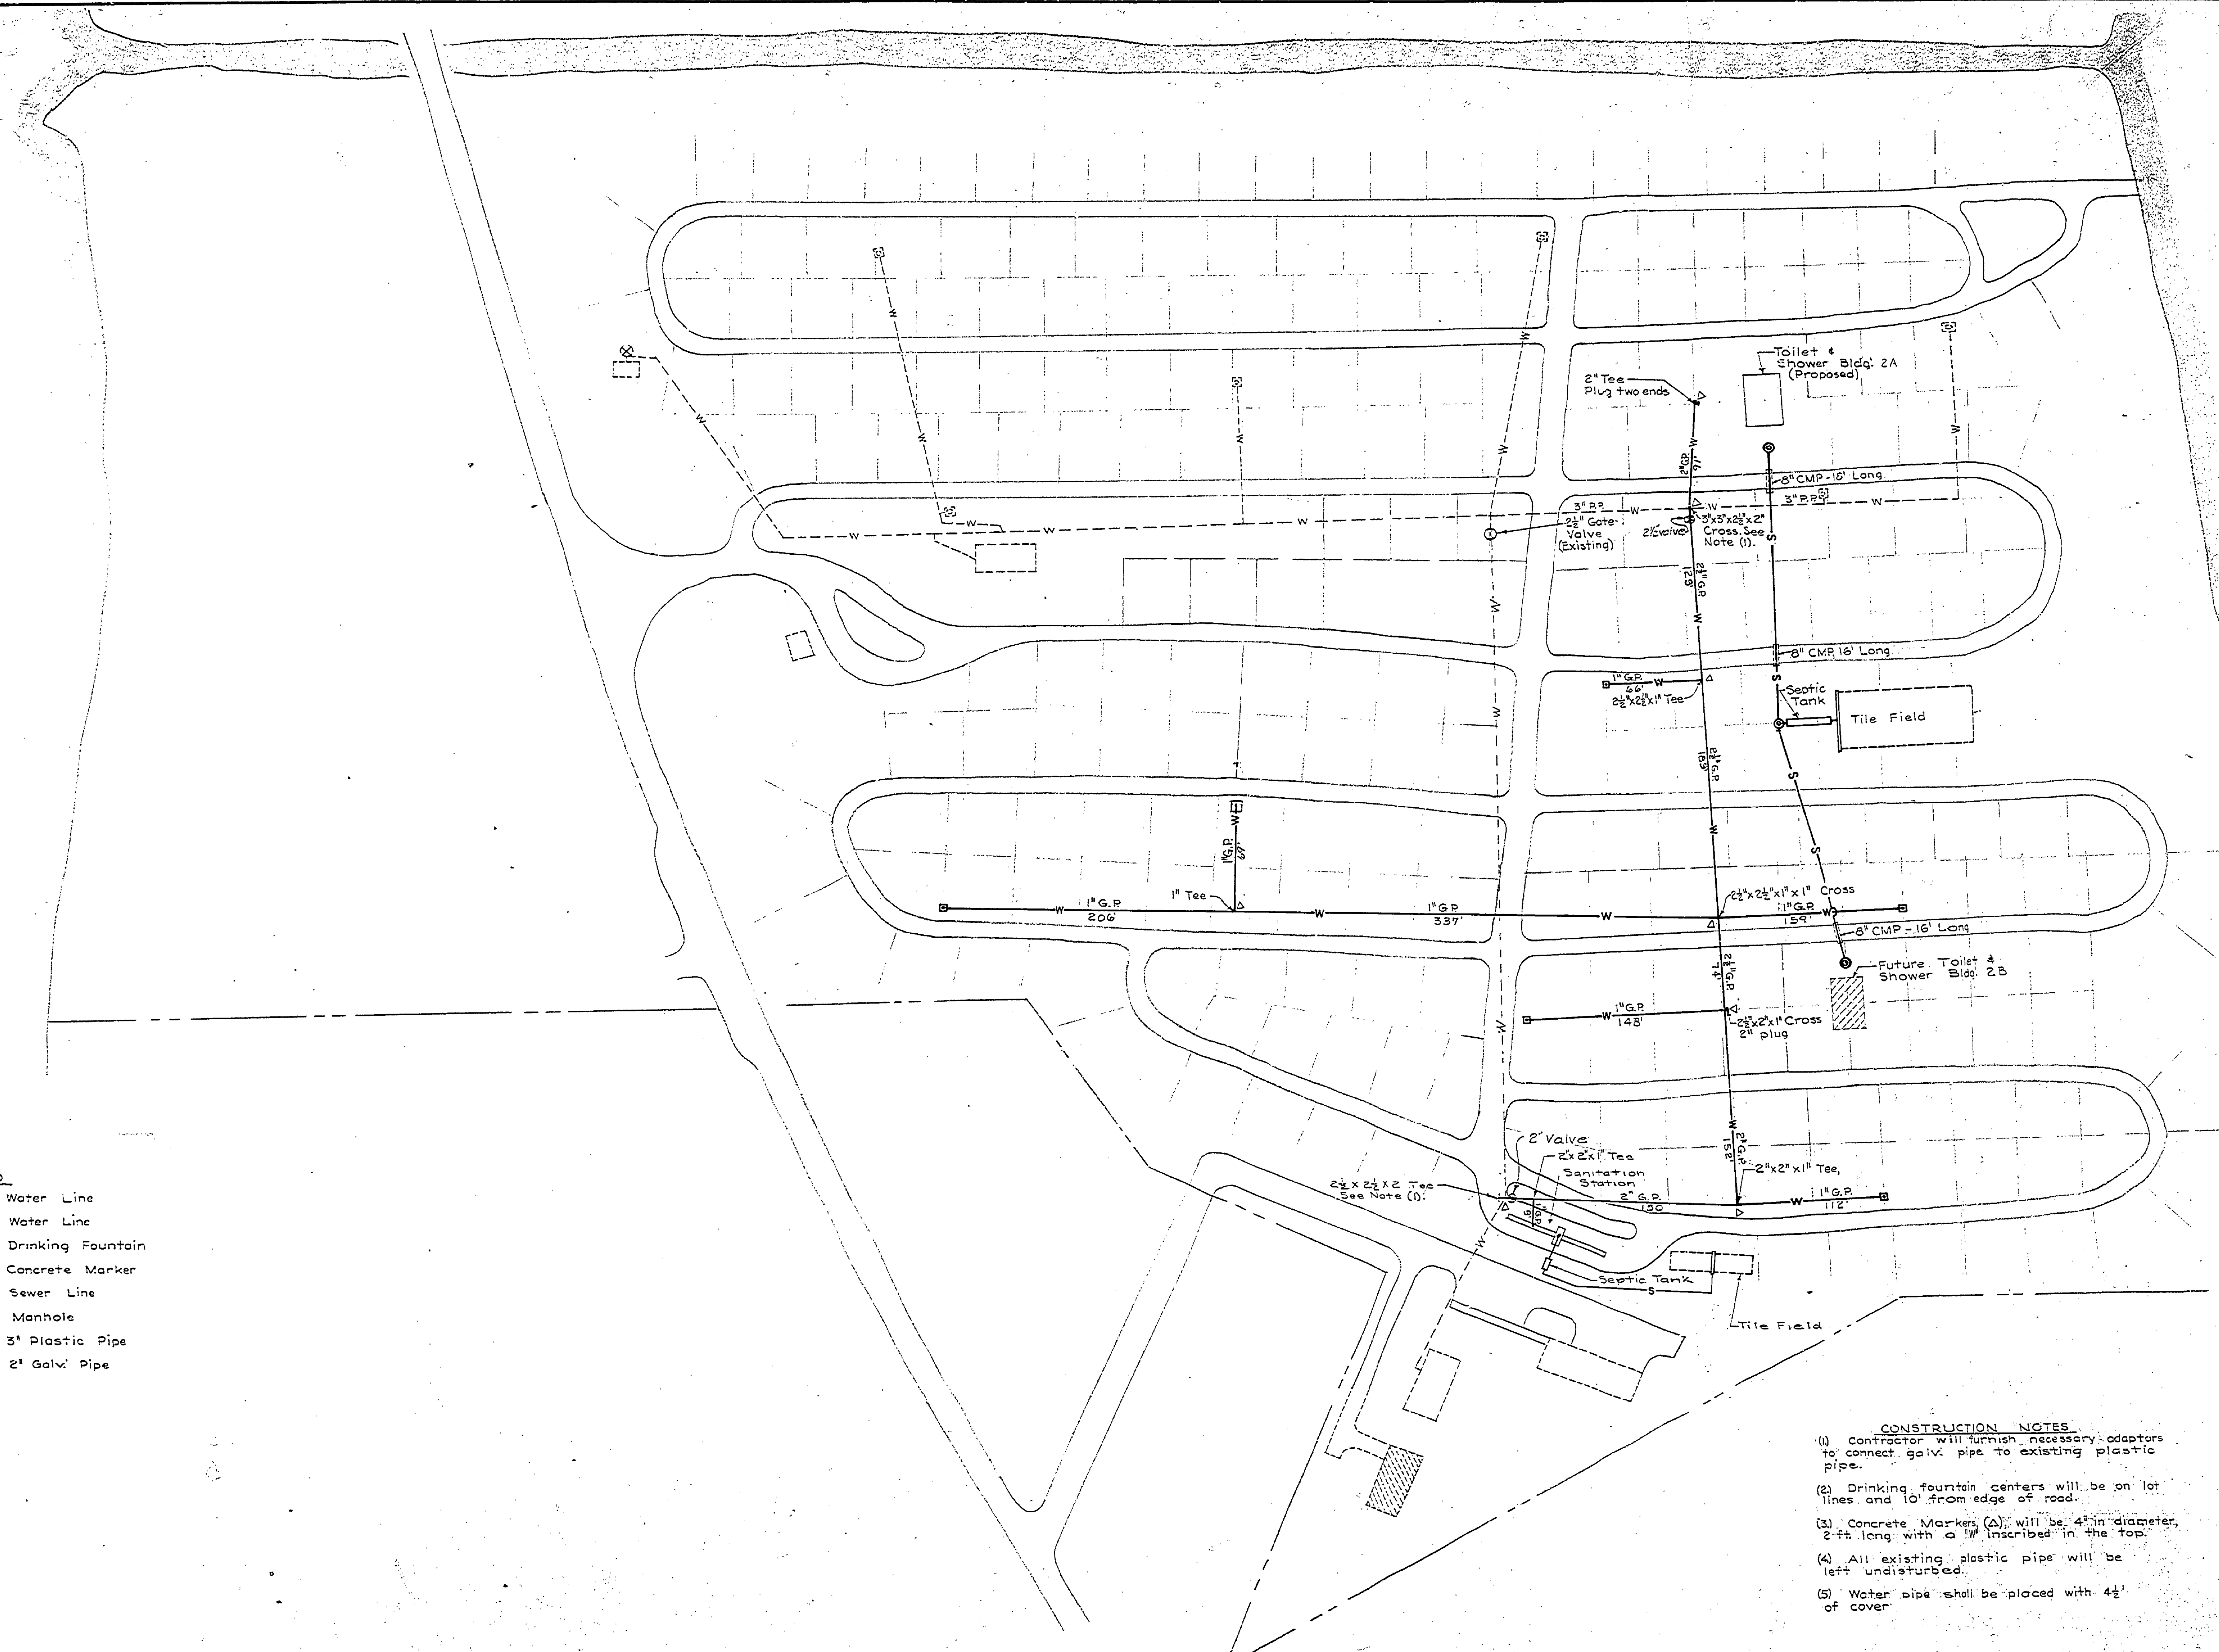

- CONSTRUCTION NOTES**
- (1) Contractor will furnish necessary adaptors to connect galv. pipe to existing plastic pipe.
  - (2) Drinking fountain centers will be on lot lines and 10' from edge of road.
  - (3) Concrete Markers (A) will be 4" in diameter, 2-ft long with a 'W' inscribed in the top.
  - (4) All existing plastic pipe will be left undisturbed.
  - (5) Water pipe shall be placed with 4 1/2' of cover.

SCALE 1" = 60'

MICHIGAN  
DEPARTMENT OF CONSERVATION  
PARKS AND RECREATION DIVISION

MITCHELL STATE PARK  
CAMPGROUND WATER LINE EXTENSION

SHEET  
NO. 2  
OF 5

PLAN NO.  
E-103