



DRAWN BY	REVIEWED BY SECTIONS	DATE	APPROVED BY	NO. DATE BY	REVISIONS	DATE BY
TRACED BY J.M.F. 1/15/57	ARCHITECTURAL		ASSISTANT CHIEF IN CHARGE	1	4	
CHECKED BY	ENGINEERING		OF DESIGN	2	5	
DATE	LANDSCAPE			3	6	

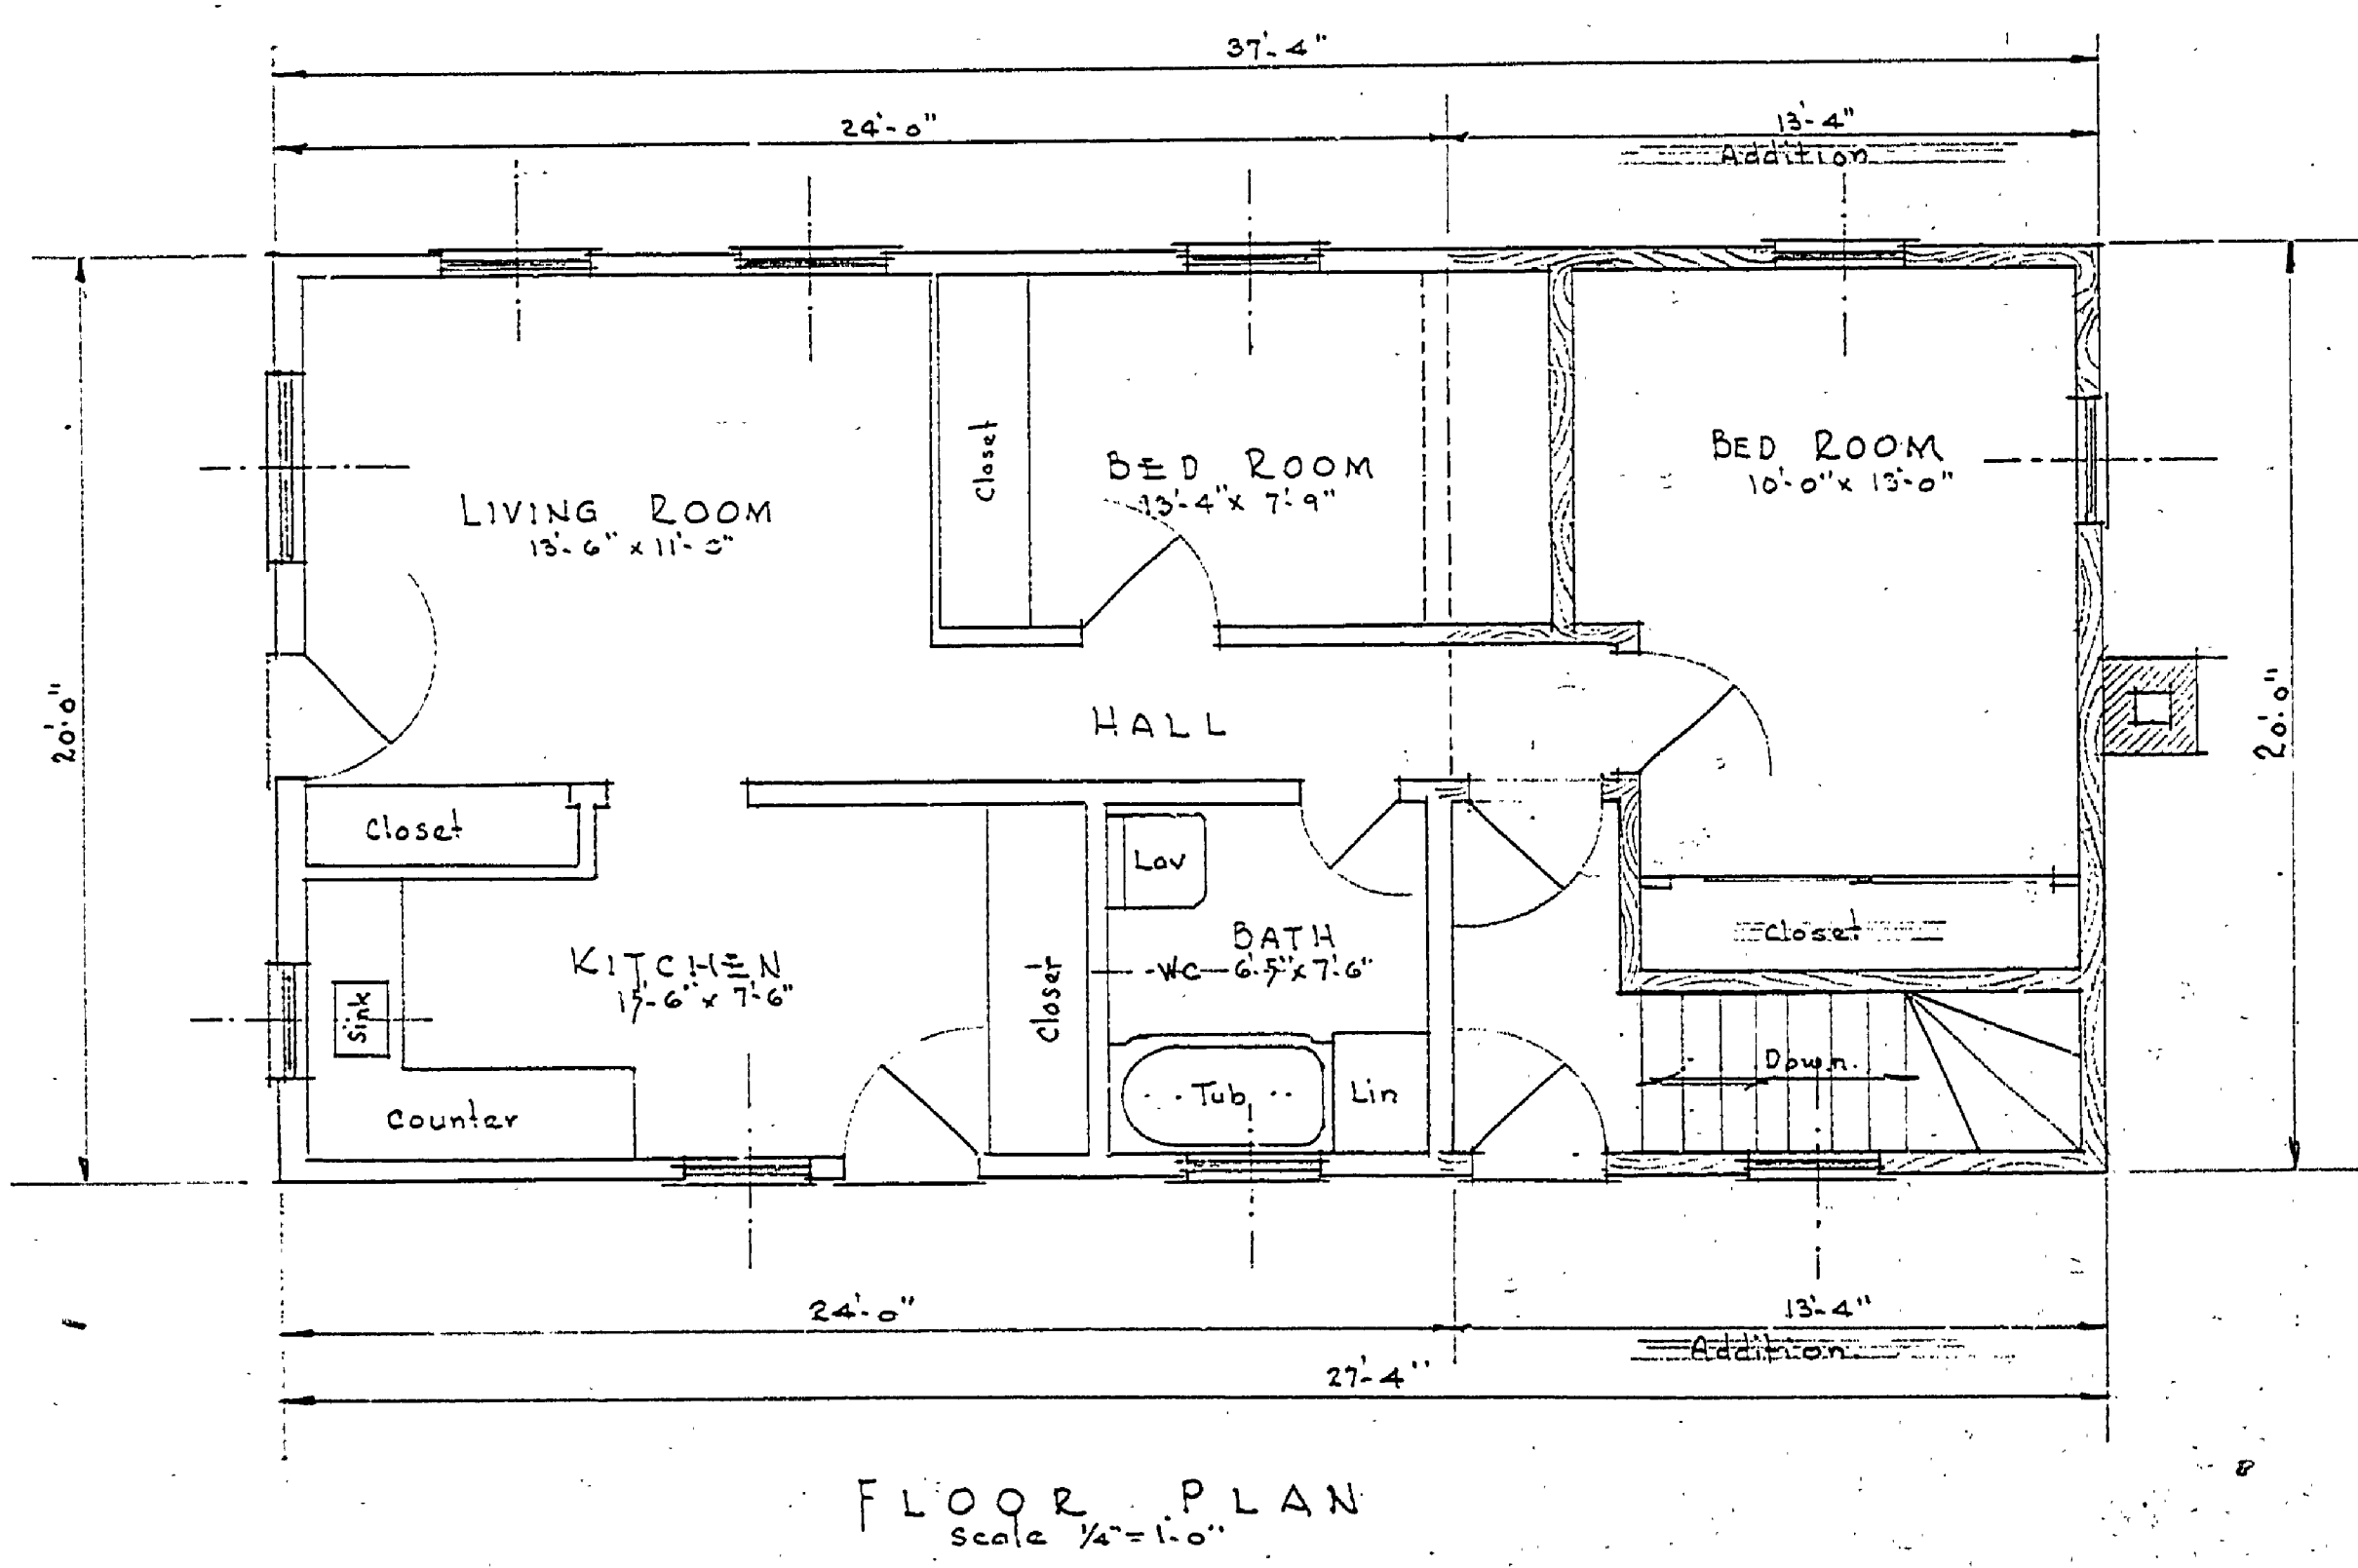

FLOOR PLAN
Scale 1/4" = 1'-0"

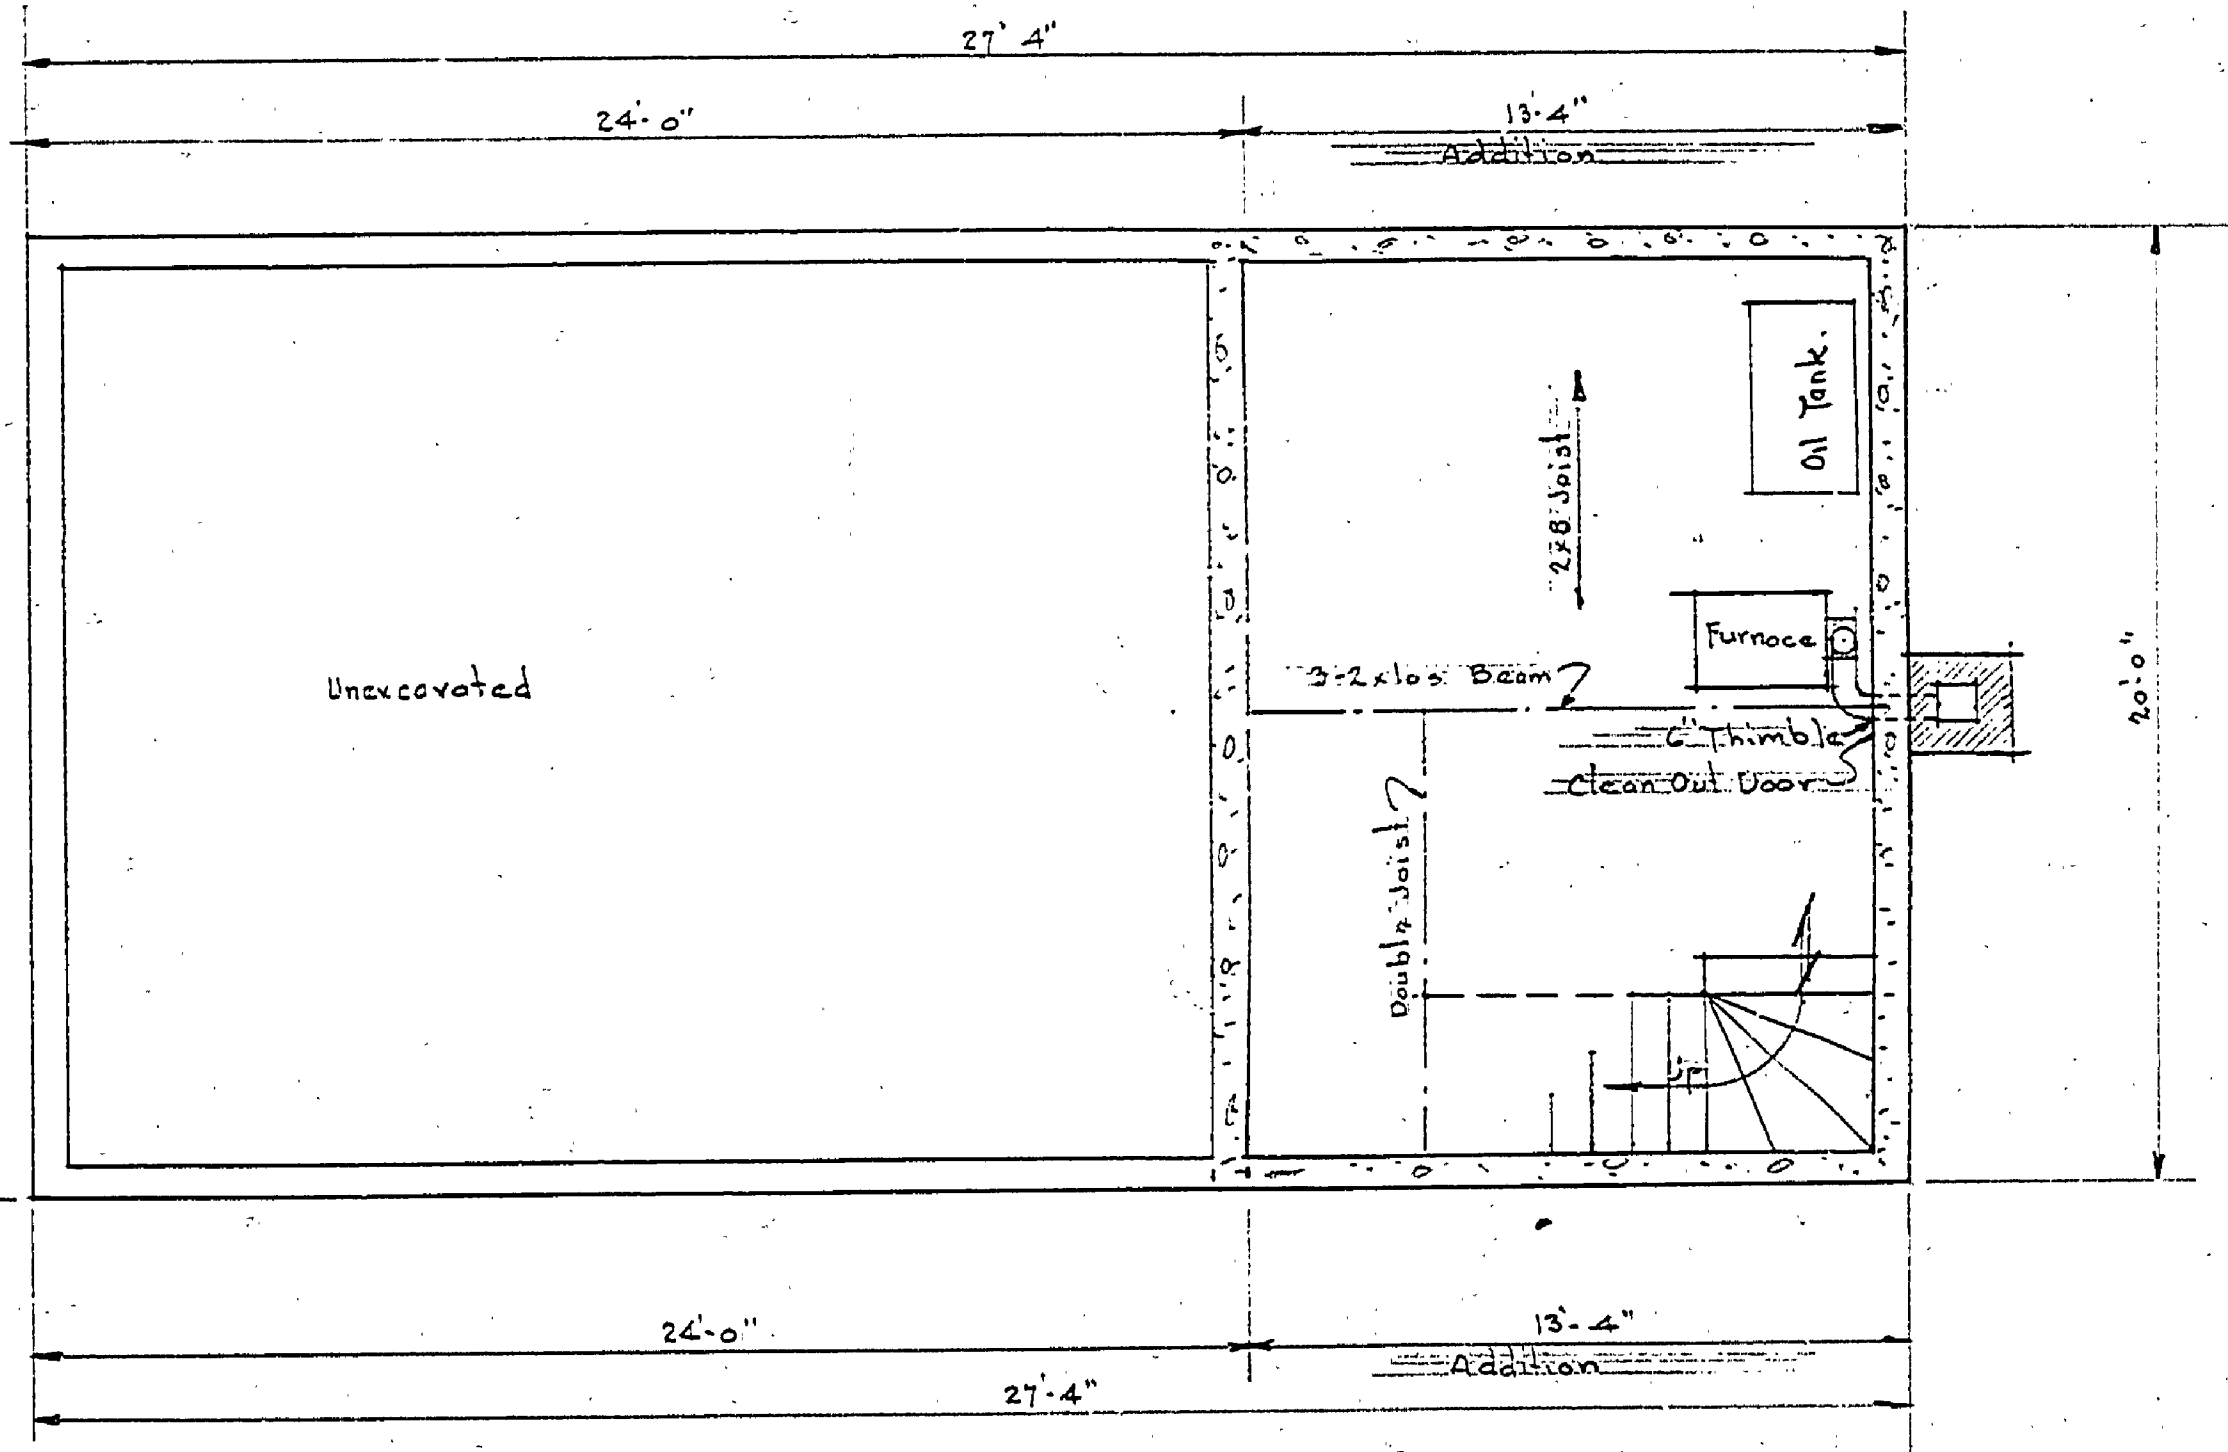

BASEMENT PLAN
Scale 1/4" = 1'-0"

NOTE:-
Room sizes of Manager's Residence
were furnished by Mr. Doric on a Sketch
Plan

MICHIGAN
DEPARTMENT OF CONSERVATION
PARKS AND RECREATION DIVISION

MCLAIN STATE PARK
MANAGER'S RESIDENCE
FOR FURNACE LAYOUT

SHEET
NO. 1
OF 1

PLAN NO.
A-107