


DESIGNED BY	DATE	REVIEWED	DATE	APPROVED	DATE	NO.	DATE BY	REVISIONS	DATE BY
B.H.G.	13 April 61	ARCHITECTURAL	6-21-61	<i>[Signature]</i>	6/16	1	8am/11 814	Revised Water System Replaces Plan No. E-100 Dated 7-26-49	4
B.H.G.	13 April 61	ENGINEERING	6-21-61	<i>[Signature]</i>	6-23-61	2			5
E.S.P.	11 June 61	LANDSCAPE	6-23-61	<i>[Signature]</i>		3			6



PLAN  
Scale 1" = 100'

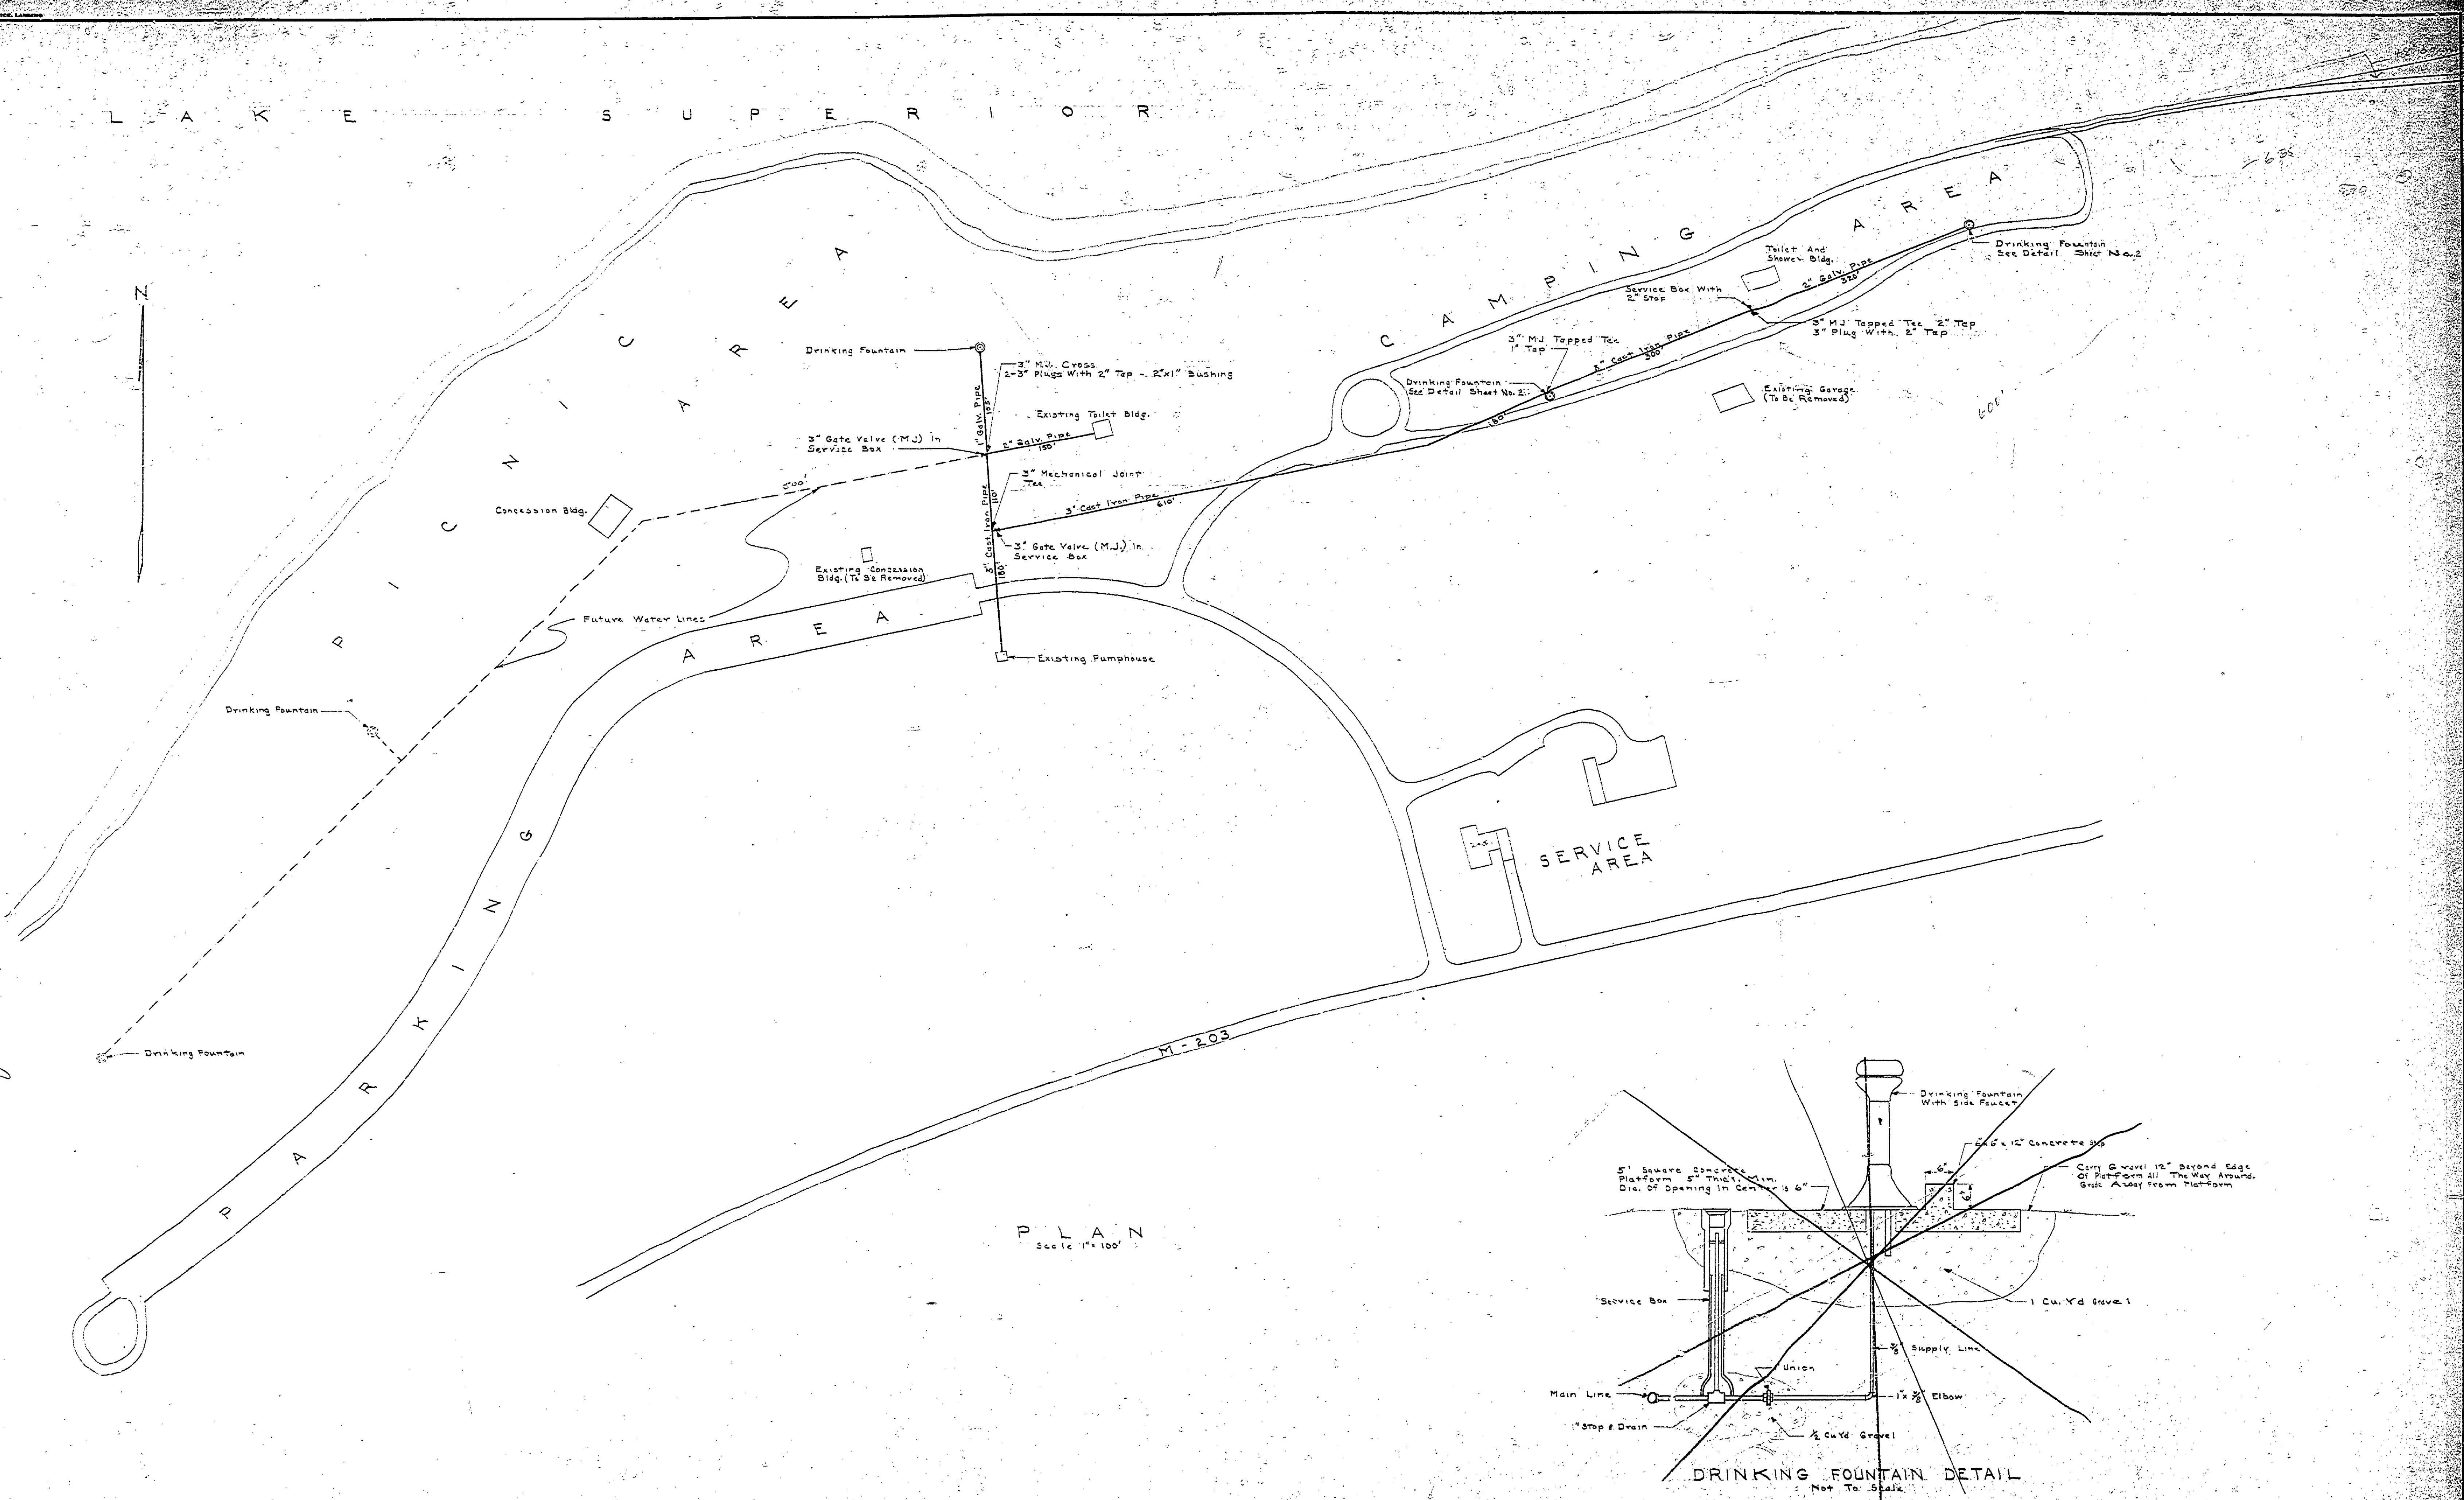