

DESIGNED BY	DRAWN BY	CHECKED BY	DATE	REVIEWED	DATE	APPROVED	DATE	NO.	DATE BY	REVISIONS	DATE BY
								1		4	
								2		5	
								3		6	


NOTE
 1. TOILET BLDG.
 2. HOT WATER PLANT
 3. 75 GAL. CAR.
 4. 100 LB. BOTTLED GAS
 5. 2" DIA. 1" DEEP
 6. 2" DIA. 1" DEEP

DETAIL A
 SCALE: 1" = 20'-0"

CYCLONE FENCE ENCLOSURE FOR 21" 100 LB. BOTTLED GAS TANKS.

NOTE
 THIS SECTION OF LINE DISCONNECTED

SI VERSION CHAMBER 10'-0" X 5'-0" X 6'-0" DEEP 2" CAST IRON MANHOLES 24" DIA. EXTENDS 3" ABOVE GROUND

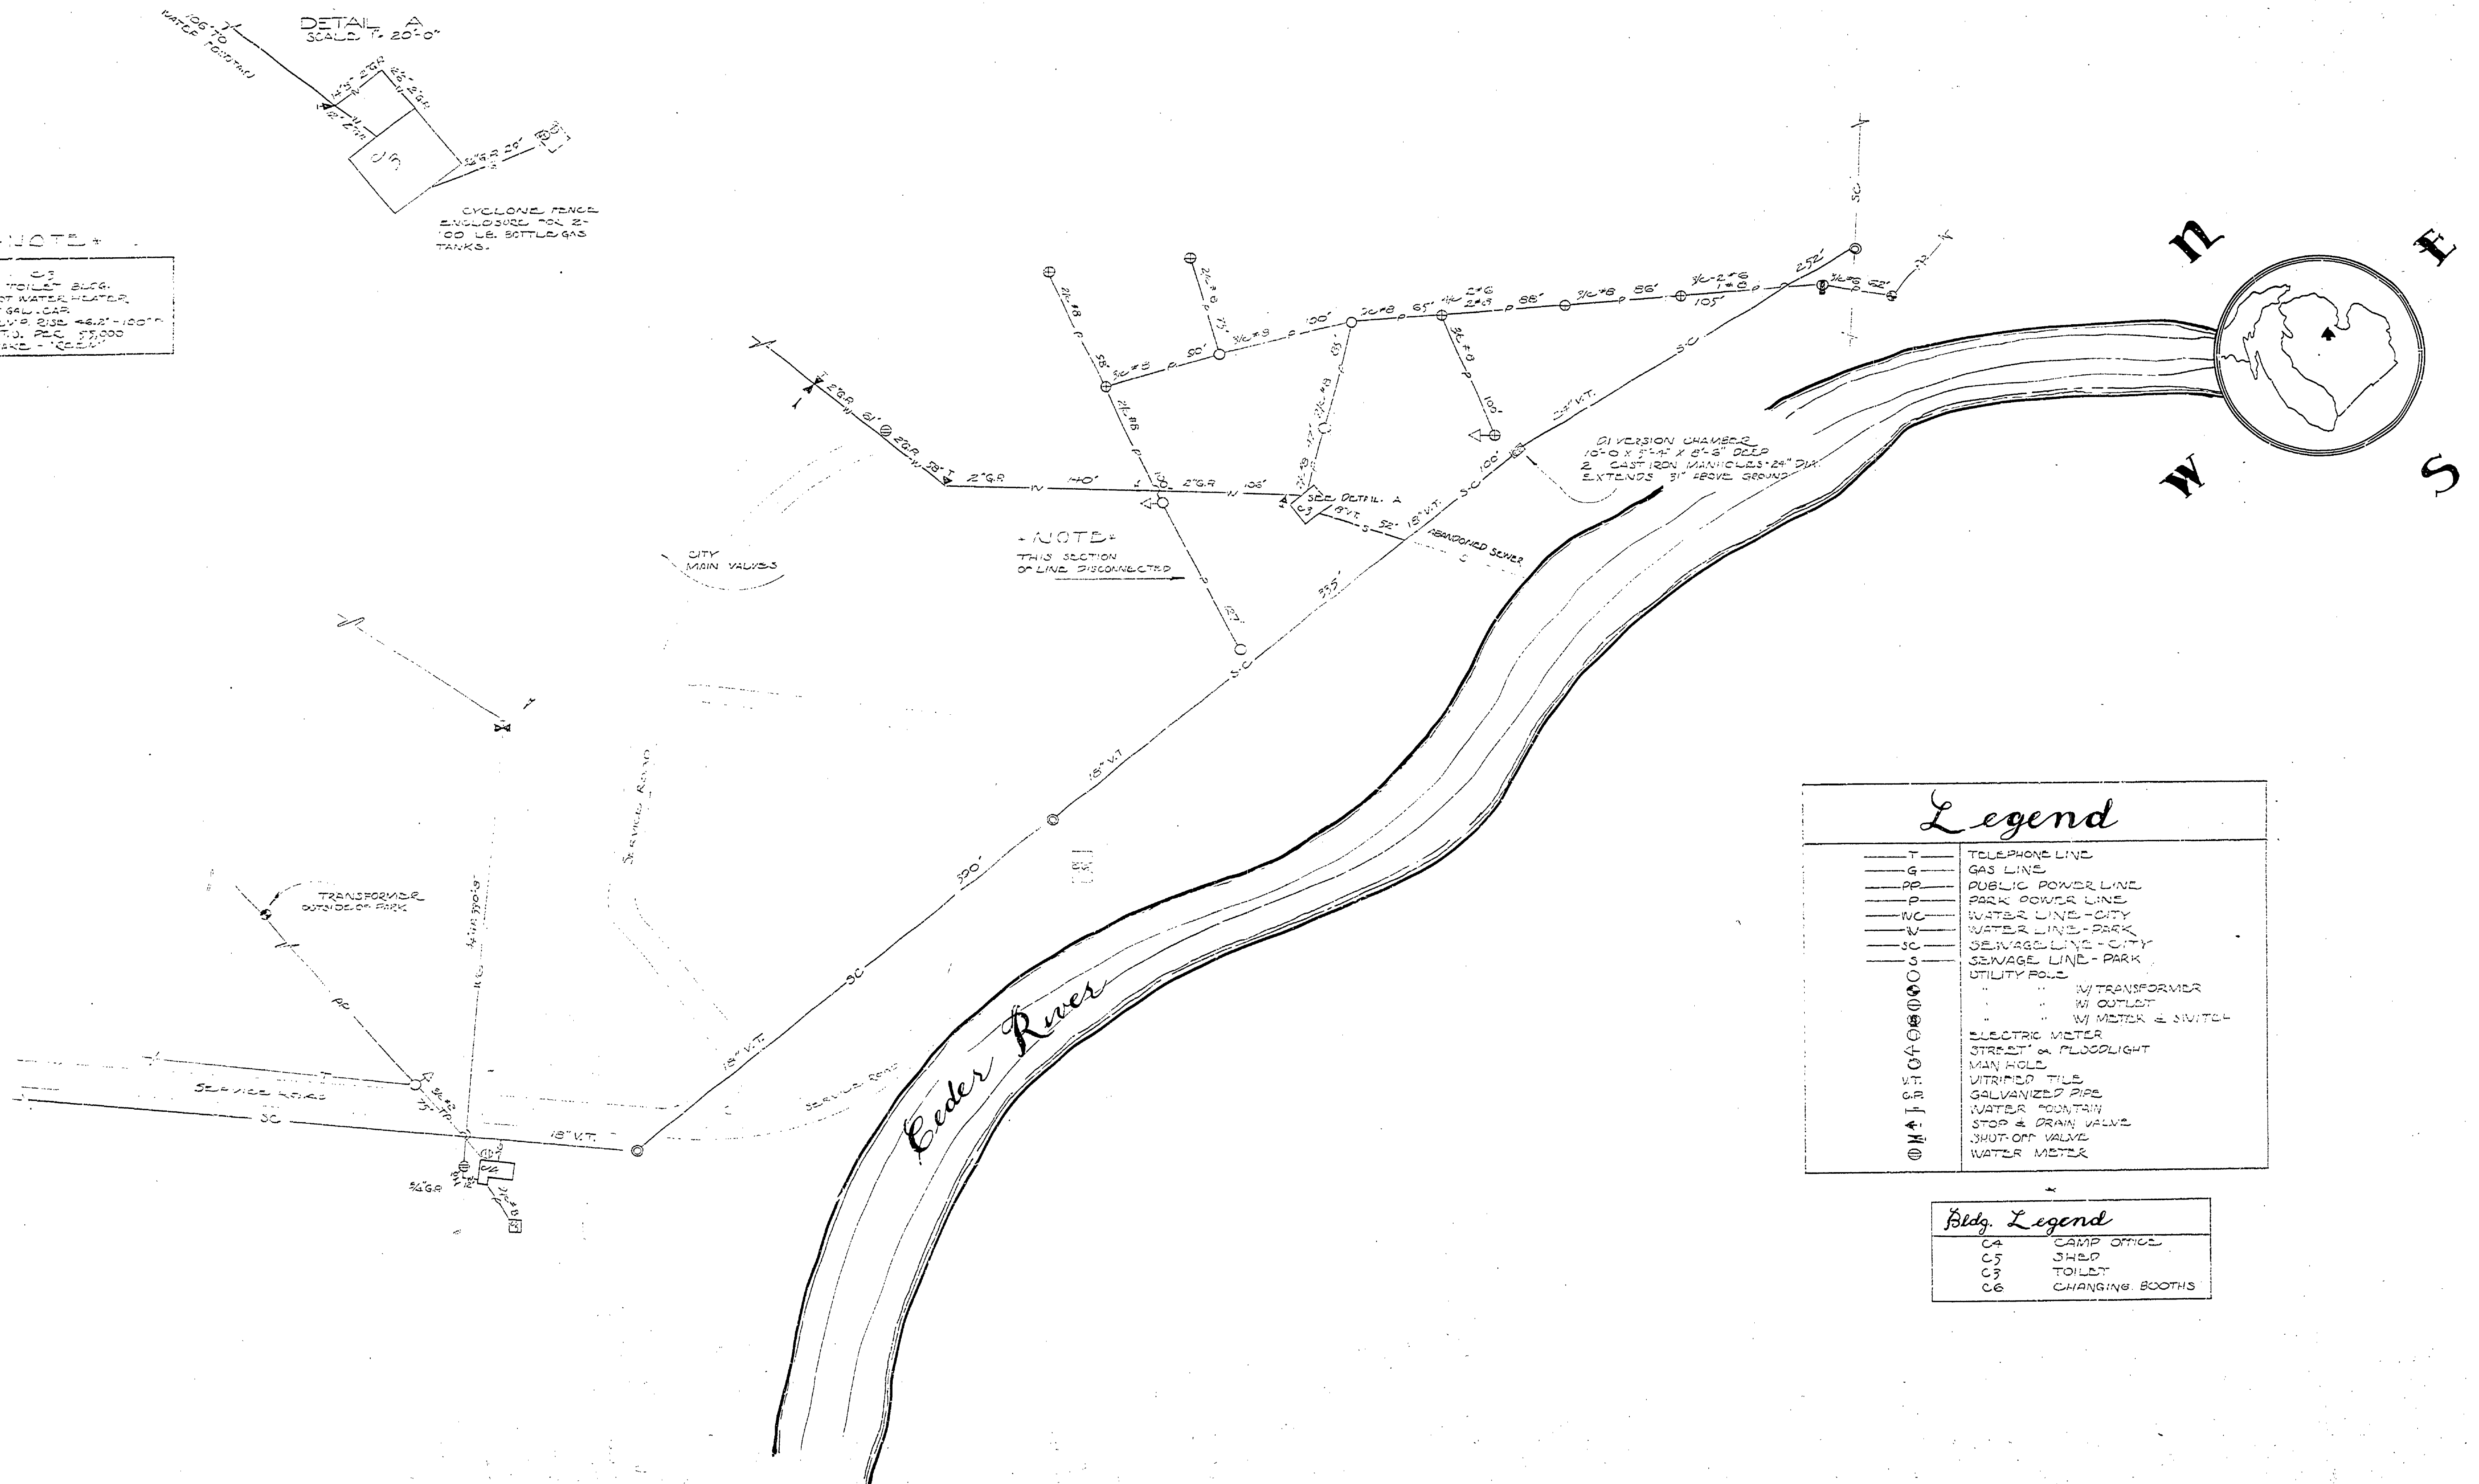

Legend	
—T—	TELEPHONE LINE
—G—	GAS LINE
—PP—	PUBLIC POWER LINE
—P—	PARK POWER LINE
—WC—	WATER LINE - CITY
—W—	WATER LINE - PARK
—SC—	SEWERAGE LINE - CITY
—S—	SEWERAGE LINE - PARK
—U—	UTILITY POLE
○	W/ TRANSFORMER
○	W/ OUTLET
○	W/ METER & SWITCH
○	ELECTRIC METER
○	STREET & FLOODLIGHT
○	MAN HOLE
○	VITRIFIED TILE
○	GALVANIZED PIPE
○	WATER FOUNTAIN
○	STOP & DRAIN VALVE
○	SHUT-OFF VALVE
○	WATER METER

Bldg. Legend	
CA	CAMP OFFICE
CS	J.H.S.P.
CT	TOILET
CG	CHANGING BOOTHS

MICHIGAN DEPARTMENT OF CONSERVATION PARKS AND RECREATION DIVISION

GLADWIN STATE PARK UTILITY MAP SCALE 1"=60'-0" POWER - WATER - GAS DISTRIBUTION SYSTEMS

SHEET NO. 1 OF 1

PLAN NO. U-1