

THIS B.M. CHECKS TO 0.04 TOO HIGH IN COMPARISON TO B.M. #10 & #11

BM#7 ELEV. 871.36  
TOP 1/2 PIPE AT INTERSECTION OF OLD BASELINE


BM#10 ELEV. 874.27  
CHISEL "D" ON NW CORNER CONC. PUMP SLAB (5'X5') AT E. CAMPGROUND, CENTER LOOP AT BLDG. SITE (CENTER WELL).

BM#11 ELEV. 887.40  
CHISEL "D" ON NE COR. CONC. SLAB (5'X5') AT W. CAMPGROUND, CENTER LOOP AT BLDG. SITE (CENTER WELL).

PLACE CONC. MARKERS (4" DIA X 24" LONG) MARKED WITH AN "E" AT ALL UNMARKED CHANGES IN ALIGNMENT.

ALL UNDERGROUND PRIMARY WILL HAVE 36" MIN. BURY.

ALL UNDERGROUND SECONDARY WILL HAVE 30" MIN. BURY.

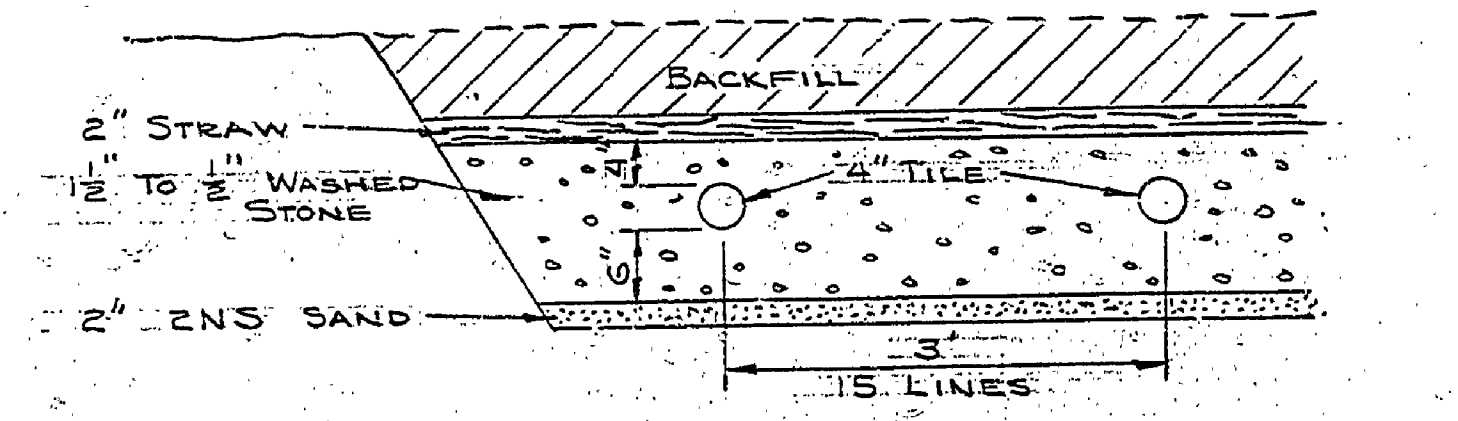

TILE FIELD DETAIL

PERCOLATION RATE 2" PER MIN.

WATER TABLE 5' BELOW TILE ELEV.

PLAN SCALE: 1"=50'

RE-MICROFILM

SURVEYED BY		DRAWN BY J. YPMA		2-72	NO. DATE BY		REVISIONS		NO. DATE BY		REVISIONS		MICHIGAN DEPARTMENT OF NATURAL RESOURCES		SEWER SYSTEM		CLEAR LAKE STATE PARK		PROJECT NO. 24-1203	
DESIGNED BY S. H. MERRILL		CHECKED BY		2-72	1. 9-74 G.M. AS BUILT PER B. GALLUP.				3.				SHEET TITLE		CAMPGROUND UTILITIES		SHEET 4 OF 4		PLAN NO. E-100	
DATE		DATE		2	DATE				4.											