

MAP
OF THE
VILLAGE OF
MIDDLESEX
OCEANA CO,
MICHIGAN.


Scale 200 feet to the inch.

Surveyed & Drawn by A. M. HIRSCH
C. Engineer - Chicago Ill.

Lots of Lot Model on Lake is on Sale Chicago.

D J S H I S A N

This Map Shows
 Property
 of
 Middlesex
 Oceana Co.

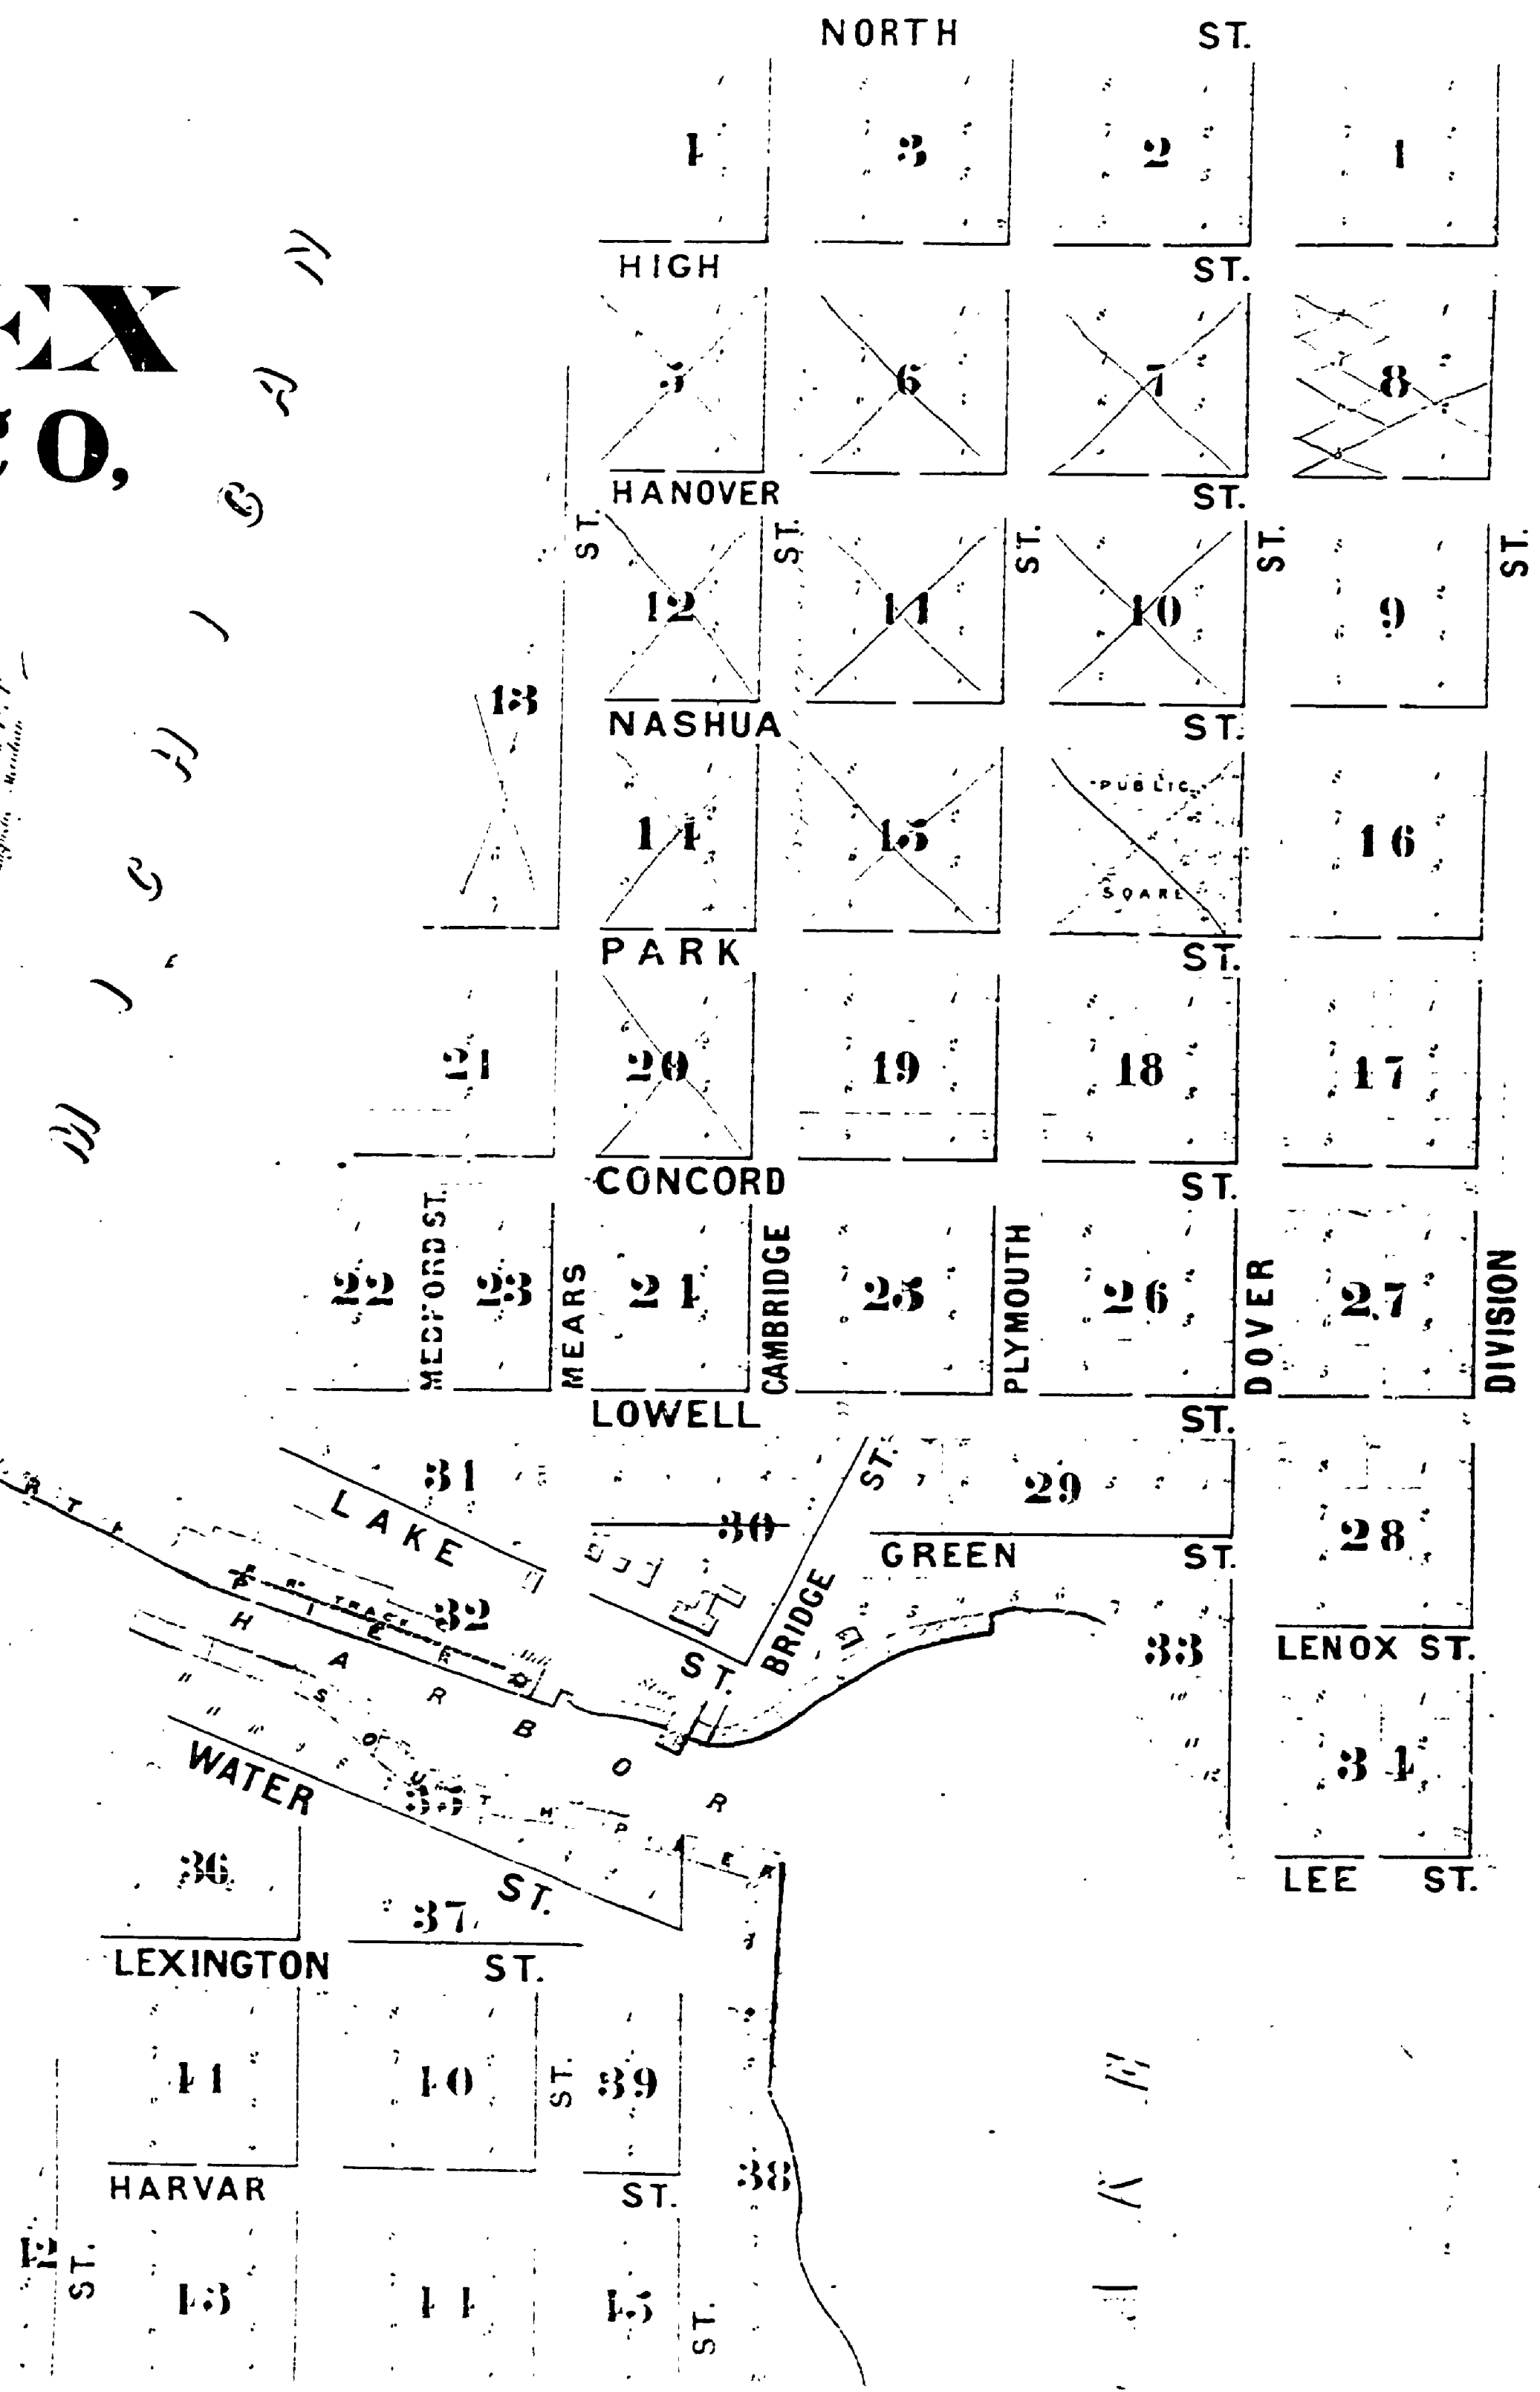

47

E-109