




C.S. 3+50 E.

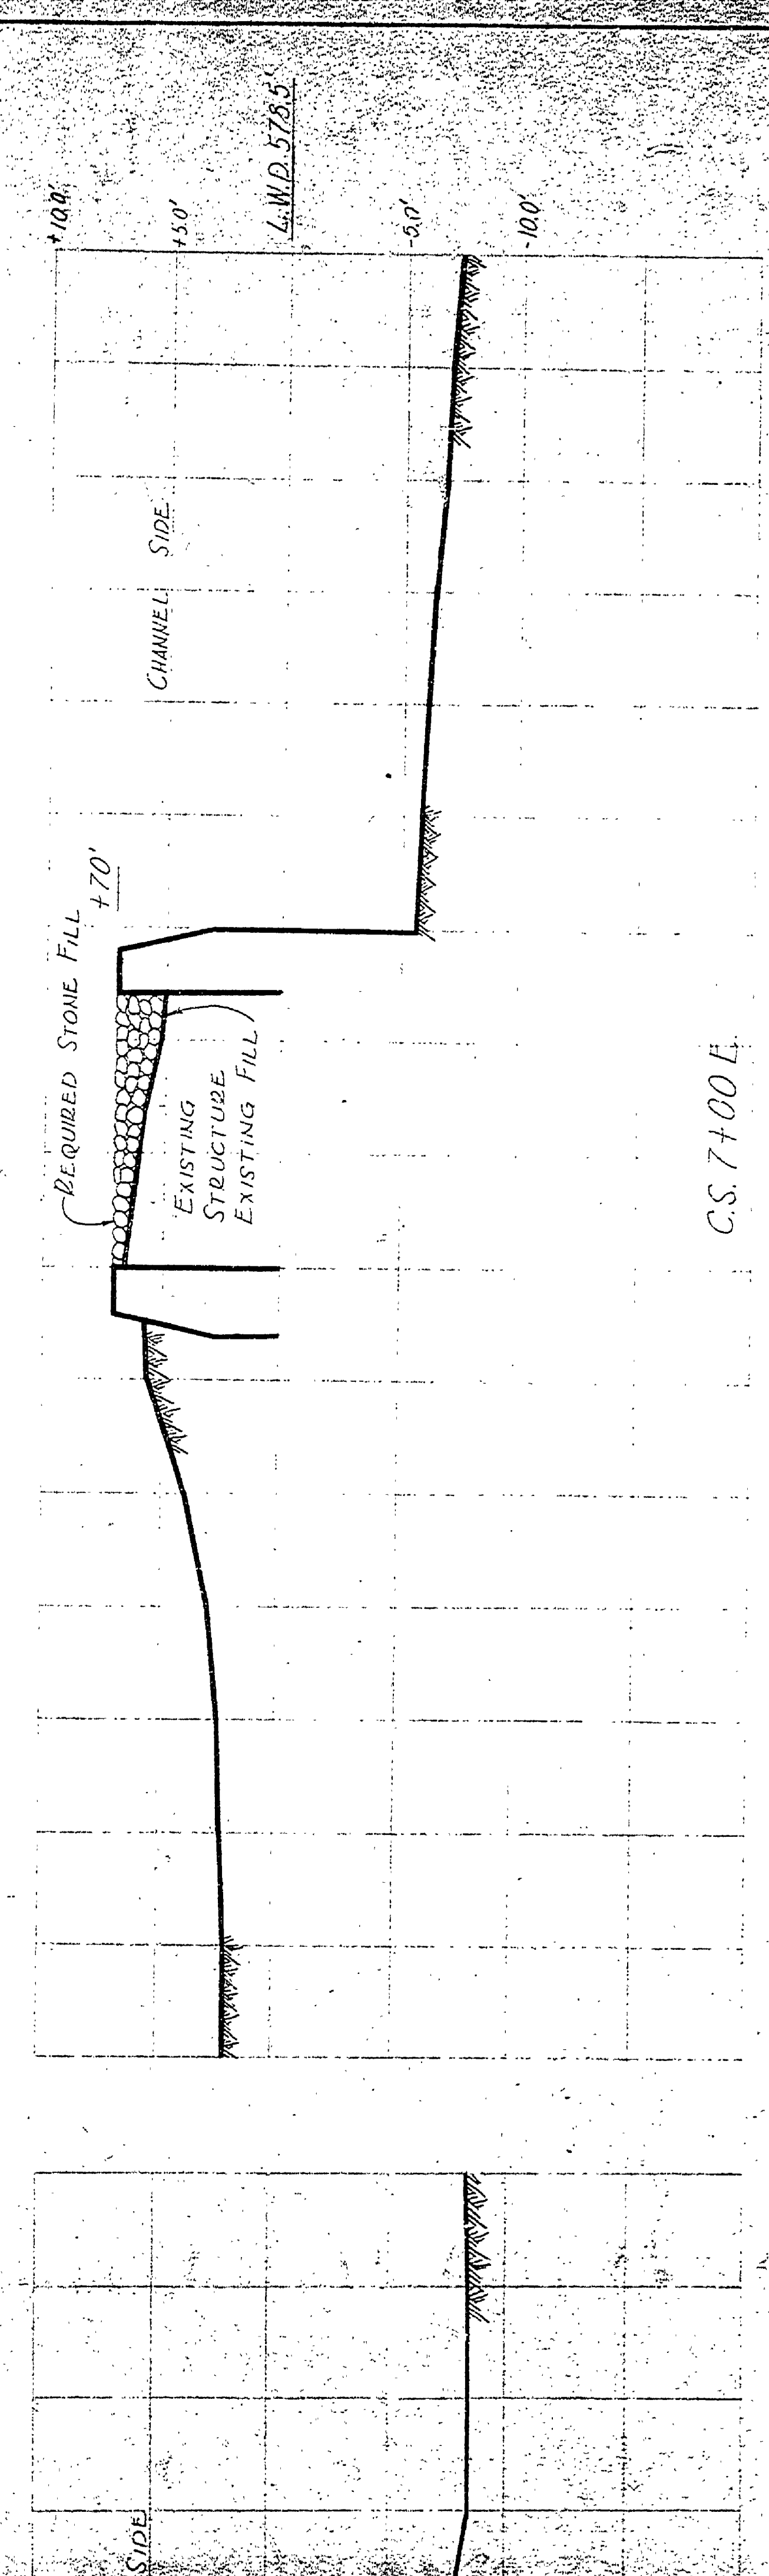

C.S. 7+00 E.

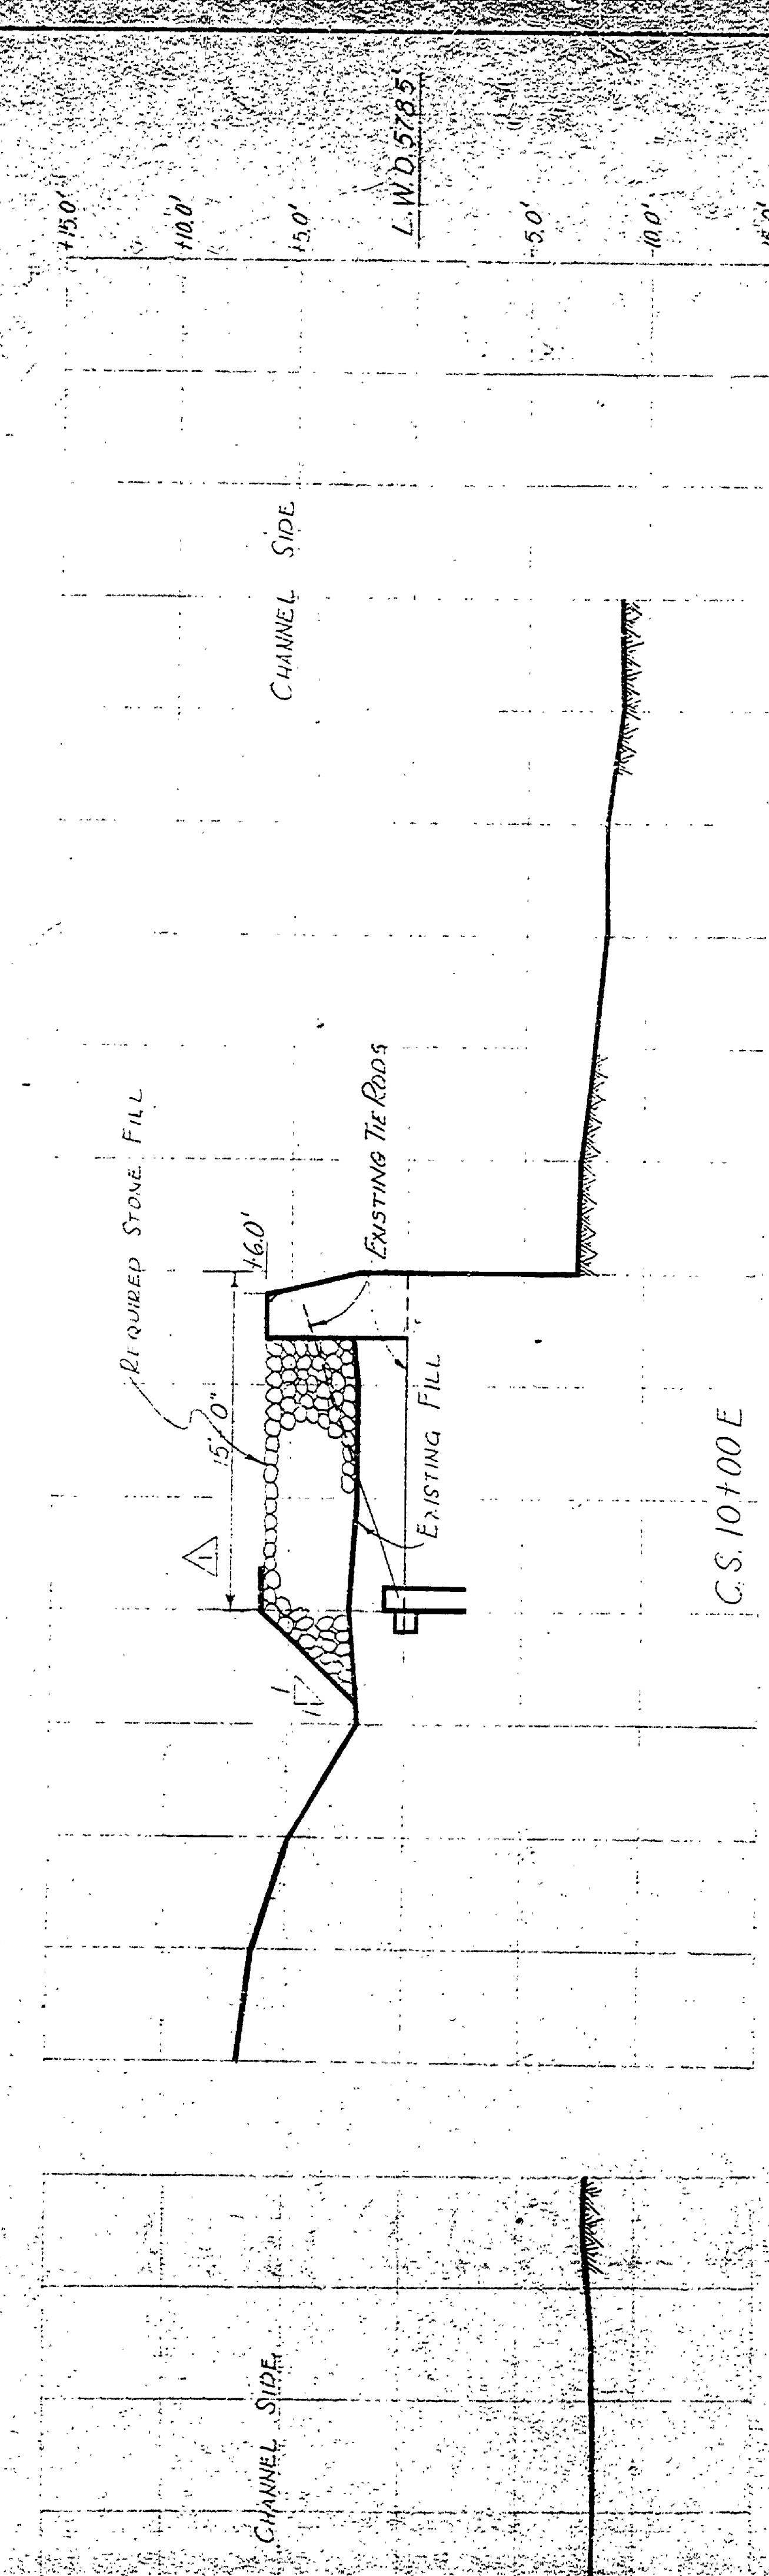

C.S. 10+00 E.

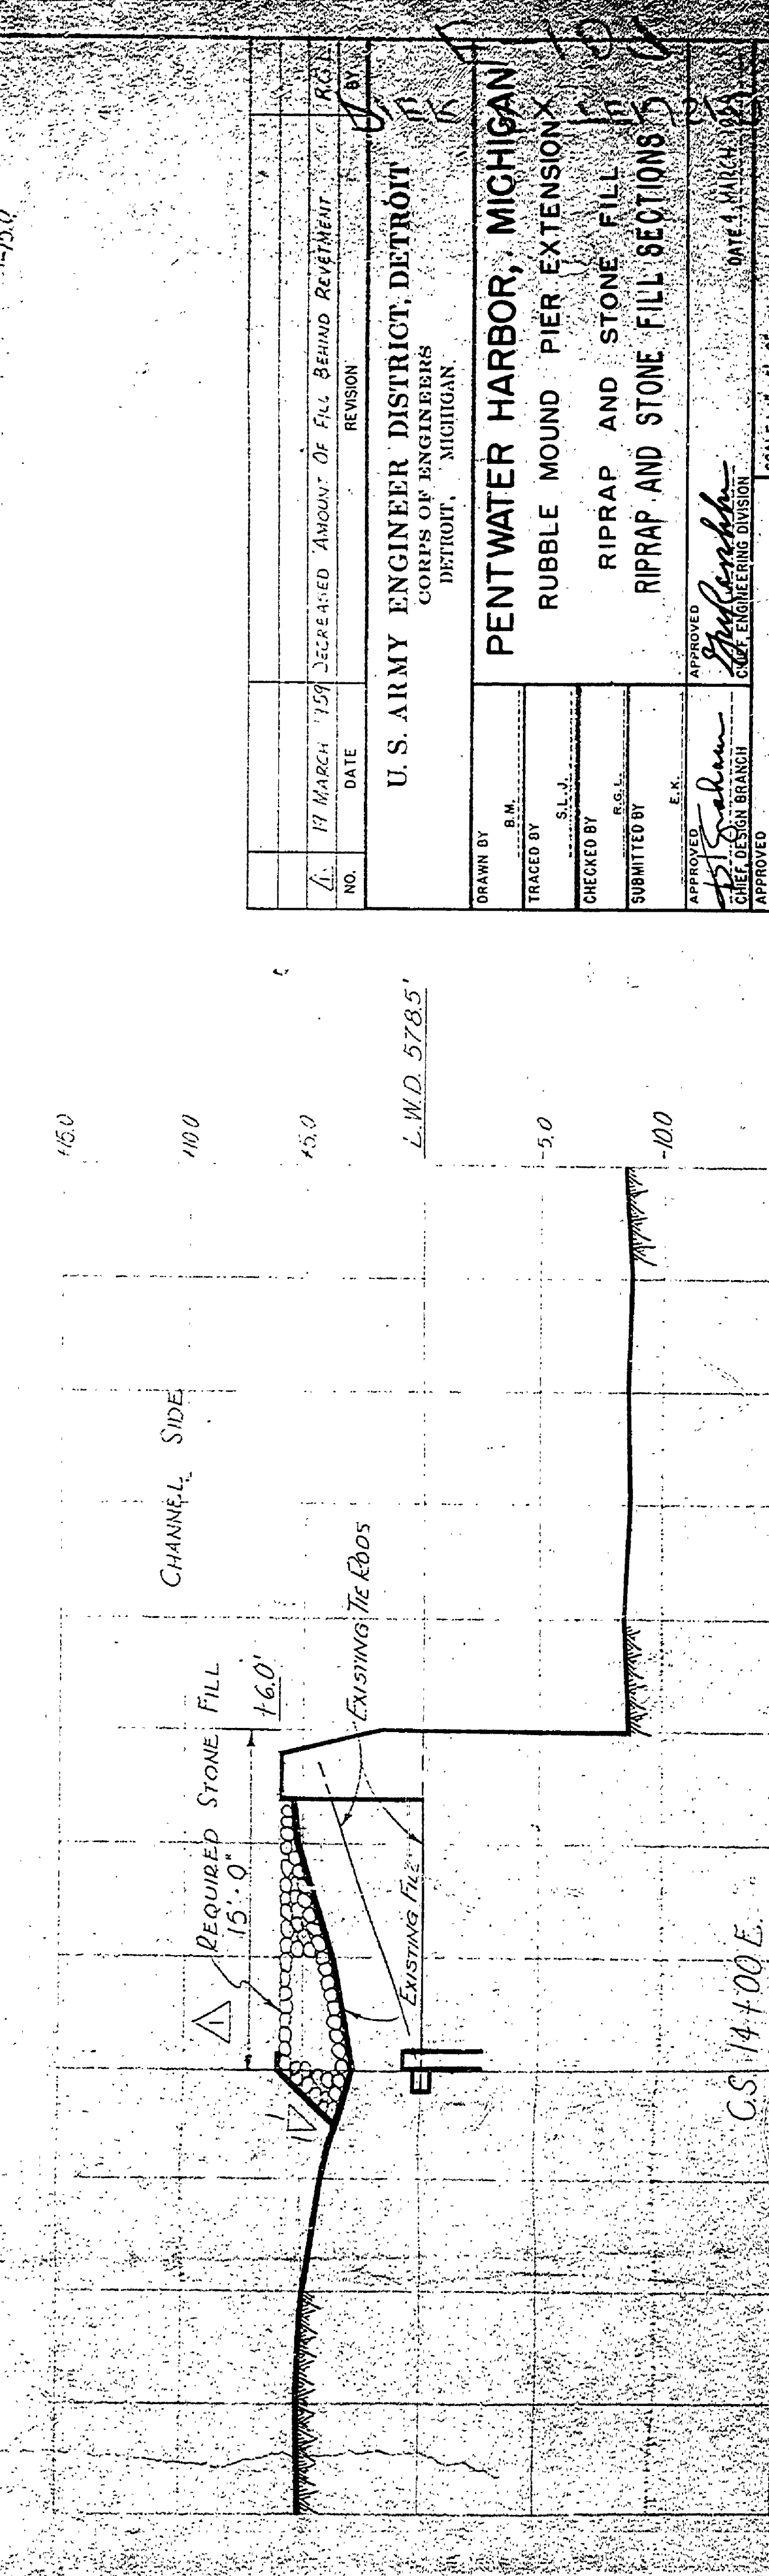

C.S. 14+00 E.

NO.	17	DATE	17 MARCH 1959	REVISION	1
DECREASED AMOUNT OF FILL BEHIND RETAINMENT					
U.S. ARMY ENGINEER DISTRICT, DETROIT CORPS OF ENGINEERS DETROIT, MICHIGAN					
DRAWN BY	P. J. [Signature]				
TRACED BY	[Signature]				
CHECKED BY	[Signature]				
SUBMITTED BY	[Signature]				
APPROVED	[Signature]				
PENTWATER HARBOR, MICHIGAN RUBBLE MOUND PIER EXTENSION RIPRAP AND STONE FILL RIPRAP AND STONE FILL SECTIONS					
SCALE: 1" = 8'-0"					
SHEET 4 OF 4					
DRAWING NO. 69-10-13					
DATE: 17 MARCH 1959					

E-109