

State of Michigan  
 County of Oceana  
 On this eighth Day of March A.D. 1860  
 before me the County Clerk of said County appeared Charles Meers the Proprietor of the above named Village of Middlesex and acknowledge that he caused the same to be laid out and plotted as above and for the use and purposes therein indicated and that same is of his own free will and deed  
 Alex. S. Anderson County Clerk L.S.

State of Michigan I hereby certify that I have surveyed for C. Meers Lots 2 and 3 and the S.W. fractional of section 14 the front Sec 15 Lot 1 of Sec 22 and Lot 3 of Sec 33 Town 14 North of Range 18 West in Michigan and that I subdivided the above described lands into Block Lots and Streets and that the above Map is a true and correct representation of said survey


A. M. Hirsch  
 C. Engineer  
 A true copy  
 Fred J. Russell  
 Deputy Register

Scale 200 feet to the inch

Surveyed & Drawn by A. W. Hirsch C. Engineer Ill.

High of Ed Mundel cor Lake & La Salle Chicago

11953

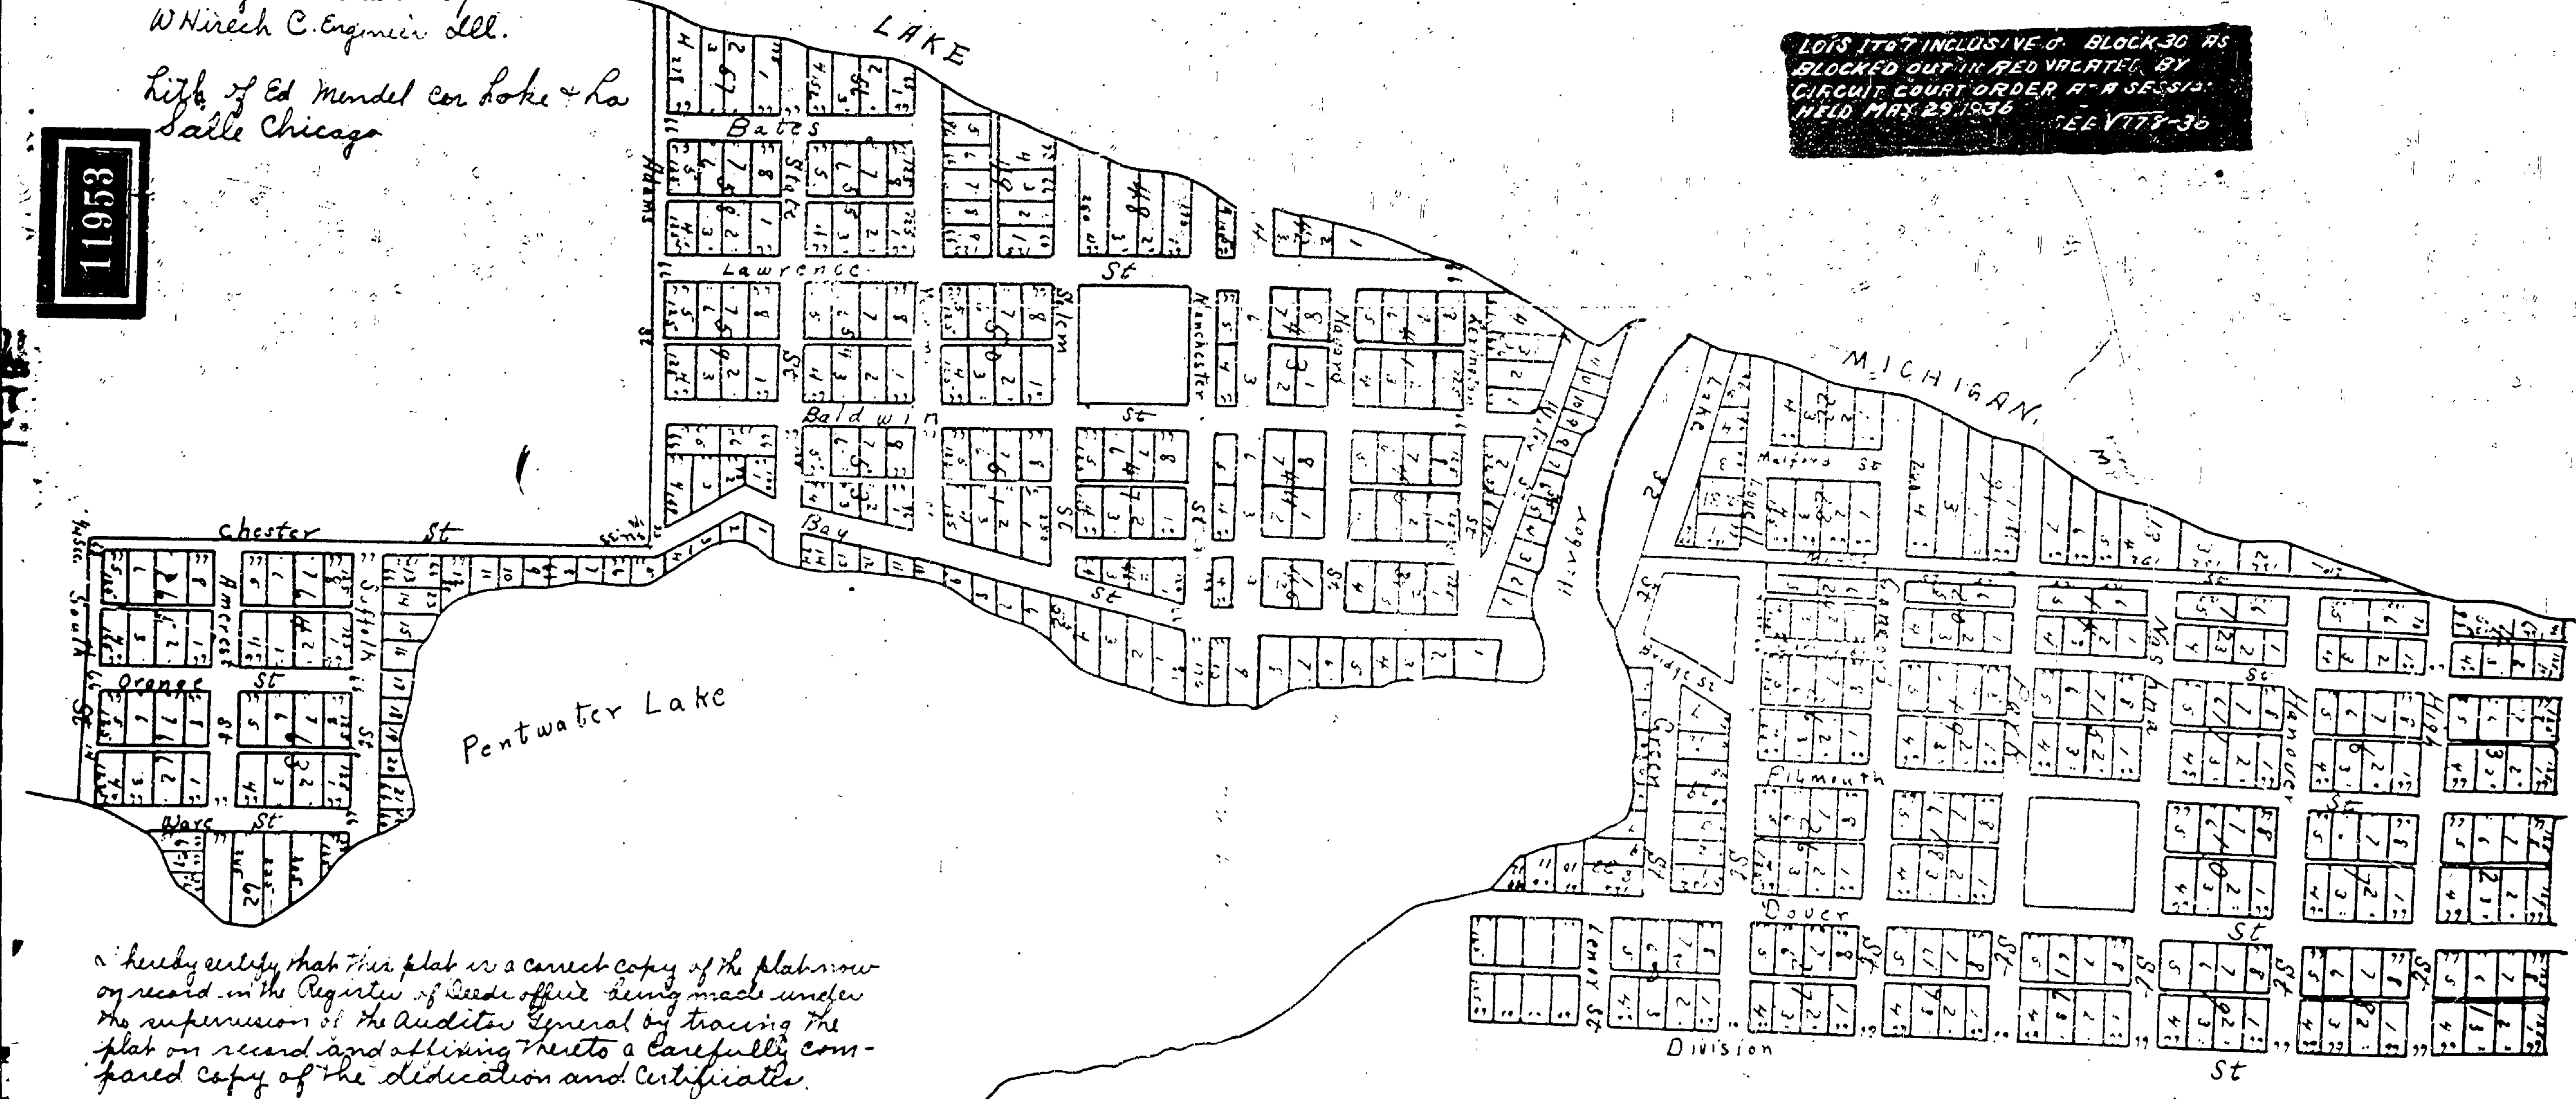

LOTS 1 TO 7 INCLUSIVE OF BLOCK 30 AS BLOCKED OUT IN RED VACATED BY CIRCUIT COURT ORDER AT A SESSION HELD MAY 29, 1936 SEE V773-36

I hereby certify that this plat is a correct copy of the plat now on record in the Register of Deeds office being made under the supervision of the Auditor General by tracing the plat on record and affixing thereto a carefully compared copy of the dedication and certificate.

Dated this 17th day of August 1911  
 John B. Fountain  
 Clerk and Ex. Secy

Alley in block 30 discontinued by resolution of the Common Council of Pentwater dated May 17, 1935 see 1220-36