
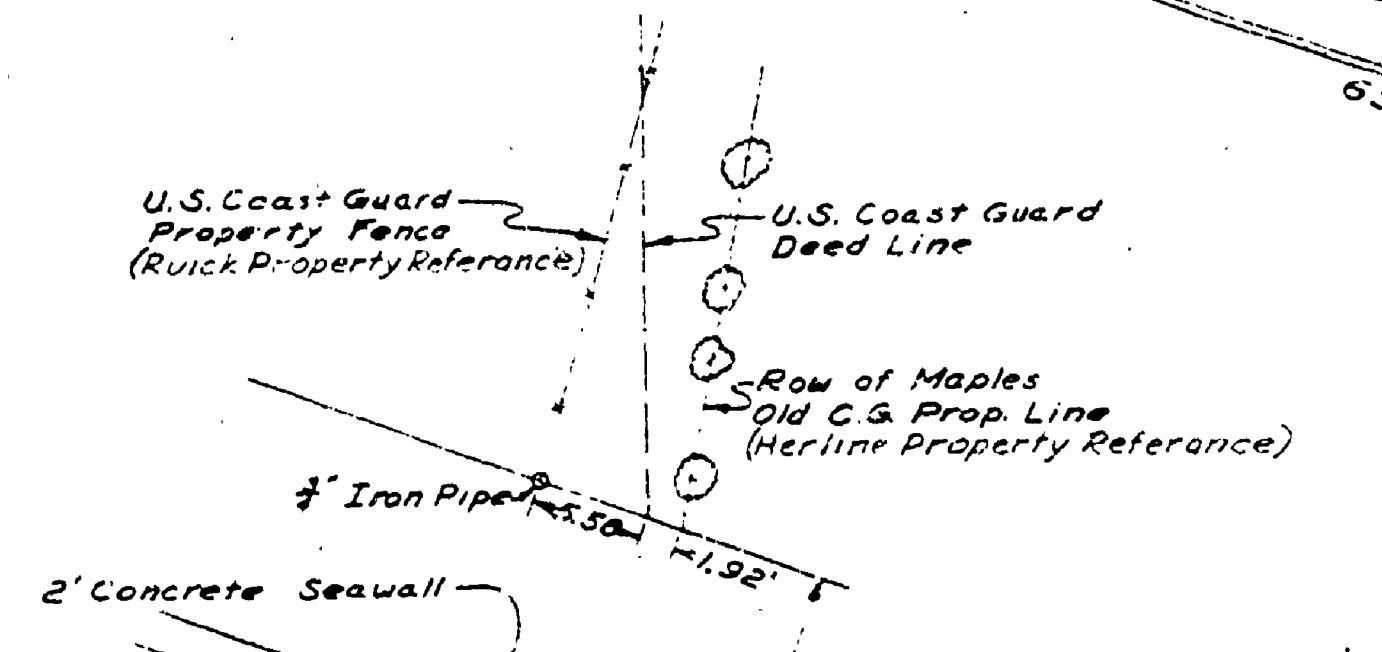


9-18-20  
 9-20-20  
 9-21-20  
 9-22-20  
 9-23-20  
 9-24-20  
 9-25-20  
 9-26-20  
 9-27-20  
 9-28-20  
 9-29-20  
 9-30-20  
 10-1-20  
 10-2-20  
 10-3-20  
 10-31-20  
 11-1-20  
 11-2-20  
 11-3-20  
 11-31-20  
 12-1-20  
 12-2-20  
 12-3-20  
 12-31-20

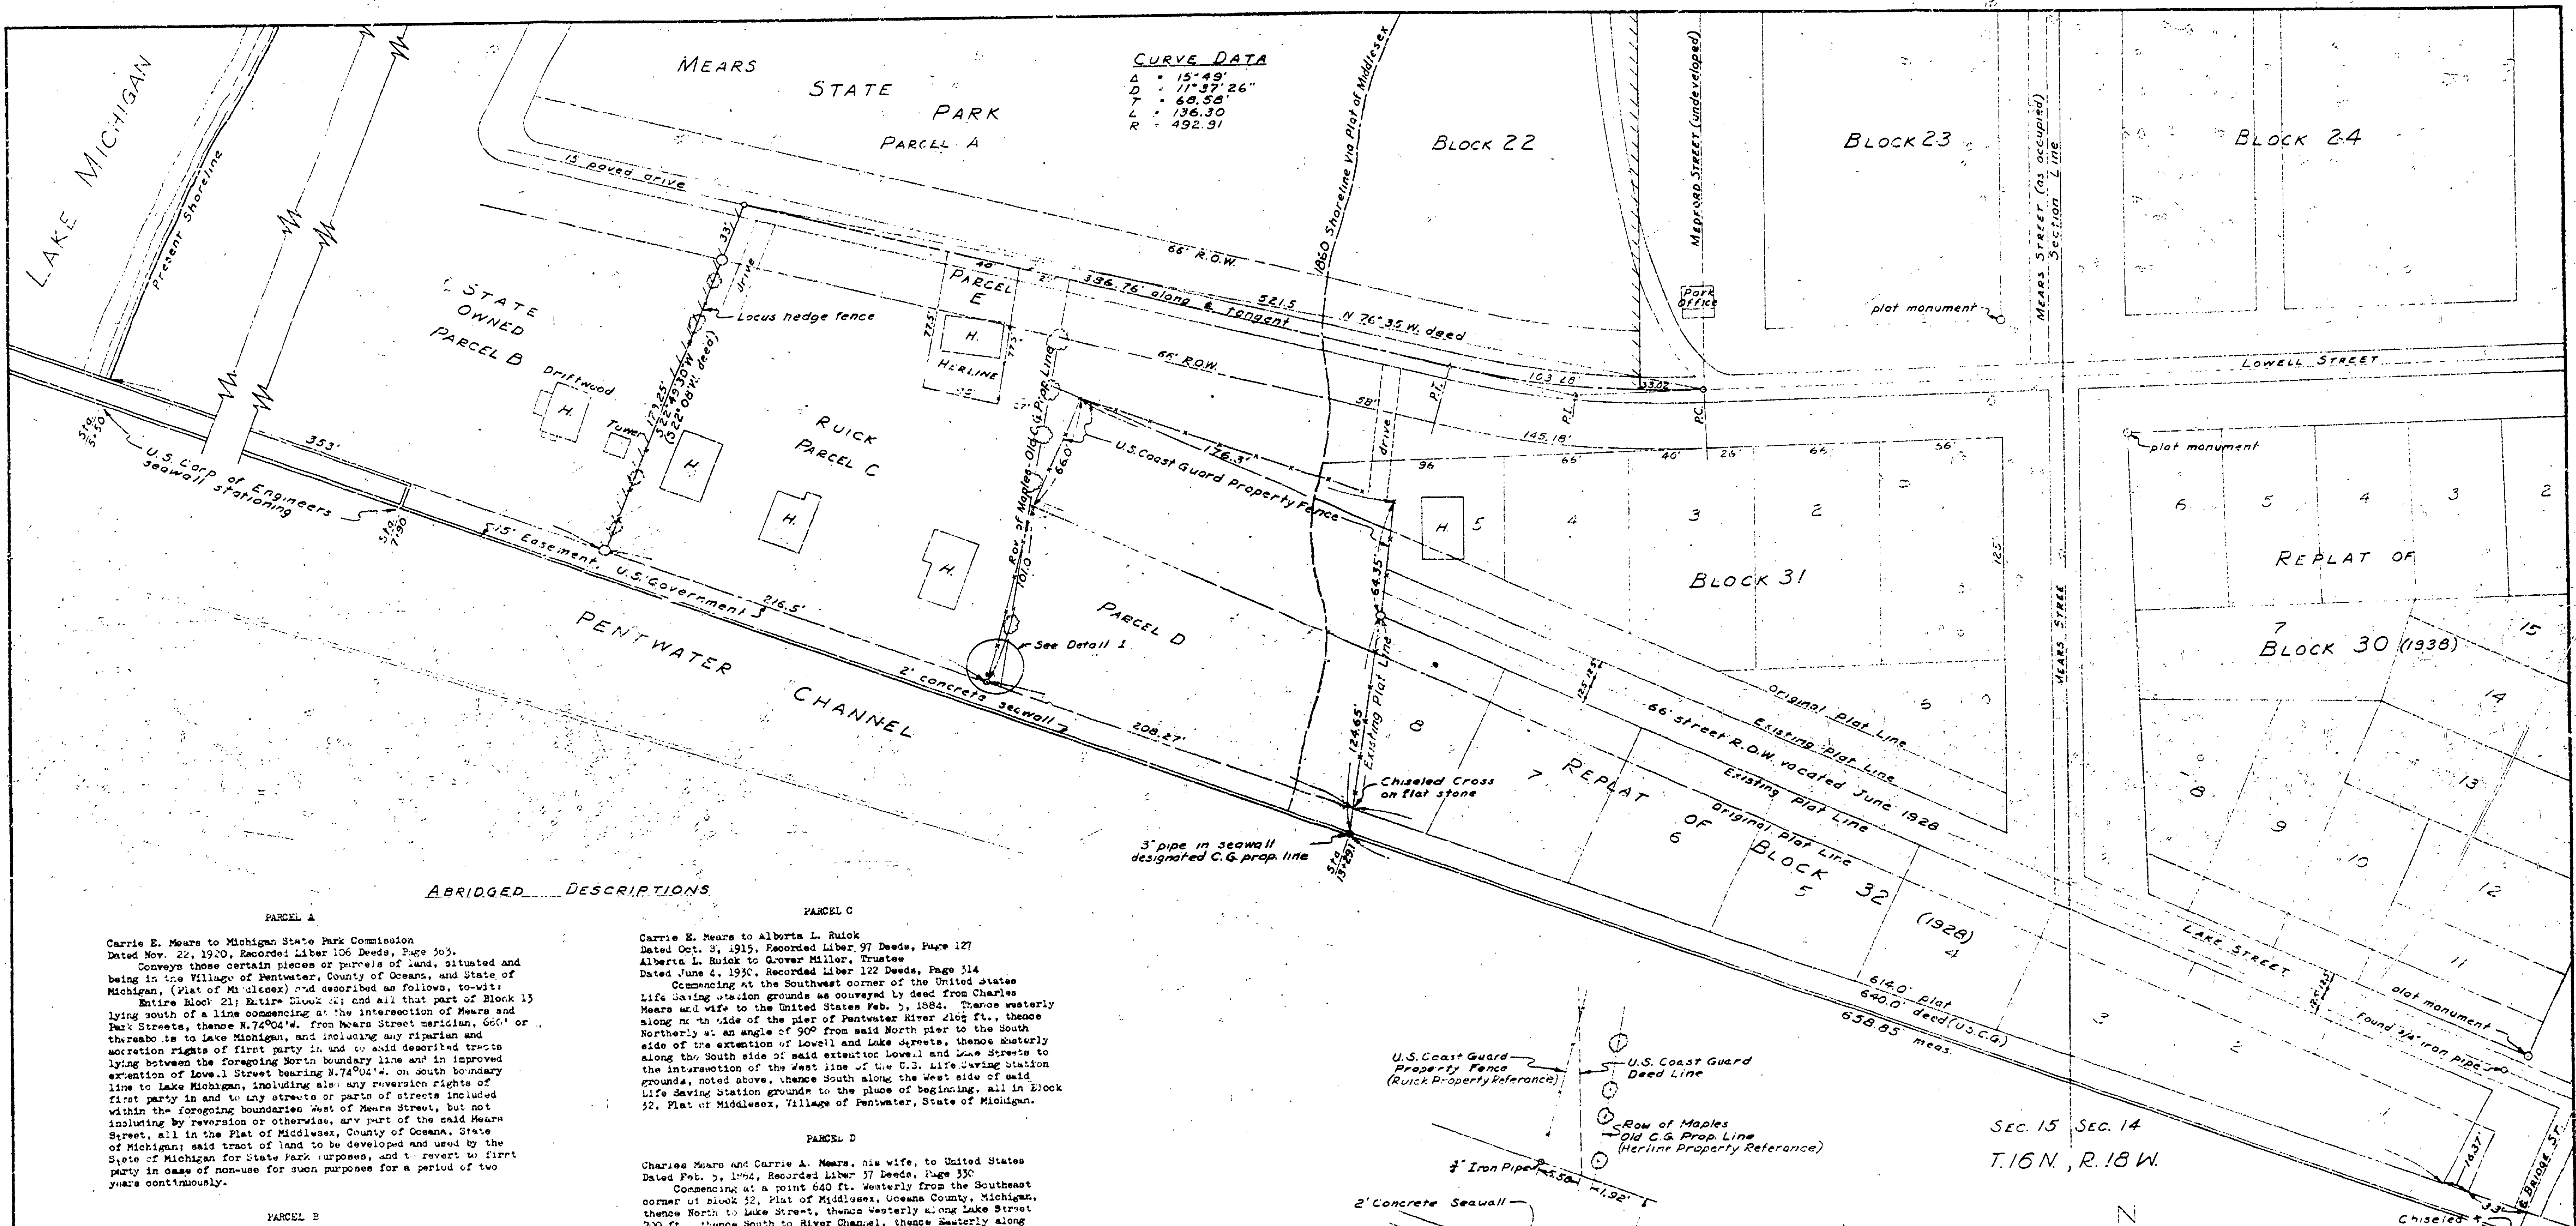

**LEGEND**  
 Survey Point  
 Plat Mon.  
 4" Iron Pipe with Brass Cap  
 Tree  
 State Park Boundary  
 Fence  
 House

SCALE 1"=40'

SEC. 15 SEC. 14  
 T. 16 N., R. 18 W.

MICHIGAN DEPARTMENT OF CONSERVATION ENGINEERING AND ARCHITECTURE		240
MEARS STATE PARK BOUNDARY SURVEY PROPERTY DETAILS		
PARKS DIVISION		OCEANA COUNTY
APPROVED	<i>Richard Herline</i>	PLAN X64B-1
APPROVED		SHEET 2 OF 2
APPROVED		REVISION
SURVEYED BY	W. J. PADDISQUILL	7-23
DESIGNED BY	W. J. PADDISQUILL	8-23
CHECKED BY		

X64B-1