


|                  |                        |                 |                      |             |           |             |                           |           |           |     |      |      |    |
|------------------|------------------------|-----------------|----------------------|-------------|-----------|-------------|---------------------------|-----------|-----------|-----|------|------|----|
| DRAWN BY<br>V.P. | CHECKED BY<br>E. J. P. | DATE<br>12-7-50 | REVIEWED BY SECTIONS |             |           | APPROVED BY |                           |           | REVISIONS |     |      | DATE | BY |
|                  |                        |                 | ARCHITECTURAL        | ENGINEERING | LANDSCAPE | DATE        | ASSISTANT CHIEF IN CHARGE | OF DESIGN | DATE      | NO. | DATE |      |    |
|                  |                        |                 |                      |             |           |             |                           | 1         |           |     | 4    |      |    |
|                  |                        |                 |                      |             |           |             |                           | 2         |           |     | 5    |      |    |
|                  |                        |                 |                      |             |           |             |                           | 3         |           |     | 6    |      |    |

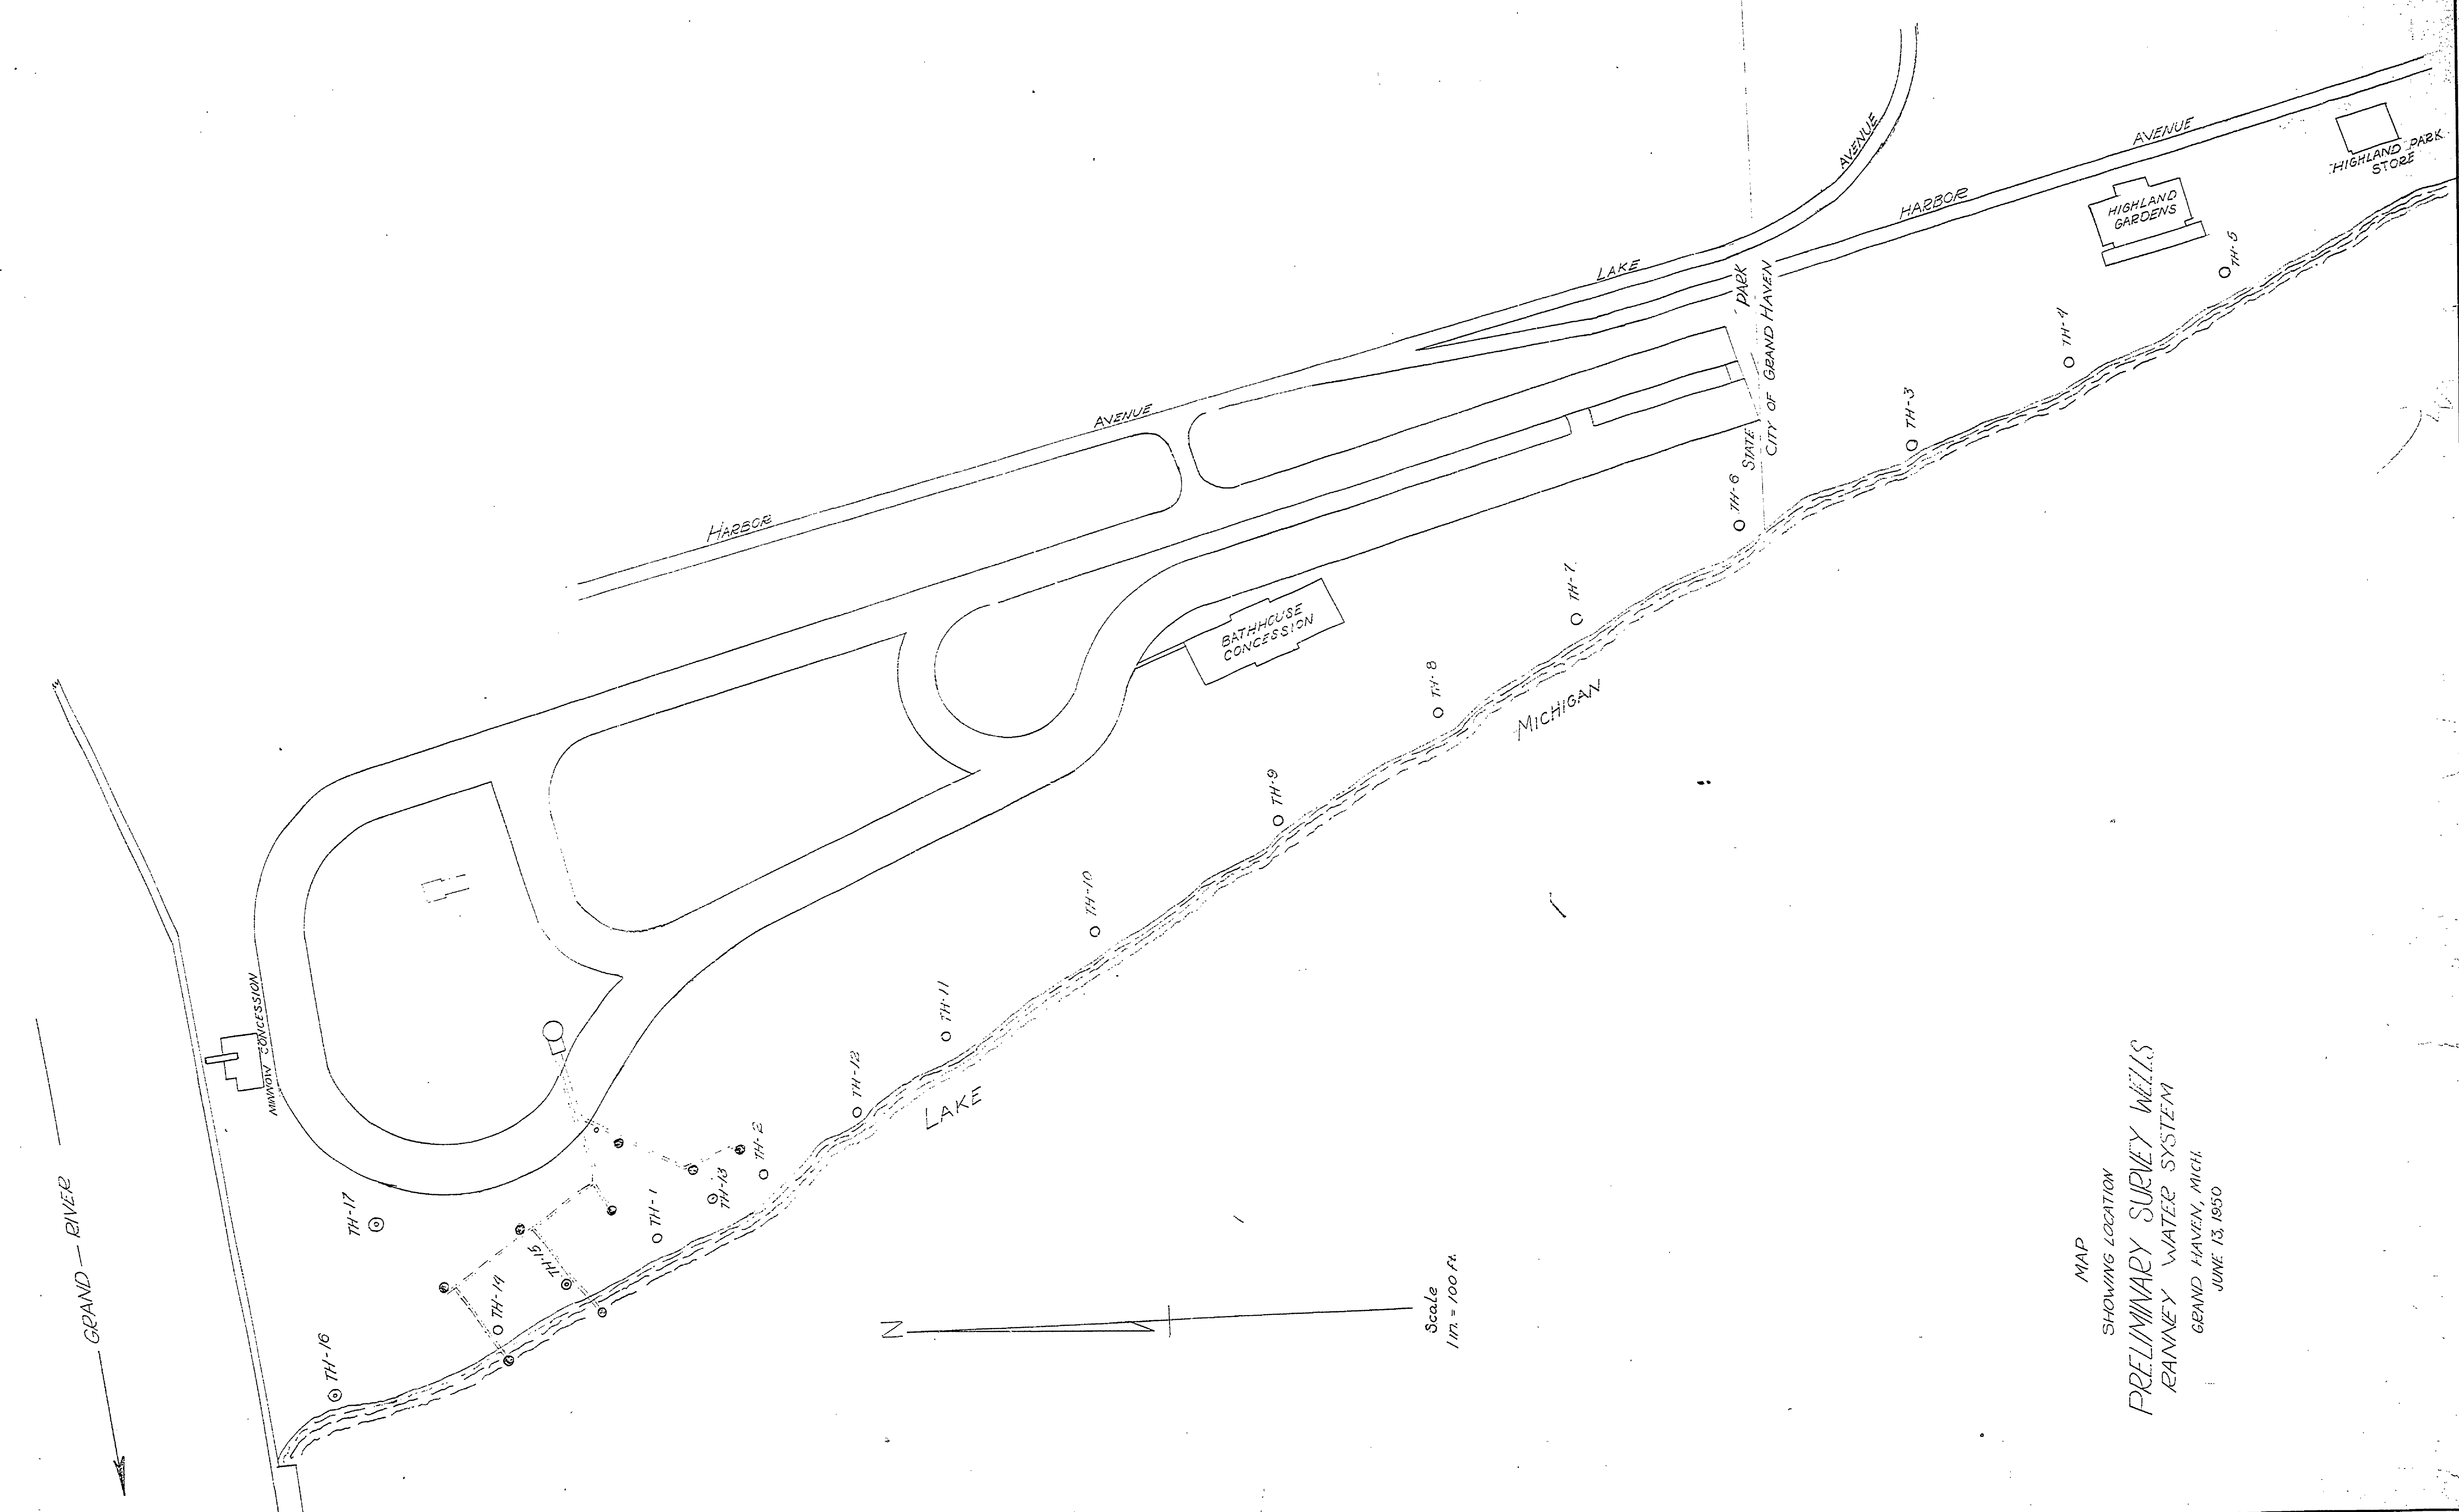

MAP  
SHOWING LOCATION  
PRELIMINARY SURVEY WELLS  
RAINEY WATER SYSTEM  
GRAND HAVEN, MICH.  
JUNE 13, 1950

MICHIGAN  
DEPARTMENT OF CONSERVATION  
PARKS AND RECREATION DIVISION

GRAND HAVEN STATE PARK  
TEST WELL LOCATION  
CITY OF GRAND HAVEN

SHEET  
NO. 1  
OF 1  
PLAN NO.  
E-101