


DESIGNED BY	DATE	REVIEWED	DATE	APPROVED	DATE	NO.	DATE	BY	REVISIONS	DATE	BY
Murray	7-11	ARCHITECTURAL				1			4		
		ENGINEERING				2			5		
		LANDSCAPE				3			6		



LAKE MICHIGAN

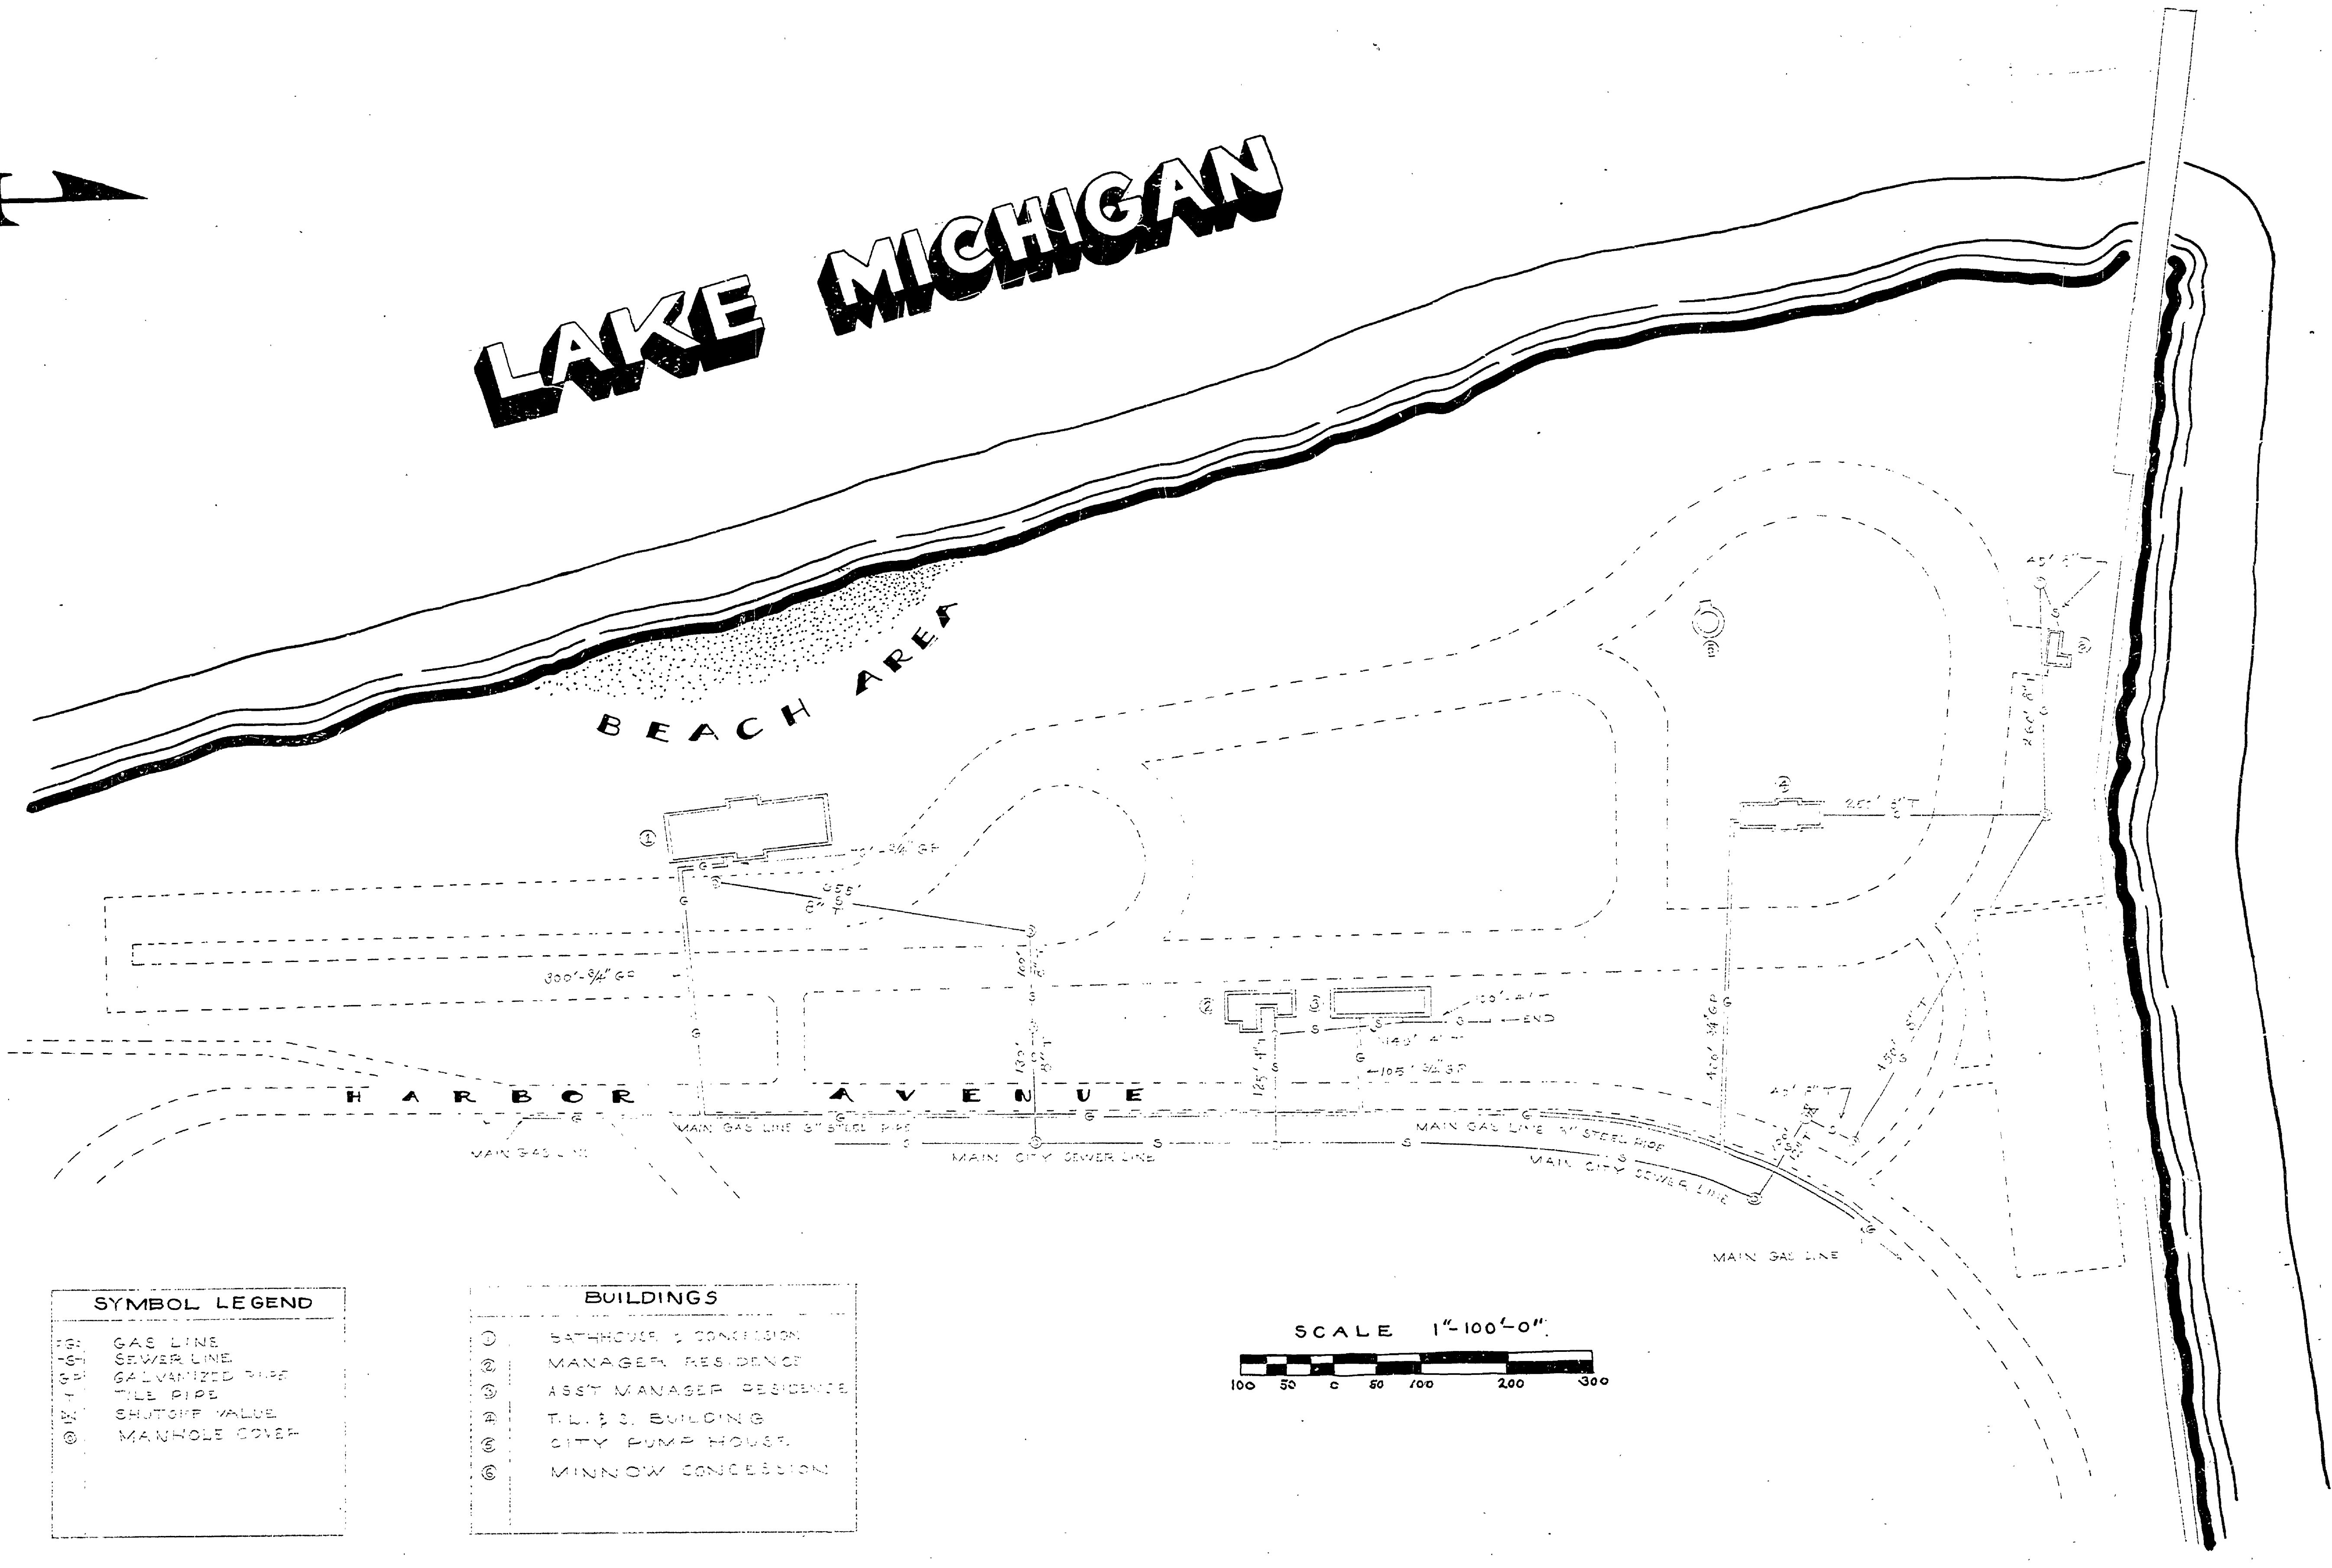


SYMBOL LEGEND

---	GAS LINE
- - -	SEWER LINE
· · ·	GALVANIZED PIPE
· · ·	TILE PIPE
○	SHUTOFF VALVE
○	MANHOLE COVER

BUILDINGS

①	BATHHOUSE & CONCESSION
②	MANAGER RESIDENCE
③	ASST. MANAGER RESIDENCE
④	T.L. & J. BUILDING
⑤	CITY PUMP HOUSE
⑥	MINNOW CONCESSION

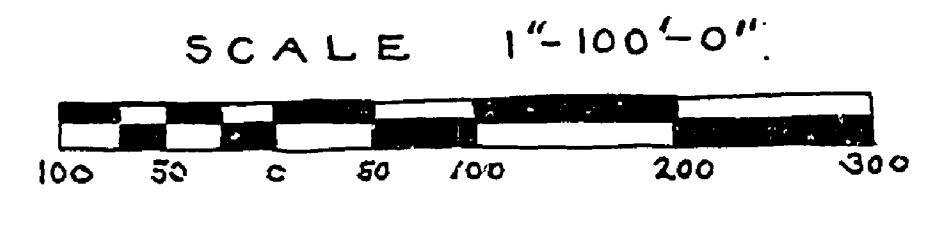

GRAND RIVER CHANNEL

GRAND HAVEN STATE PARK

MICHIGAN
DEPARTMENT OF CONSERVATION
PARKS AND RECREATION DIVISION

GRAND HAVEN STATE PARK
UTILITY MAP
GAS & SEWER SYSTEM

SHEET
NO. 3
OF 3

PLAN NO.
0-1