


DESIGNED BY BPH	REVIEWED BY SECTIONS ARCHITECTURAL E.F.H. ENGINEERING H.M.P./P.H.H. LANDSCAPE D.A.O.	APPROVED BY [Signature]	NO. DATE BY REVISIONS
TRACED BY [Signature]	DATE 10/28/46	DATE 10/28/46	1 10/28/46 [Signature] Revise floor plan 4
CHECKED BY [Signature]	DATE 10/28/46	DATE 10/28/46	2 10/28/46 [Signature] 5
DATE 10/28/46	DATE 10/28/46	DATE 10/28/46	3 10/28/46 [Signature] 6

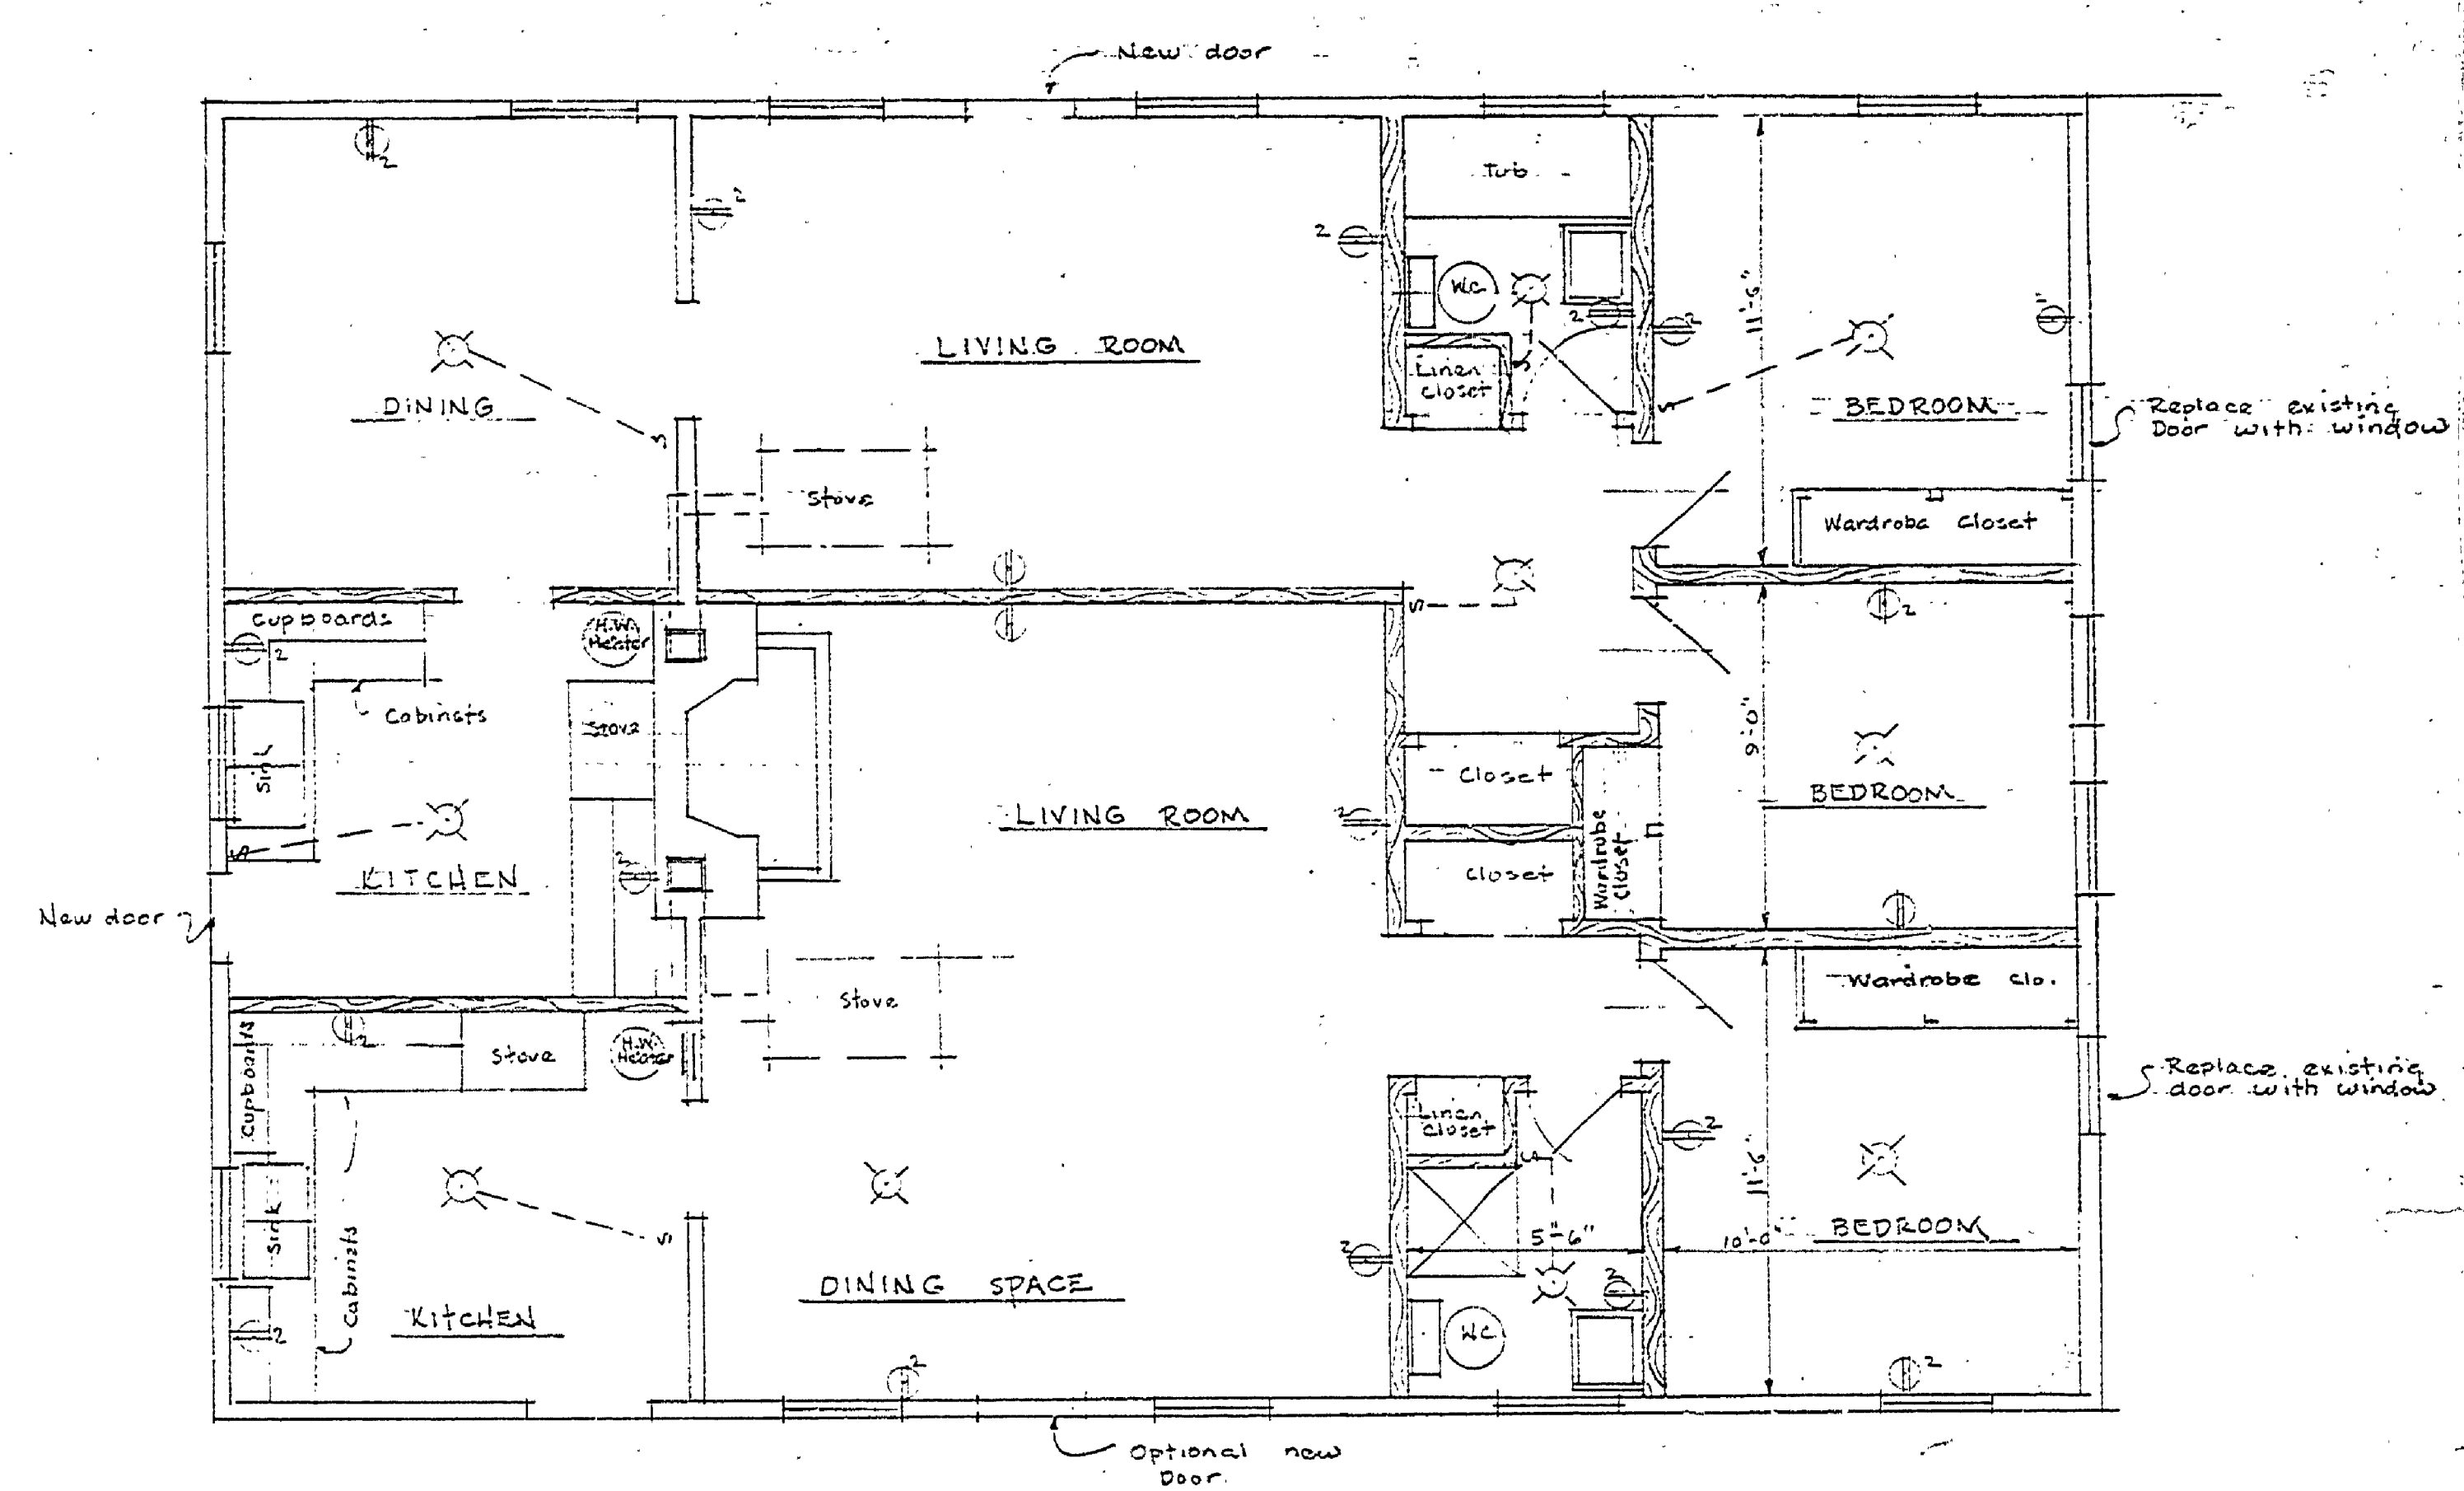

REVISED FLOOR PLAN
Scale: 1/4" = 1'-0"

EXISTING WALLS
NEW PARTITIONS

INSURANCE No. 3 PARTIAL REVISION OF SHEET 1 of 2

MICHIGAN
DEPARTMENT OF CONSERVATION
STATE PARKS DIVISION

REMODELING OF GROUP CAMP
BUILDING FOR HELPS QTRS.
BAY CITY STATE PARK

SHEET
NO. 1
OF 1

PLAN NO.
A-97a