

REVISIONS	DATE	BY
4		
5		
6		

NO.	DATE	BY	APPROVED BY
1	10-23-50	E.H.R.	
2	10-27-50	E.H.R.	
3			


REVIEWED BY SECTIONS	DATE	APPROVED BY
ARCHITECTURAL	9-8-50	
ENGINEERING	H.C.M.	
LANDSCAPE	J.T.R.	



DRAWN BY	CHECKED BY	DATE
G.H.A.L.I.K.	E.J.P.	8-1-50


NO.	DATE	BY	REVISIONS
1	10-23-50	E.H.R.	Stops Wash Wall floor
2	10-27-50	E.H.R.	Revis. location of line from filters
3			
4			
5			
6			




SWITCH PANEL  
NO SCALE

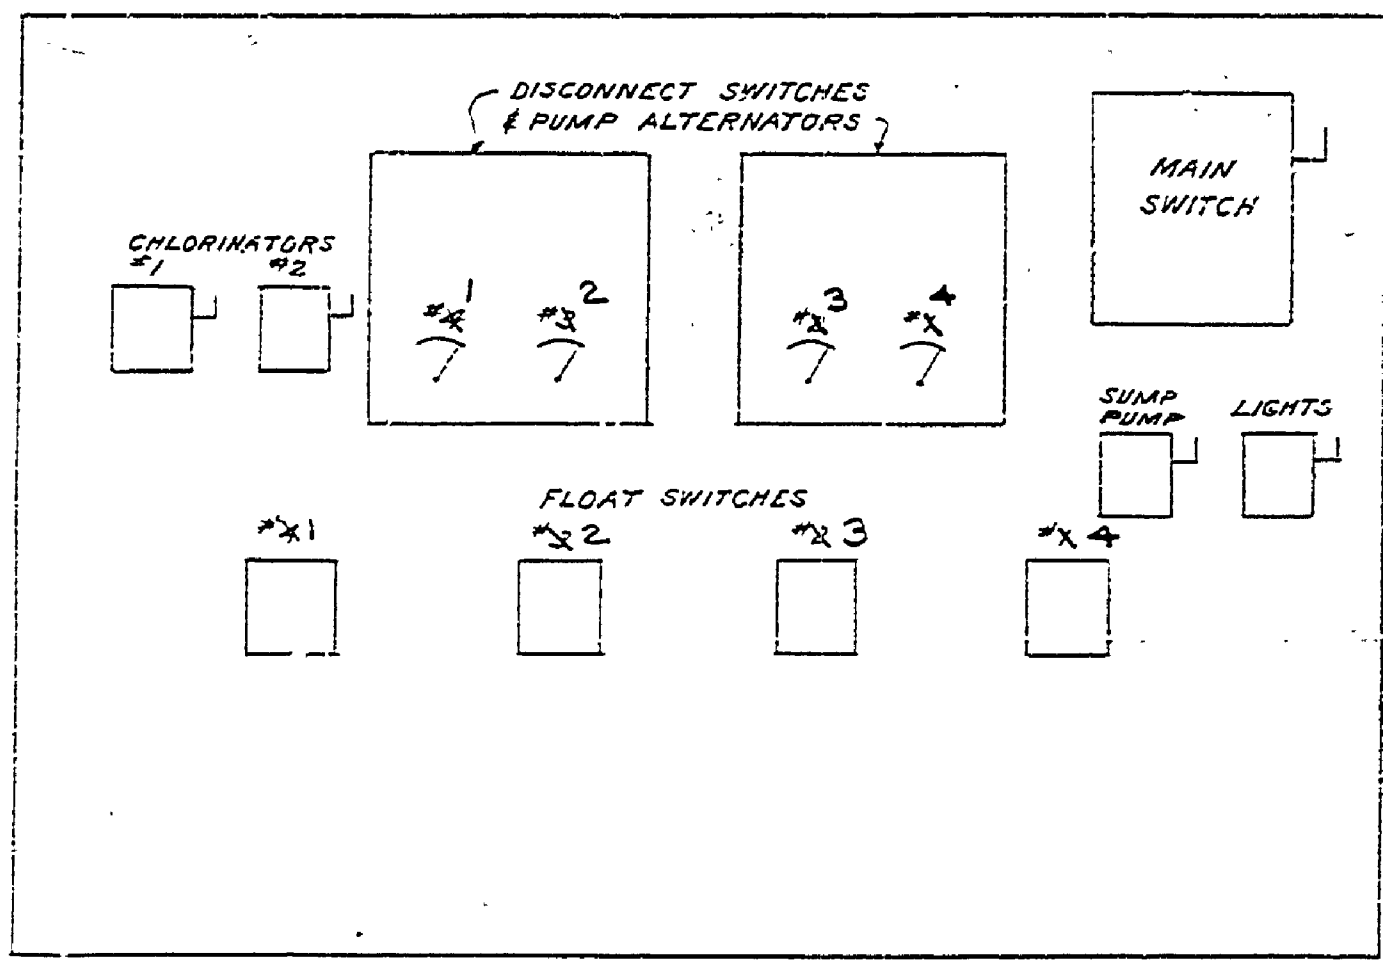

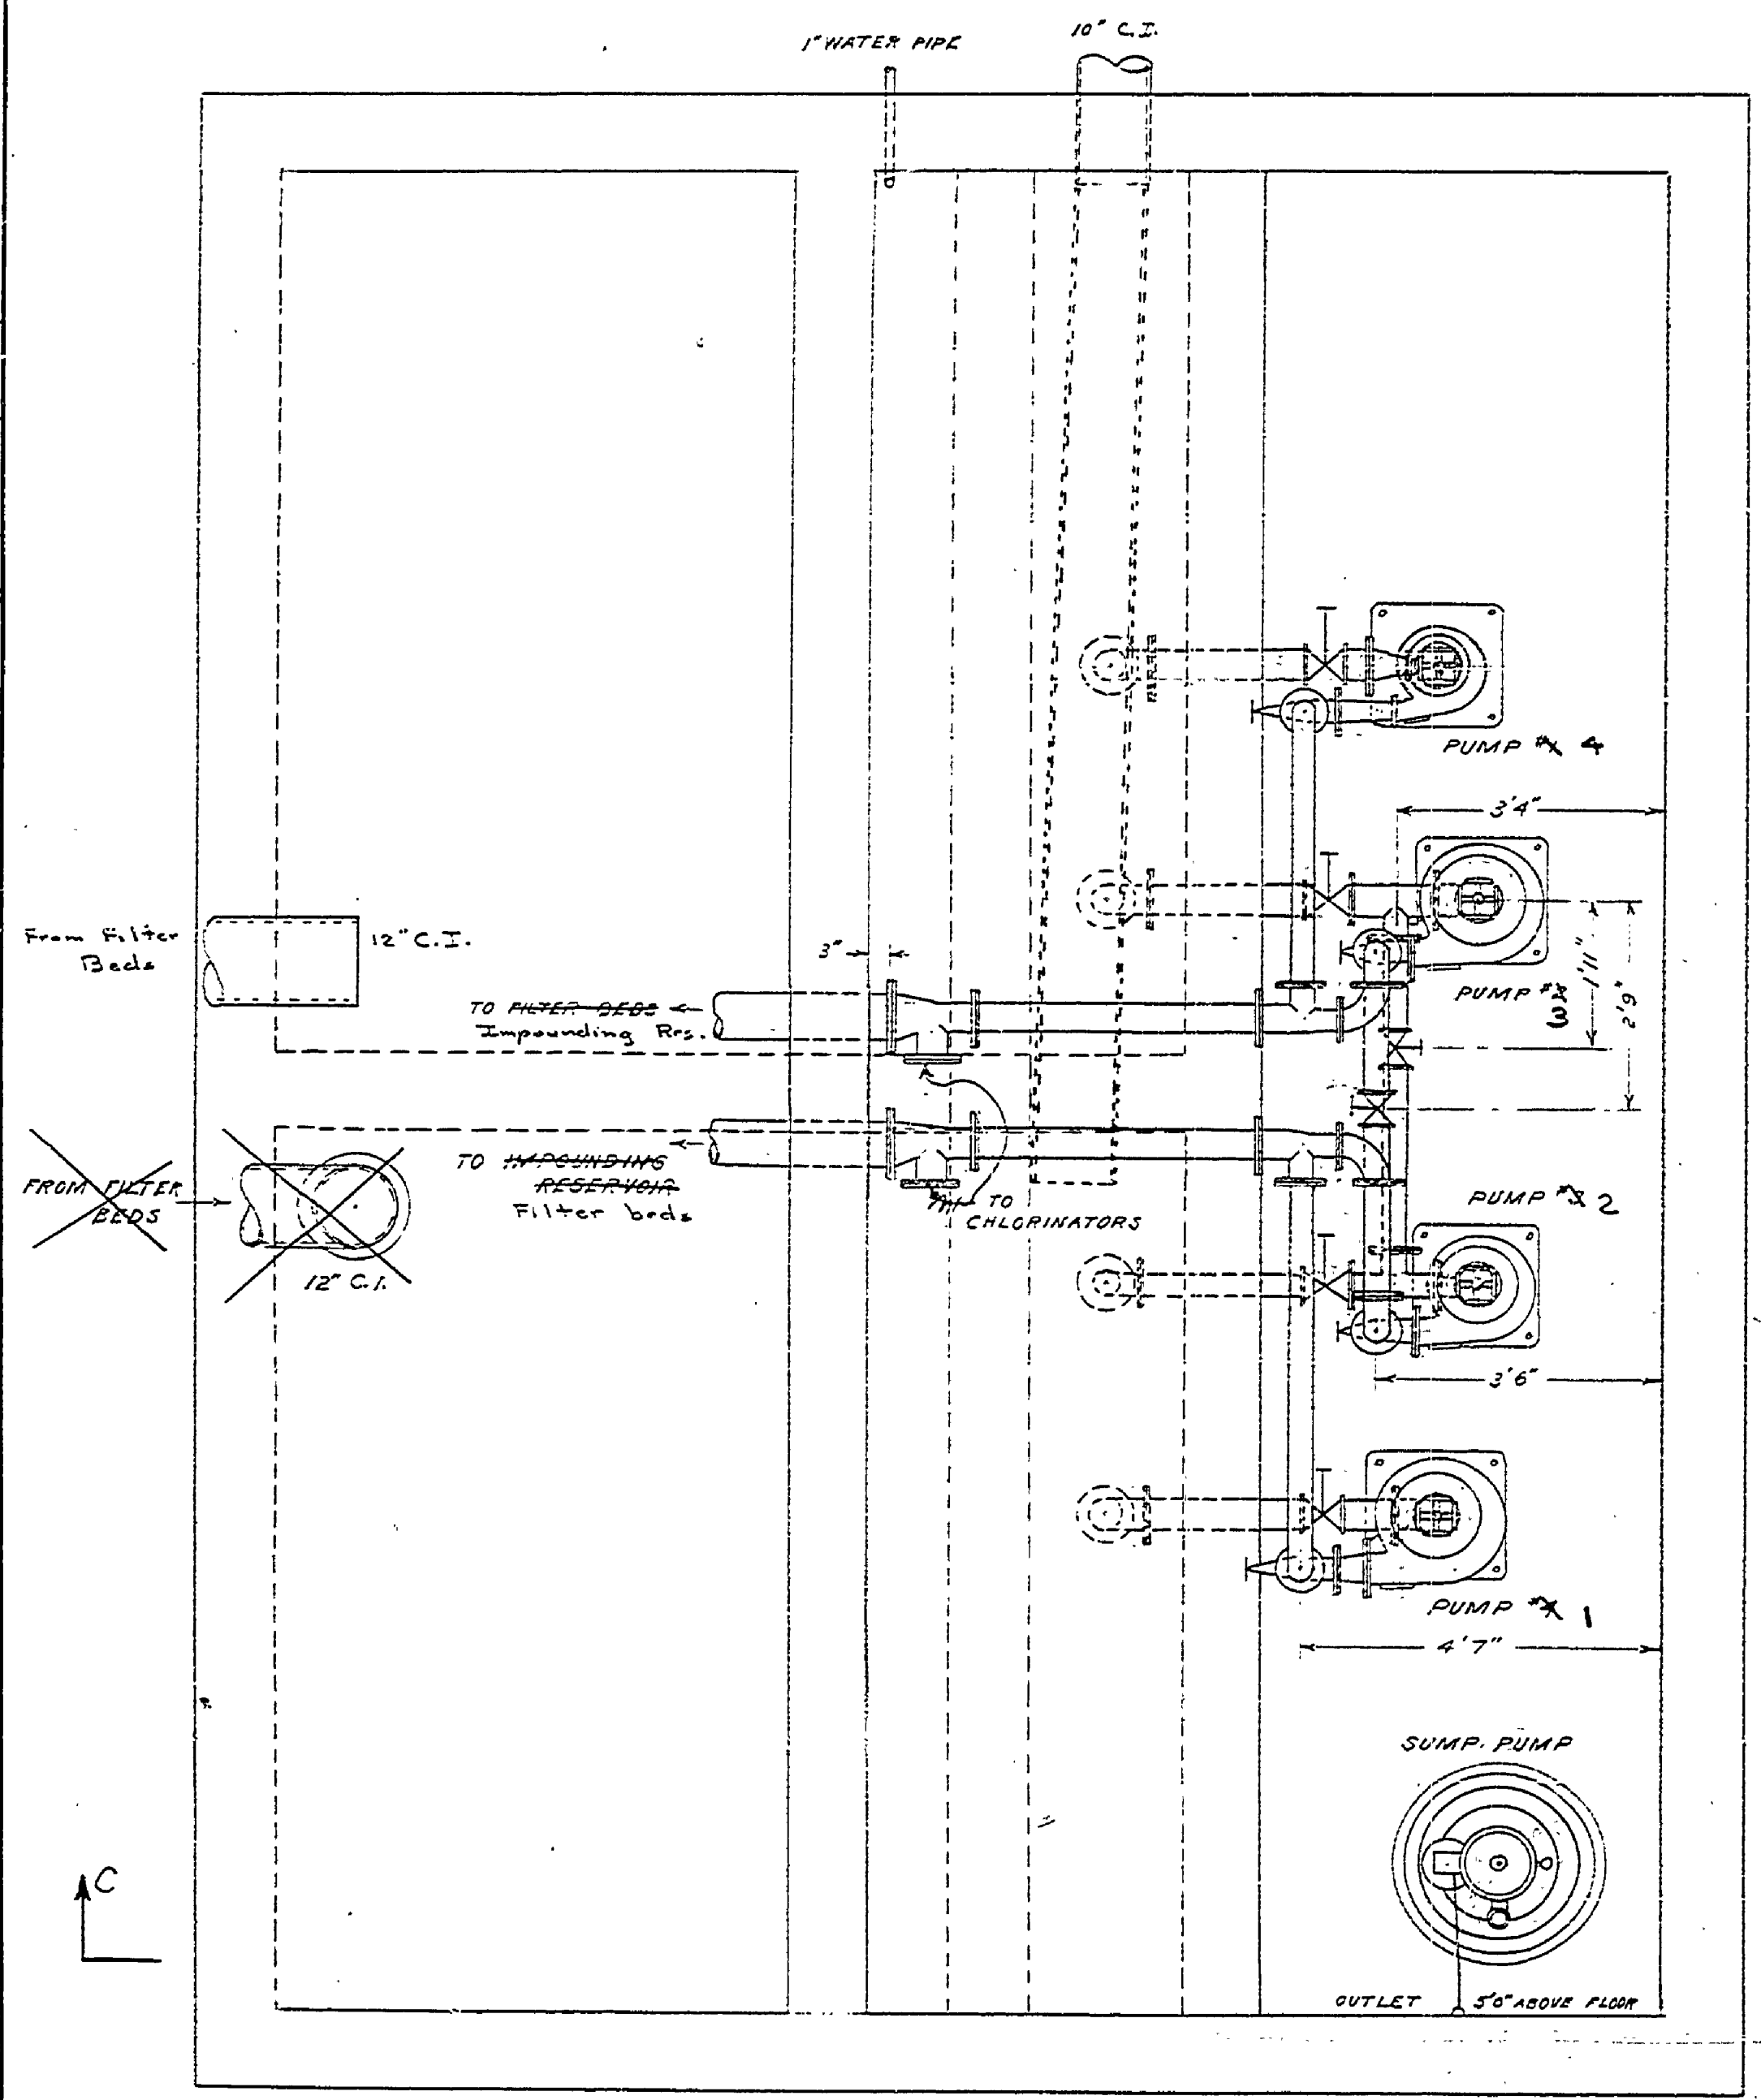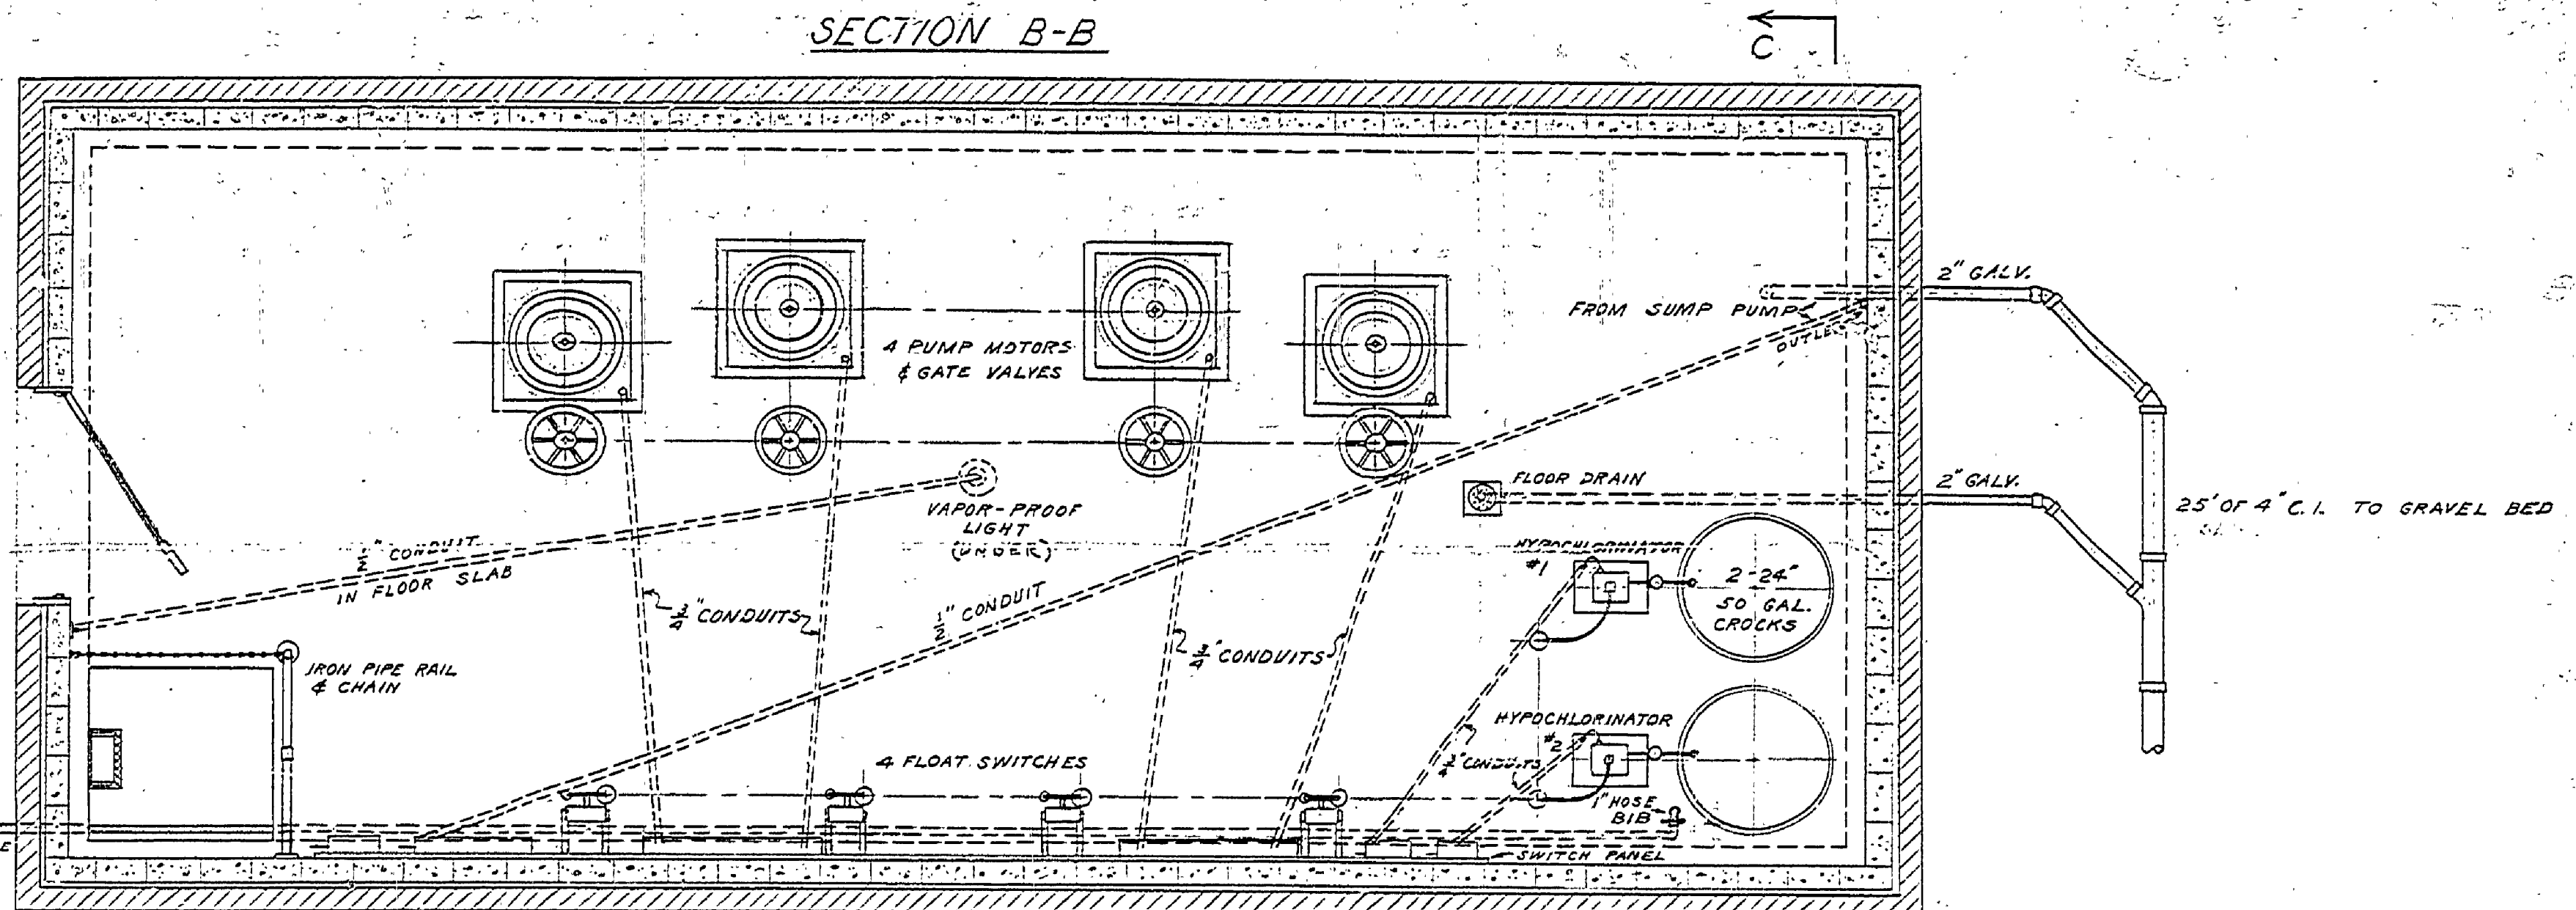SECTION A-A

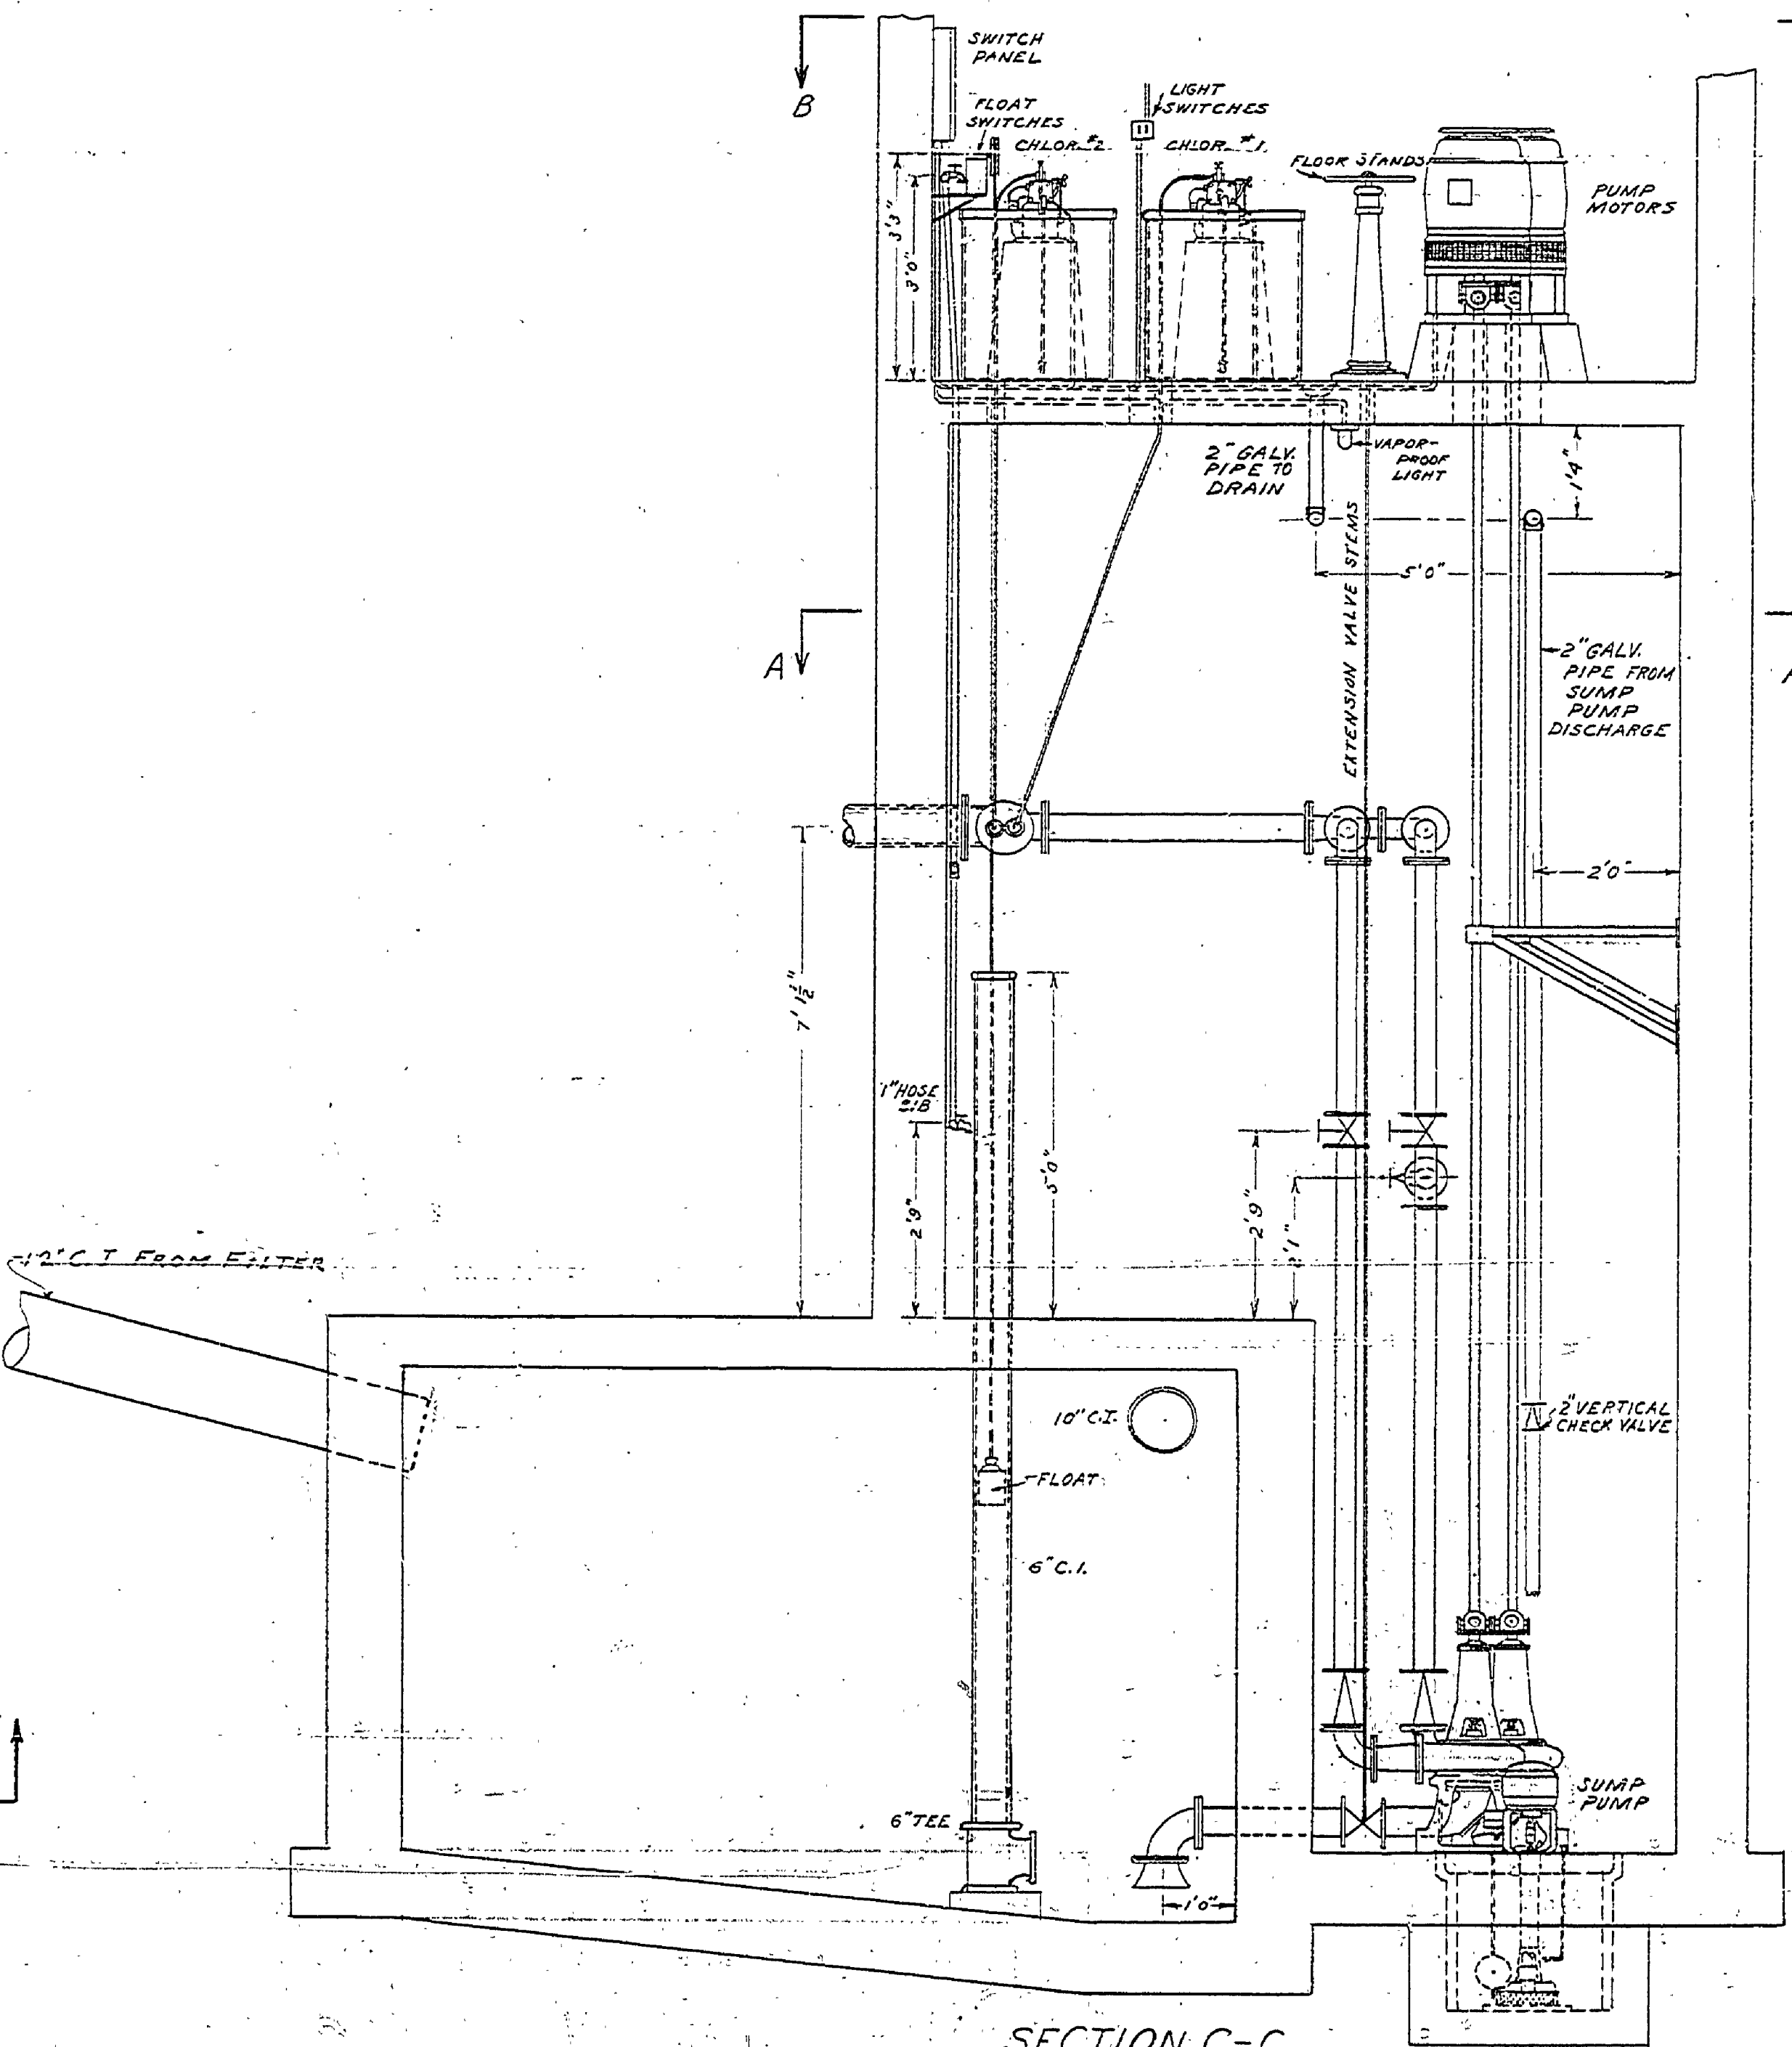

SECTION C-C

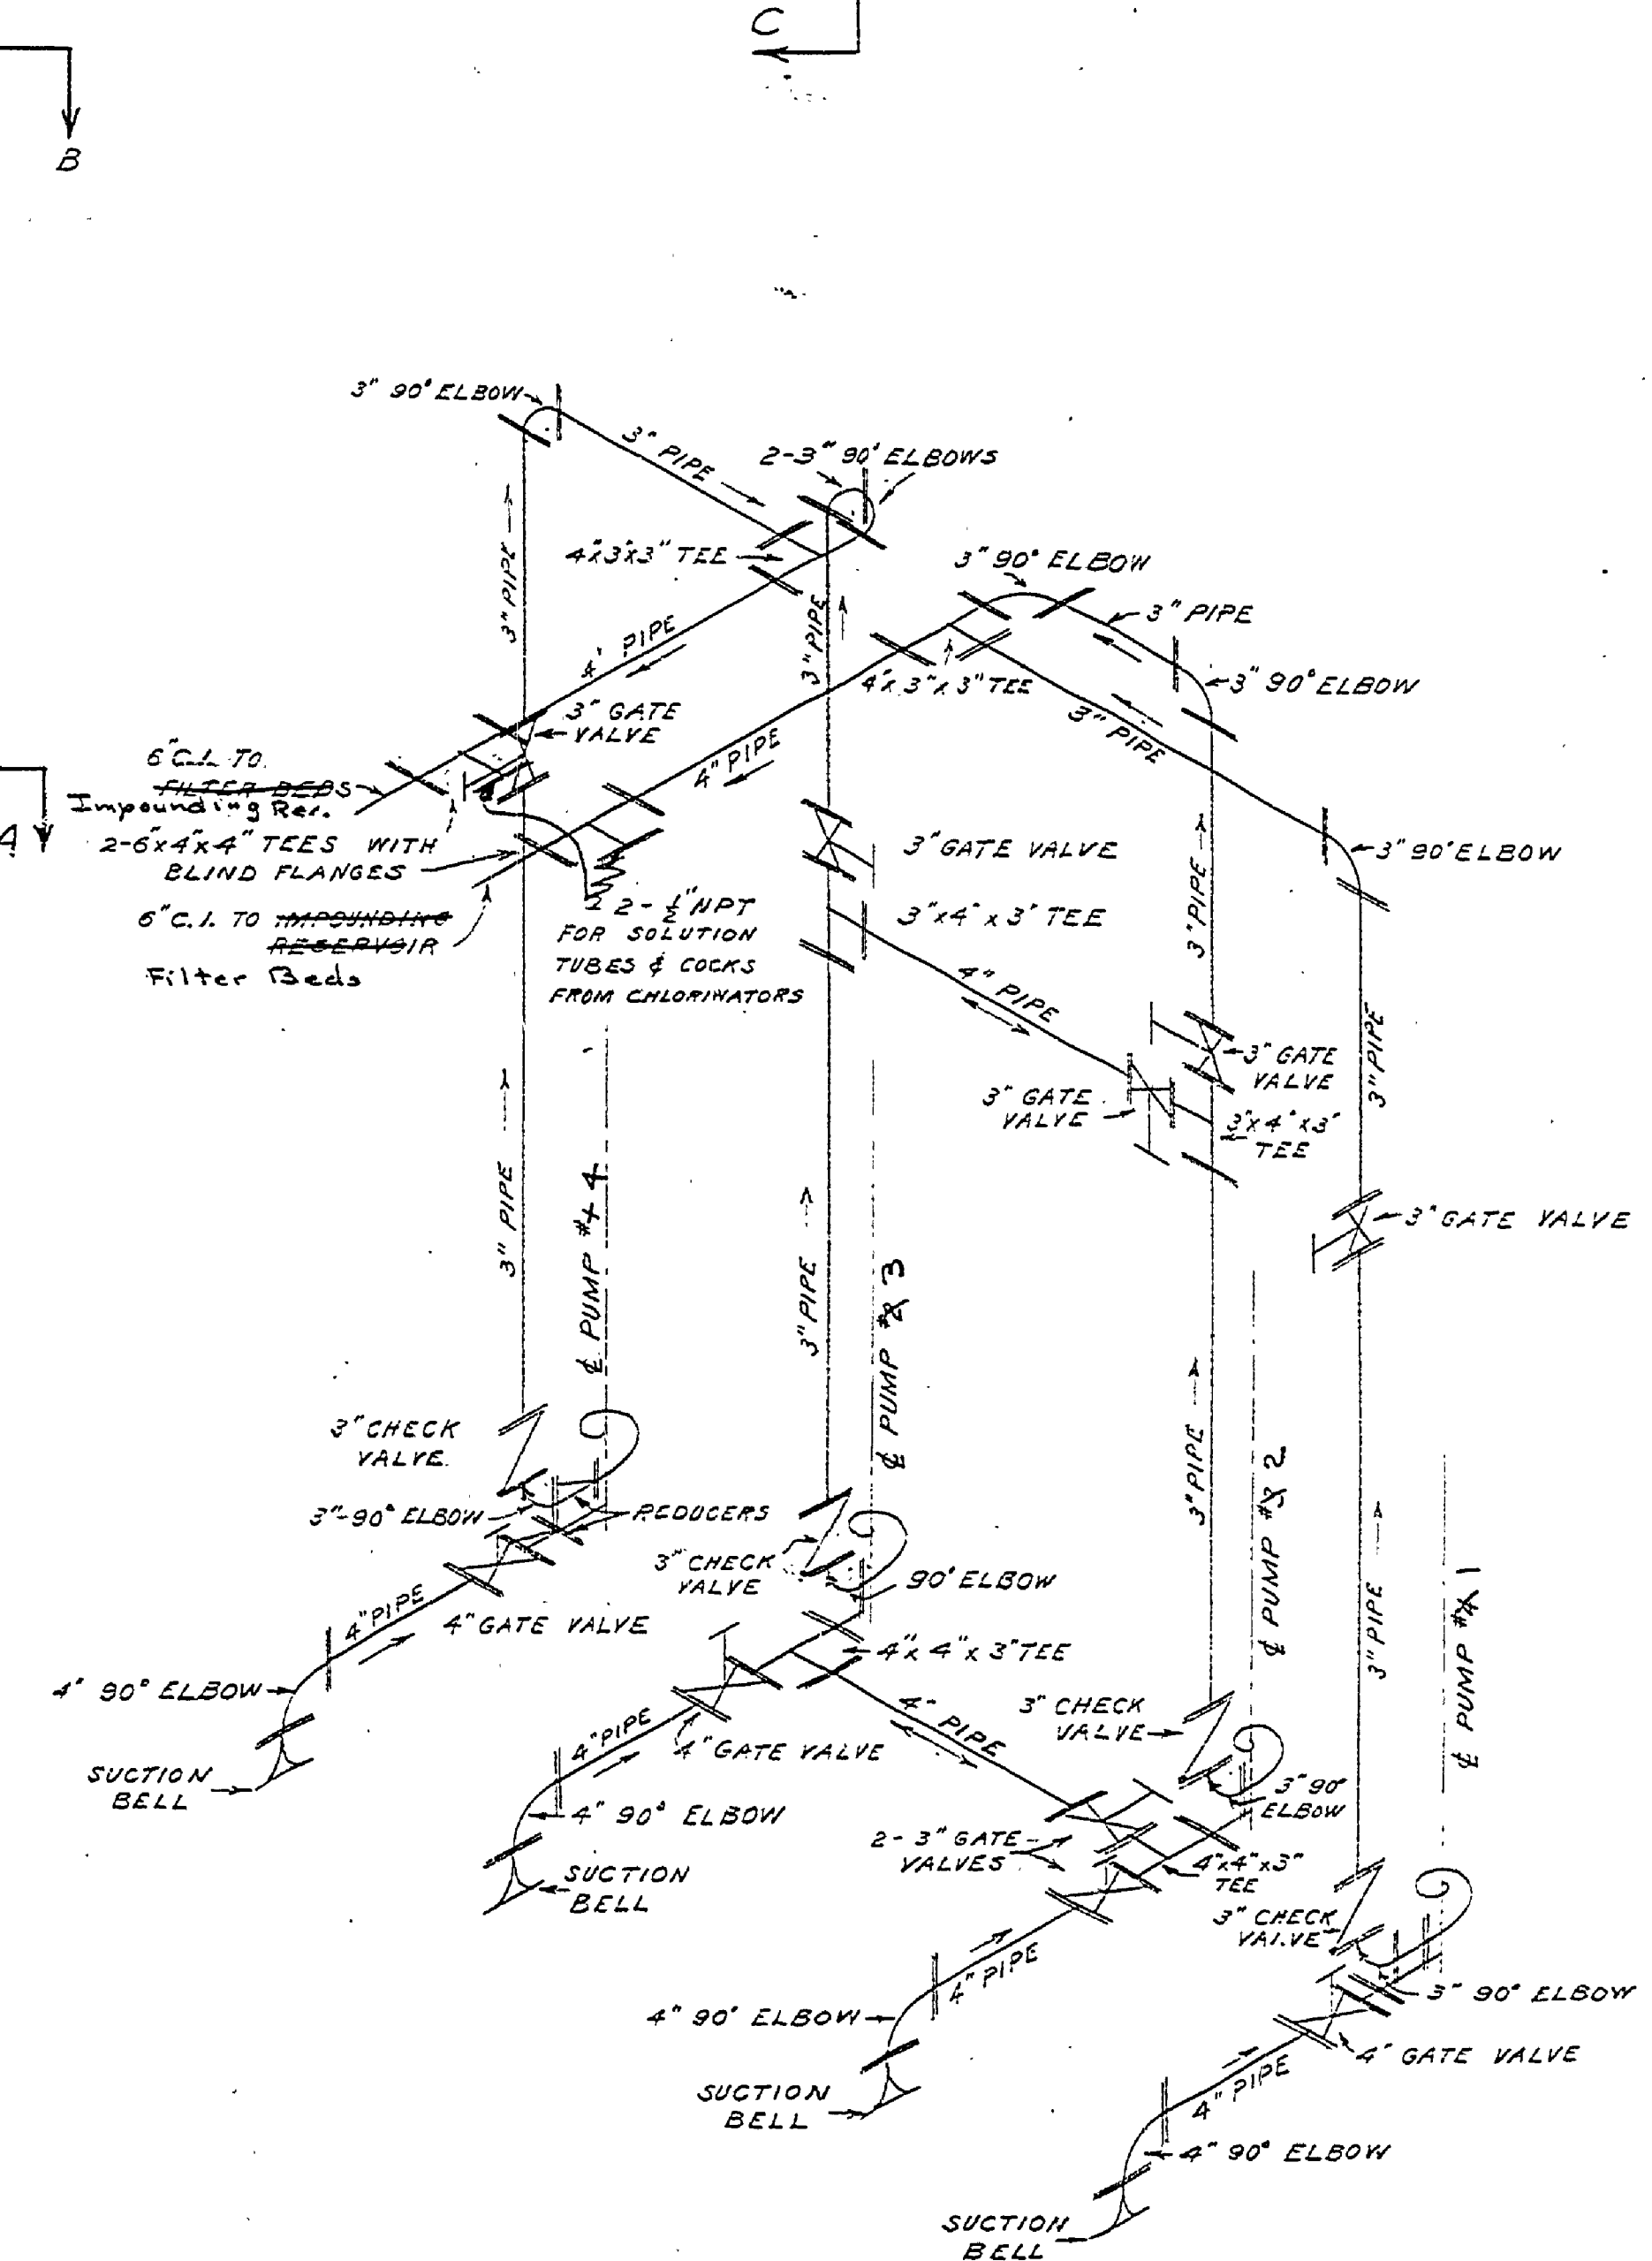

PUMP HOUSE PIPING INSTALLATION

MICHIGAN  
DEPARTMENT OF CONSERVATION  
PARKS AND RECREATION DIVISION

BAY CITY STATE PARK  
SANITARY SEWERAGE SYSTEM  
SCALE: 1/2\"/>

SHEET  
NO. 4  
OF 16

PLAN NO.  
E-107