


DRAWN BY G. HALIK	CHECKED BY E. T. P.	DATE JUNE 27 '50	REVIEWED BY SECTIONS			APPROVED BY			REVISIONS		
			ARCHITECTURAL S.T.R.	ENGINEERING H.C.M.	LANDSCAPE V.F.R.	DATE 9-8-50	DATE 6-24-50	DATE 2-8-50	NO.	DATE	BY
								1			4
								2			5
								3			6

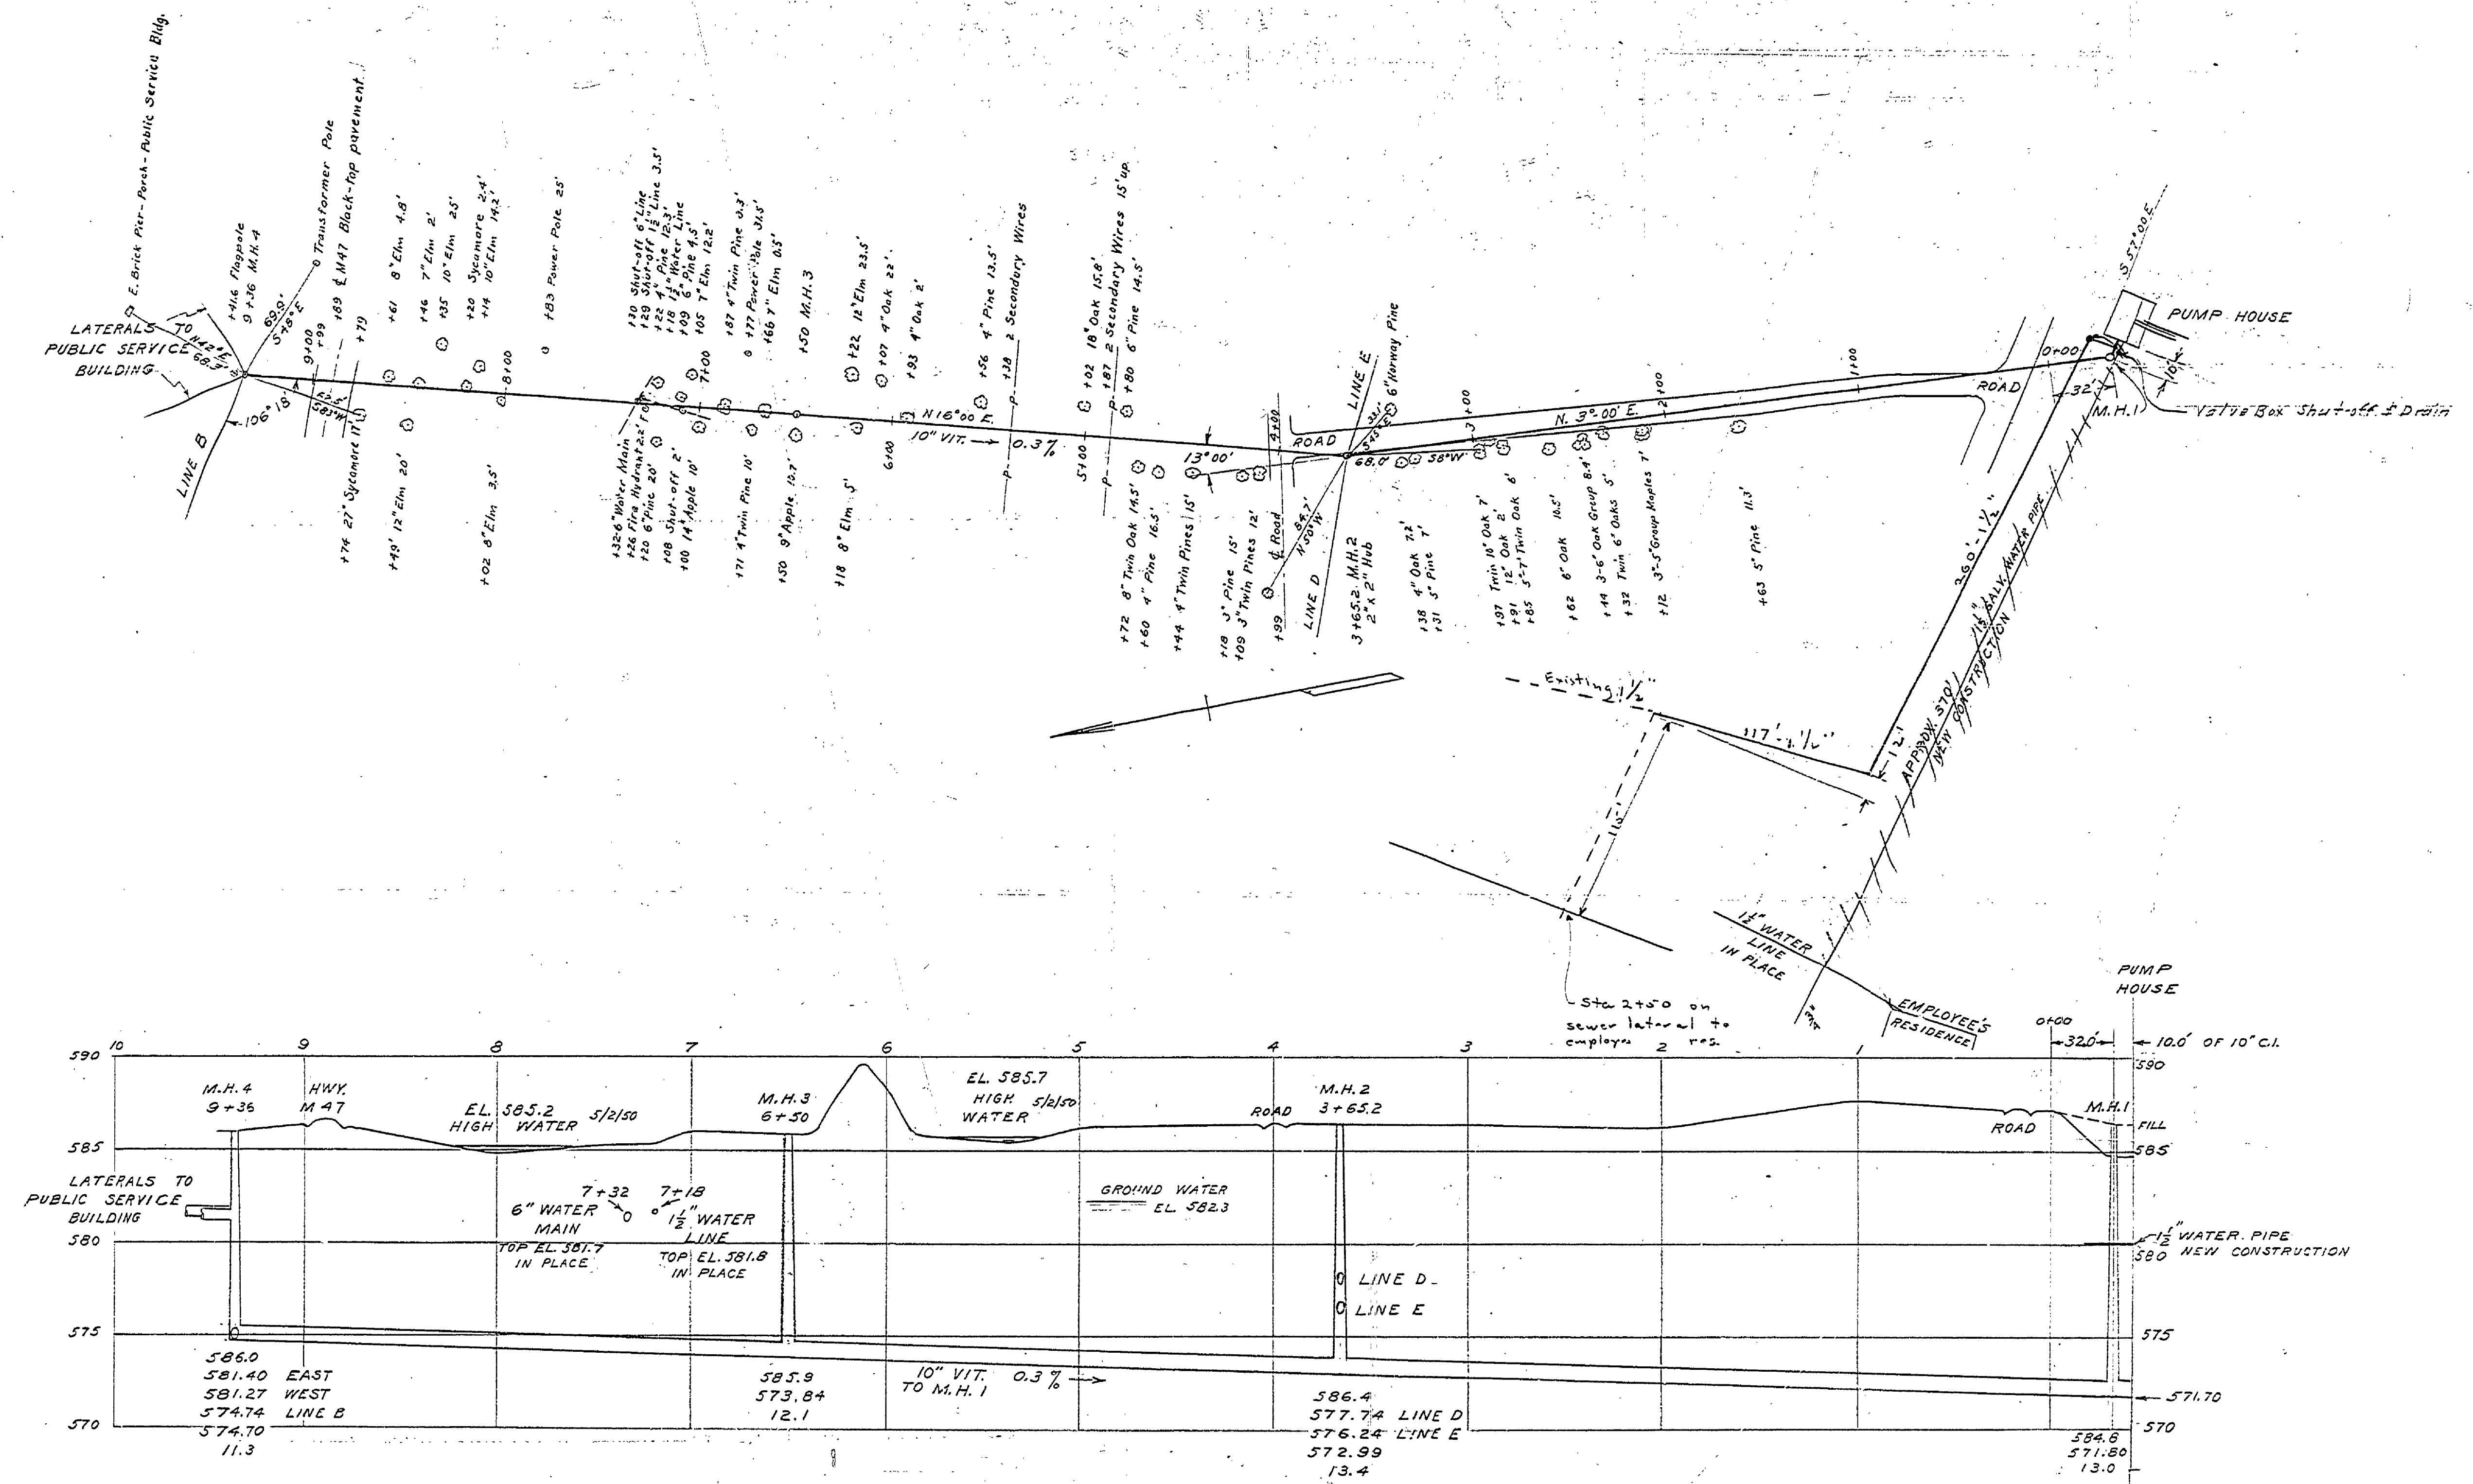

PLAN & PROFILE LINE A

MICHIGAN
DEPARTMENT OF CONSERVATION
PARKS AND RECREATION DIVISION

BAY CITY STATE PARK
SANITARY SEWERAGE SYSTEM
SCALE: VER. 5"=1", HOR. 50'=1"

SHEET NO. 10 OF 16 PLAN NO. E-107