
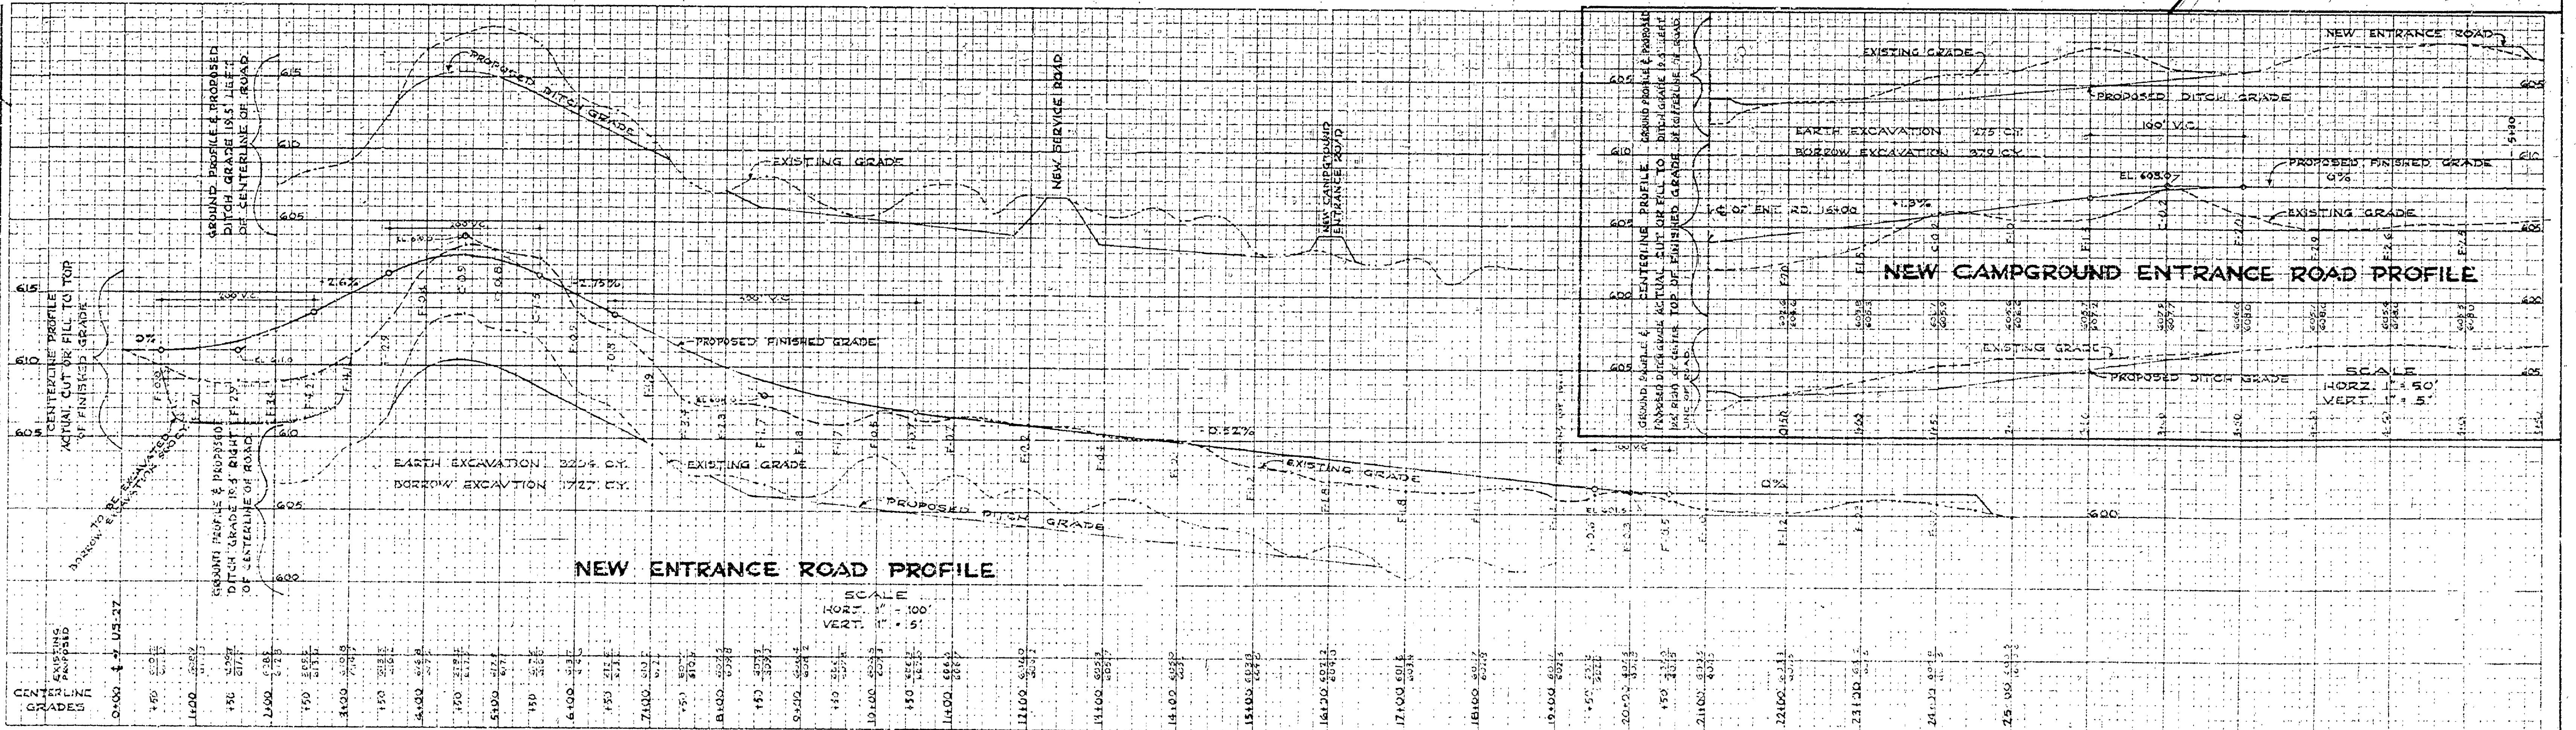


DESIGNED BY K.M.O. ARCHITECTURAL
 DRAWN BY F.J.W. ENGINEERING
 CHECKED BY LANDSCAPE

DATE 10-61
 REVIEWED
 DATE
 APPROVED

REVISIONS
 1 1/50/62 E.J.W. THIRD LANE & TURN CIRCLE
 2
 3
 4
 5
 6

DATE BY DATE BY DATE BY

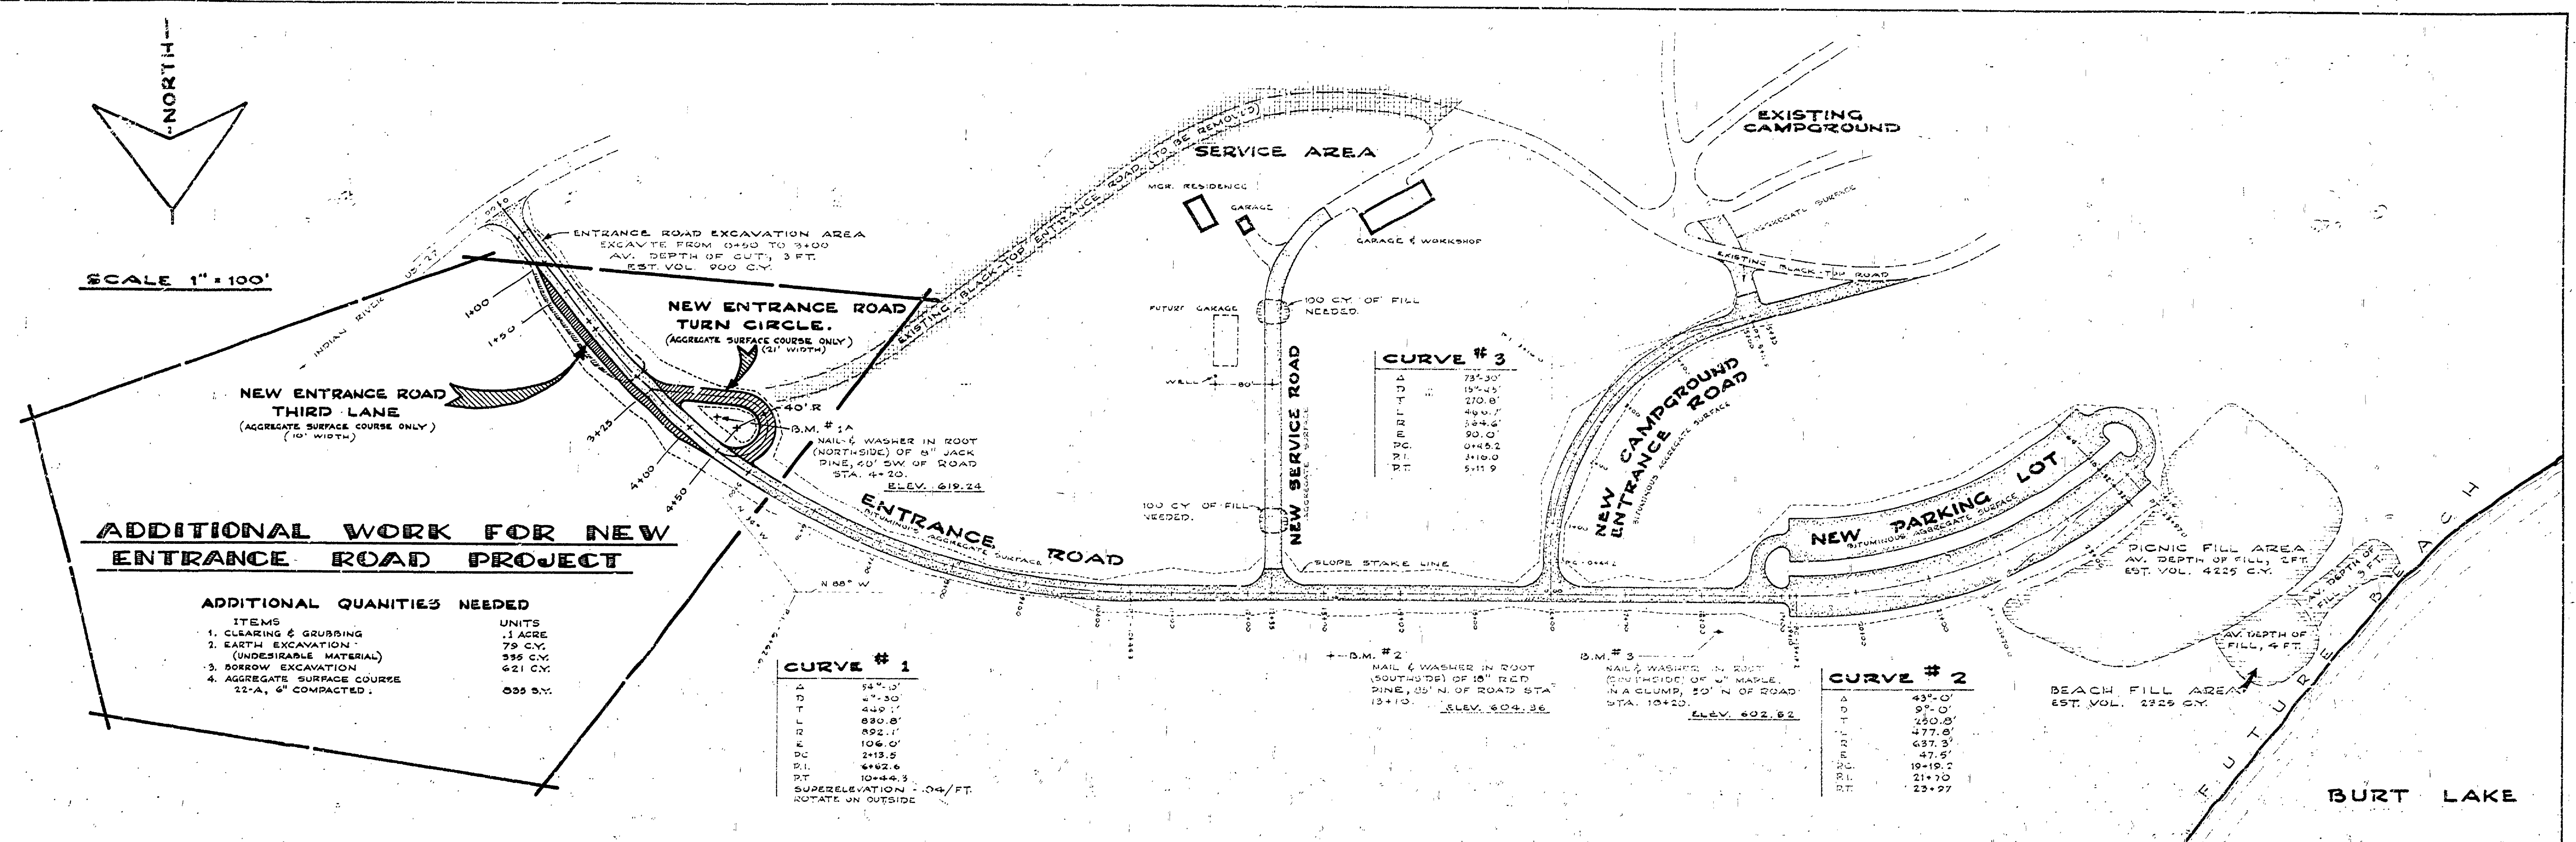

SUPPLEMENT TO CONTRACT NO. 975-28-C1

MICHIGAN DEPARTMENT OF CONSERVATION PARKS AND RECREATION DIVISION

BURT LAKE STATE PARK ENTRANCE ROAD PLAN AND PROFILE

SHEET NO. 2 OF 3

PLAN NO. L-110A

SUPPLEMENT SHEET NO. 1