

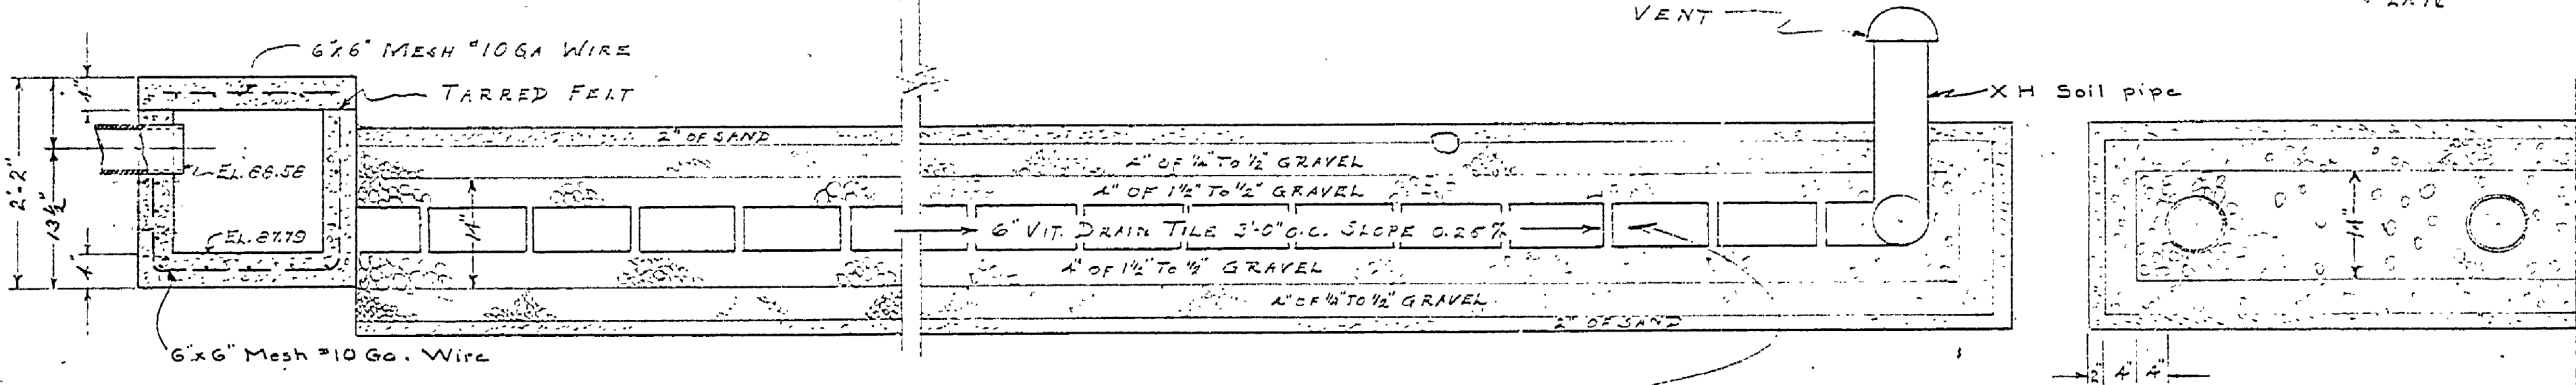


PLAN OF DISPOSAL FIELD
SCALE 3/4"=1'-0"


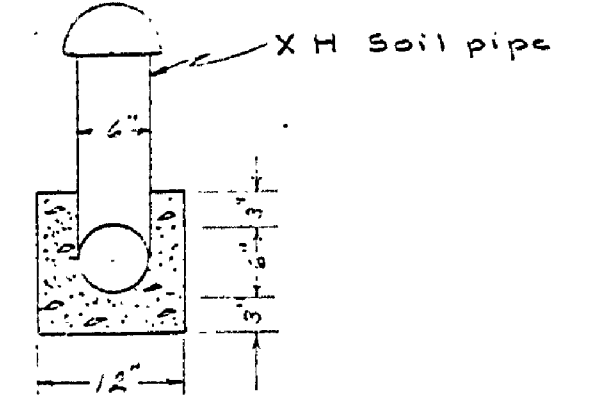


SECTION OF DISPOSAL FIELD
SCALE 3/4"=1'-0"


Note: Remove, clean and relay tile. Finished Tile Field to comply with details of this plan with consideration for grades, material & workmanship

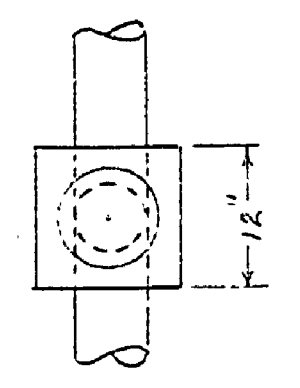


VENT DETAIL
SCALE 3/4"=1'-0"

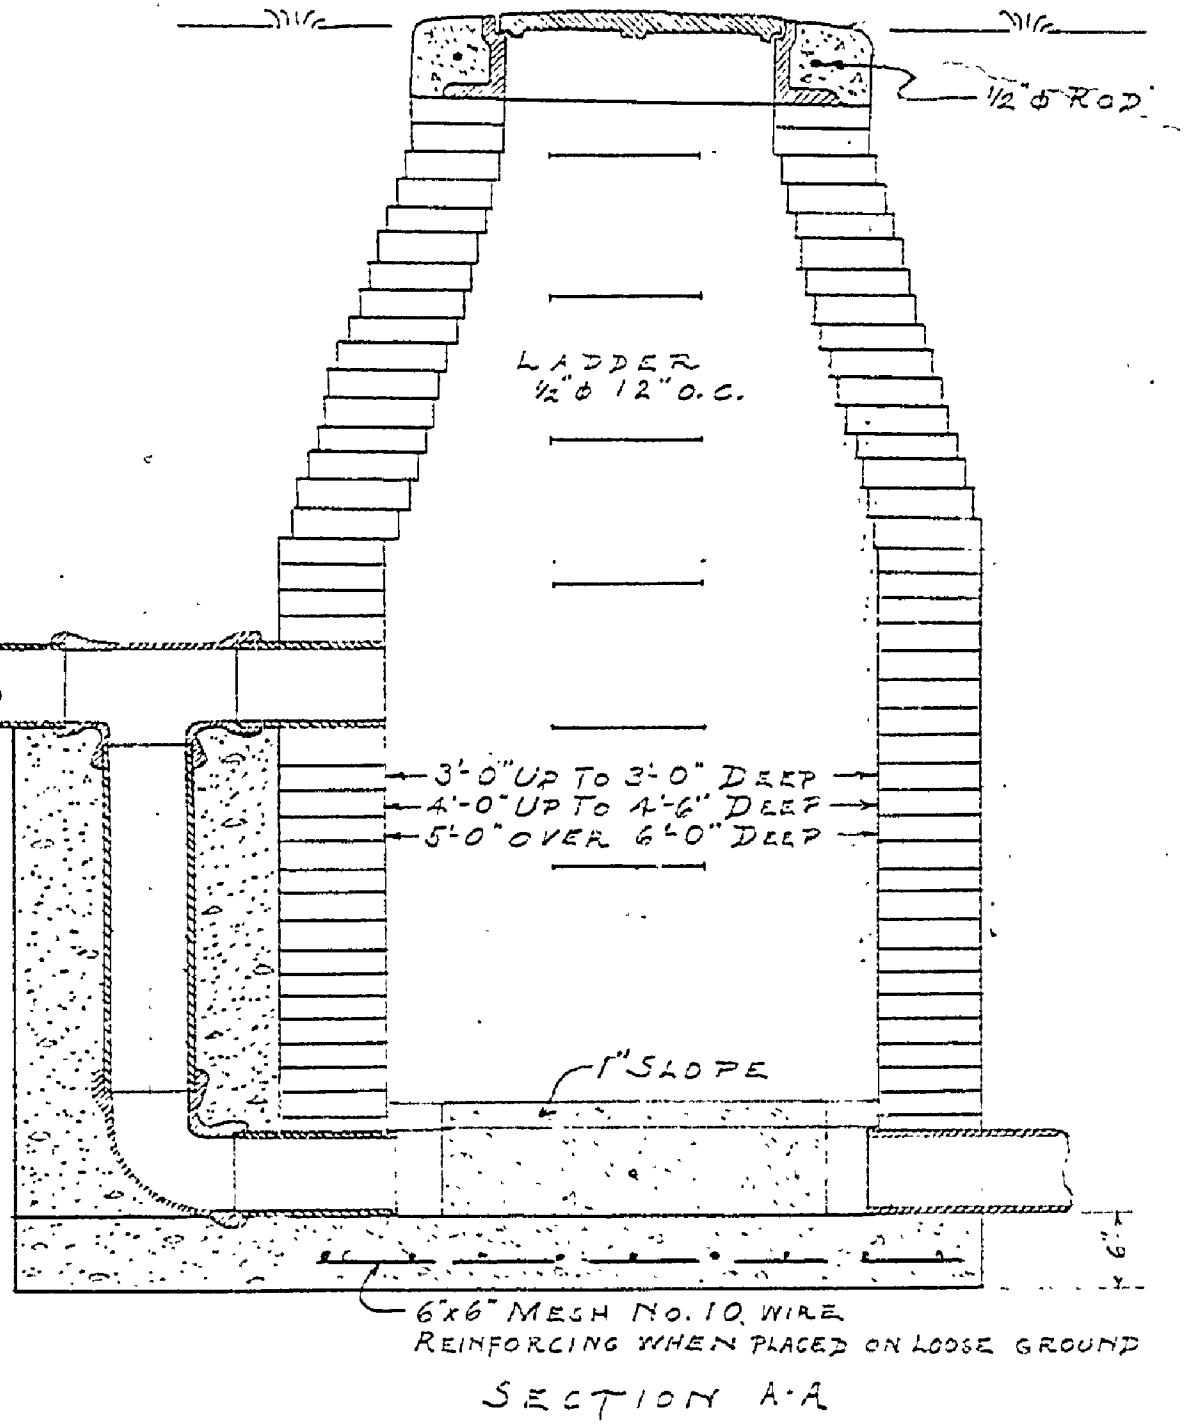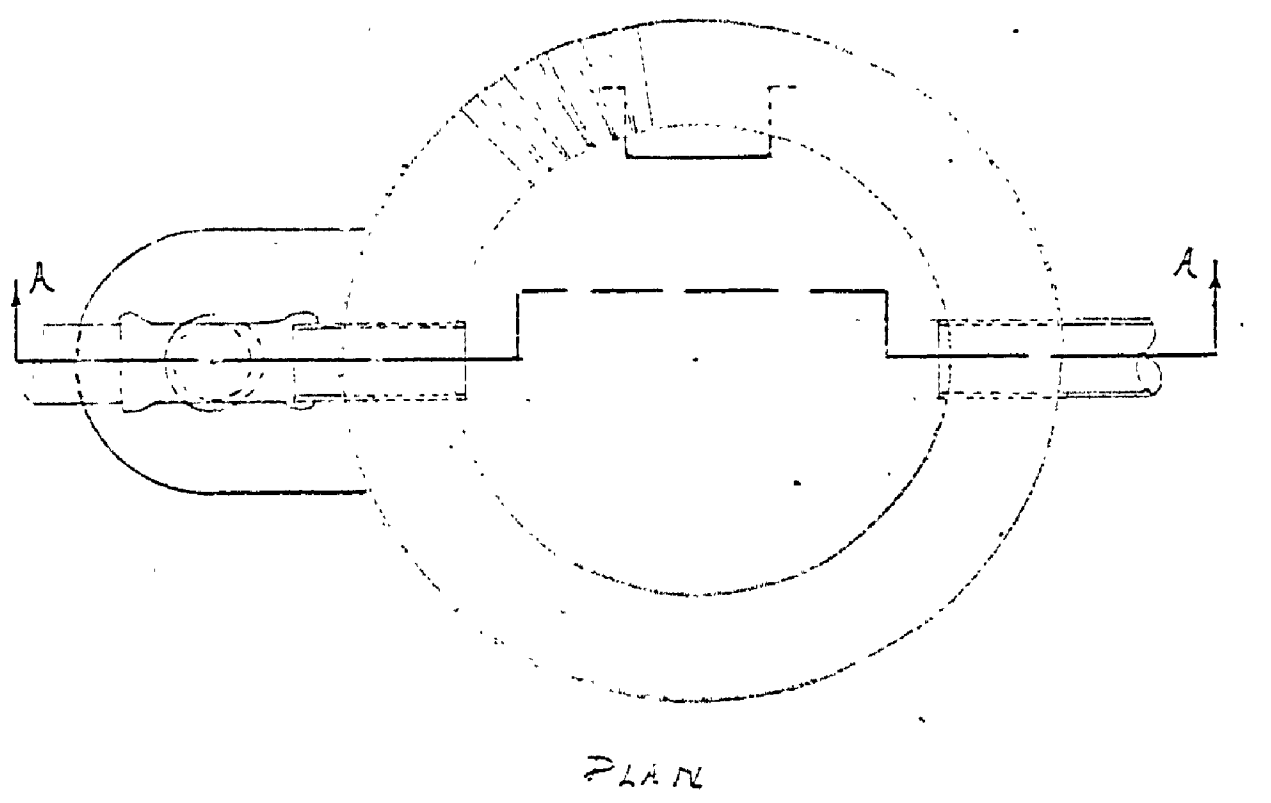

DETAIL OF DROP MANHOLE
SCALE 3/4"=1'-0"

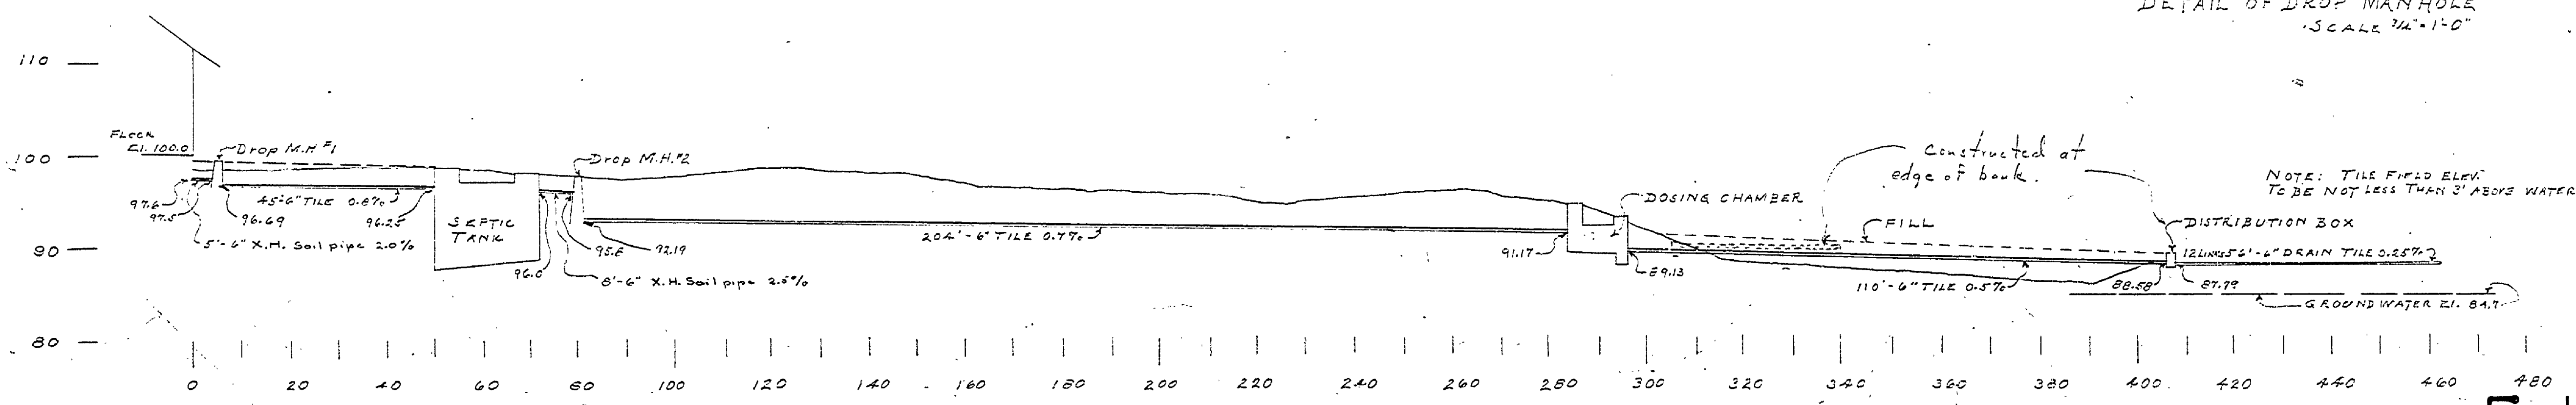


PROFILE SCALE { VERT 1"=10'-0" / HORIZ. 1"=20'-0"

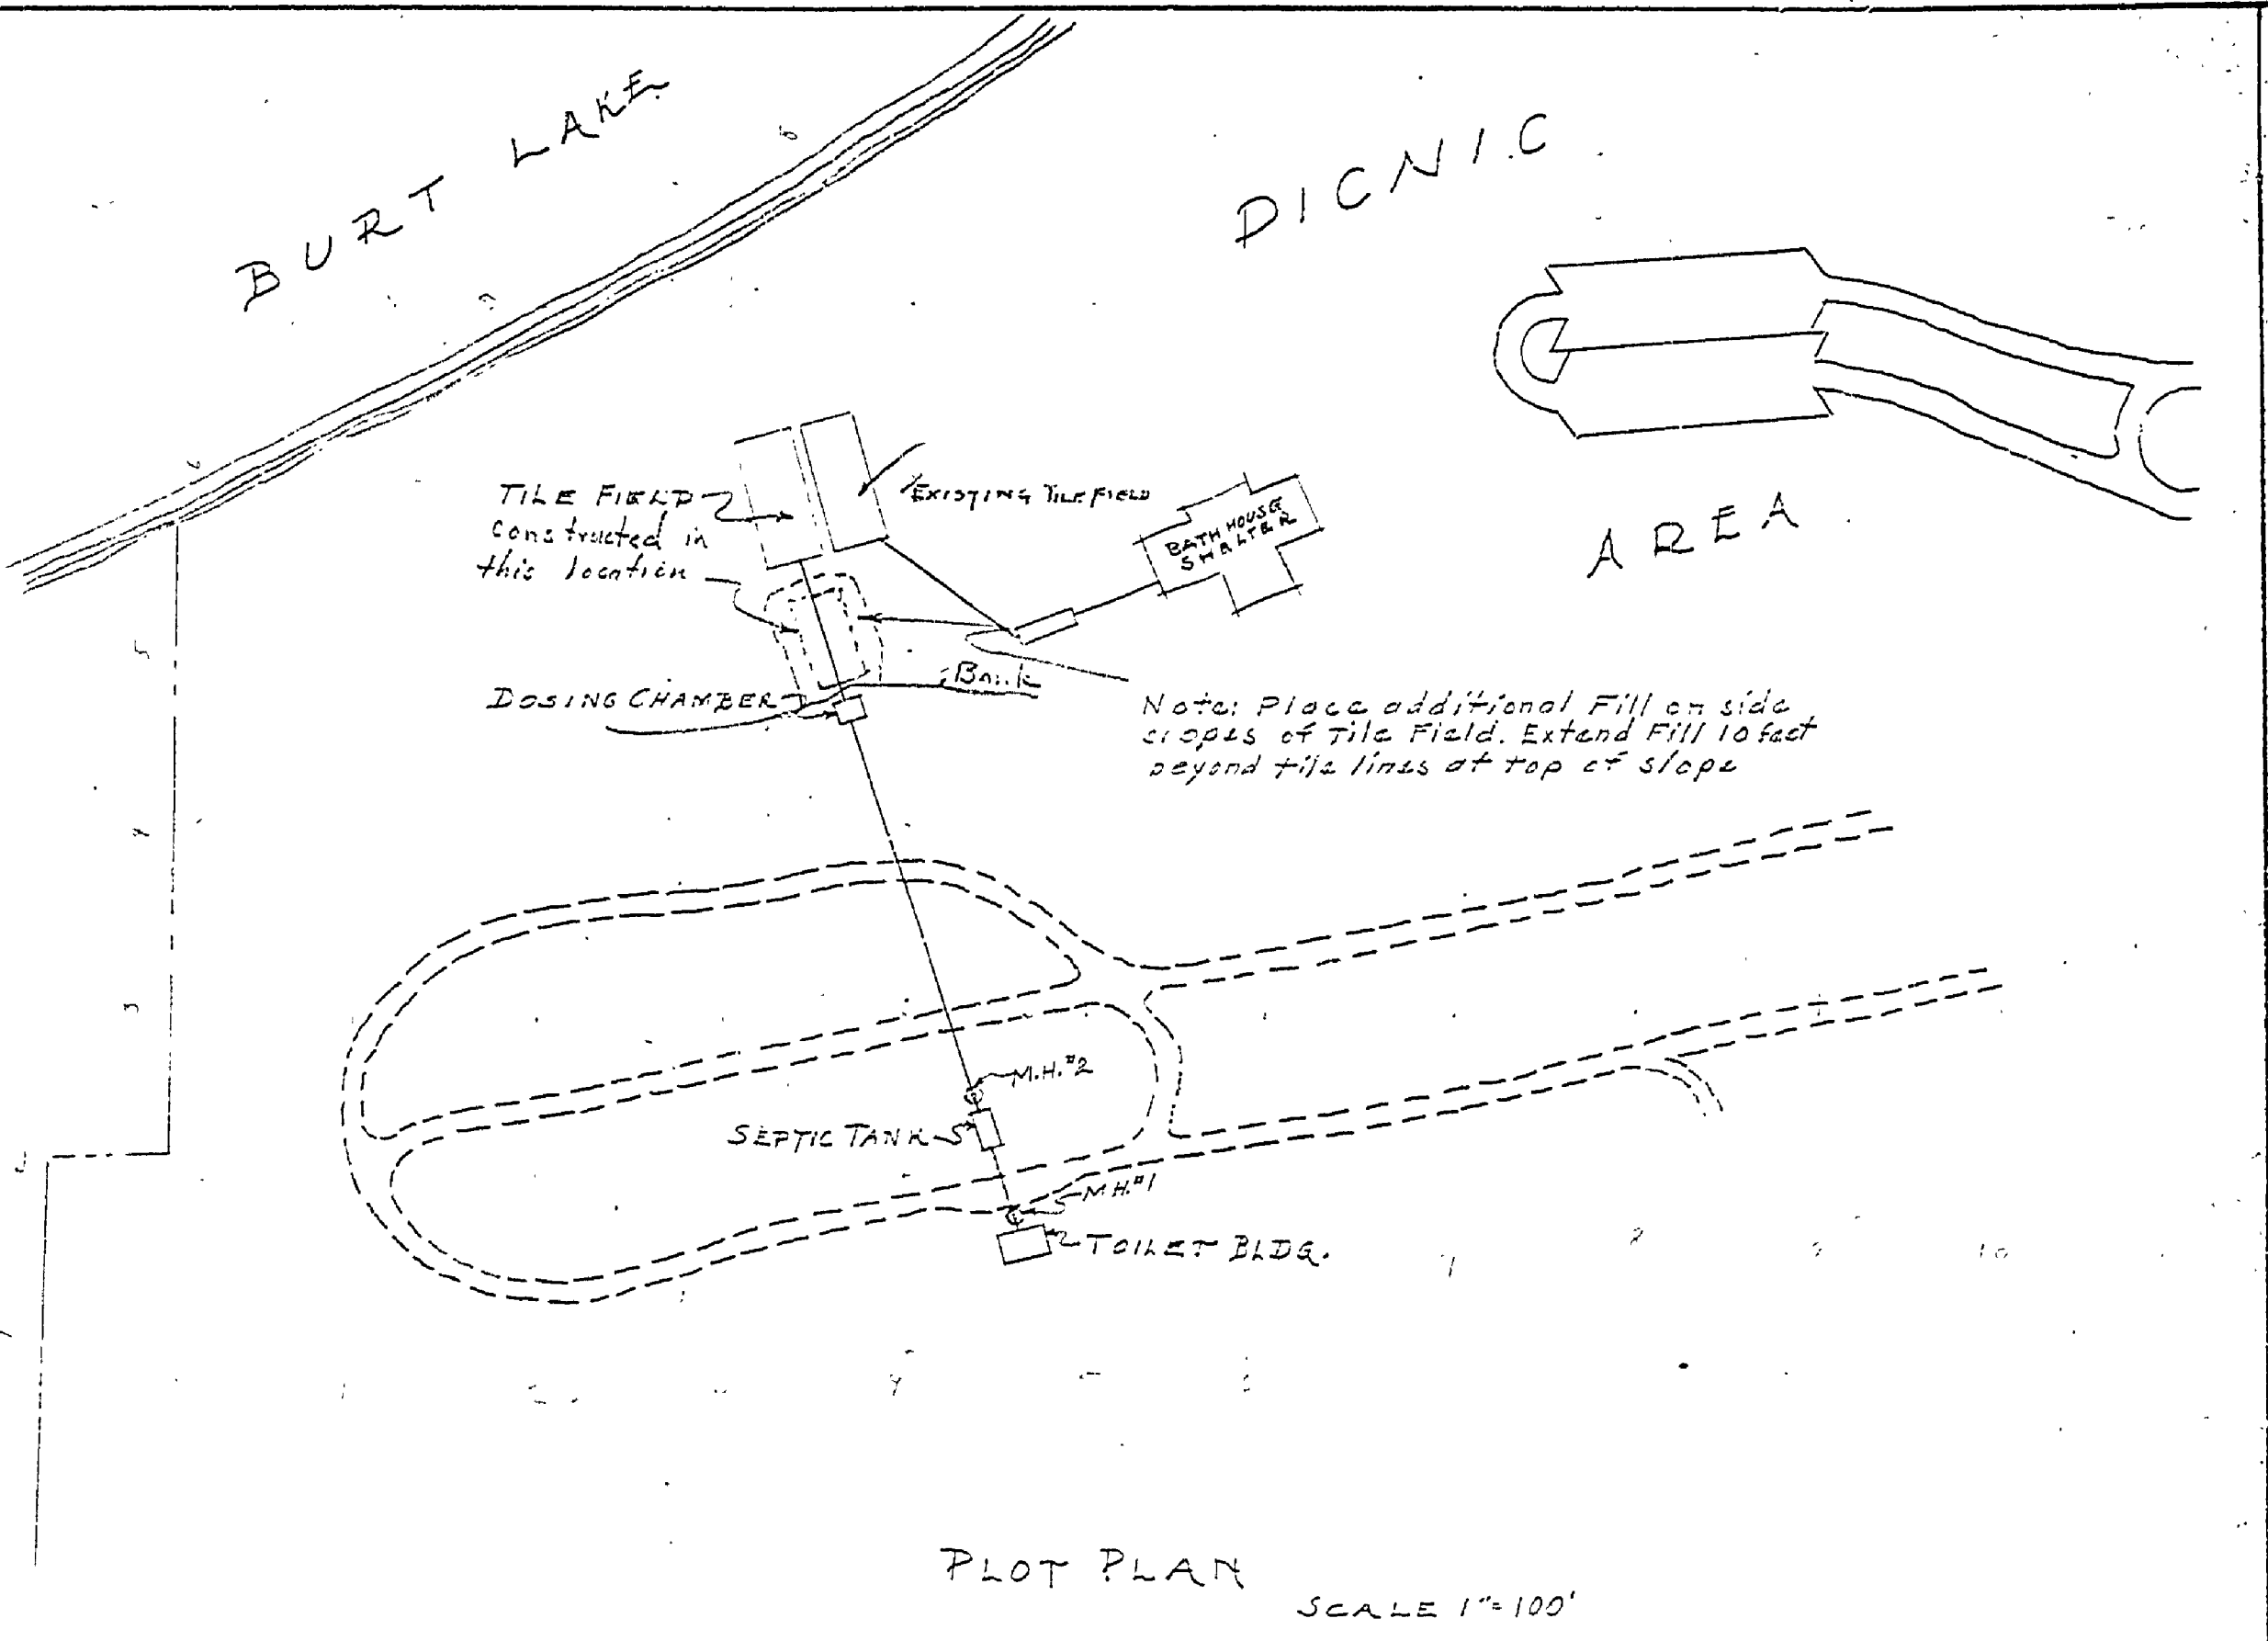

PLOT PLAN SCALE 1"=100'

DESIGNED BY
E. J. F. [Signature]
DATE 8-21-41

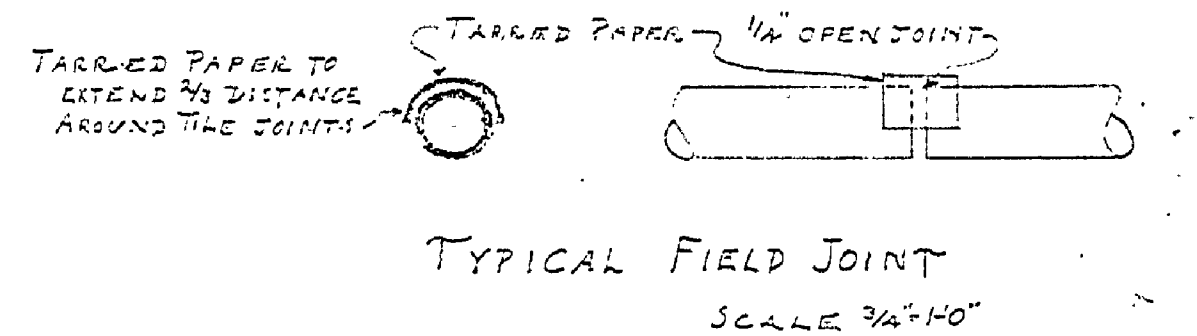

MICHIGAN DEPARTMENT OF CONSERVATION UNITED STATES DEPARTMENT OF THE INTERIOR NATIONAL PARK SERVICE COOPERATING		
DRAWN BY: E. J. F.	BURT LAKE STATE PARK DISPOSAL SYSTEM	PLAN NO. 1 OF 2
DESIGNED BY:	WESTCAMP GROUND TOILET BLDG. NO. 1	SCALE AS SHOWN
CHECKED BY:		DATE: 7-18-41
PREPARED AND APPROVED BY:	[Signature]	DATE 8-21-41
APPROVED BY:	INSPECTOR	DATE

E-102