


DESIGNED BY	DATE	REVIEWED	DATE	APPROVED	DATE	NO.	BY	REVISIONS	DATE	BY
C.S.	1-3-63	ARCHITECTURAL	1-3-63	C.S.	1	1-3-63	C.S.	4		
C.S.		ENGINEERING			2			5		
C.S.		LANDSCAPE			3			6		

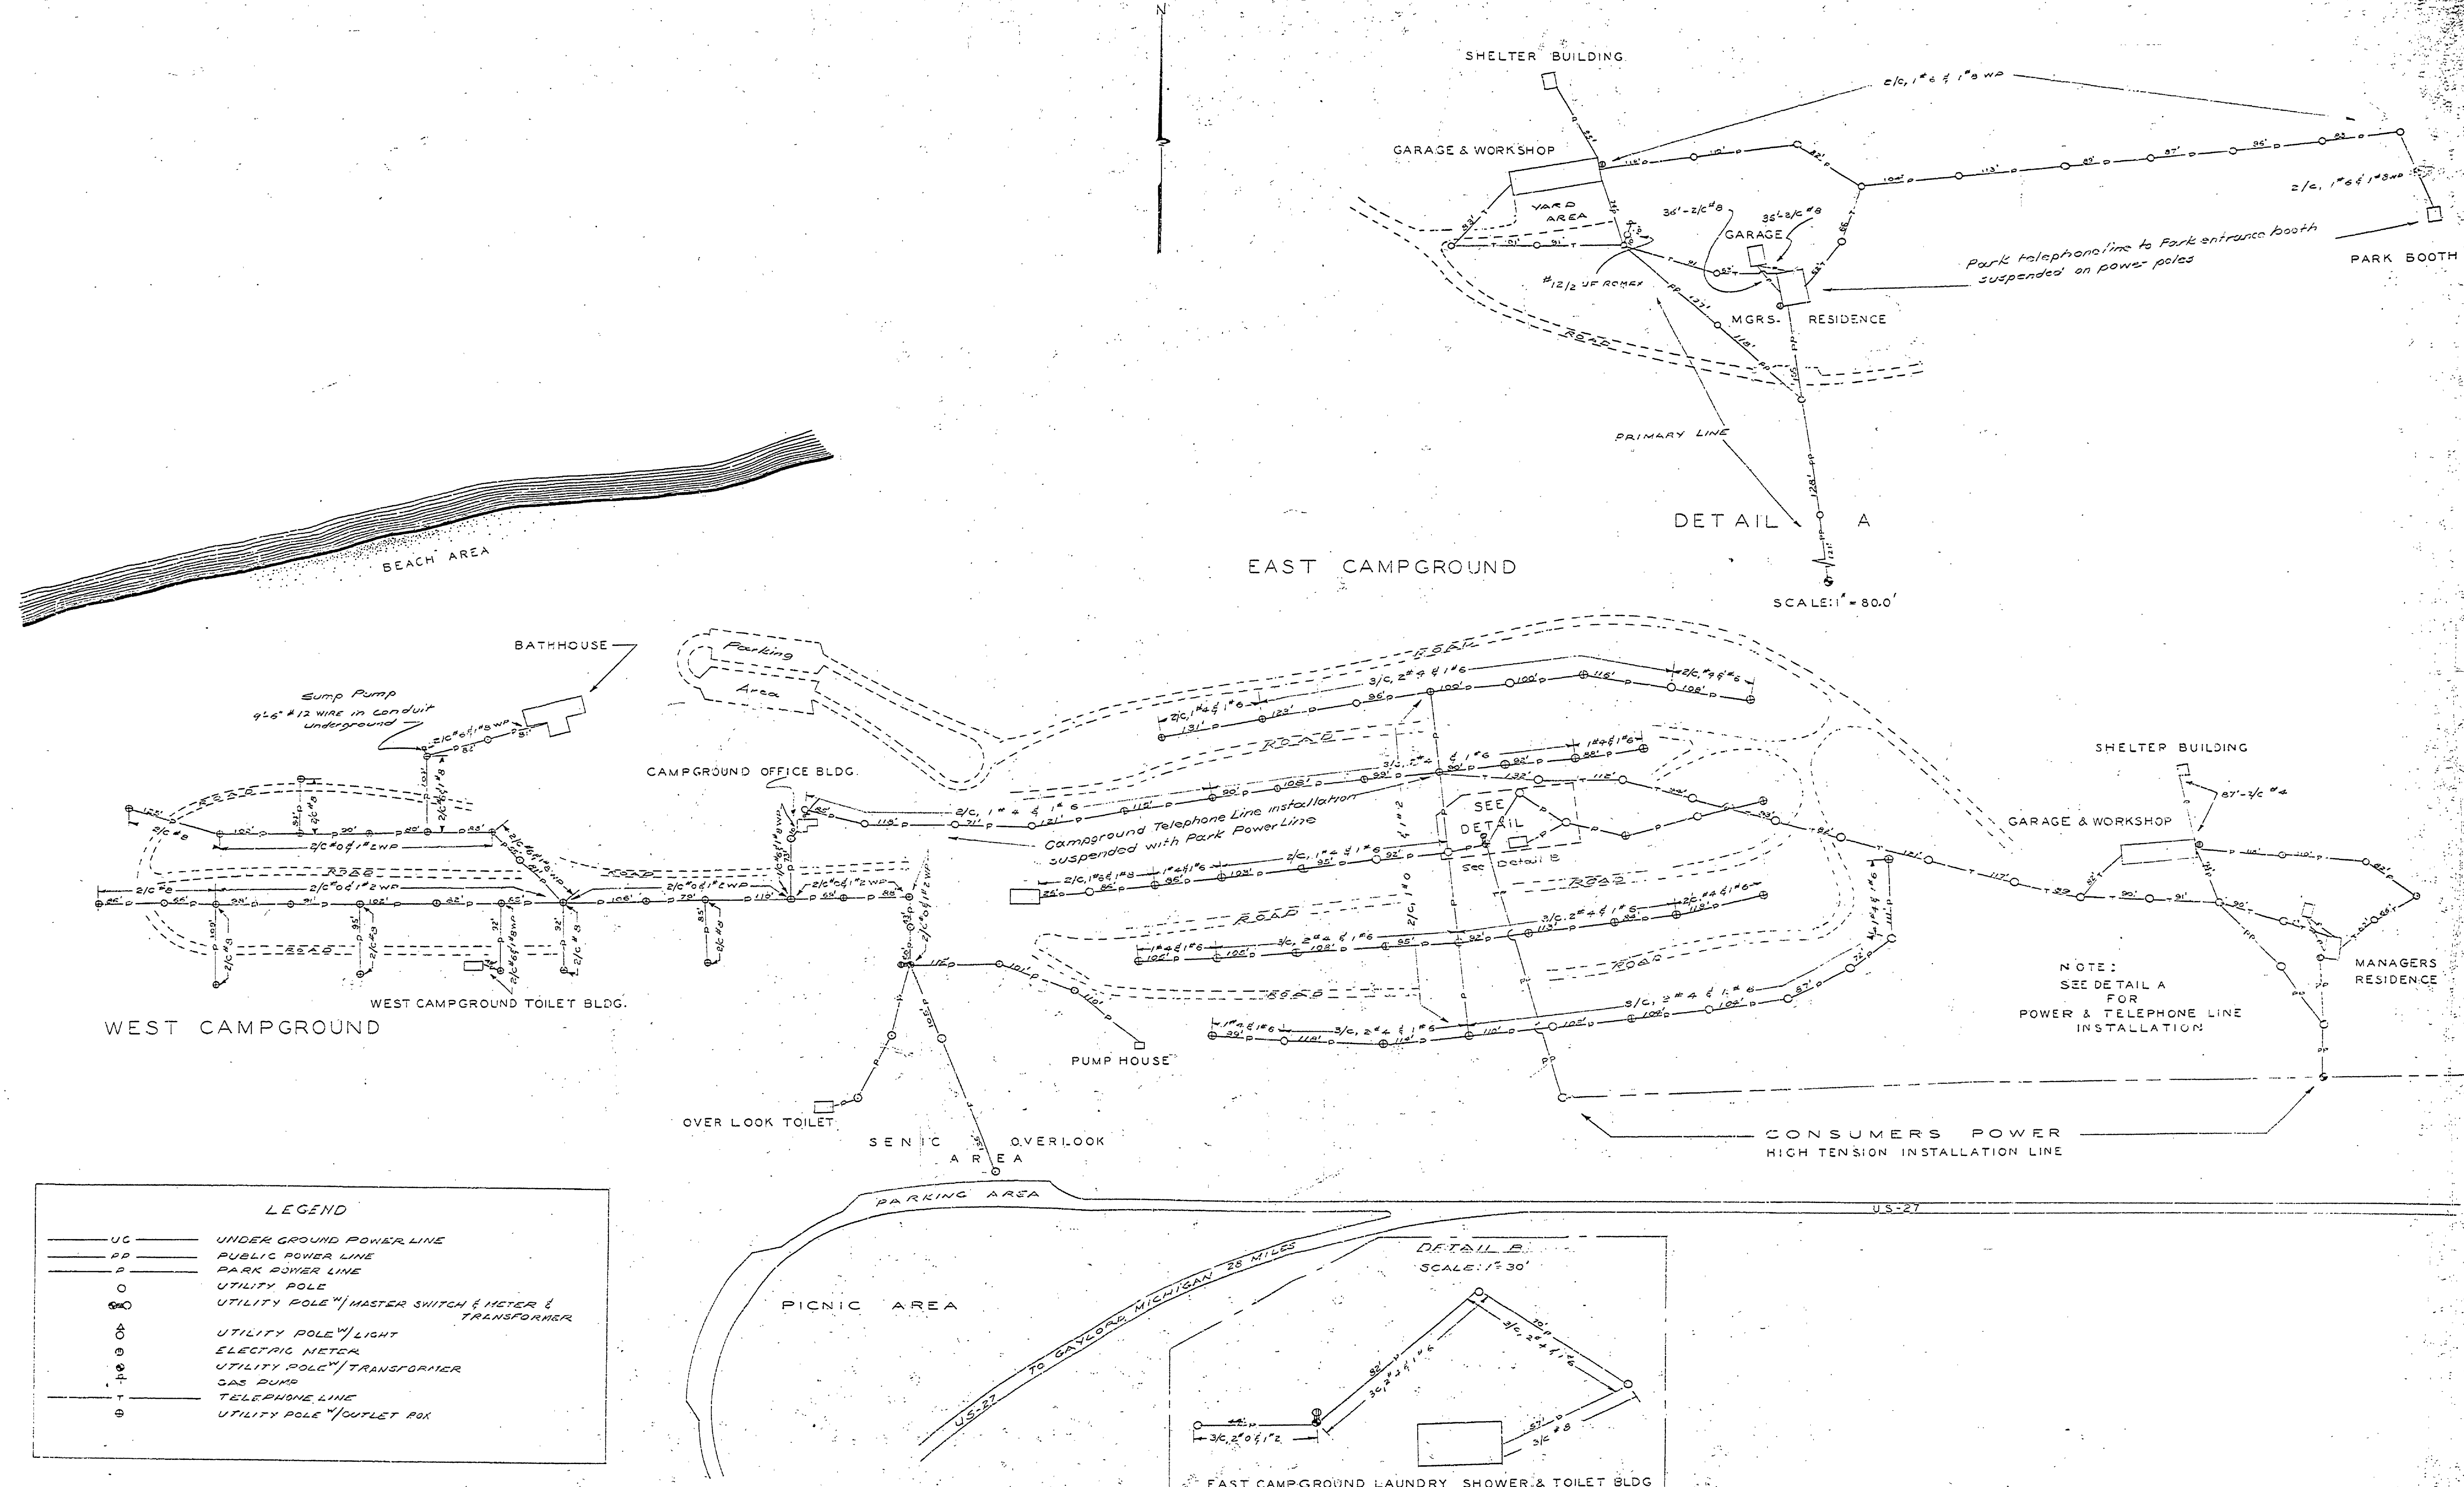

LEGEND

— UC —	UNDER GROUND POWER LINE
— PP —	PUBLIC POWER LINE
— P —	PARK POWER LINE
○	UTILITY POLE
○ ⊕	UTILITY POLE "MASTER SWITCH & METER & TRANSFORMER"
○ ⊕ ⊕	UTILITY POLE "LIGHT ELECTRIC METER"
○ ⊕ ⊕ ⊕	UTILITY POLE "TRANSFORMER"
⊕	GAS PUMP
— T —	TELEPHONE LINE
⊕	UTILITY POLE "OUTLET FOR"

NOTE:
SEE DETAIL A
FOR
POWER & TELEPHONE LINE
INSTALLATION