

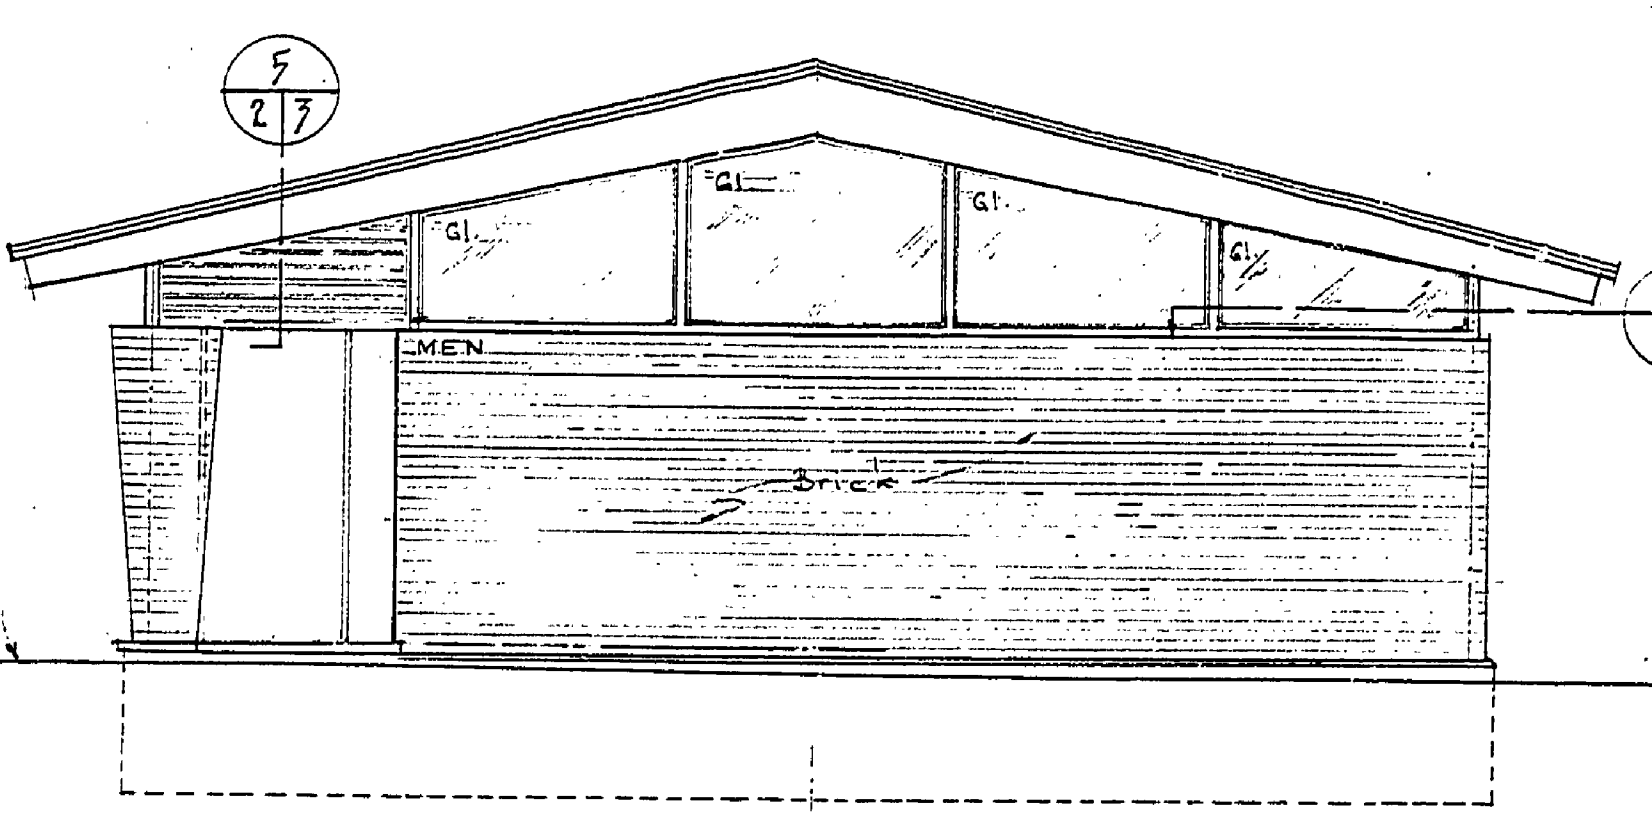
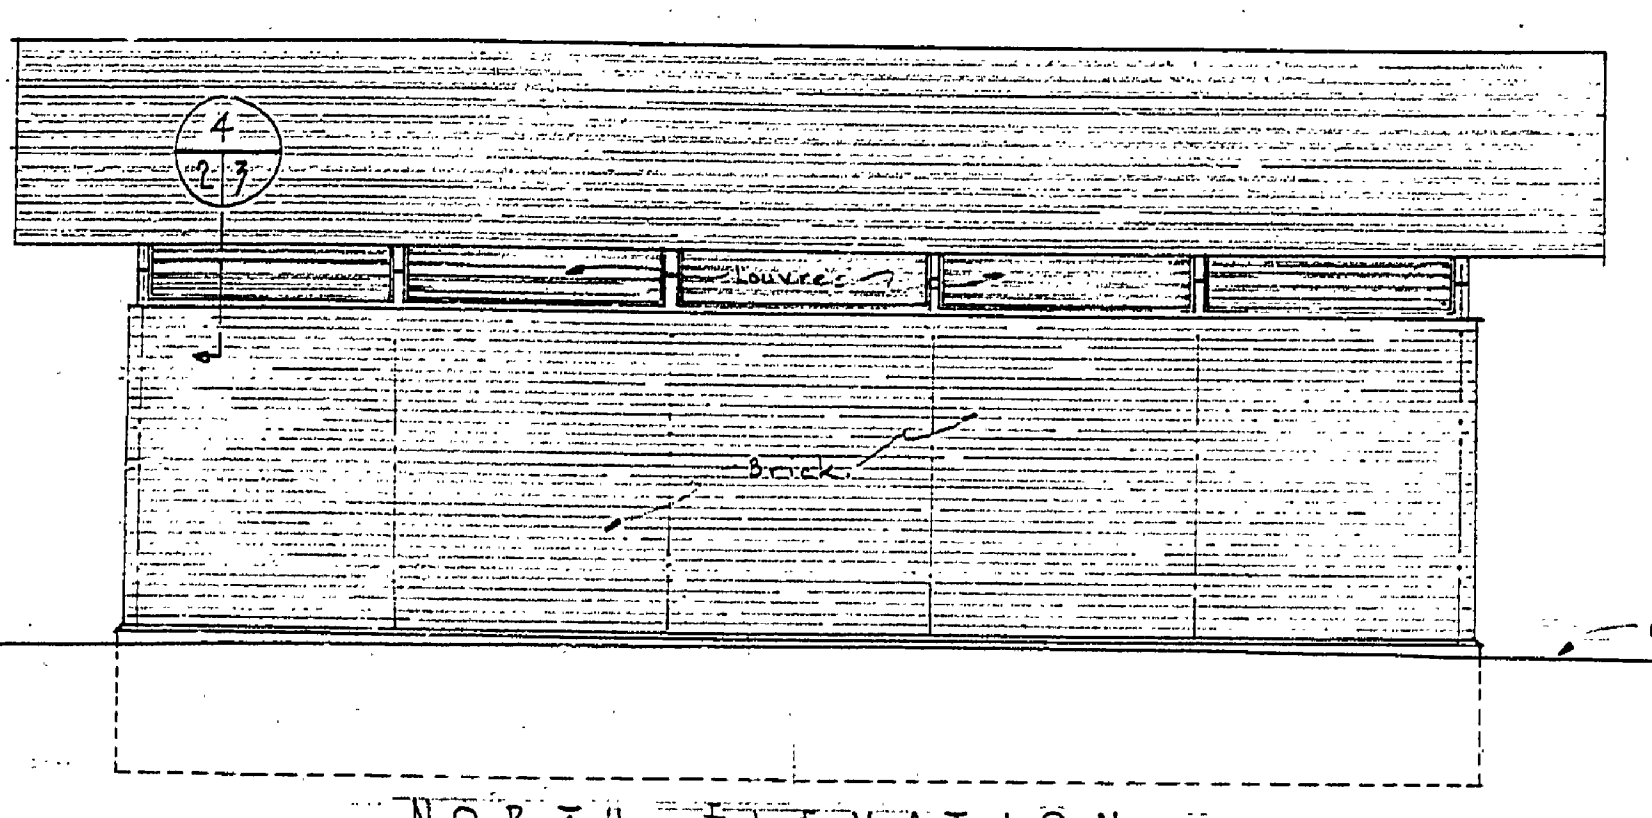
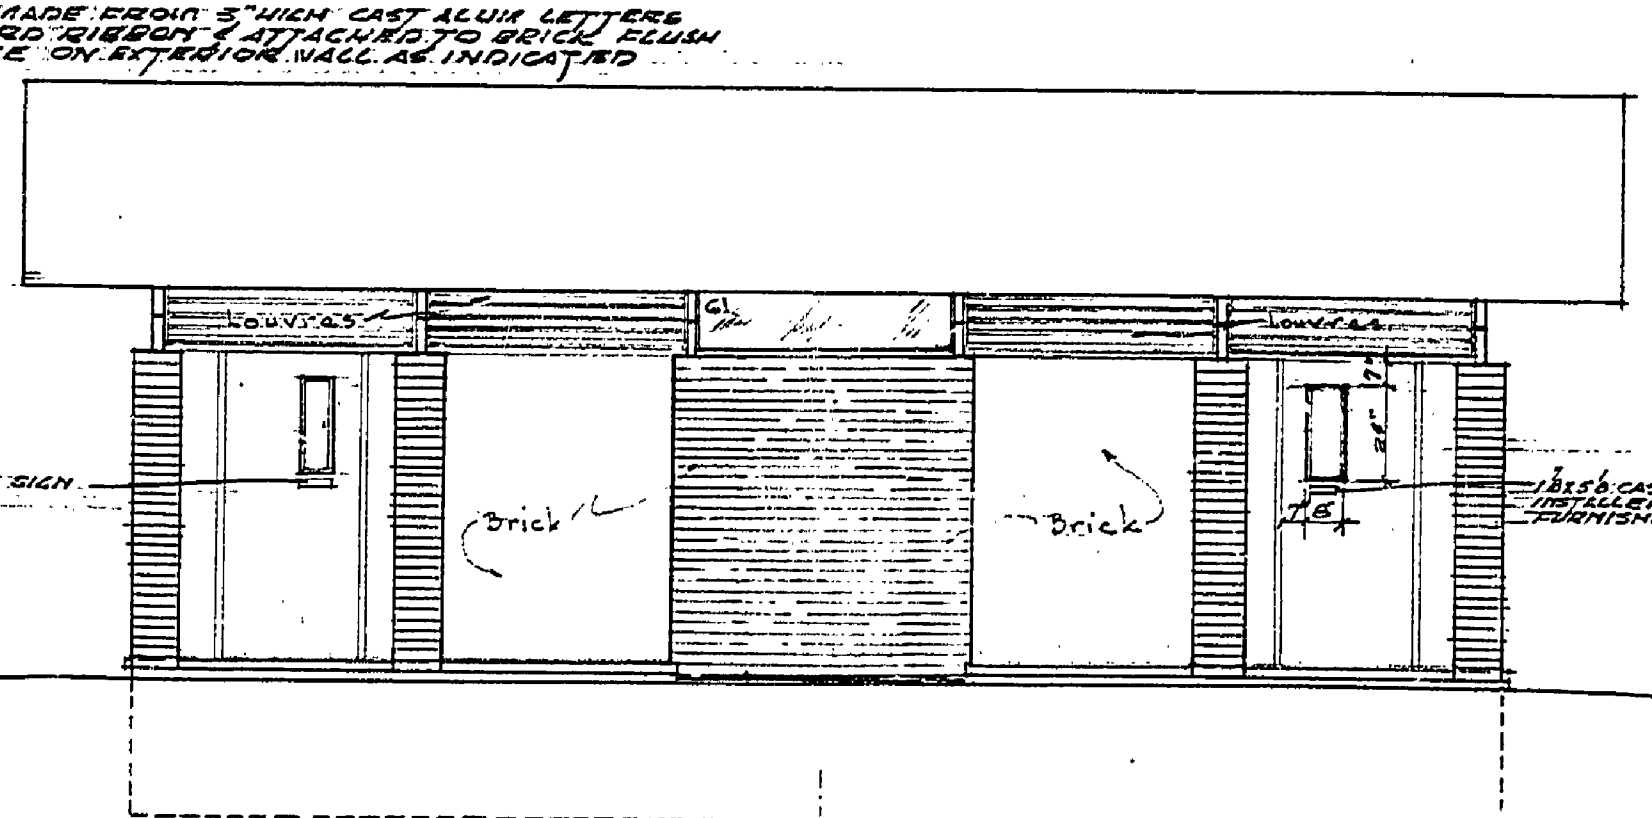
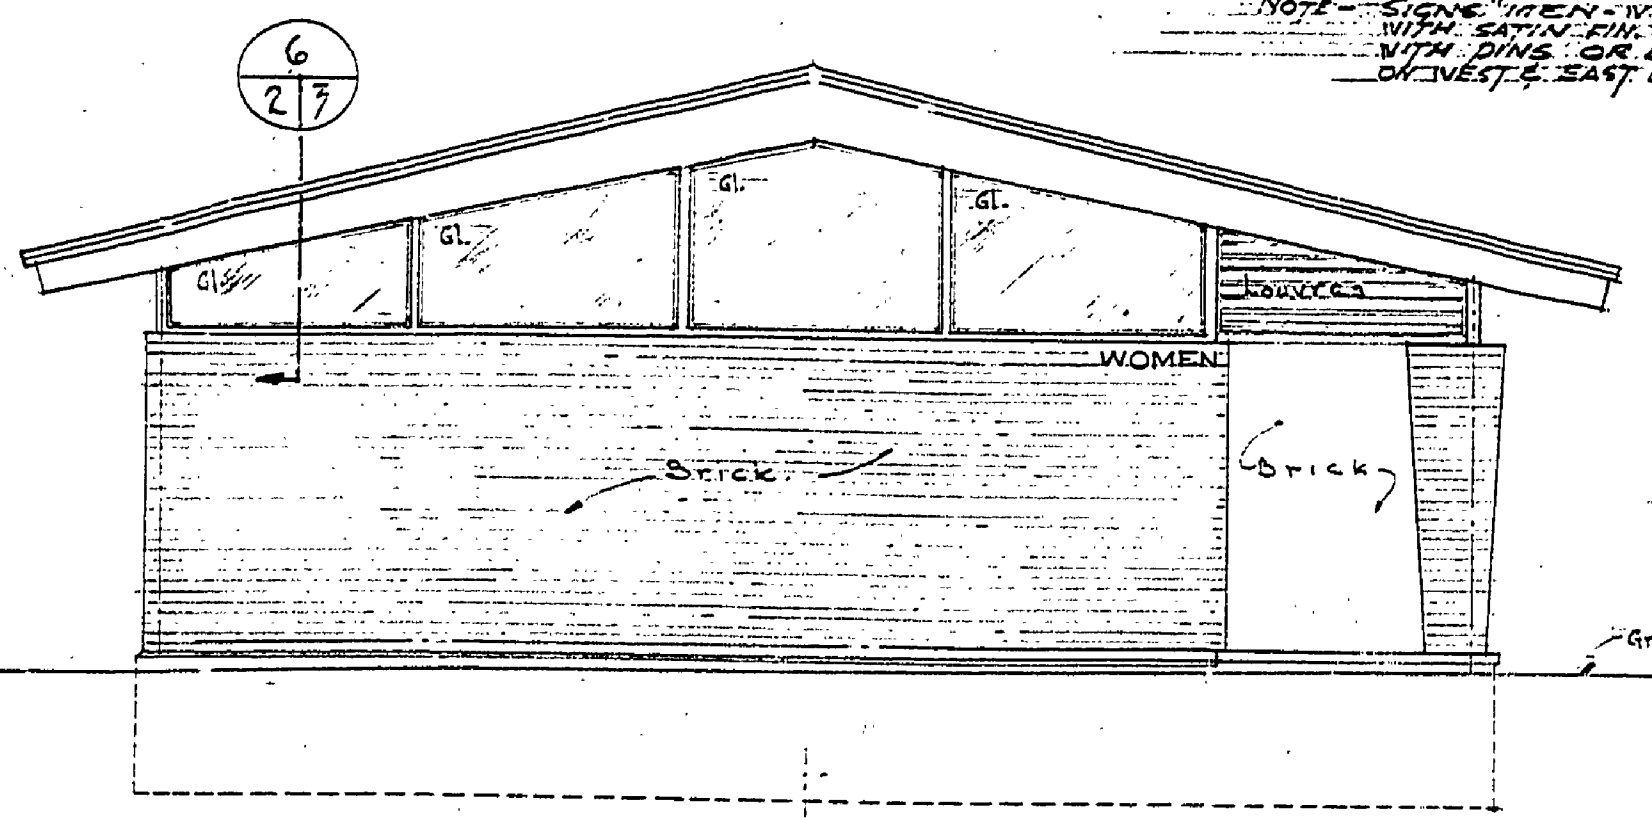
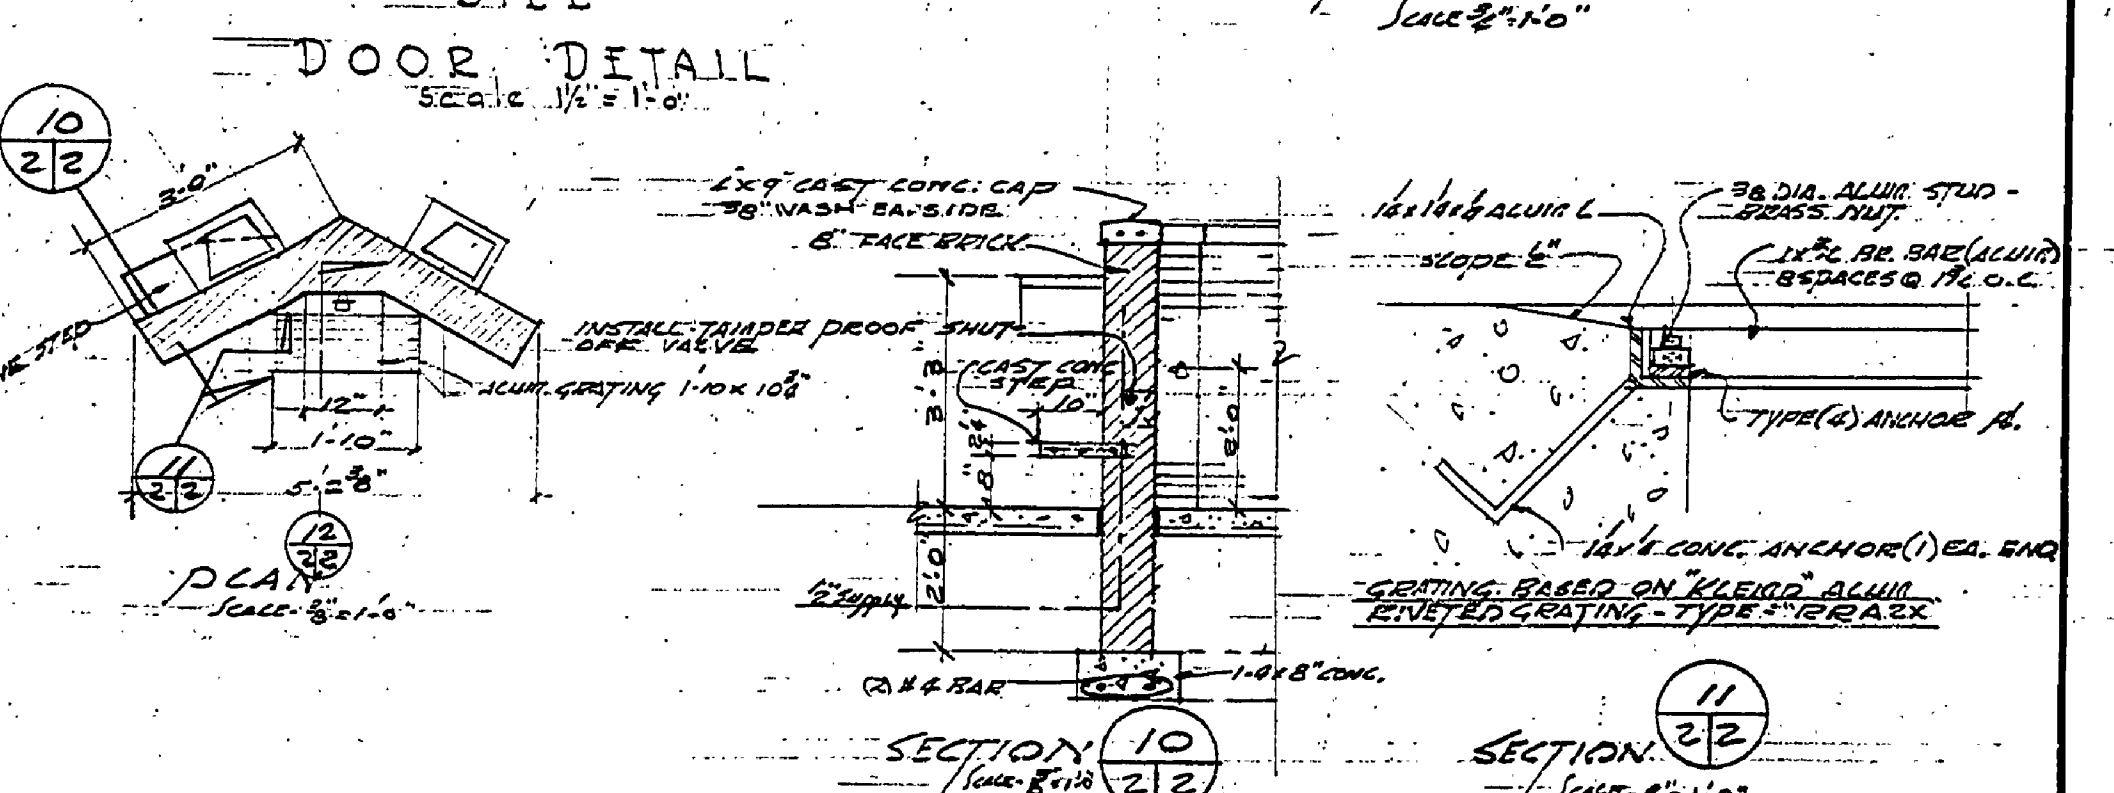
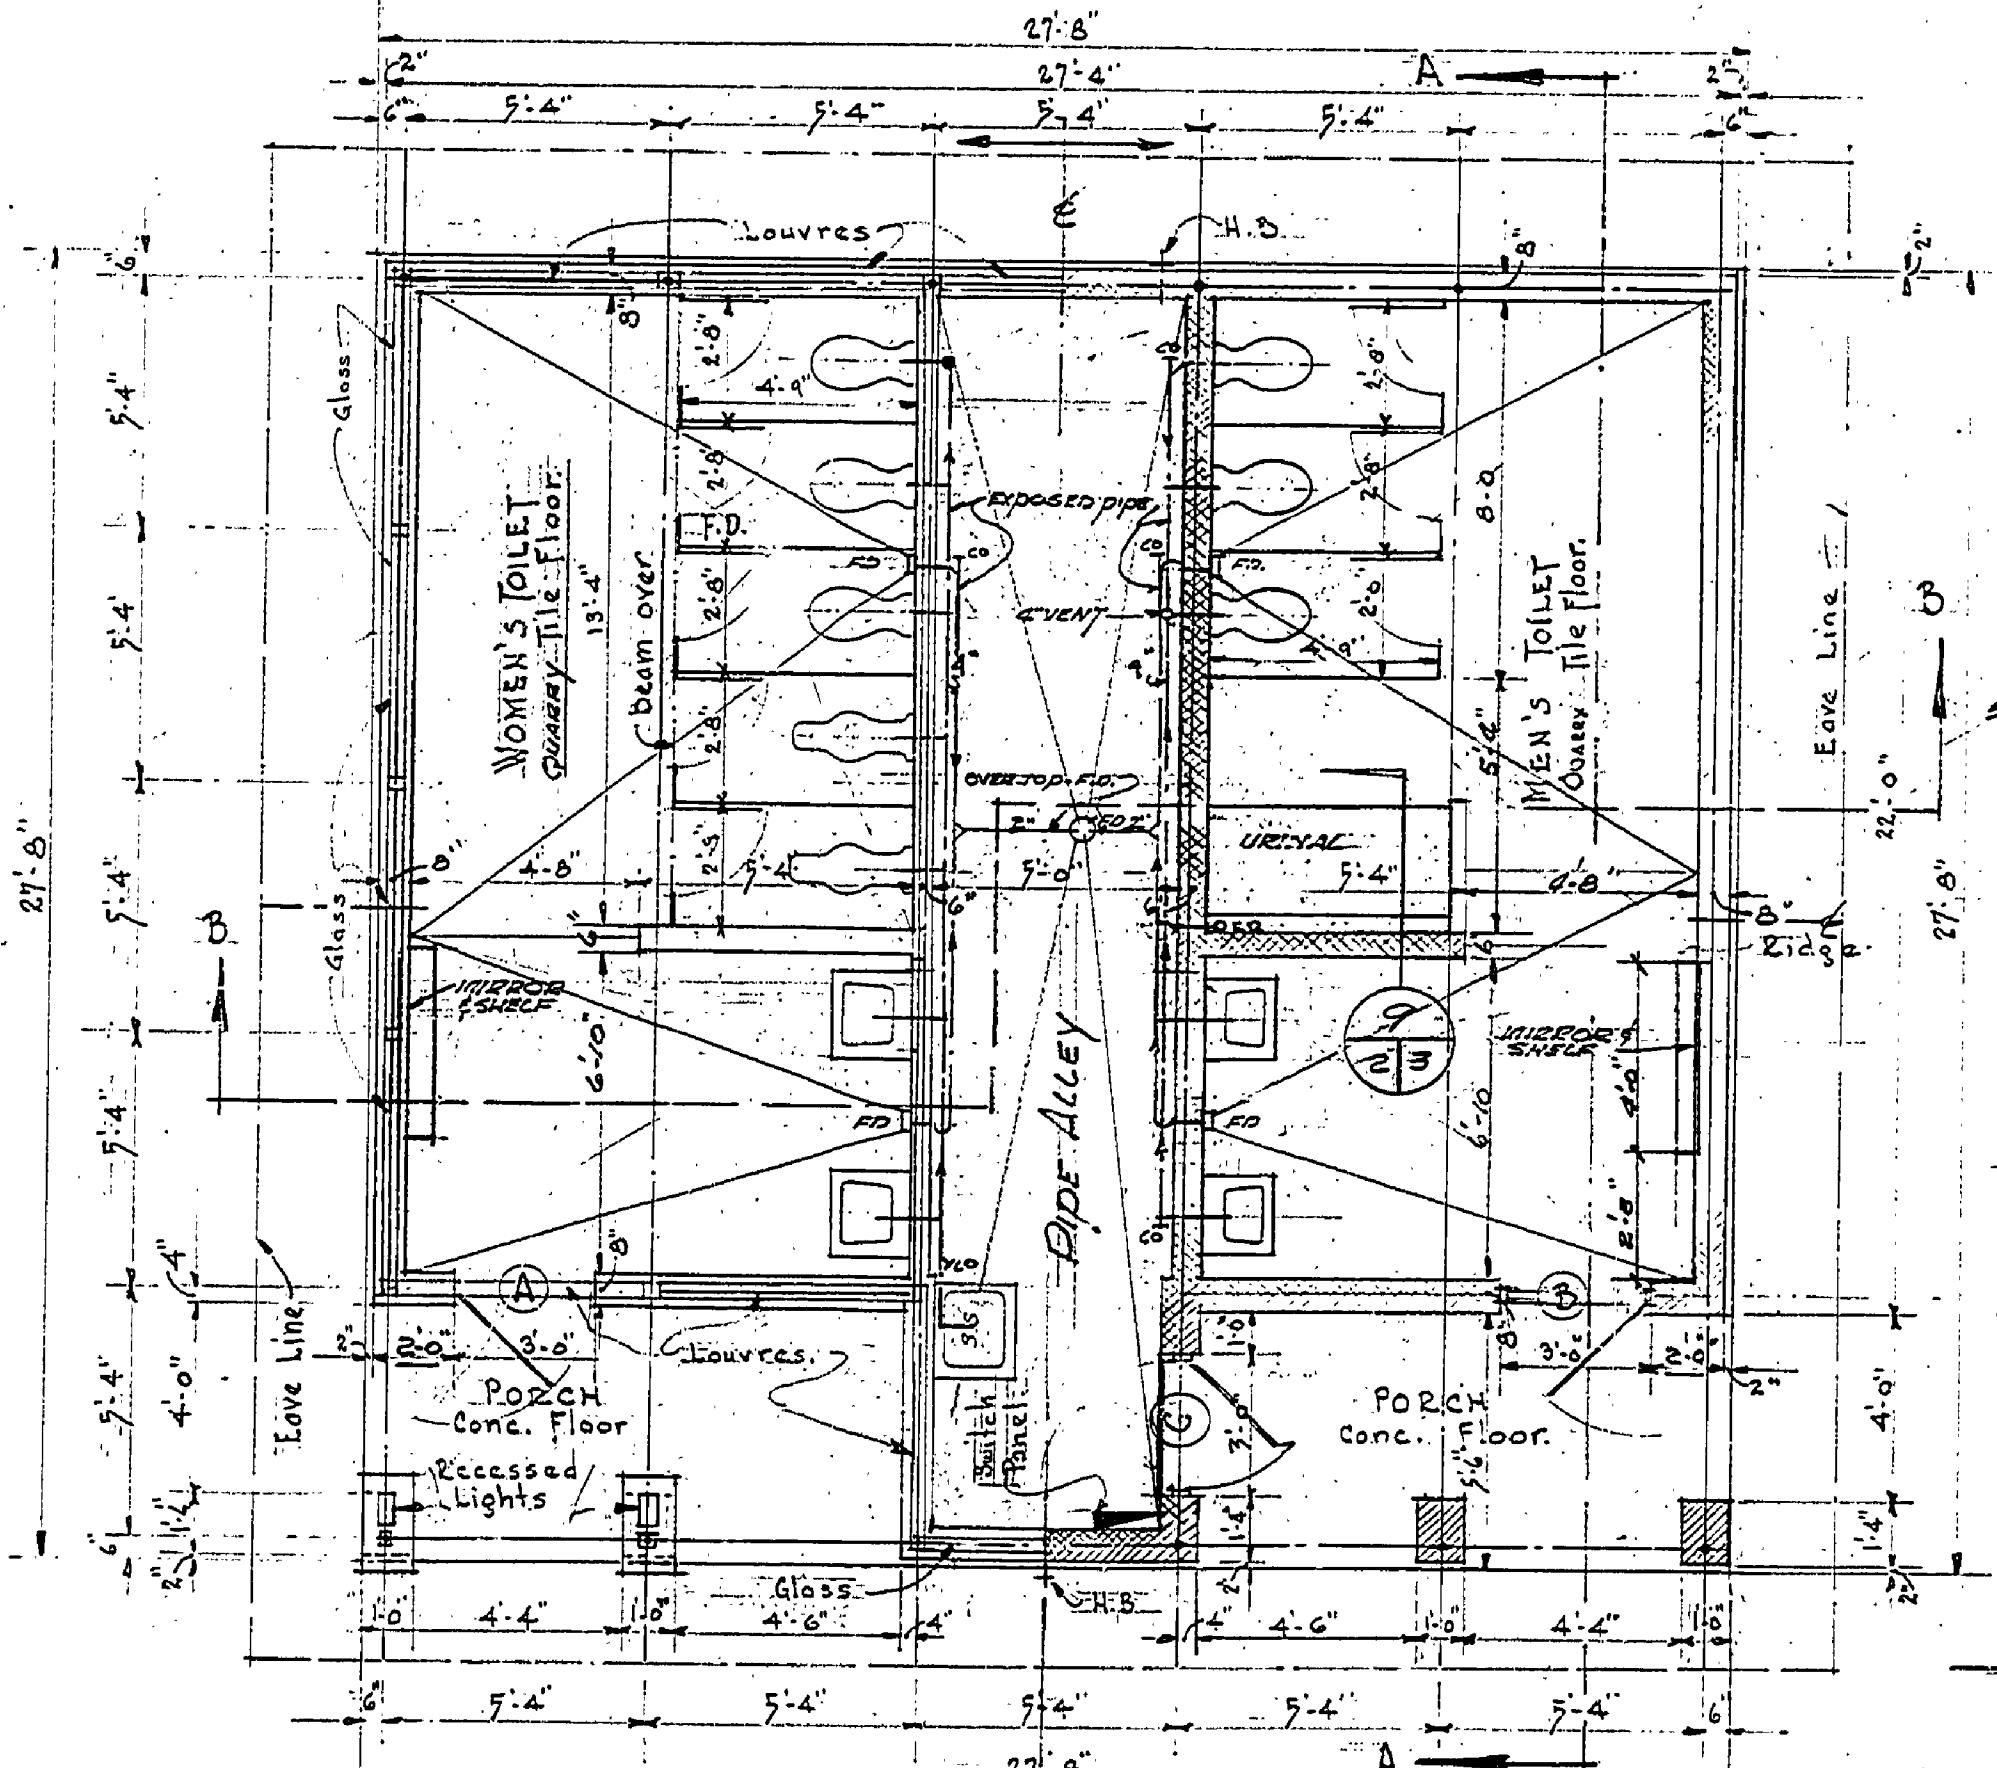
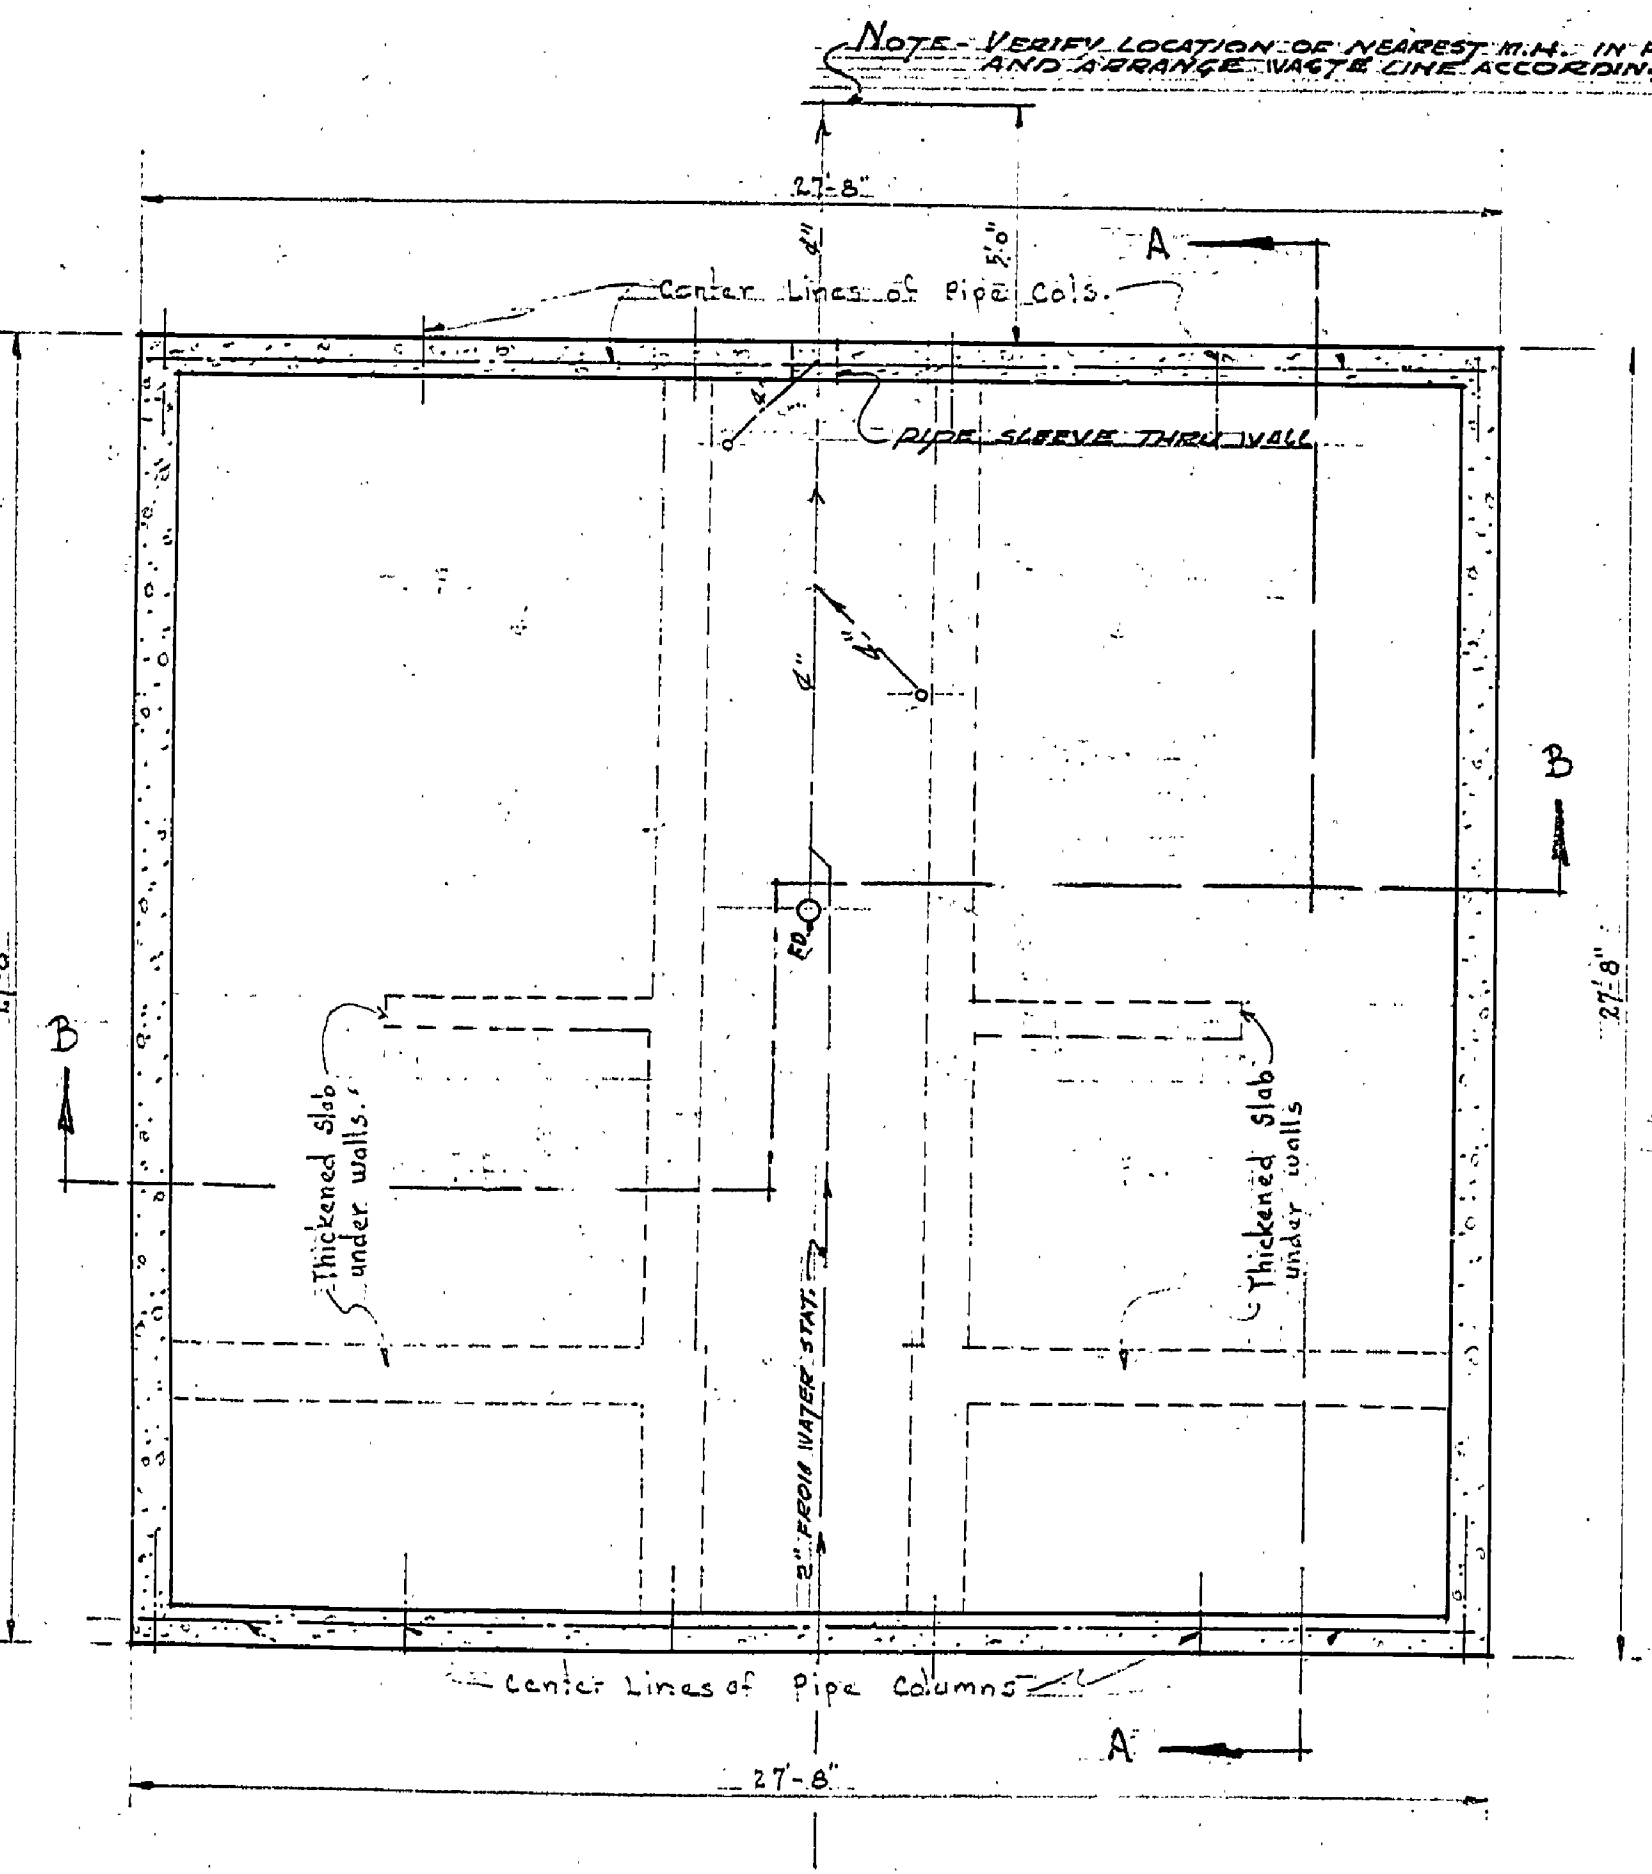


NO.	DATE	BY	REVISIONS	
			NO.	DATE
1	1/15/58	J.I.R.	ADDED WALLS - 14" x 8" x 8" REVISION	1
2	1/27/58	J.I.R.	ADDED WALLS - 14" x 8" x 8" REVISION	2
3	1/27/58	J.I.R.	ADDED WALLS - 14" x 8" x 8" REVISION	3
4	1/27/58	J.I.R.	ADDED WALLS - 14" x 8" x 8" REVISION	4
5	1/27/58	J.I.R.	ADDED WALLS - 14" x 8" x 8" REVISION	5
6	1/27/58	J.I.R.	ADDED WALLS - 14" x 8" x 8" REVISION	6

DESIGNED BY	TRACED BY	CHECKED BY	DATE	APPROVED BY	DATE
W. M. G.	J. W. H.	W. M. G.	12-16-58	J. C. P.	12-16-58
			1/15/58		1/15/58
			1/27/58		1/27/58
			1/27/58		1/27/58

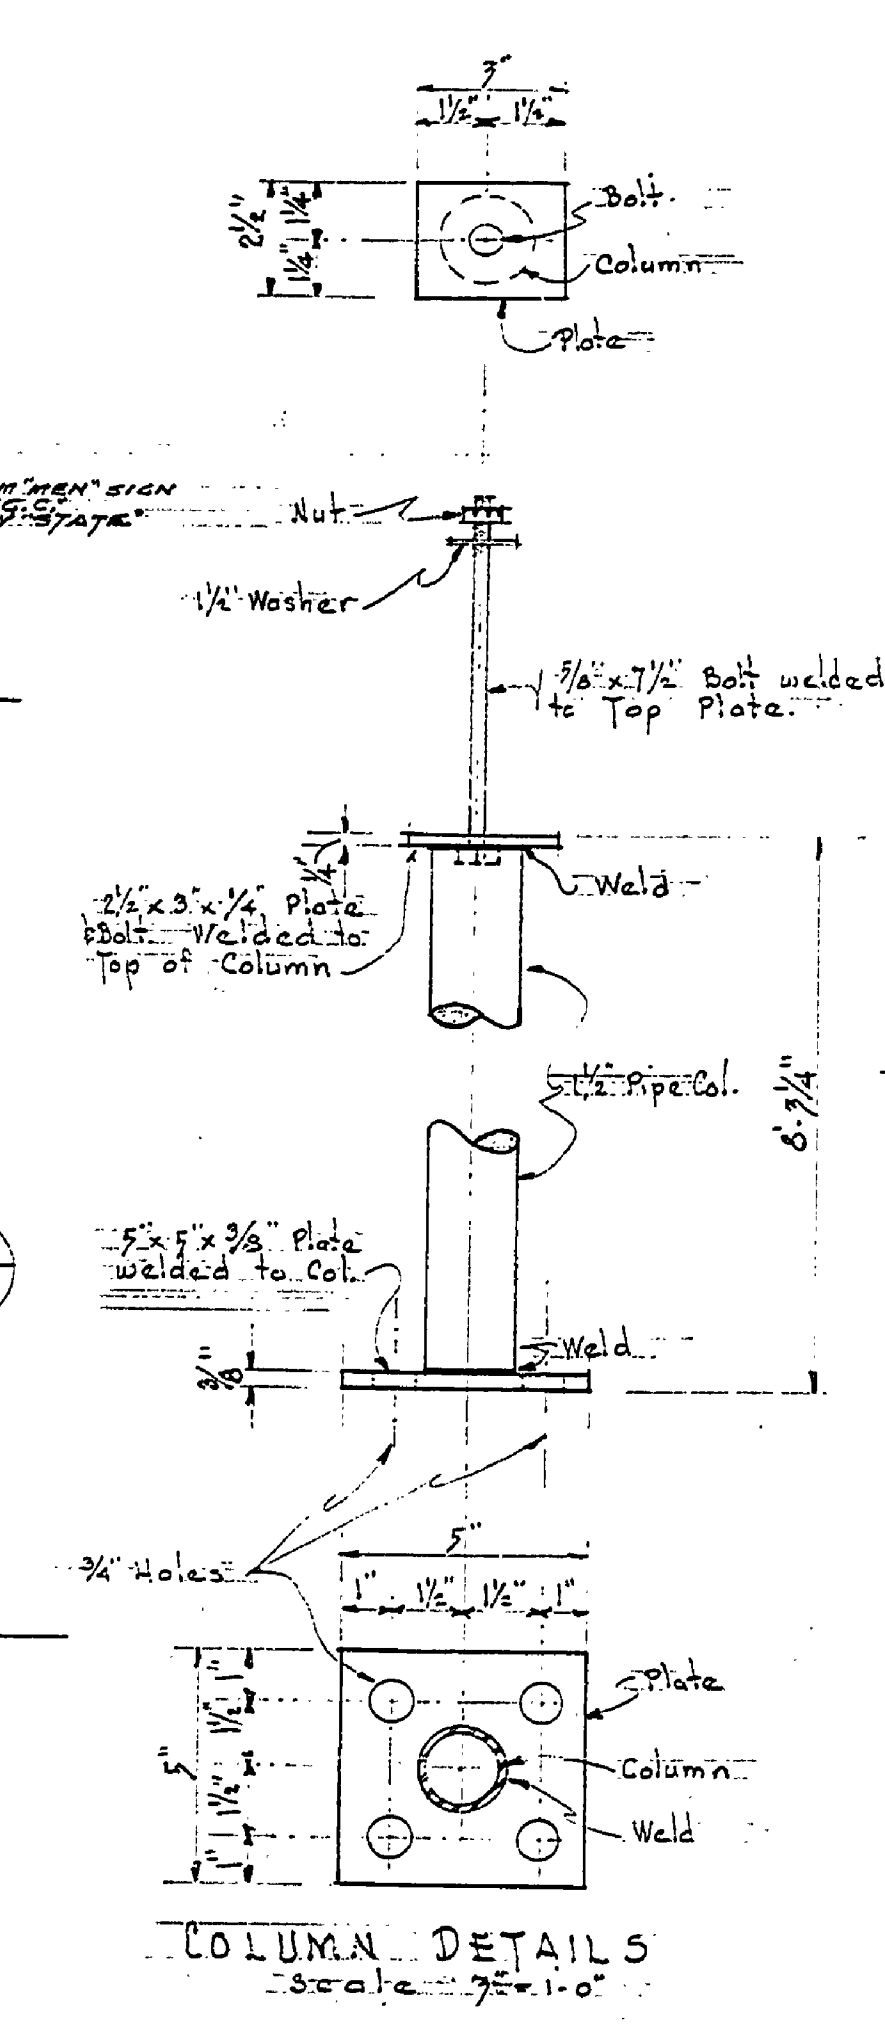

ROOMS	FLOOR				BASE				WALLS				CEILING				WOOD			
	CONCRETE	SP. GLAZED	SP. GLAZED	SP. GLAZED	CONCRETE	SP. GLAZED	SP. GLAZED	SP. GLAZED	SP. GLAZED	SP. GLAZED	SP. GLAZED	SP. GLAZED	SP. GLAZED	SP. GLAZED	SP. GLAZED	SP. GLAZED	SP. GLAZED	SP. GLAZED		
Women's Toilet Room																				
Men's Toilet Room																				
Pipe Alley																				

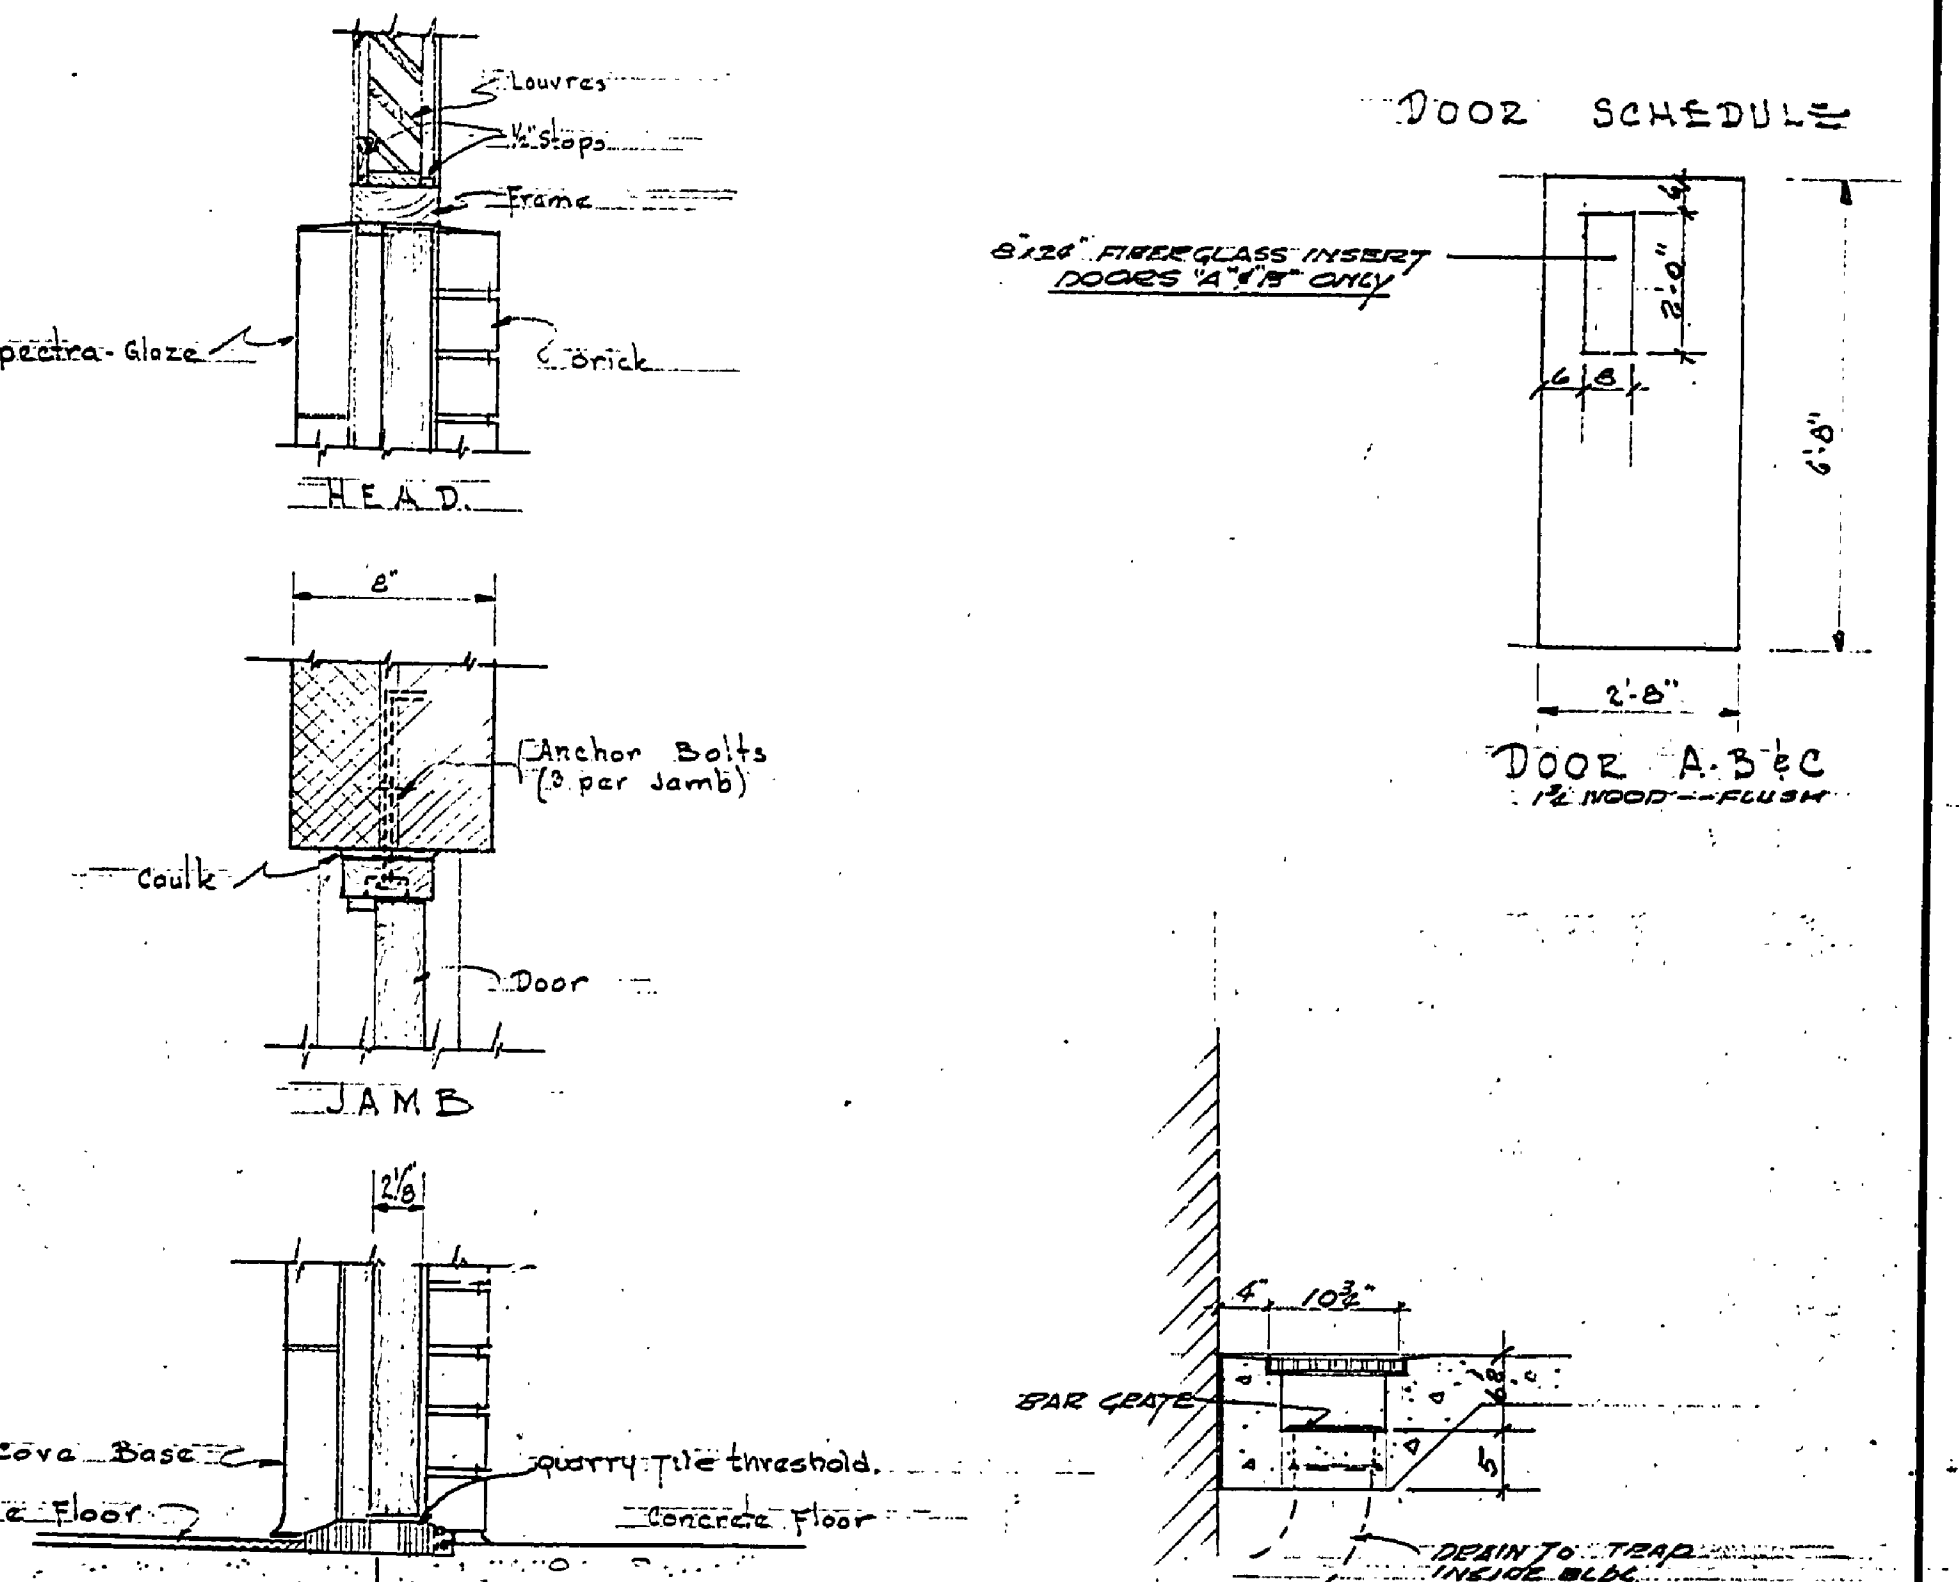

SECTION	SCALE
SECTION 10	1/4" = 1'-0"
SECTION 11	1/4" = 1'-0"
SECTION 12	1/4" = 1'-0"

ARCHITECTURAL SYMBOLS	DETAIL DESIGNATION
Concrete or Concrete Block	CONCRETE
Brick	BRICK
Steel or Aluminum	STEEL
Dimensioned Wood	WOOD
F.D. - Floor Drain	F.D.
C.I. - Cast Iron	C.I.
S.S. - Service Sink	S.S.
S.C. - Sill Cock	S.C.
M.B. - Hose Bib	M.B.
SP. GLAZED BLOCK	SP. GLAZED BLOCK
WOOD	WOOD
FLOOR TILE	FLOOR TILE

MICHIGAN DEPARTMENT OF CONSERVATION PARKS AND RECREATION DIVISION

PLANS AND ELEVATIONS - SCHEDULES	SHEET NO.	PLAN NO.
YANKEE SPRINGS RECREATION AREA GUN LAKE DAY USE SECTION TOILET BUILDINGS #5	2 OF 3	A-178