
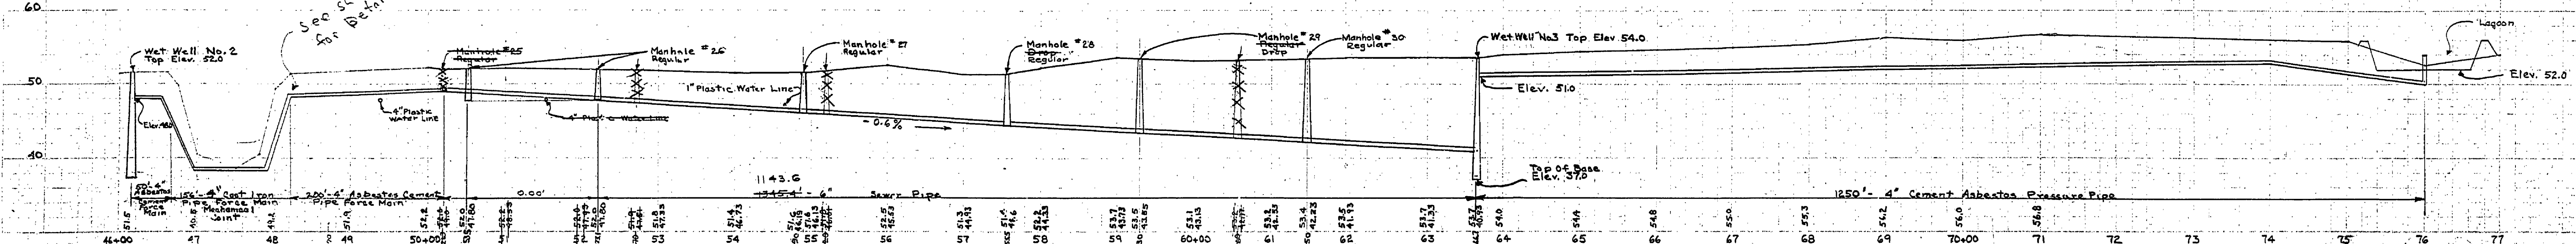
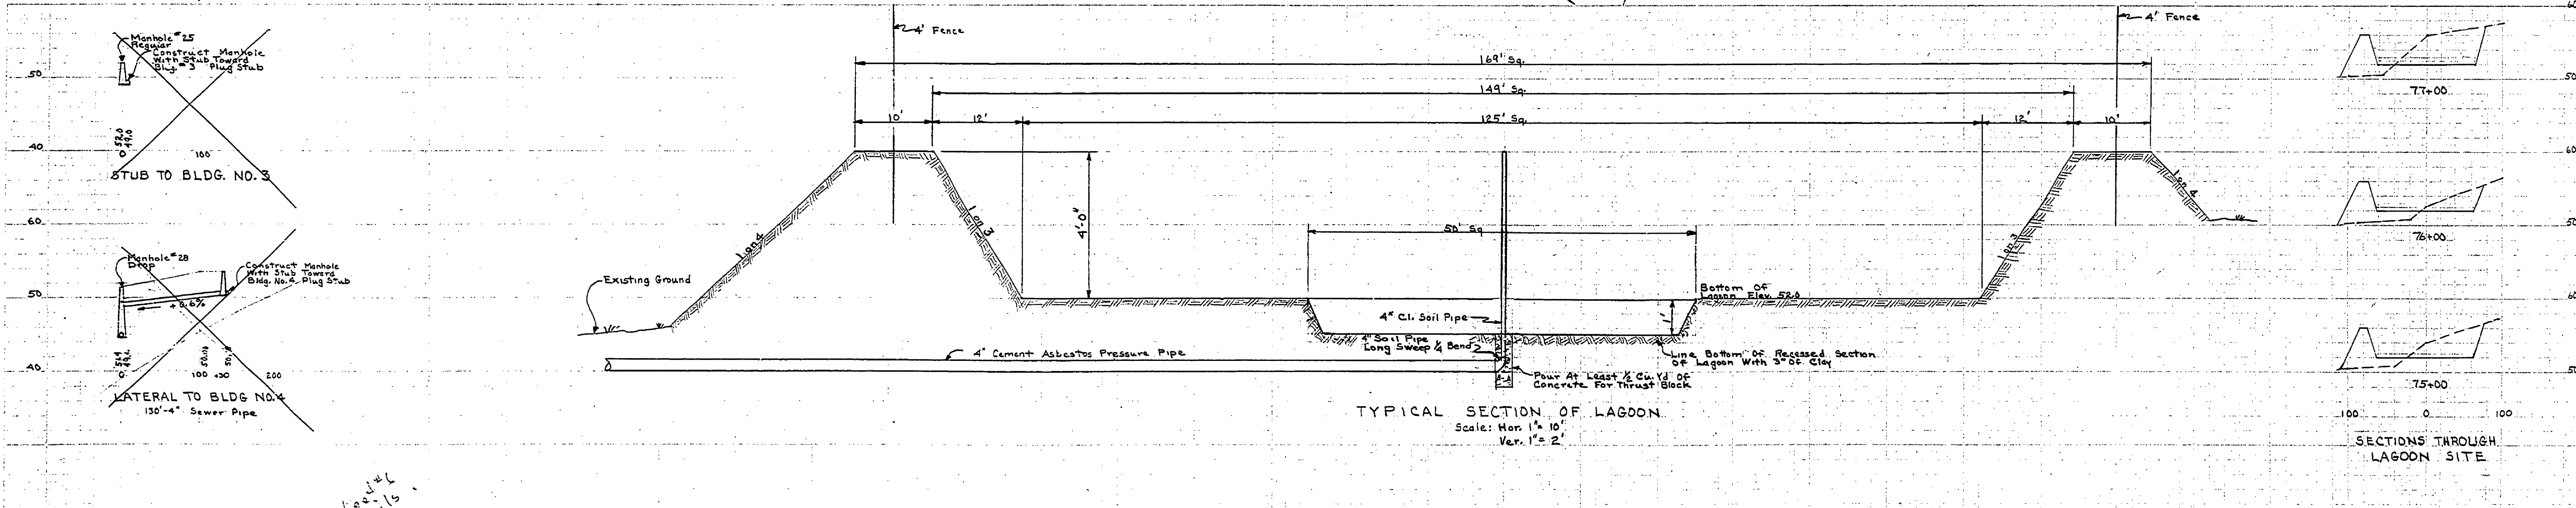


DRAWN BY B.H.G.	CHECKED BY E.J.P.	DATE 8 Jan. 1963	REVIEWED BY SECTIONS			APPROVED BY		
			ARCHITECTURAL J.I.R.	ENGINEERING J.I.R.	LANDSCAPE J.I.R.	DATE 3-29-60	DATE 3-29-60	DATE 3-29-60
			REVISIONS			NO. DATE BY		
			1	10-1-60	J.V.	Revised To Meet Well #3	4	
			2				5	
			3				6	

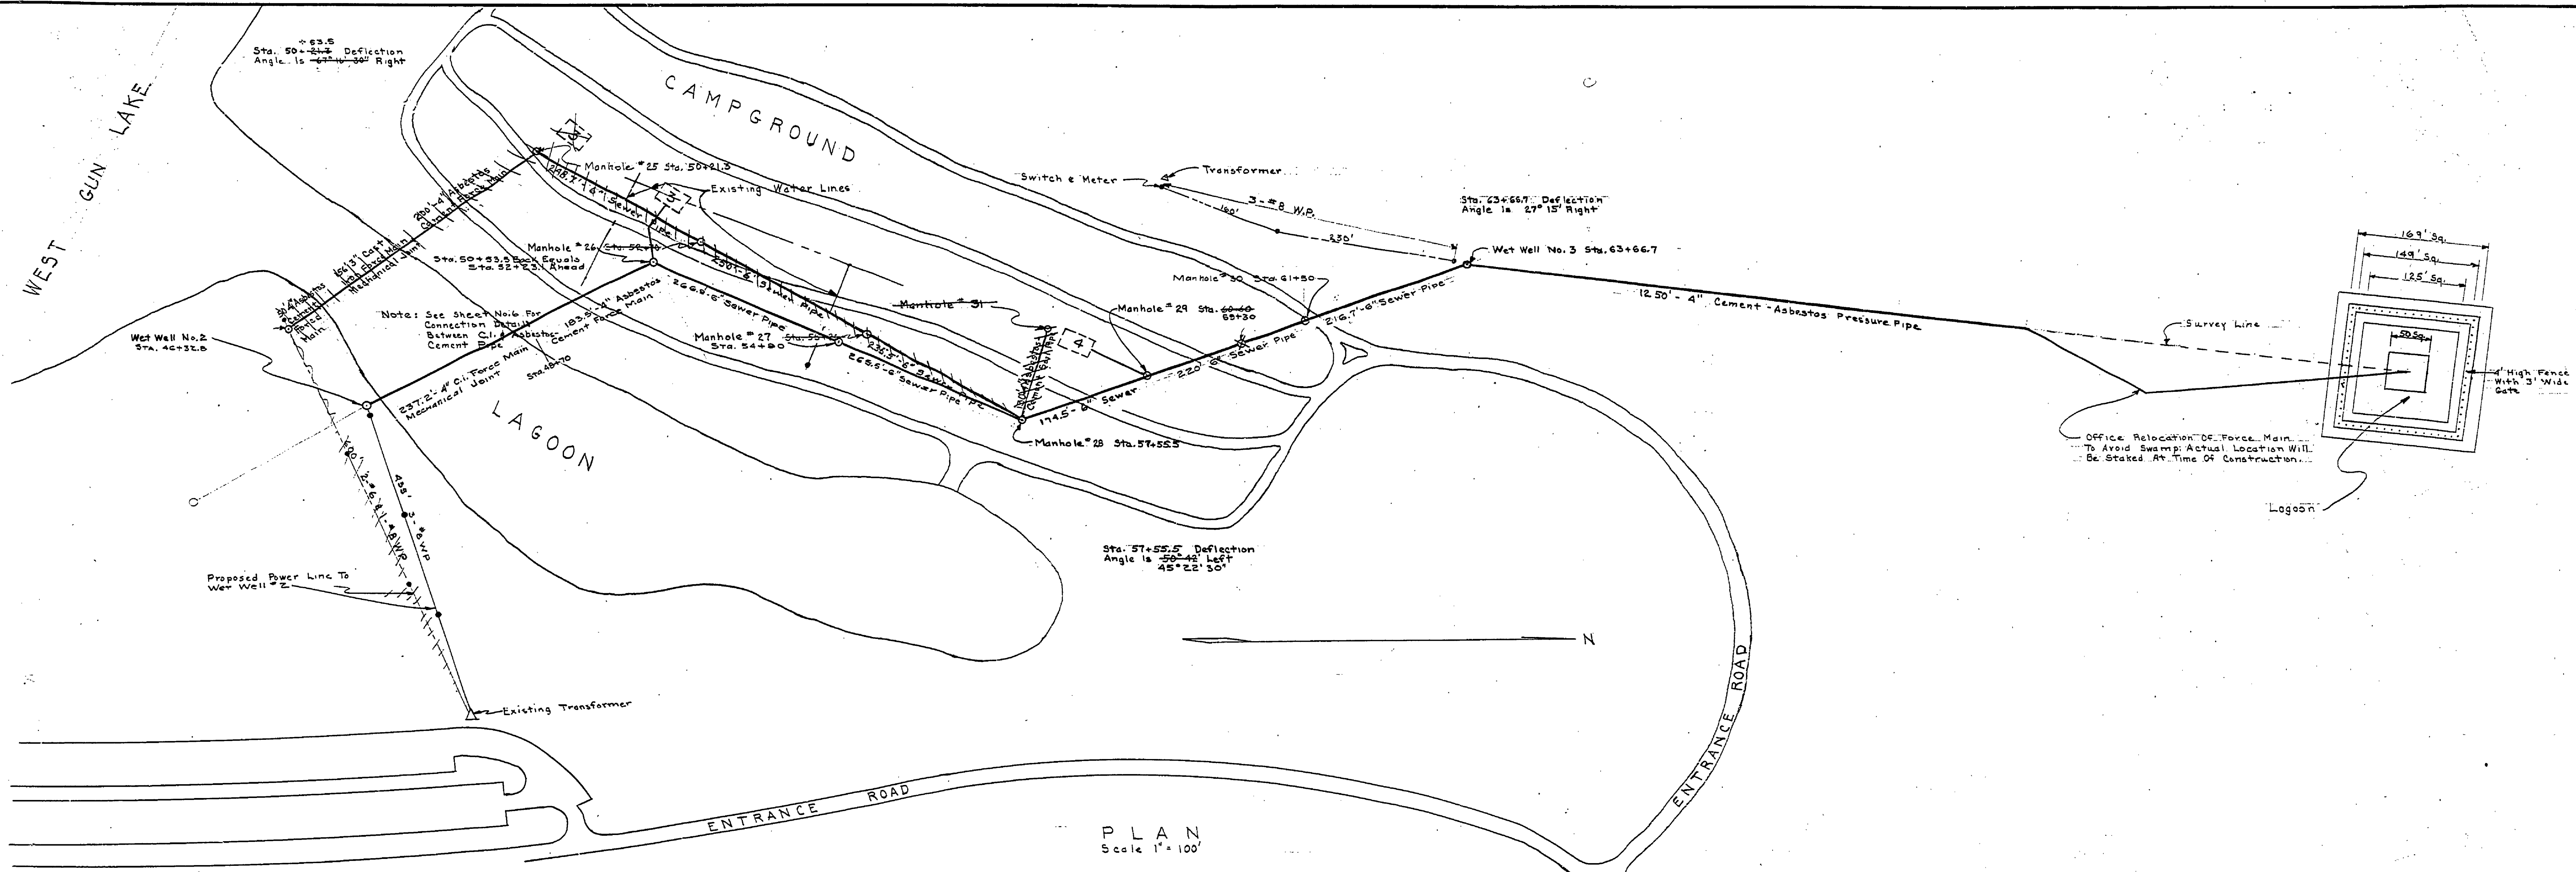

MICHIGAN DEPARTMENT OF CONSERVATION PARKS AND RECREATION DIVISION		YANKEE SPRINGS RECREATION AREA GUN LAKE DAY USE SECTION CENTRAL SEWAGE DISPOSAL SYSTEM		SHEET NO. 3 OF 6	PLAN NO. E-136
---	--	--	--	------------------	----------------