
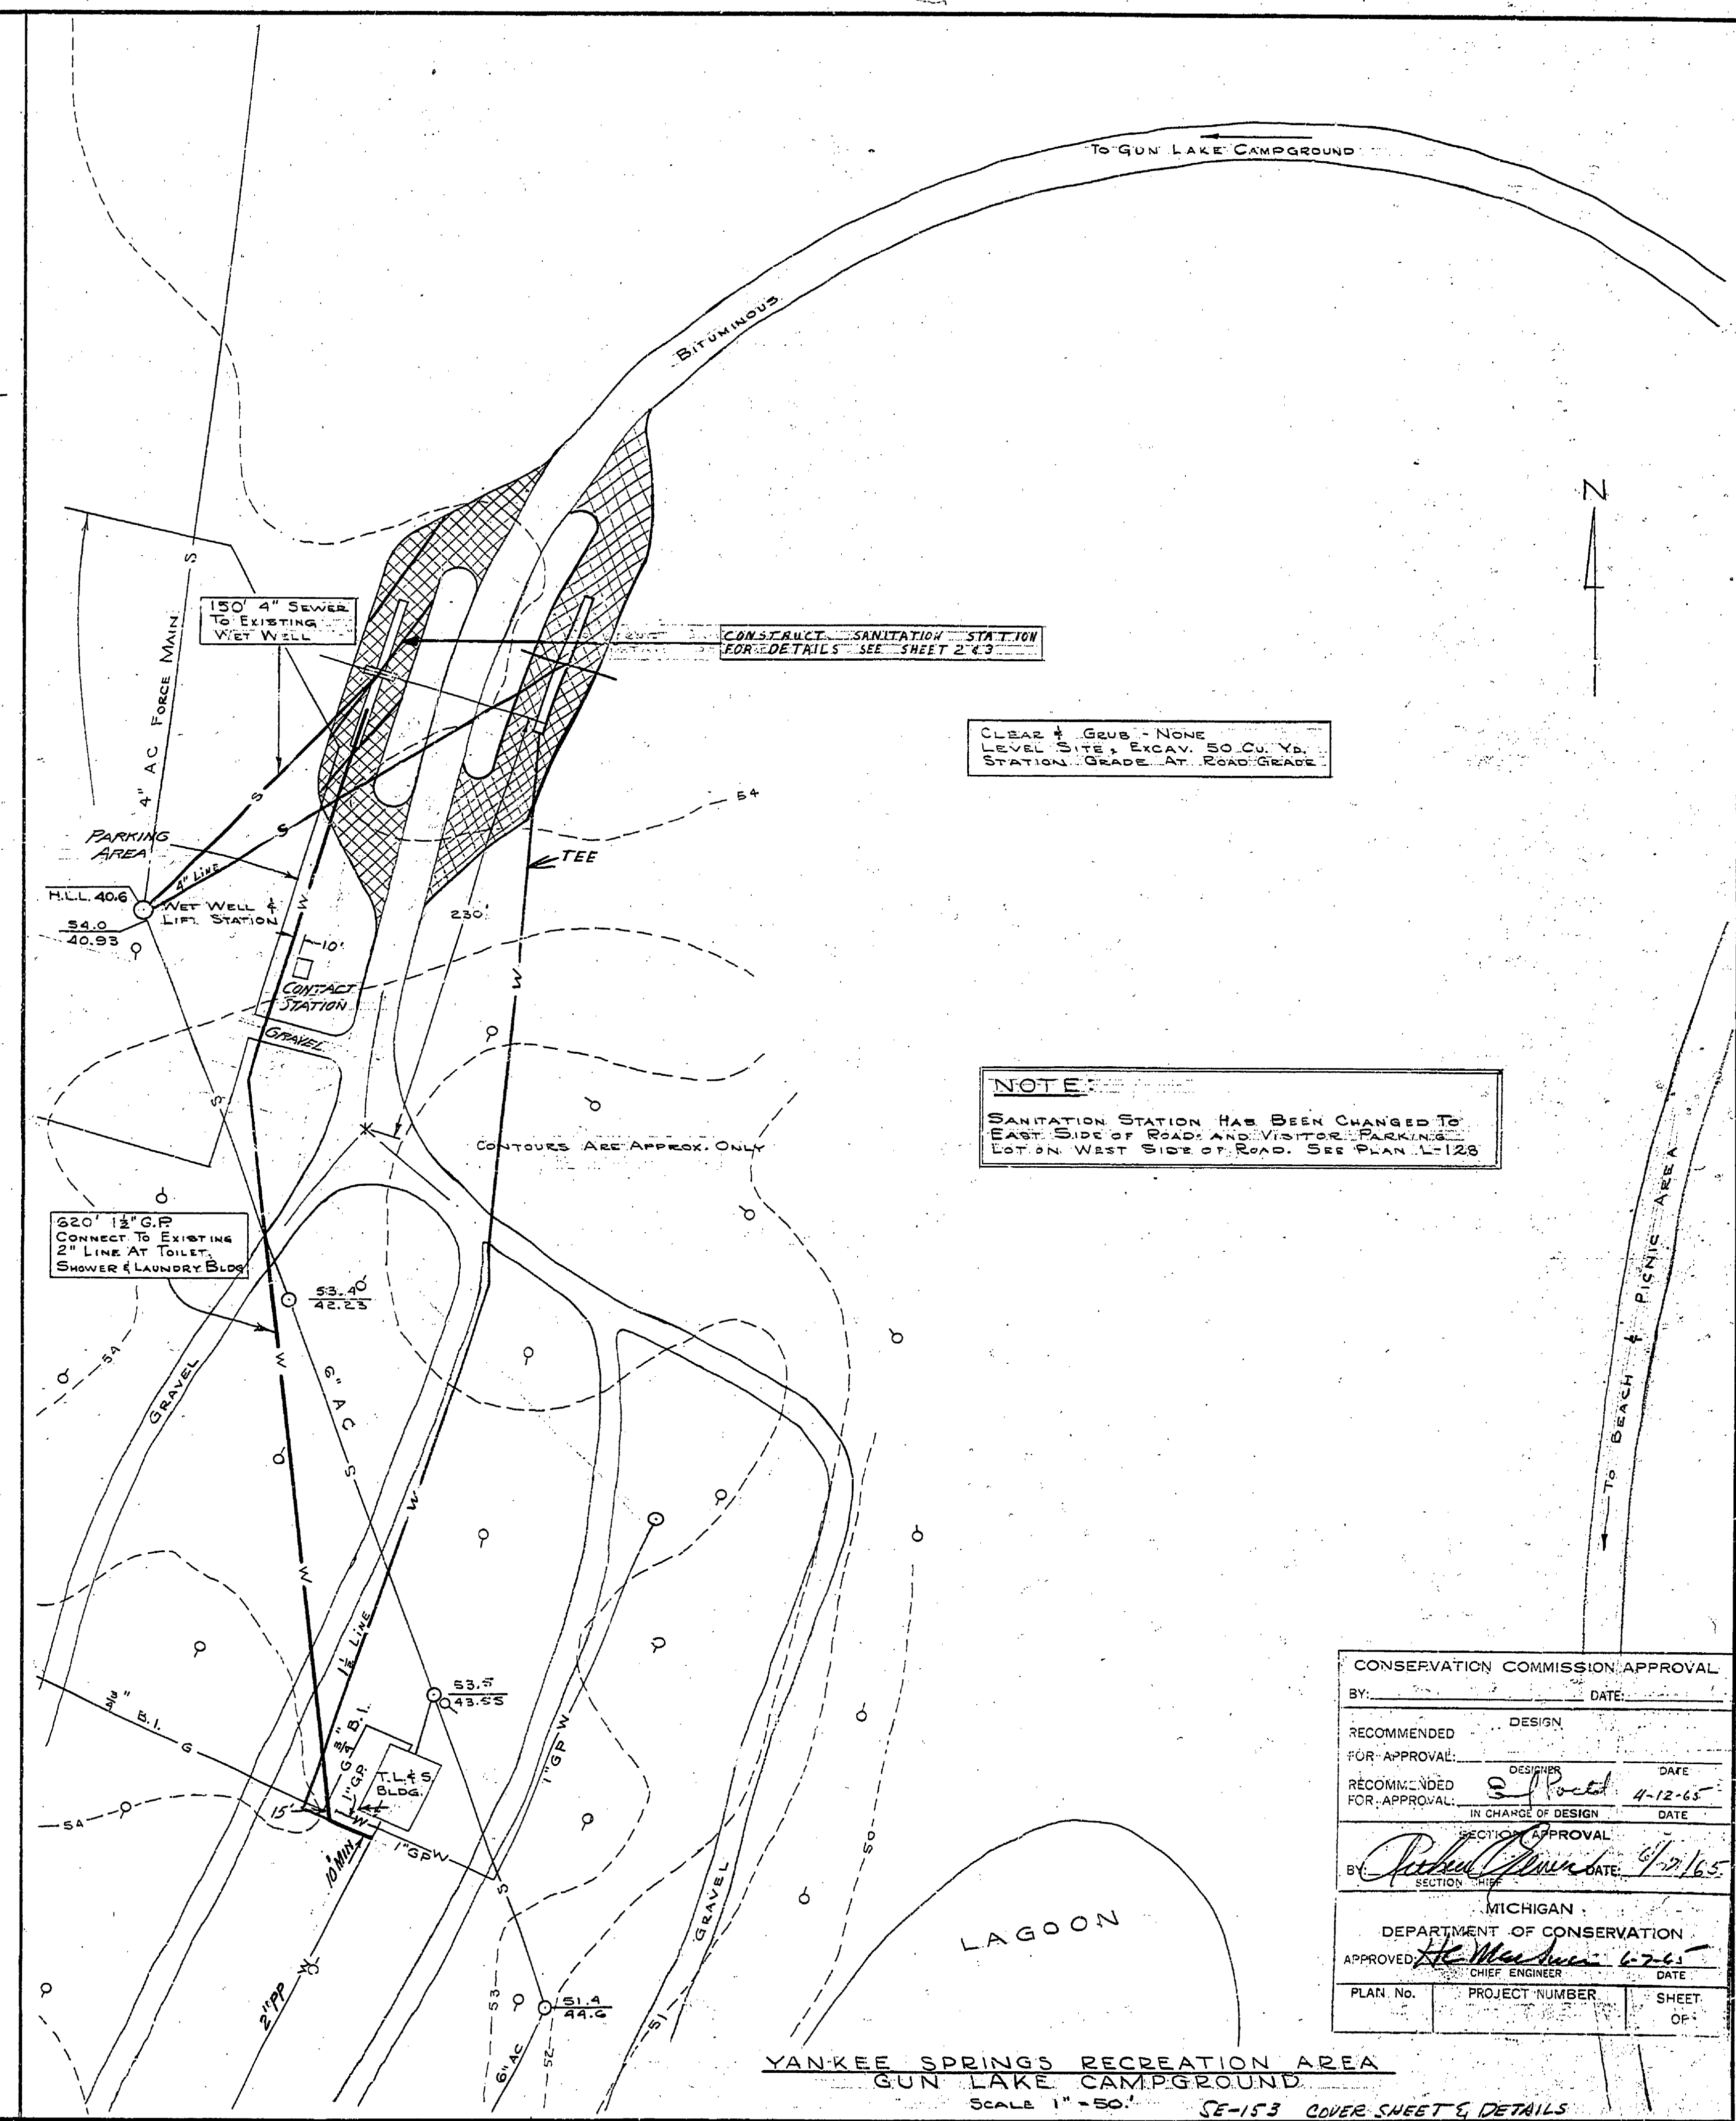


DESIGNED BY	DATE	REVIEWED	DATE	APPROVED	DATE	NO.	DATE	BY
DRAWN BY CHECKED BY X. Jansina		ARCHITECTURAL			1			
		ENGINEERING			2			
		LANDSCAPE			3			
					4			
					5			
					6			

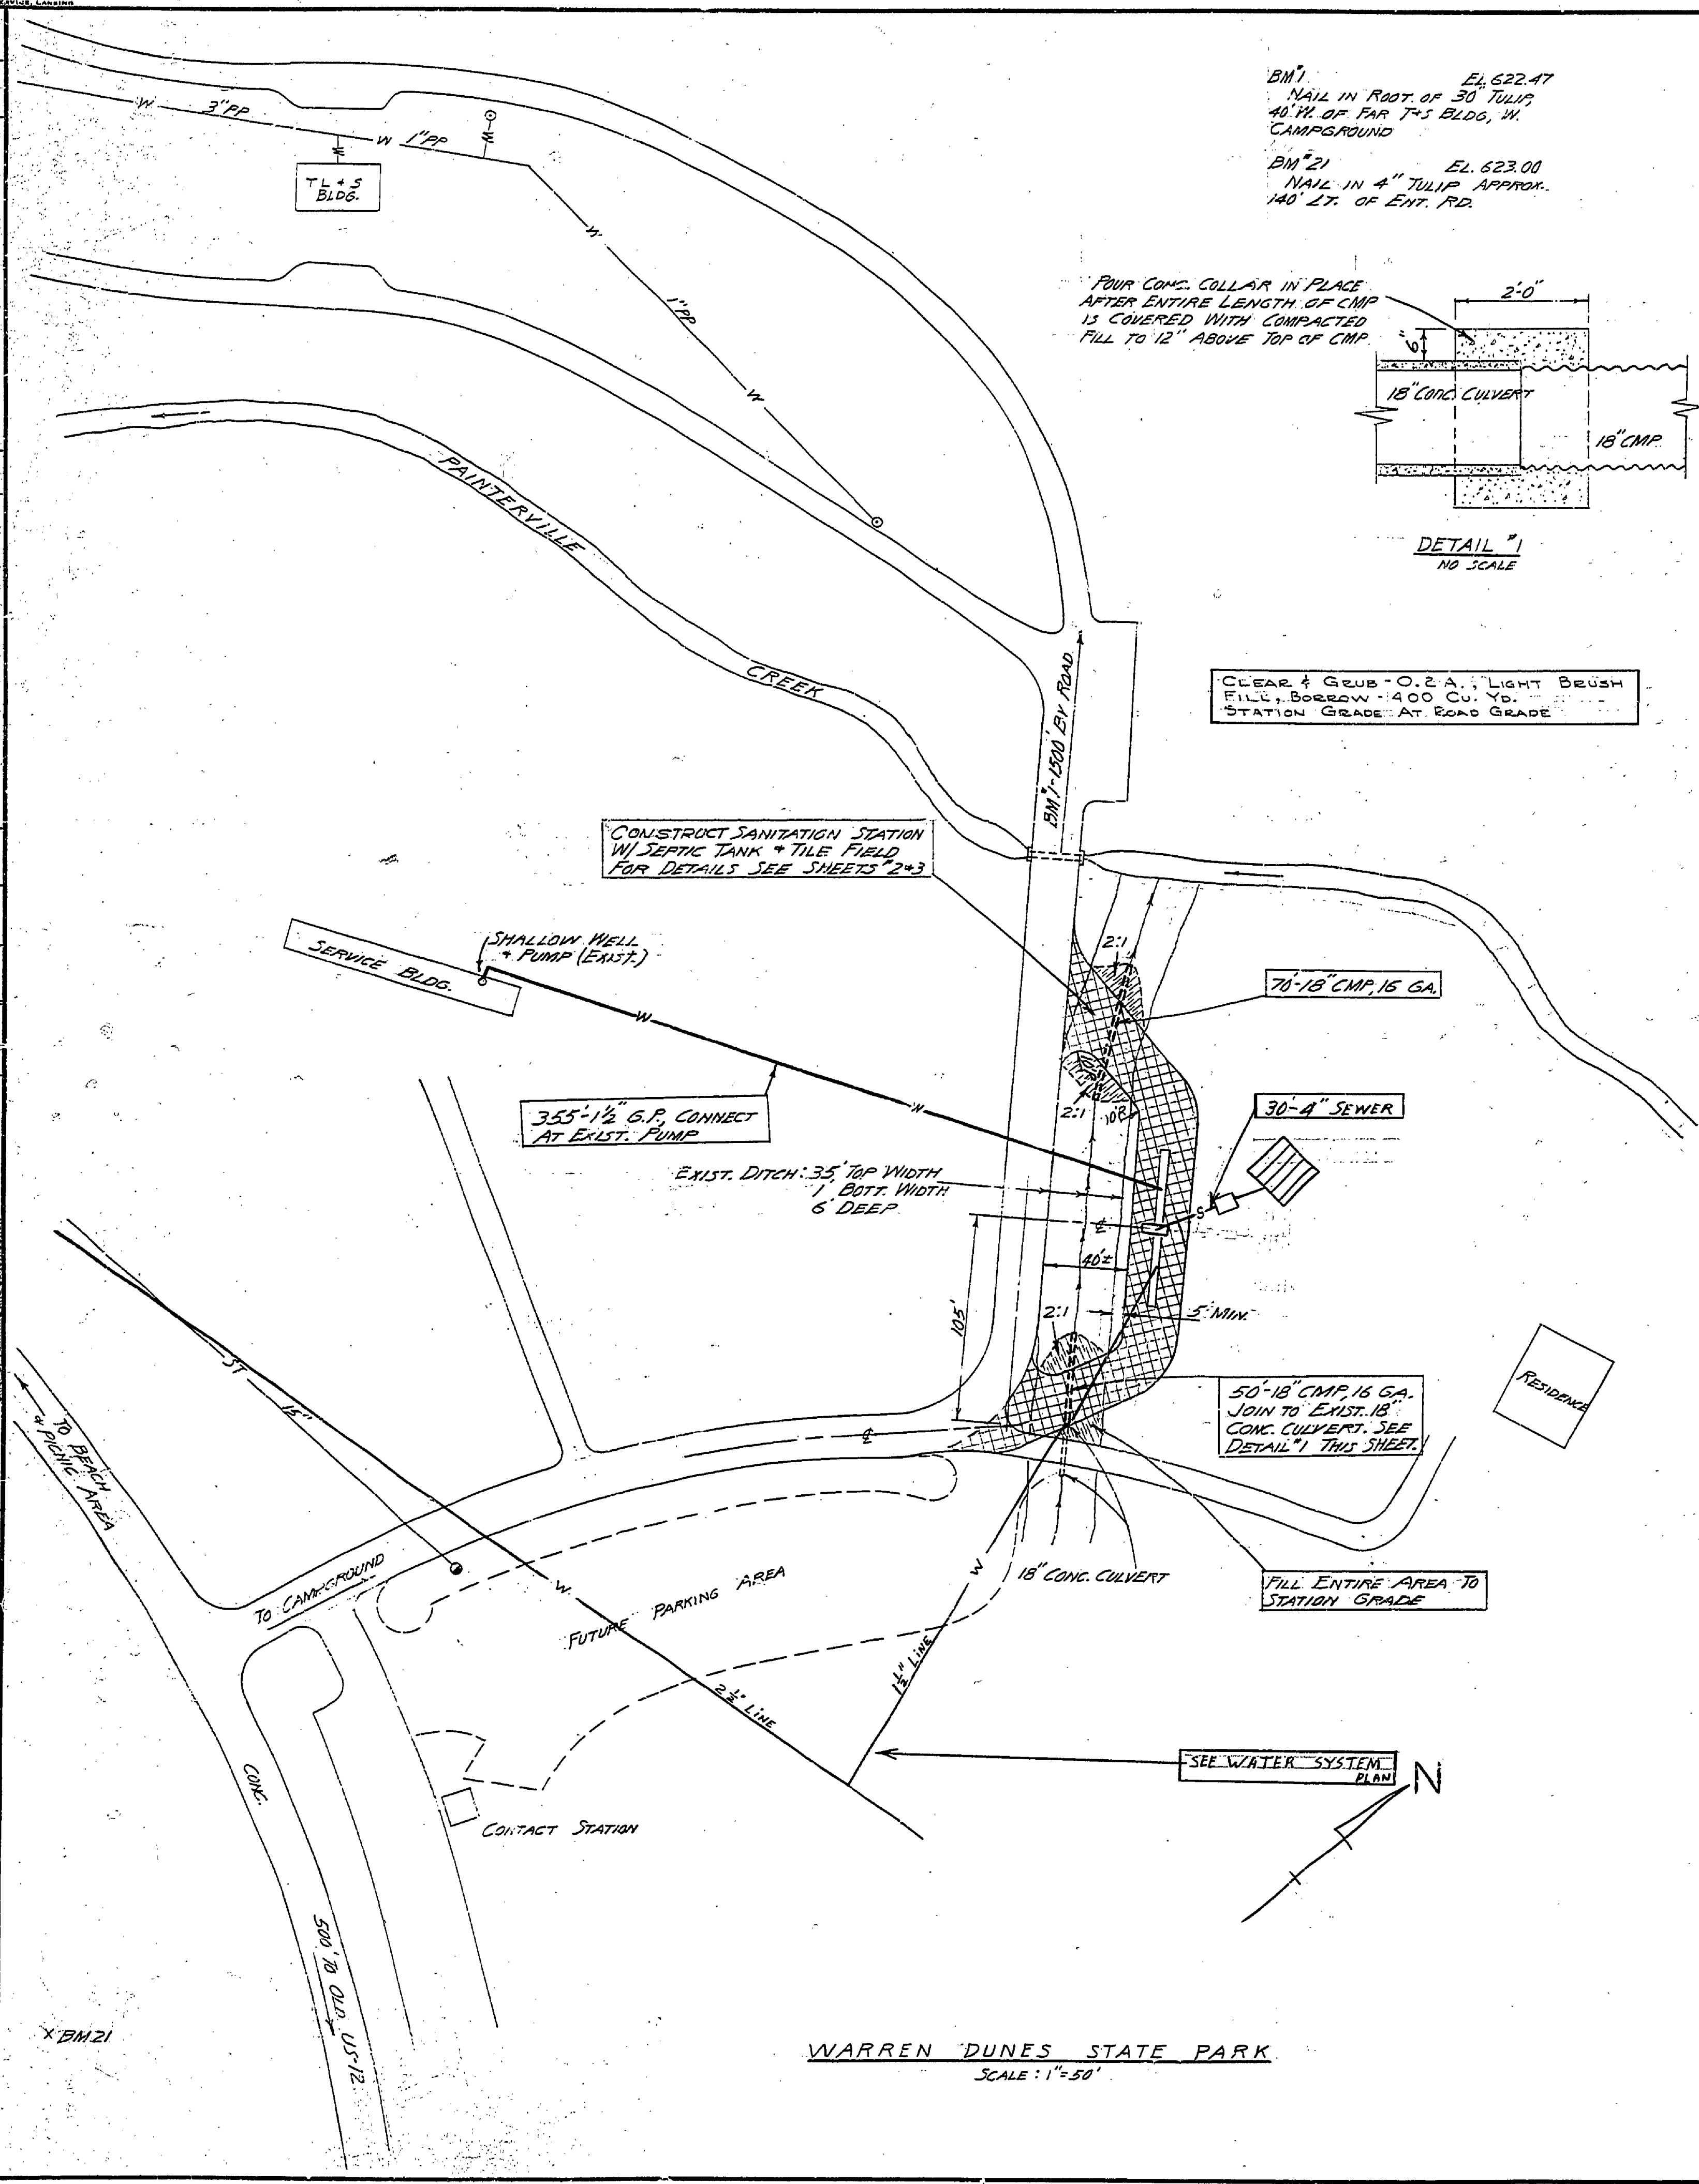

CONSERVATION COMMISSION APPROVAL		
BY:	DESIGN	DATE:
RECOMMENDED	DESIGN	
FOR APPROVAL:	DESIGNER	DATE
RECOMMENDED	DESIGNER	DATE
FOR APPROVAL:	IN CHARGE OF DESIGN	DATE
SECTION APPROVAL		
BY:	DATE	
MICHIGAN DEPARTMENT OF CONSERVATION		
APPROVED:	DATE	
PLAN NO.	PROJECT NUMBER	SHEET
		OF