

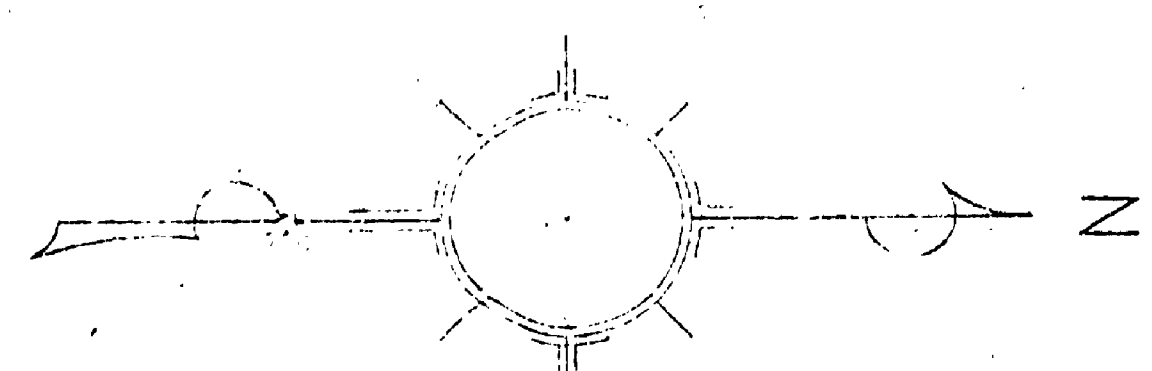


NO.	DATE	BY	REVISIONS
1	5-24	J.E.B.	Final measurements shown
2	6-1	J.E.B.	Final measurements shown
3	6-1	J.E.B.	Final measurements shown
4	6-1	J.E.B.	Final measurements shown
5	6-1	J.E.B.	Final measurements shown
6	6-1	J.E.B.	Final measurements shown

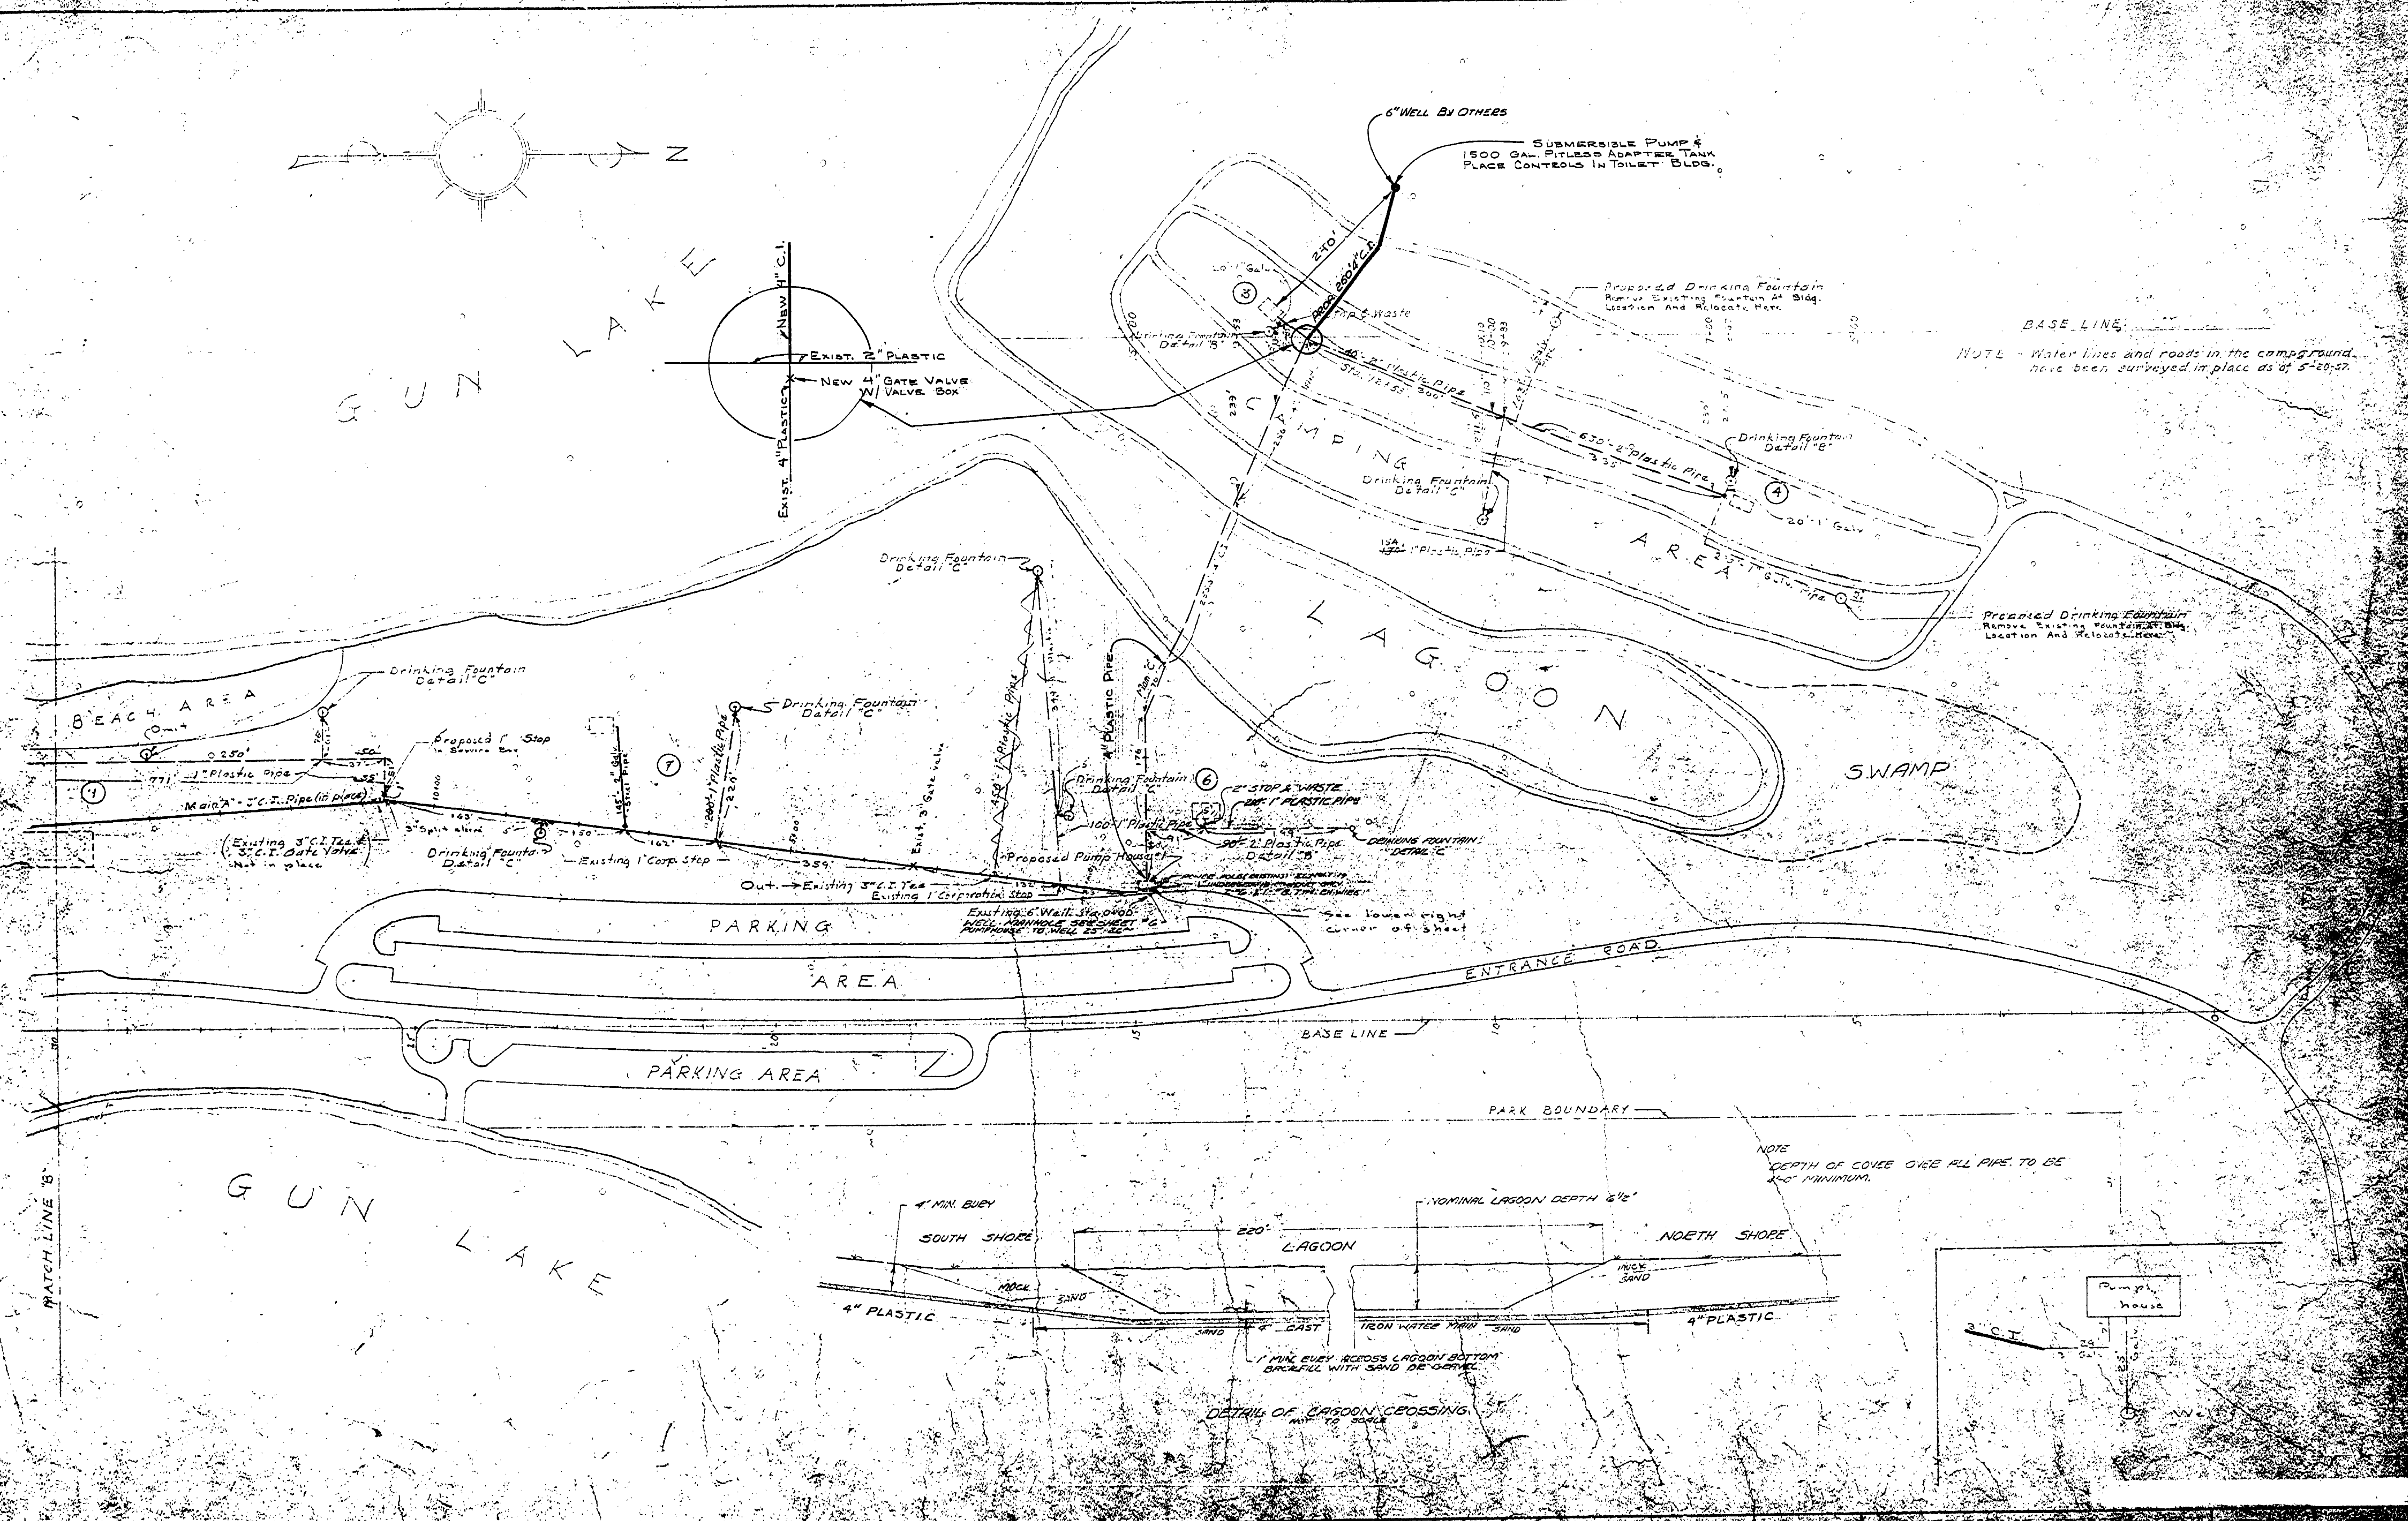

GUN LAKE

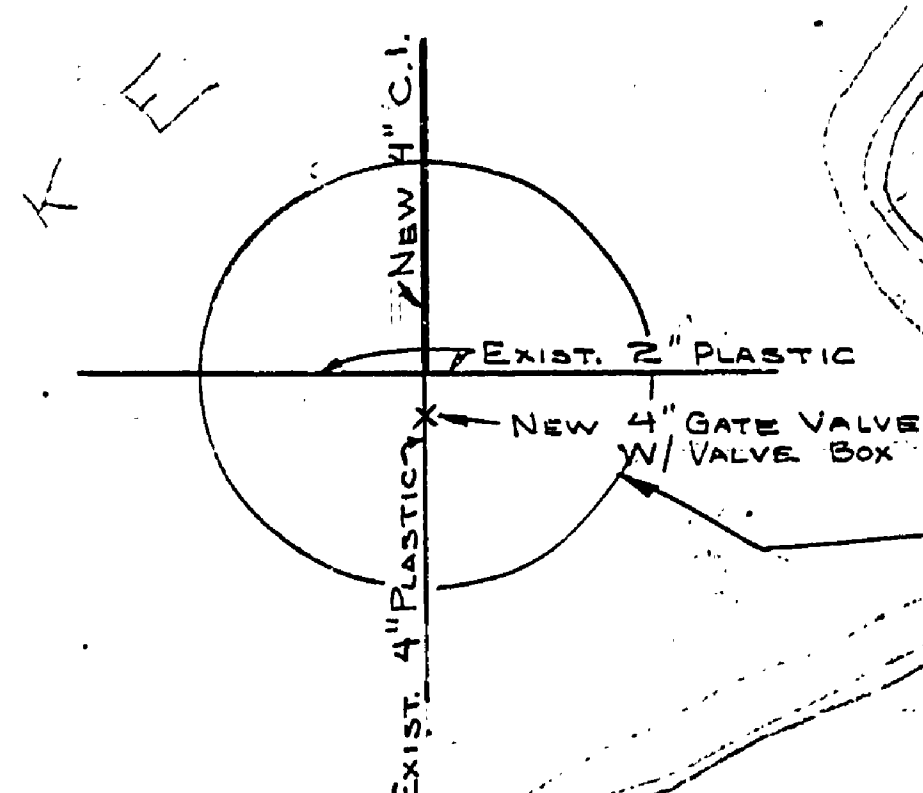

BASE LINE
NOTE - Water lines and roads in the campground have been surveyed in place as of 5-20-57.

NOTE
DEPTH OF CONVE OVER ALL PIPE TO BE 1'-0" MINIMUM.

