



PLAN
1 1/2' x 1'-0"

PLAN OF CONCRETE SLAB
1 1/2' x 1'-0"

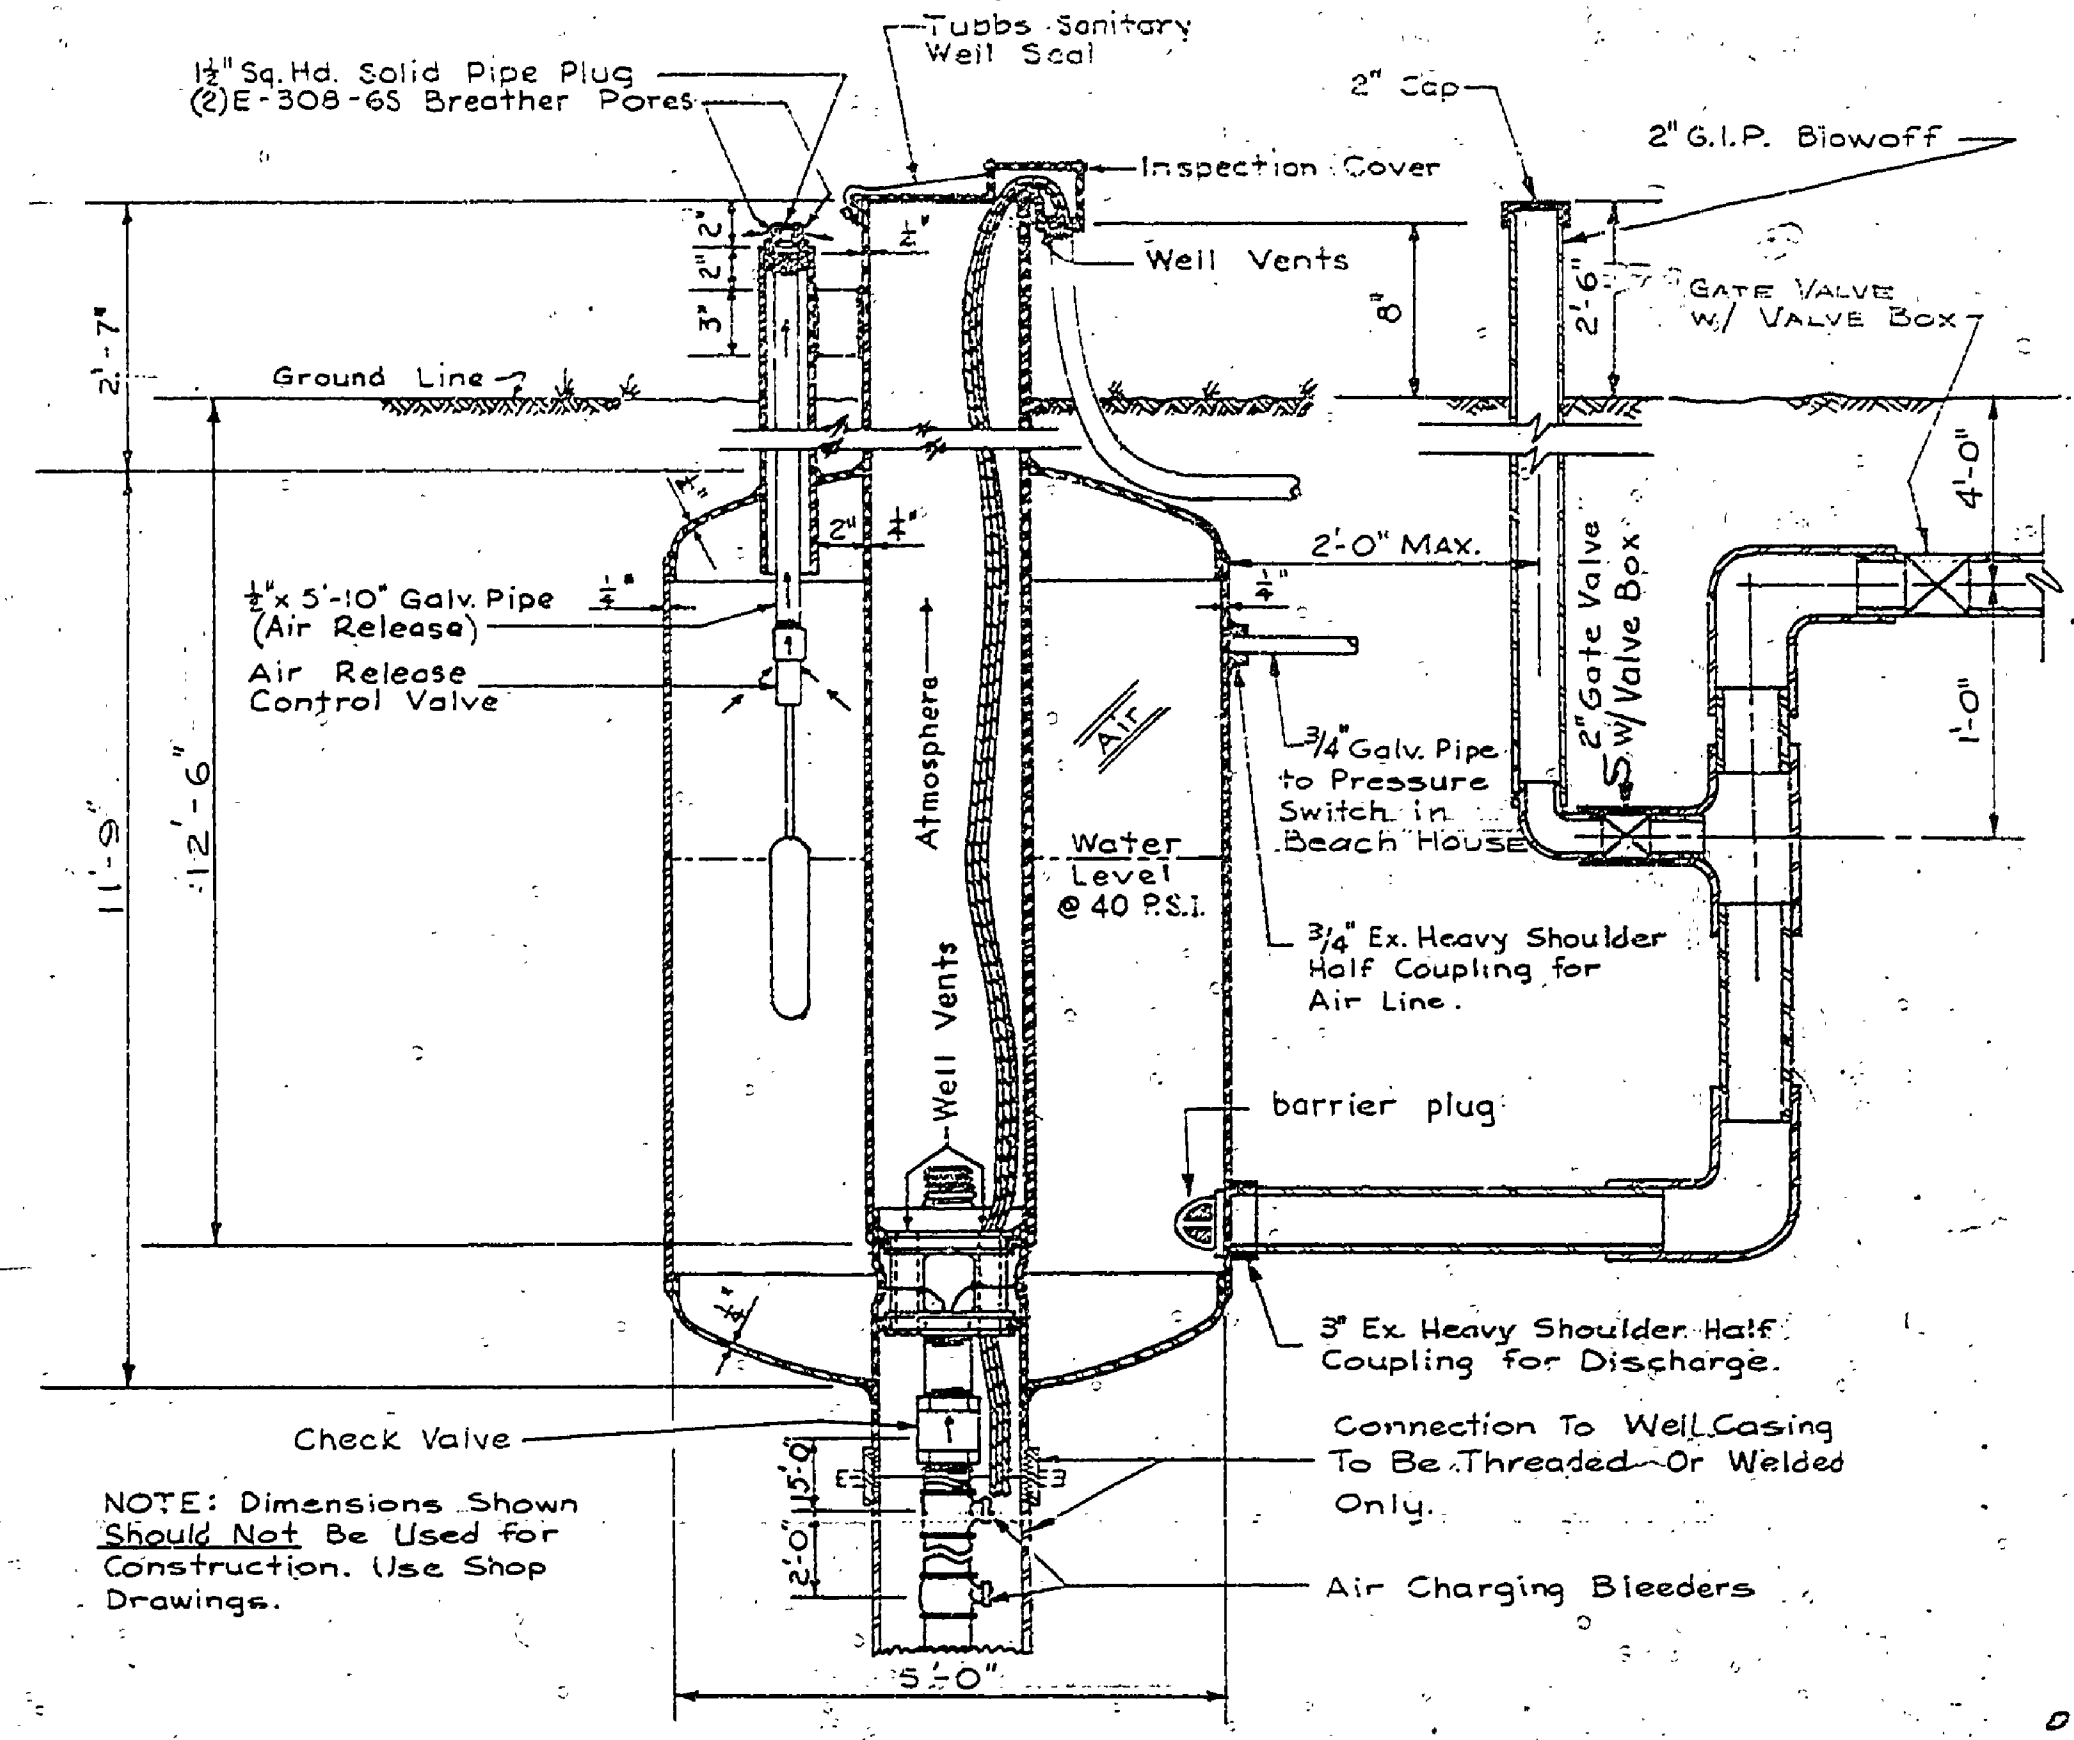


1500 GALLON
PITLESS ADAPTER TANK
No Scale

NOTE: Dimensions Shown Should Not Be Used for Construction. Use Shop Drawings.

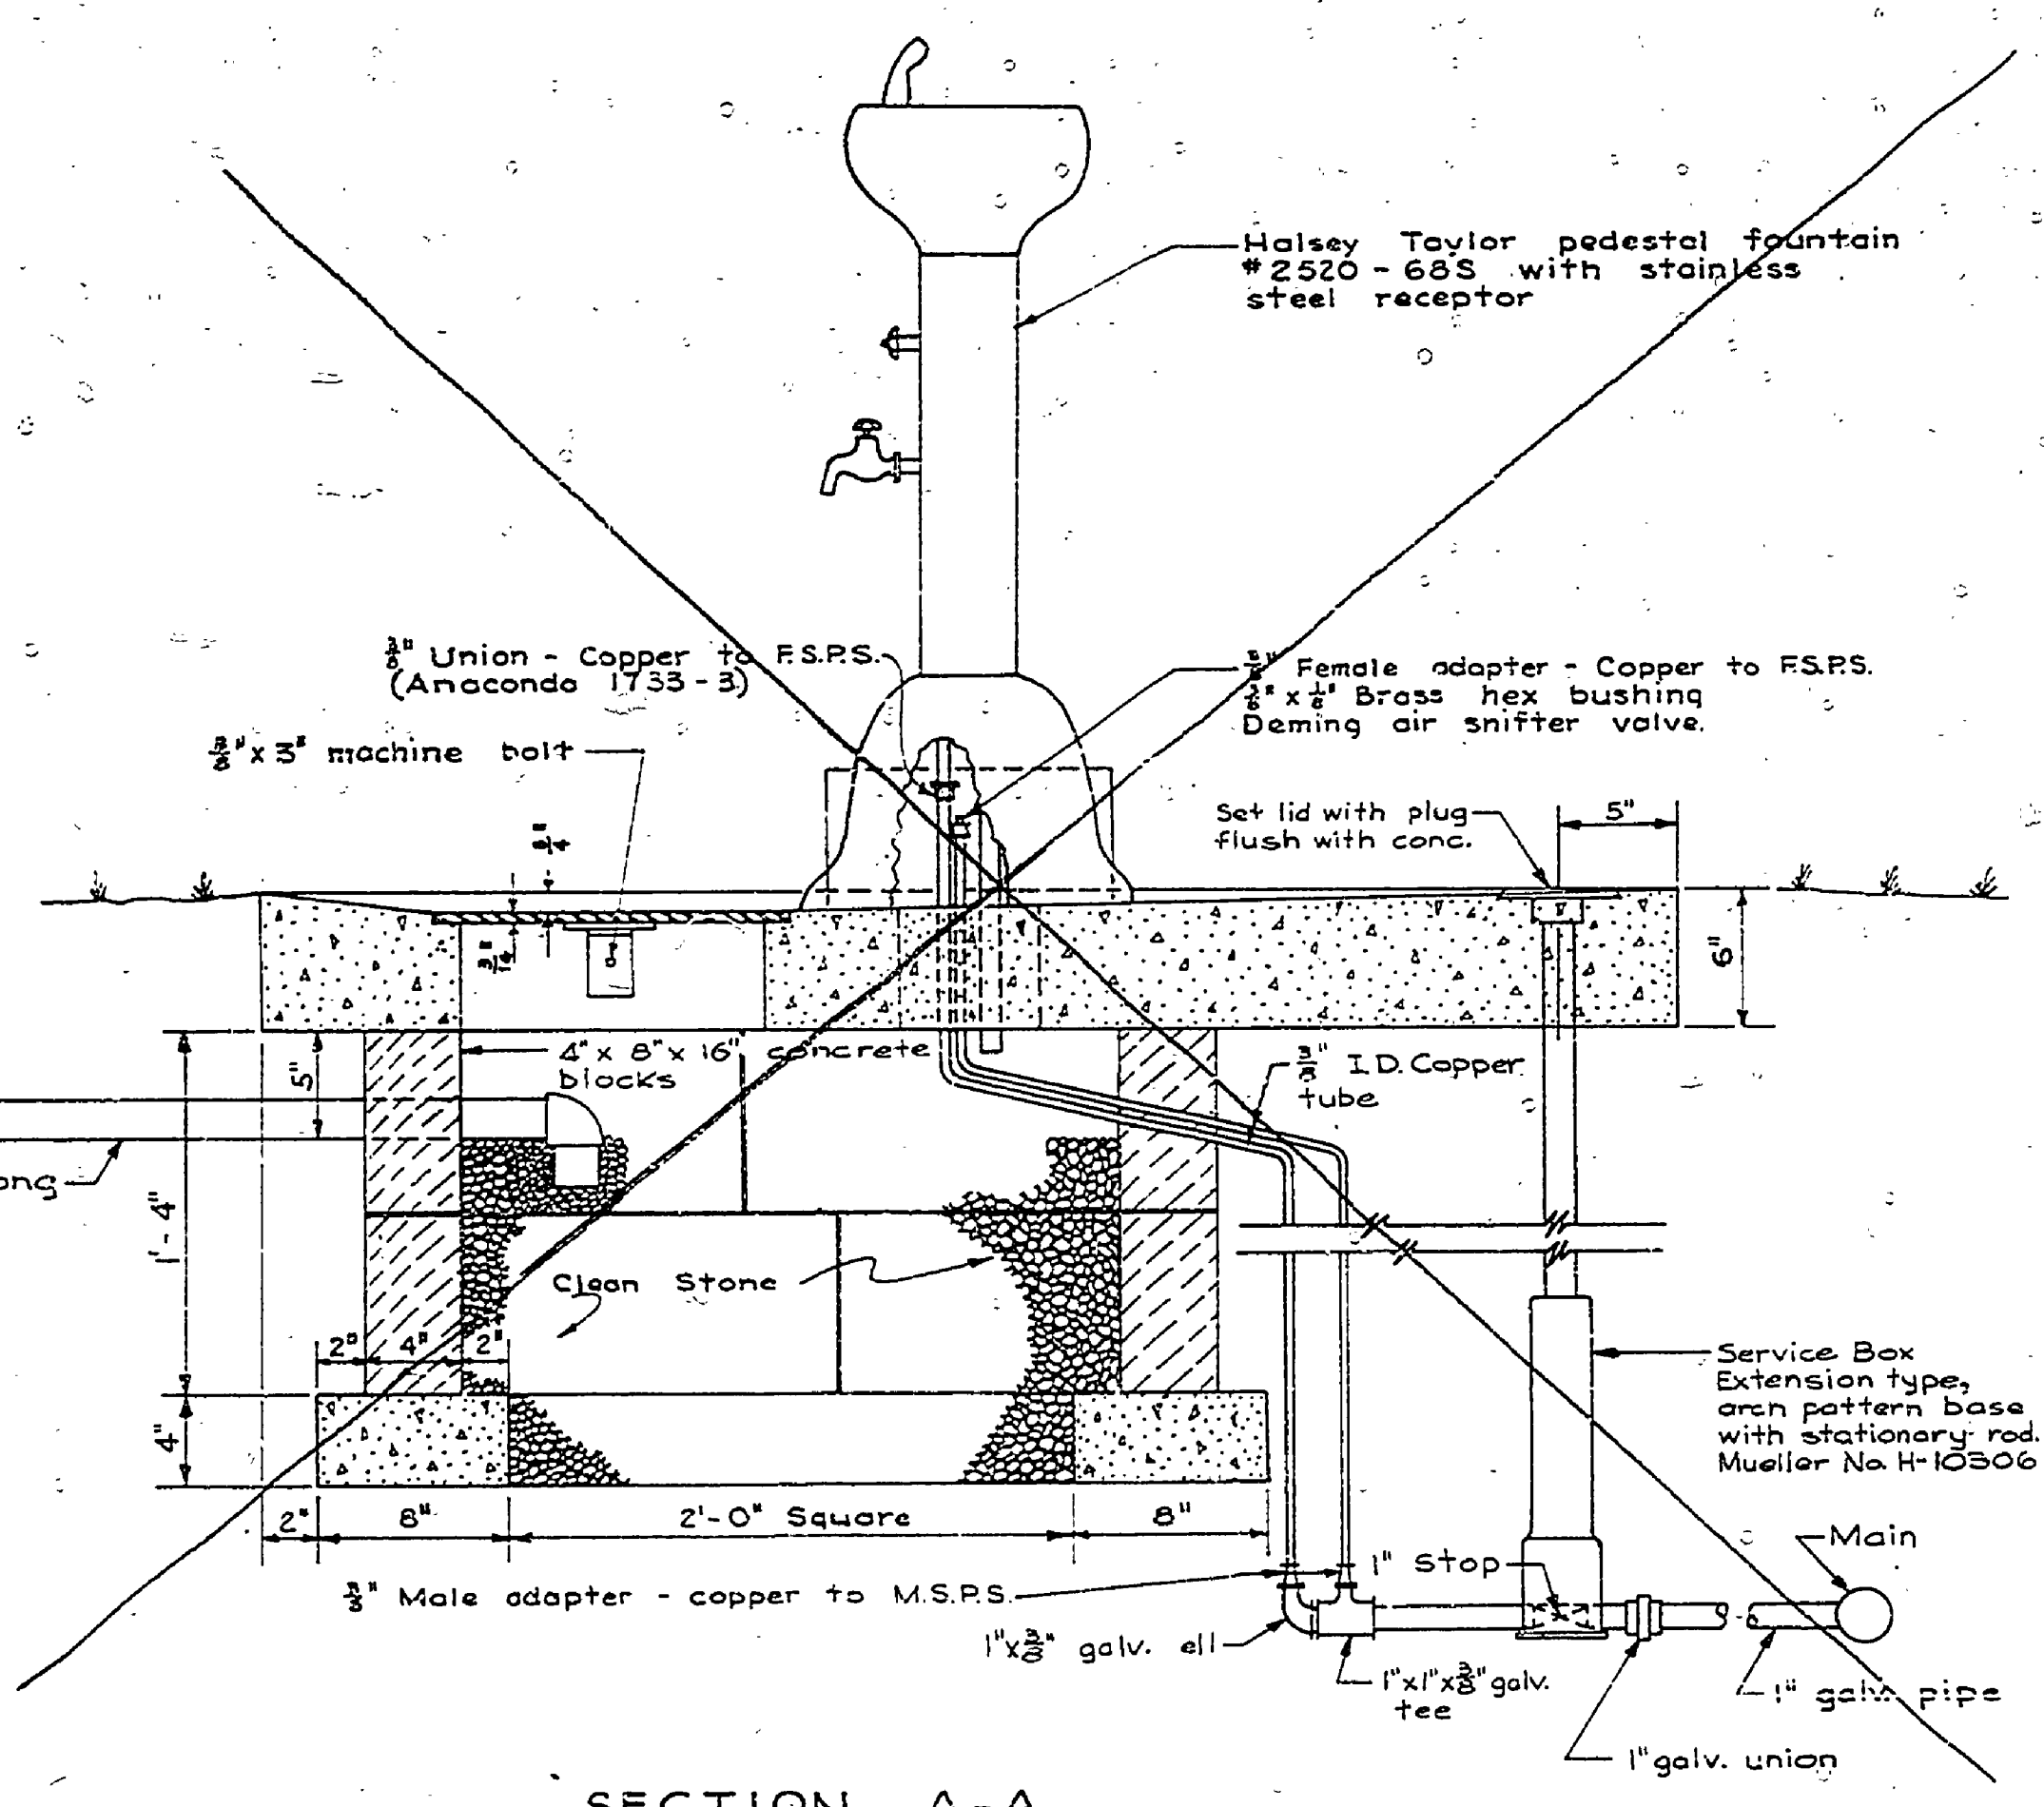


SECTION A-A
1 1/2' x 1'-0"


NOTE: Shut-off valve in service box. Open faucet on fountain and pump air through sniffer valve for winter shut down.

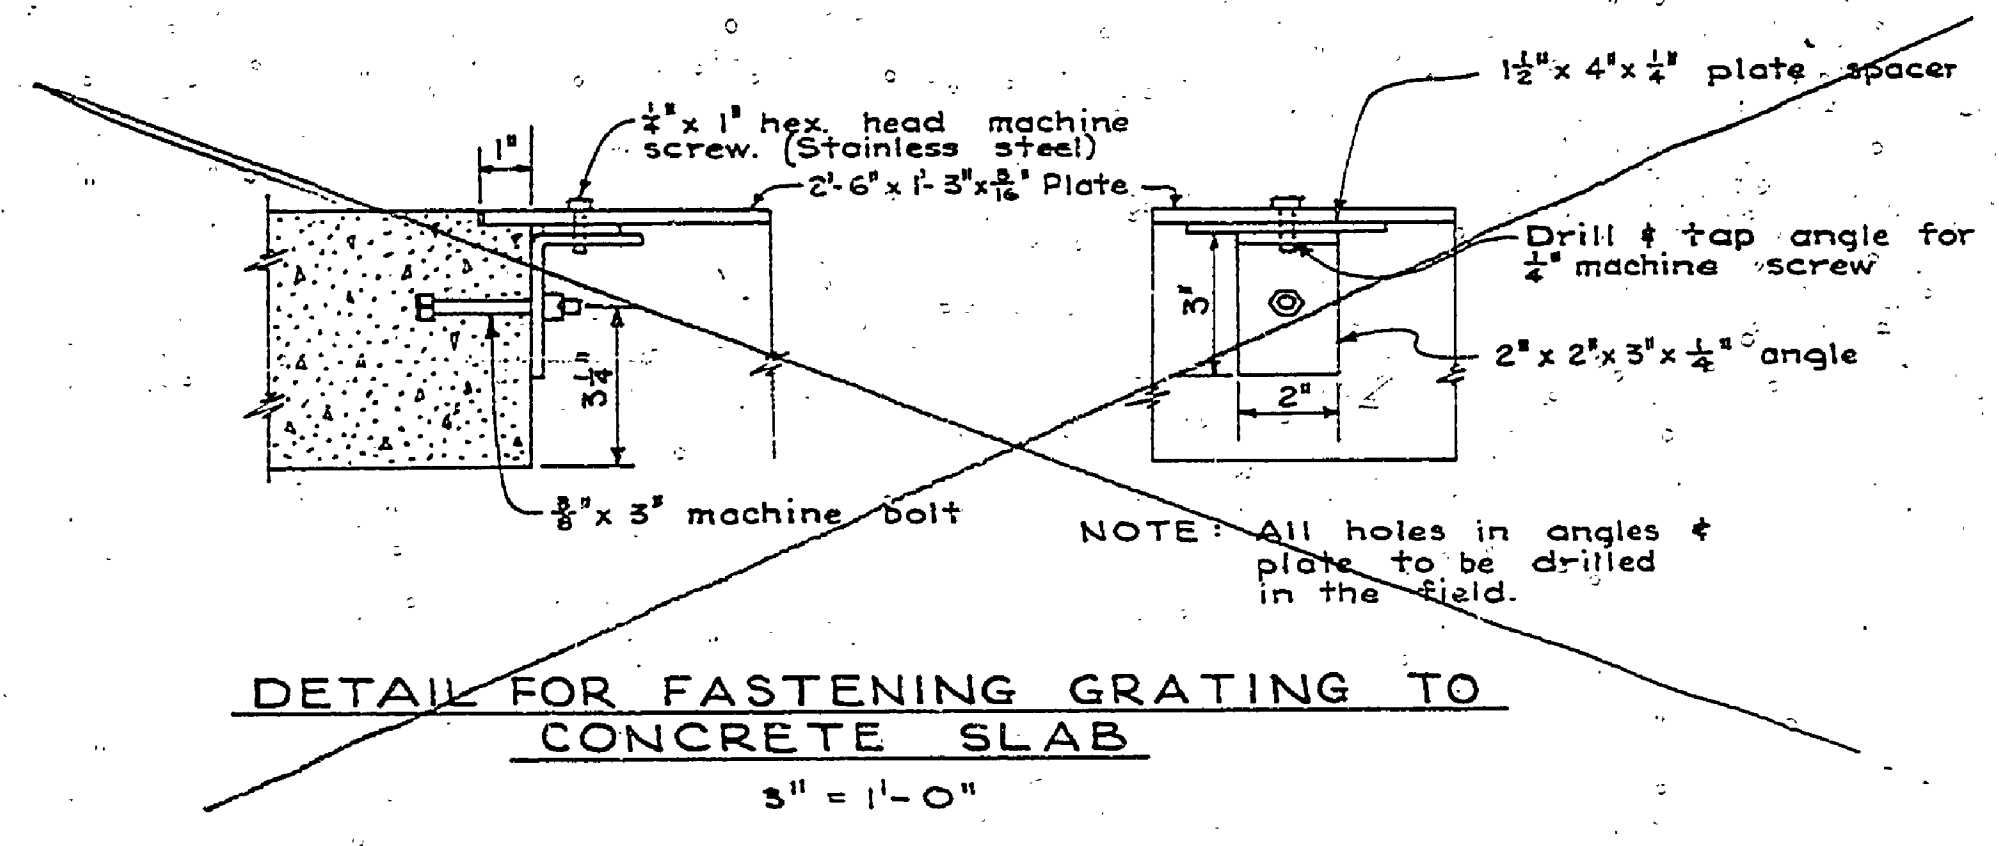

DETAIL FOR FASTENING GRATING TO CONCRETE SLAB
3" x 1'-0"

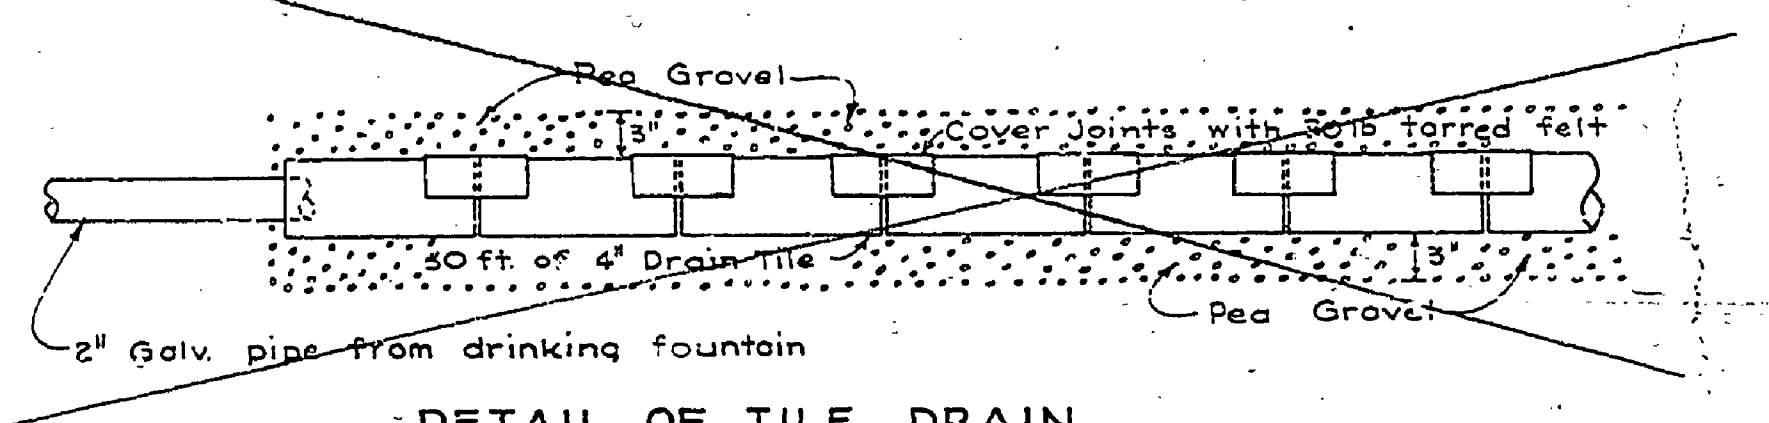

DETAIL OF TILE DRAIN

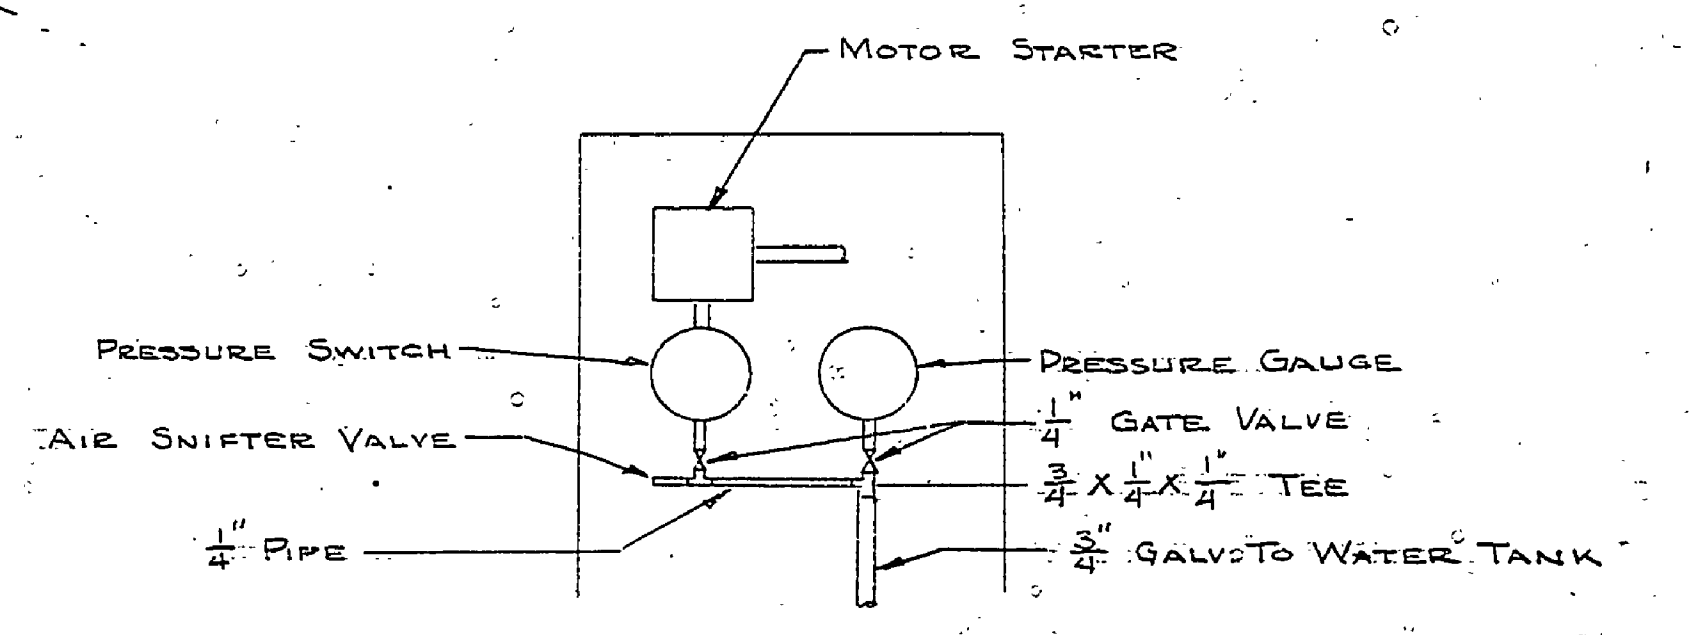

PUMP CONTROL DETAIL
IN BEACH HOUSE

SURVEYED BY	DRAWN BY	NO.	DATE	BY	REVISIONS	NO.	DATE	BY	REVISIONS
BARKER	COTE	1	6-69	H.L.R.	Extension Type Service Box in Slab	3			
	W.H.E.	2	8-64	J.H.N.	Tank Construction to Casing	4			

MICHIGAN DEPARTMENT OF CONSERVATION	DRINKING FOUNTAIN PLAN	SHEET NO. OF	YANKEE SPRINGS REC. AREA
		FOR PROJECT NO. 24-1211	SHEET 3 OF 6 PLAN NO. E-147

SE-119