



ENTRANCE RACK
WITH METER SOCKET & CIRCUIT BREAKER PANEL BOARD


NOTE: GROUND ELECTRICAL SYSTEM AT DISTRIBUTION PANELBOARD TO NEAREST BURIED WATER PIPE.

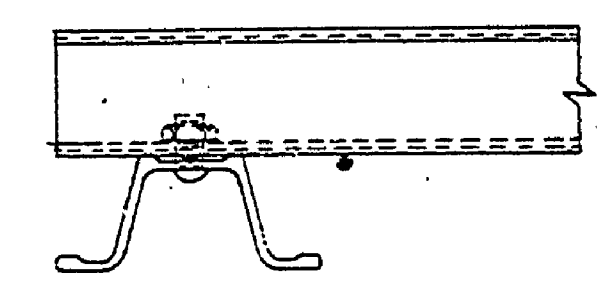


SECTION A-A
NO SCALE

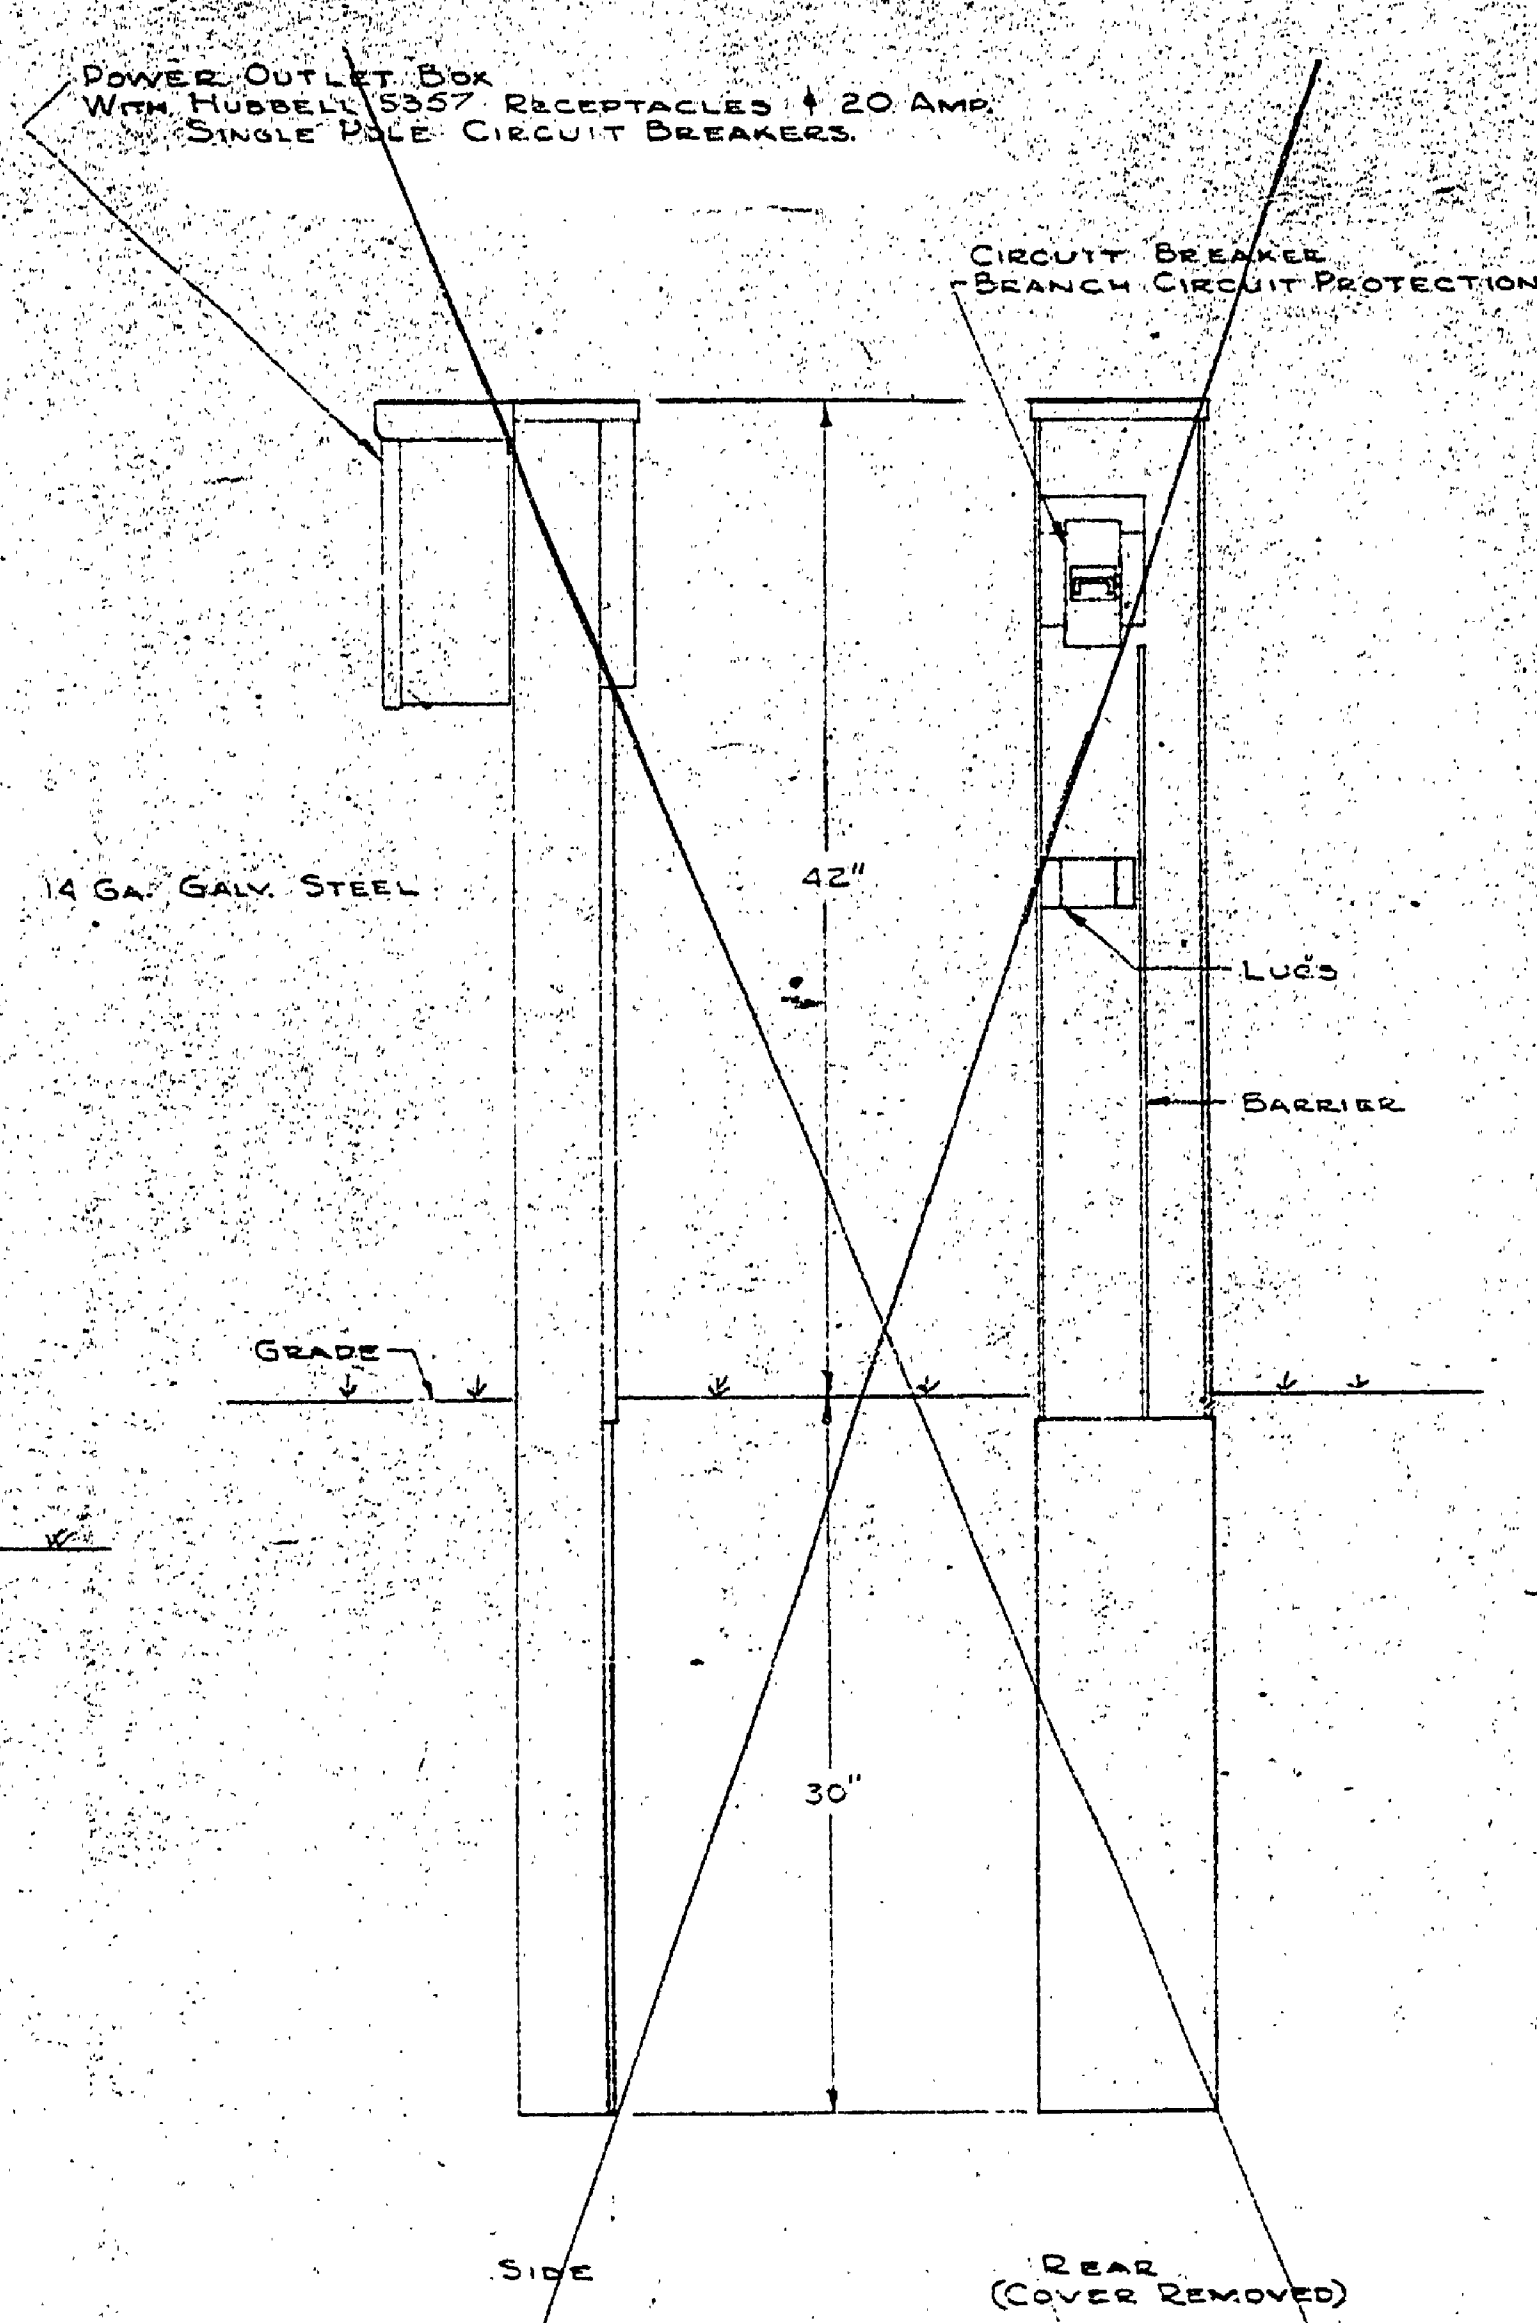

JUNCTION POST
WITH OUTLET BOX & BRANCH CIRCUIT PROTECTION

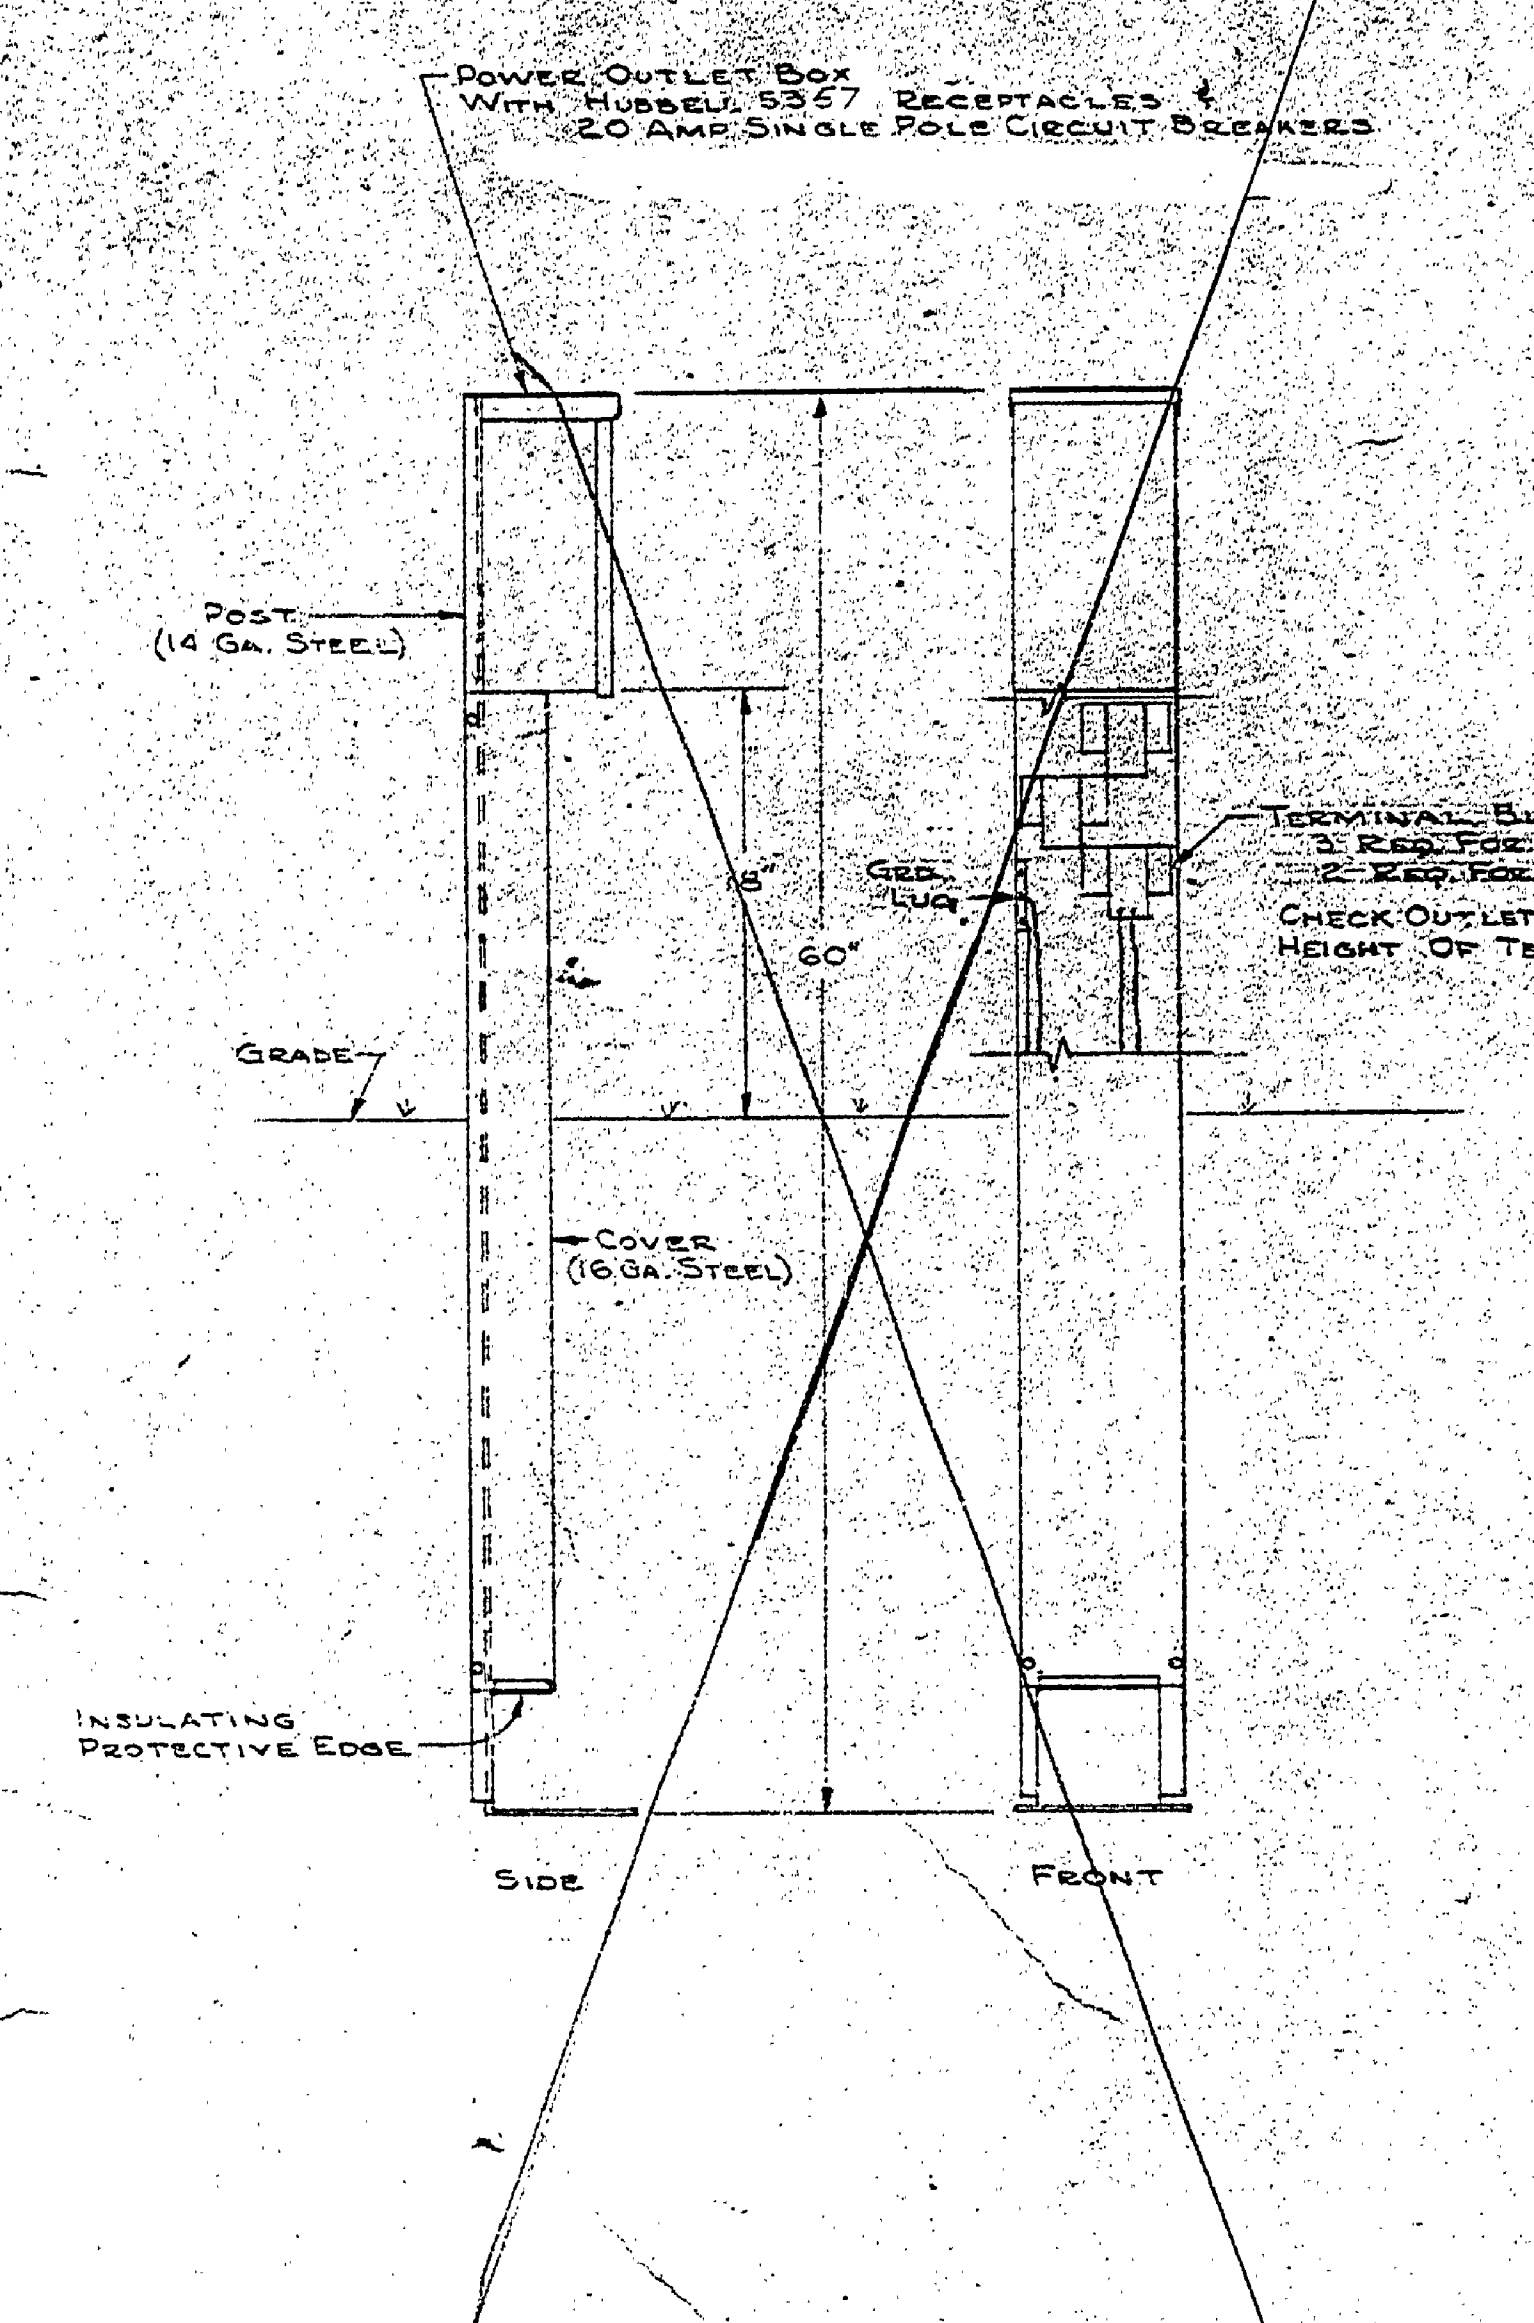

MOUNTING POST
WITH OUTLET BOX

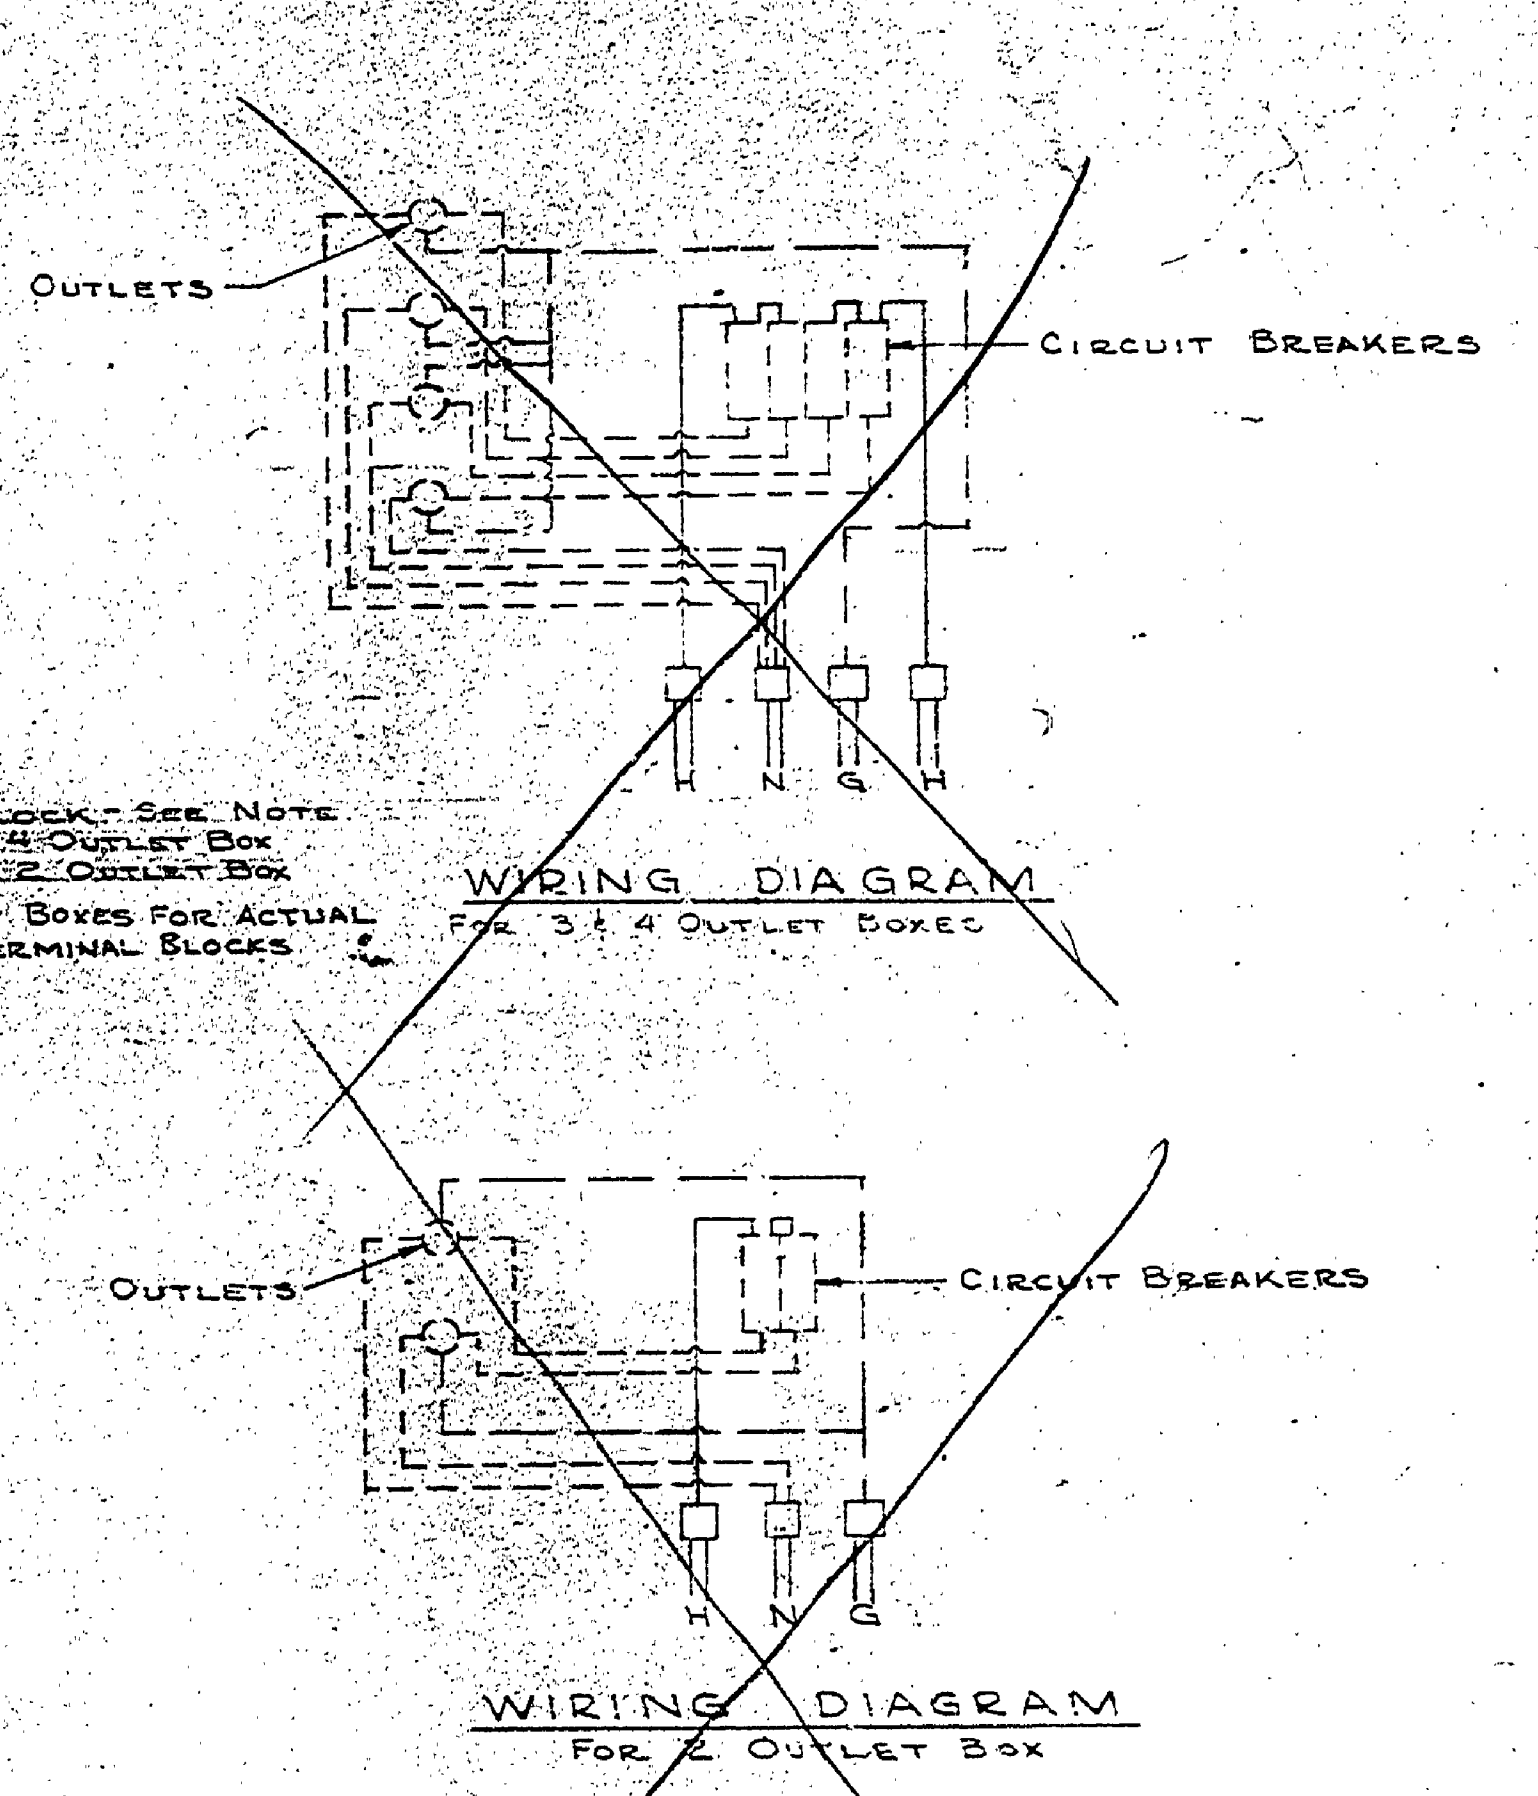

NOTE: THESE POSTS ARE DESIGNED TO PERMIT LOOPING OF CABLE FROM ONE UNIT TO THE NEXT, SPlicing TO BE DONE IN POST. LUGS ARE PROVIDED TO RECEIVE UP TO #10 WIRE. GROUND #8 BARE TO EQUIPMENT GROUND PROVIDED ON POST.

SURVEYED BY	DRAWN BY J. YEMA & R. HARRY	Aug. '66	NO.	DATE	BY	REVISIONS	NO.	DATE	BY	REVISIONS	MICHIGAN DEPARTMENT OF CONSERVATION	STANDARD PLAN UNDERGROUND SECONDARY FOR CAMPGROUND	SHEET NO. 2 OF 2	YANKEE SPRINGS RECREATION AREA
DESIGNED BY W. J. POVELT	Aug. '66	CHECKED BY	1.	4-15-68	J.Y.	WIRING DIA. REV., TERMINAL BLOCK ADDED	3.						FOR PROJECT NO. 24-1729	PLAN NO. E-150
	DATE	DATE	2.	11-25-68	J.Y.	CONDUIT BUSHING ADDED	4.							SE-1614