


DESIGNED BY	DATE	REVIEWED	DATE	APPROVED	DATE	NO.	DATE	BY
DRAWN BY Pfeiffer CHECKED BY	4-6-62	ARCHITECTURAL				1		
		ENGINEERING				2		
		LANDSCAPE				3		
						4		
						5		
						6		

BLDG. NO.	DESCRIPTION
1	ONE SELLERS IMMERSION AUTO. HOT WATER HEATER NO. A-52 66,000 B.T.U. - TANK 30 DIA. 72" LONG.
2	6 CASING IN WELL 90 FT. DEEP 5000 GAL. TANK -
3	RHEEM 45 GAL. GAS HOT WATER HEATER, 150 GAL. TANK.
4	RHEEM 45 GAL. GAS HOT WATER HEATER, 150 GAL. TANK.

BUILDING CODE	
①	CAMPGROUND TOILET
②	TOILET, LNDRY. & SHWR.
④	FISH HOUSE
⑤	PICNIC TOILET
⑥	STAFF QUARTERS
⑦	DORMITORY
⑧	TOILET
⑨	DINING HALL

LEGEND	
—W—	WATER LINE
—S—	SEWER LINE
⊙	MANHOLE
⊕	DRINKING FOUNTAIN
G.P.	GALVANIZED PIPE
C.P.	COPPER PIPE
V.S.P.	VITRIFIED SEWER PIPE
V.D.T.	DRAIN TILE

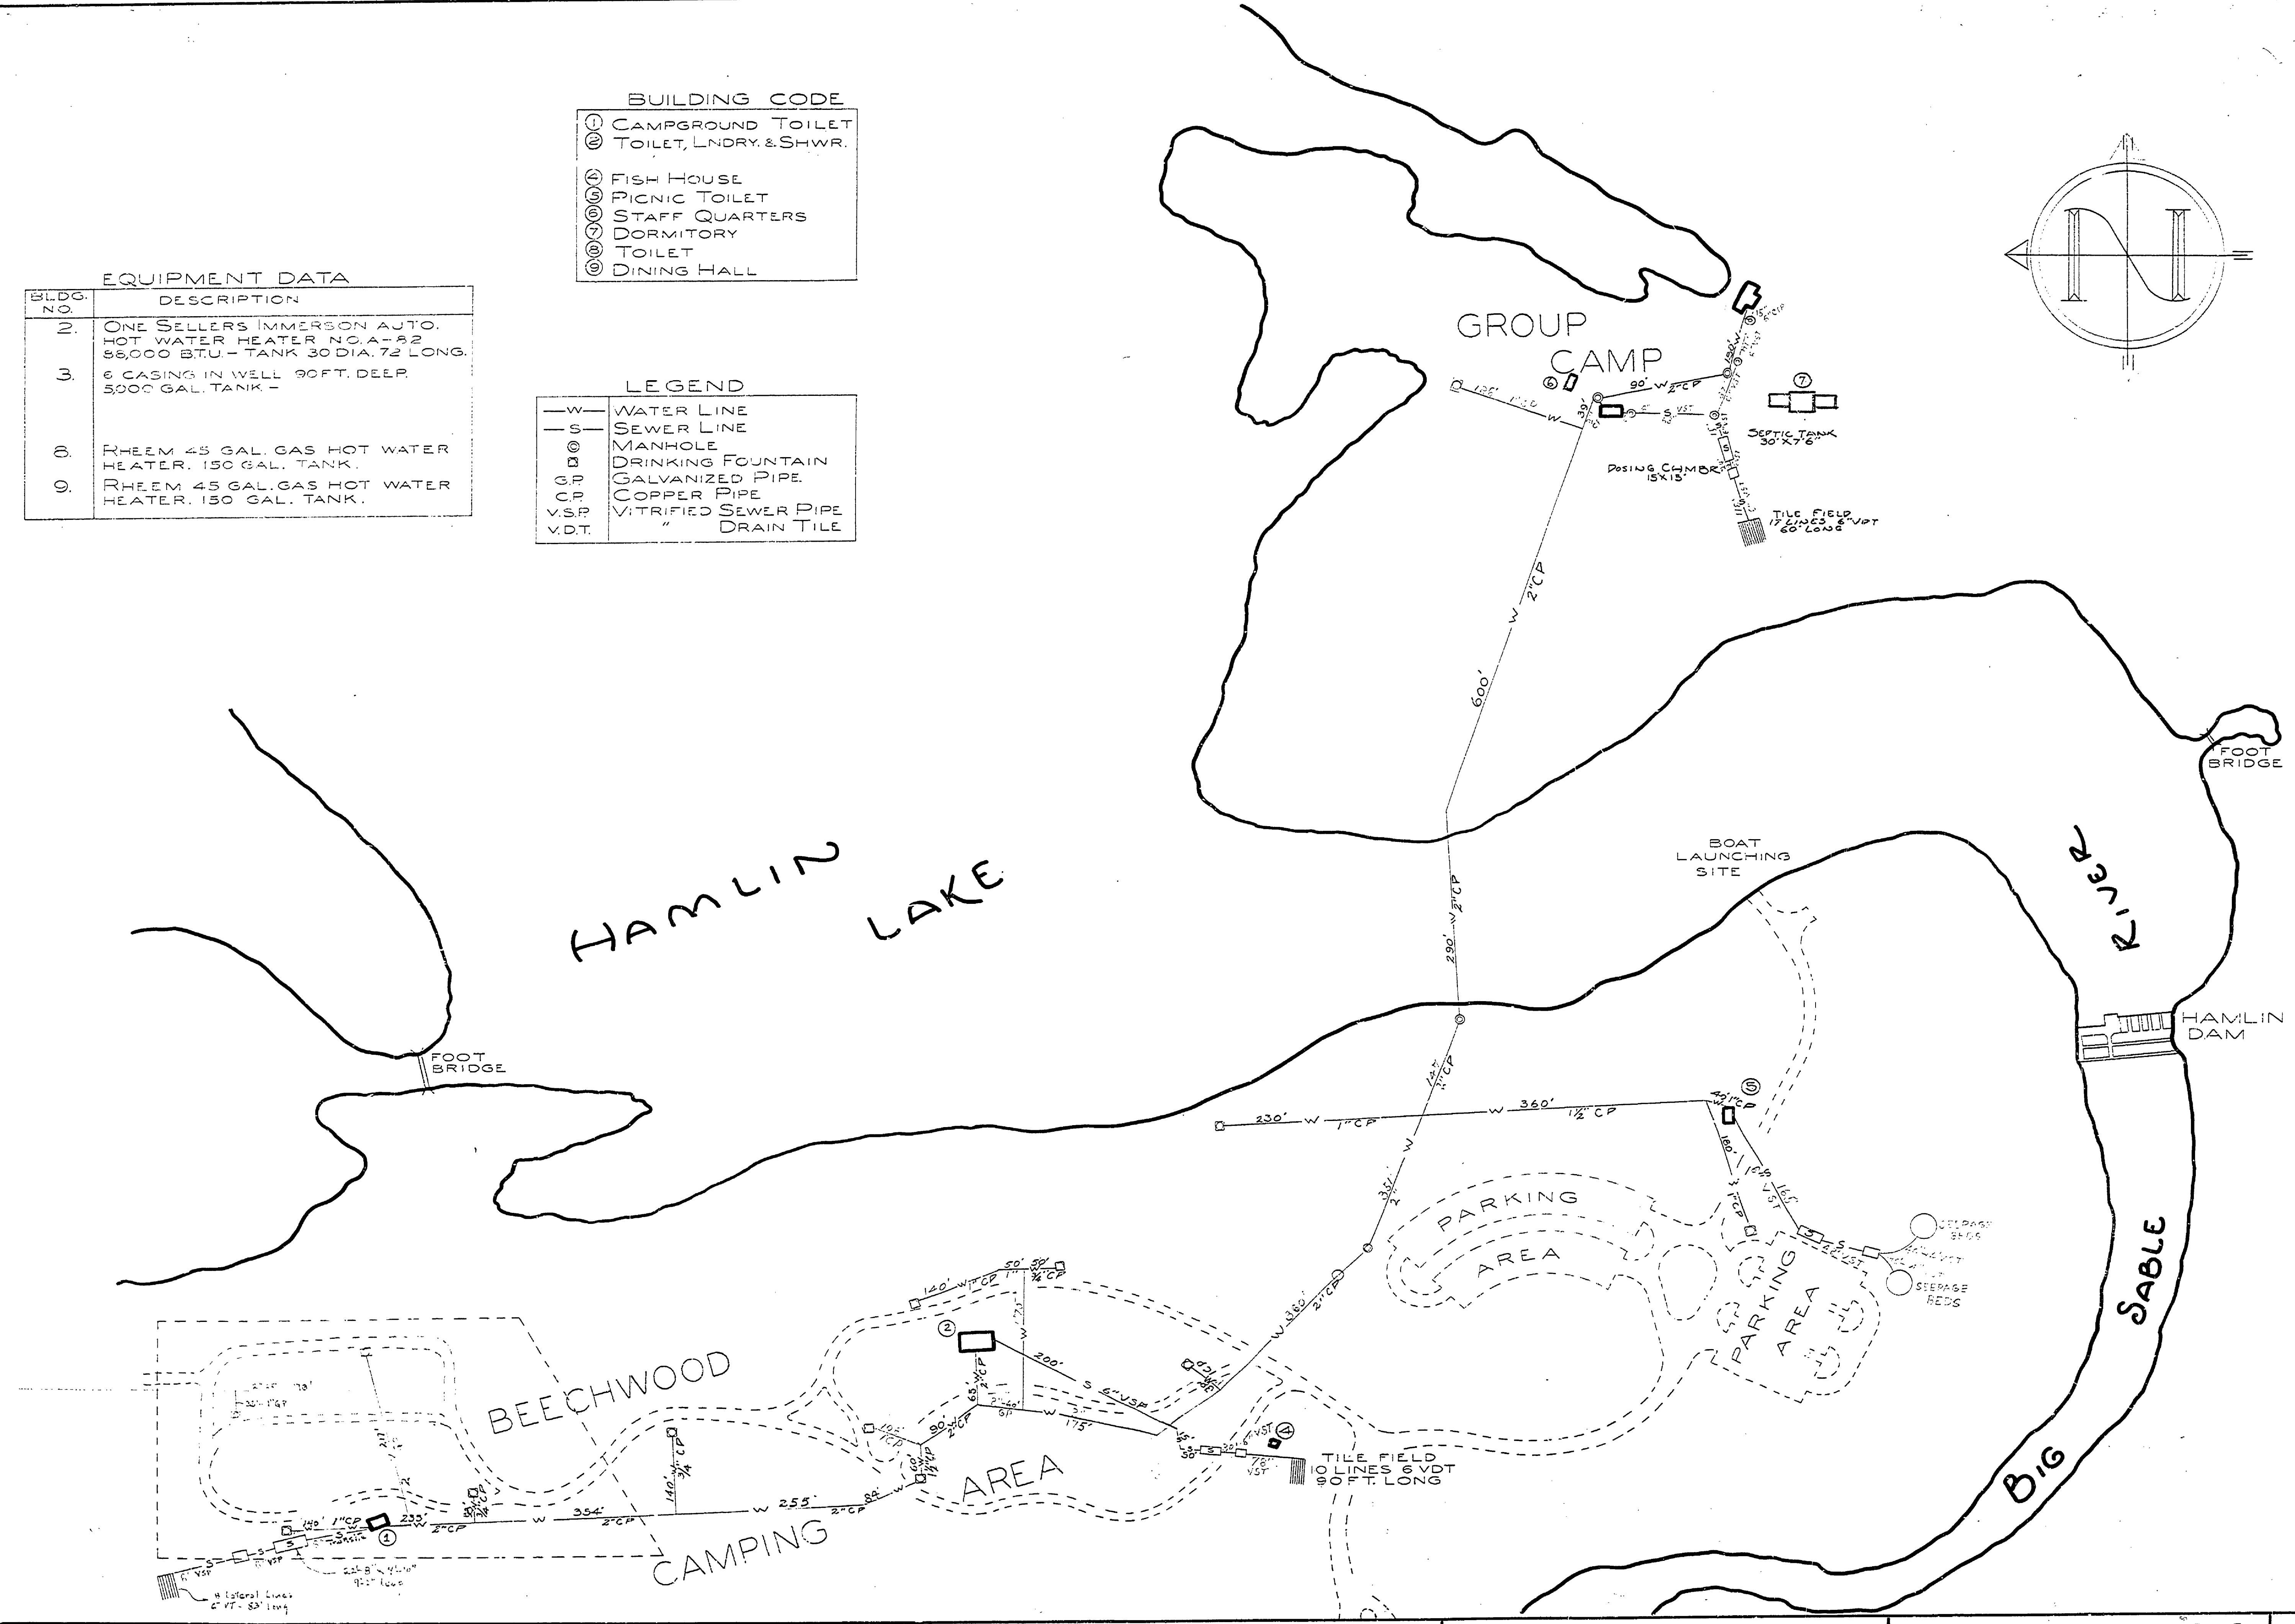

LUDINGTON STATE PARK

MICHIGAN DEPARTMENT OF CONSERVATION PARKS AND RECREATION DIVISION

BEECHWOOD & GROUP CAMP AREAS WATER & SEWAGE DIST. NO SCALE

SHEET NO. 2 OF 4

PLAN NO. U-1