


DRAWN BY M.D.S.	REVIEWED BY SECTIONS ARCHITECTURAL ENGINEERING LANDSCAPE	DATE 9-11-46	APPROVED BY <i>[Signature]</i> ASSISTANT CHIEF IN CHARGE OF DESIGN DATE 2-12-46	NO. DATE BY 1 2 3	REVISIONS 4 5 6	DATE BY
CHECKED BY C.B. [Signature]		DATE 9-19-46				
DATE 9-19-46						

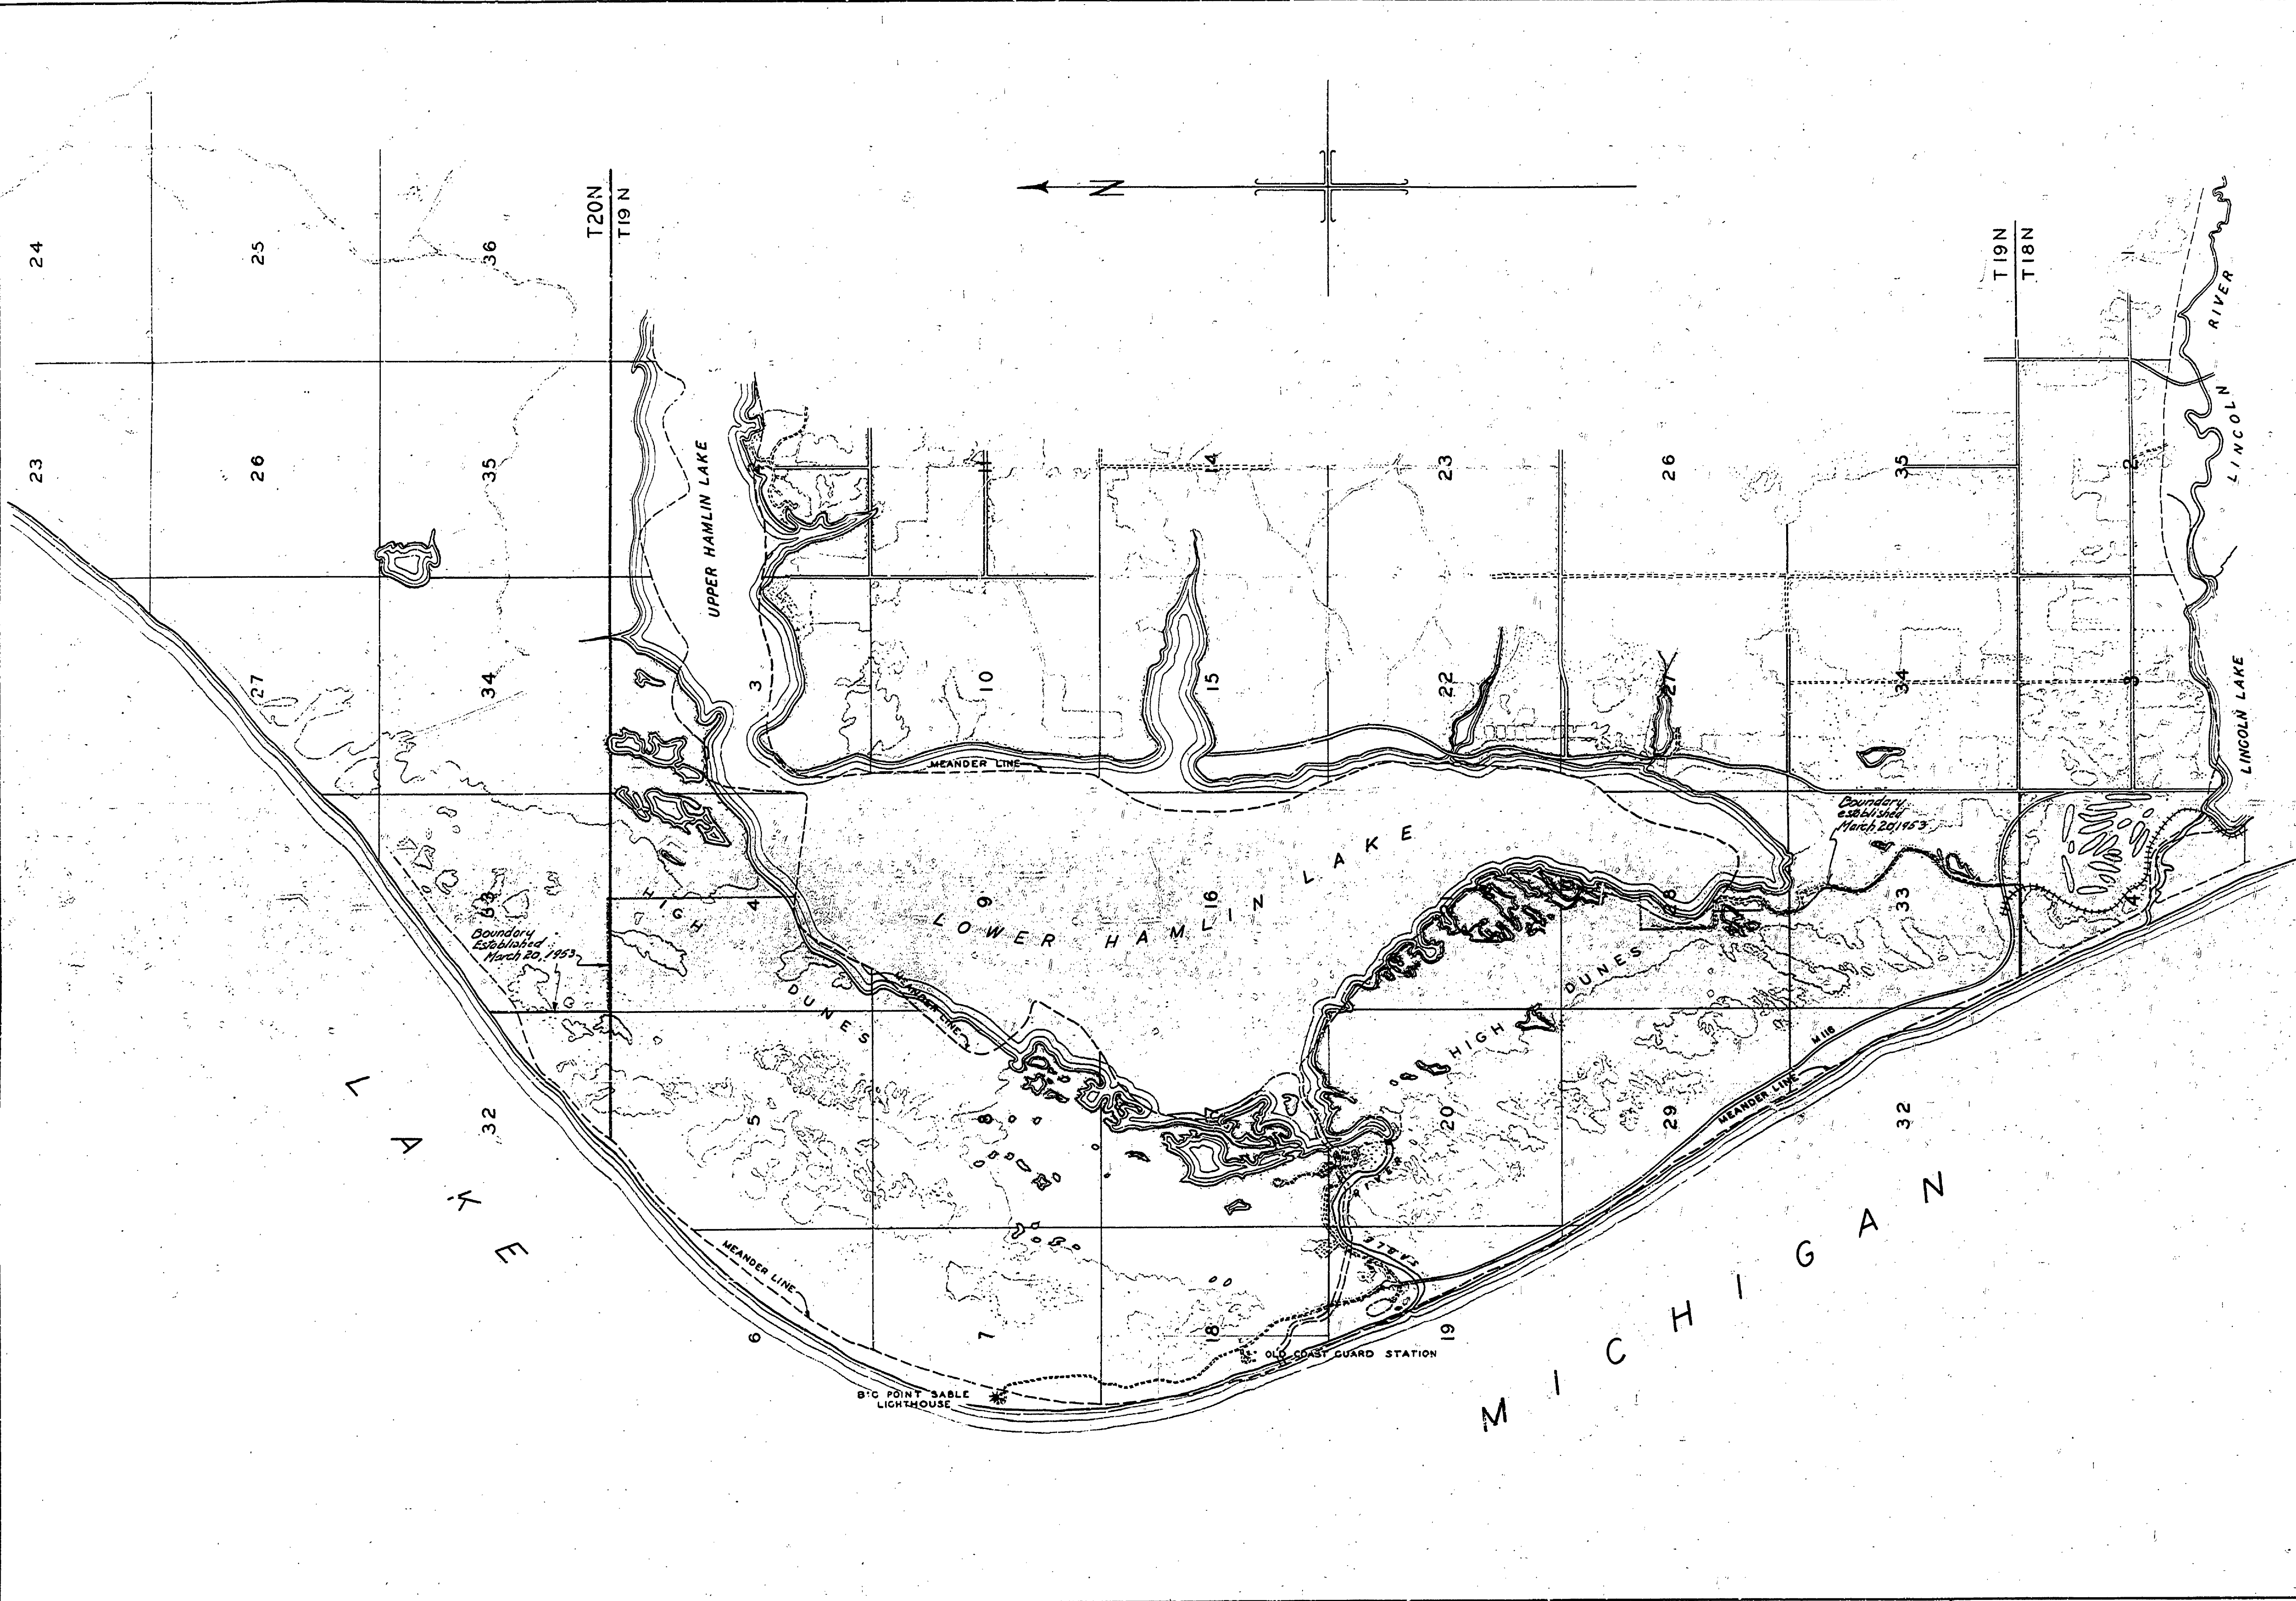

SCALE 3IN. = 1MI.

COMPILED FROM  
C.L.O. AND AERIAL  
PHOTO INFORMATION

MASON COUNTY

GRANT TOWNSHIP T20N R18W  
HAMLIN TOWNSHIP T19N R18W  
PERE MARQUETTE TOWNSHIP T18N R18W

MICHIGAN  
DEPARTMENT OF CONSERVATION  
PARKS AND RECREATION DIVISION

LUDINGTON STATE PARK PROJECT  
RECONNAISSANCE MAP

SHEET  
NO. 1  
OF 1

PLAN NO.  
R-3