


BRYANT A. BARR & CARMEL J. BARR PROPERTY
 ALOHA TWP. CHEBOYGAN CO.
 Part of Govt. Lot 3 & The NW 1/4 - SE 1/4 - Section 8
 T36N-R1W

LOCATIONS OF SOIL BORINGS & OBSERVATION WELLS
 FOR PROPOSED IRRIGATION FIELD,
 FOR ALOHA STATE PARK.

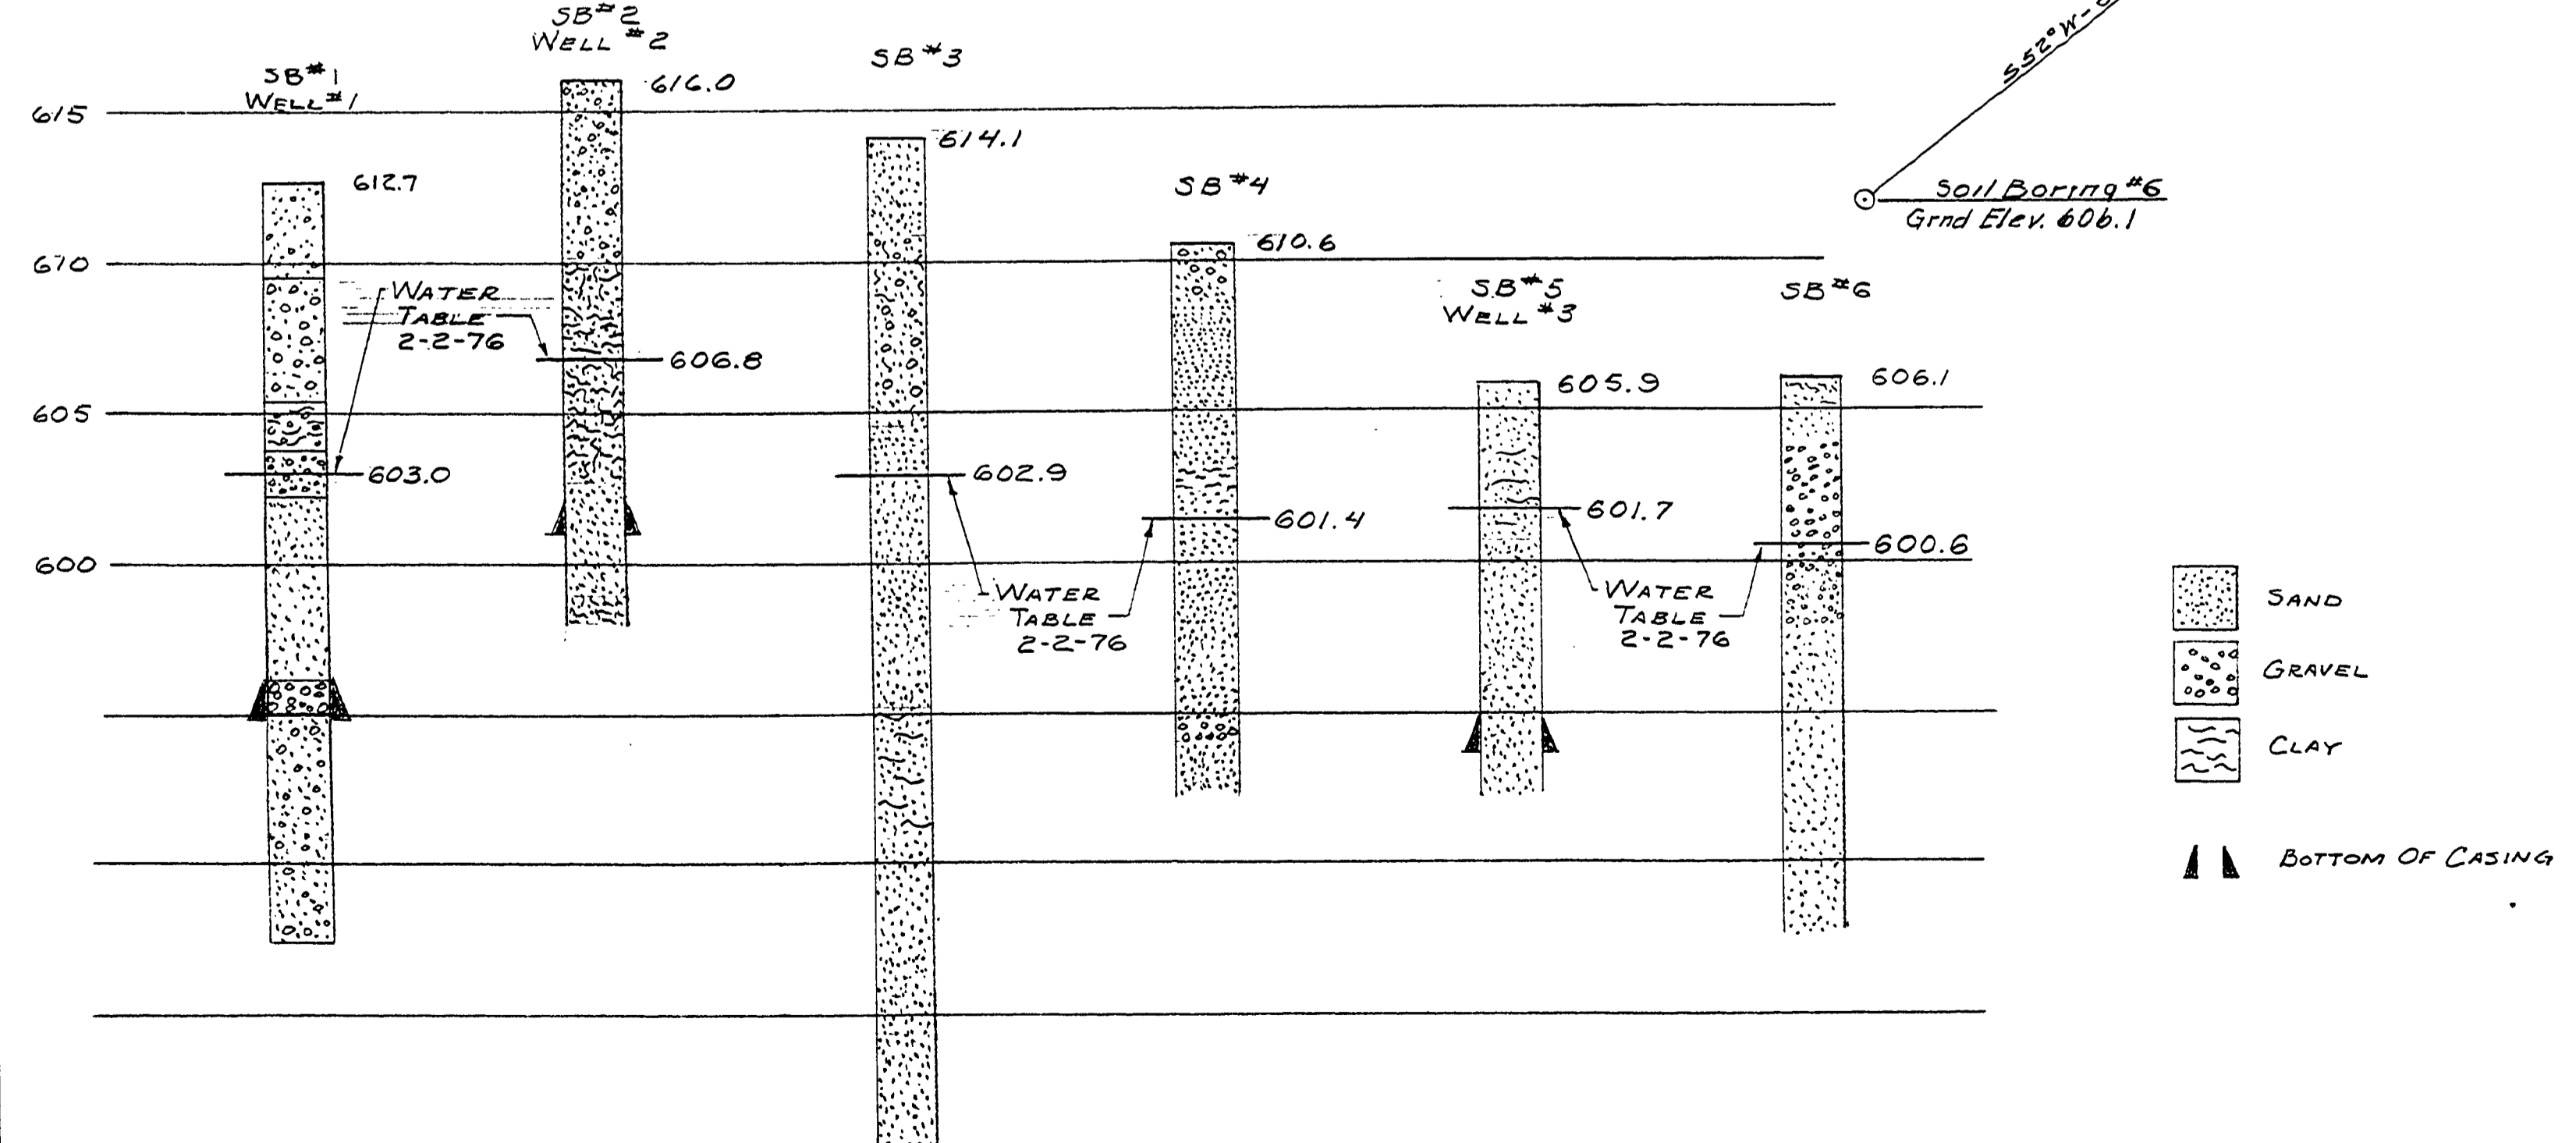

SURVEYED BY <i>L. Smith, H. Merrill</i>	2-76	DRAWN BY <i>L. Smith</i>	2-76	NO.	DATE	BY	REVISIONS	NO.	DATE	BY	REVISIONS	MICHIGAN DEPARTMENT OF NATURAL RESOURCES	SOILS & OBSERVATION WELLS SHEET TITLE	AREA OR PARK <i>ALOHA STATE PARK</i>	PROJECT NO. <i>24-1862</i>
DESIGNED BY	DATE	CHECKED BY	DATE	1.				3.						PROJECT <i>SEWAGE SYSTEM REVISIONS</i>	SHEET <i>4</i> OF <i>4</i> PLAN NO. <i>E-118</i>