




BUILDING SECTION "B-B"
SCALE 3/8" = 1'-0"

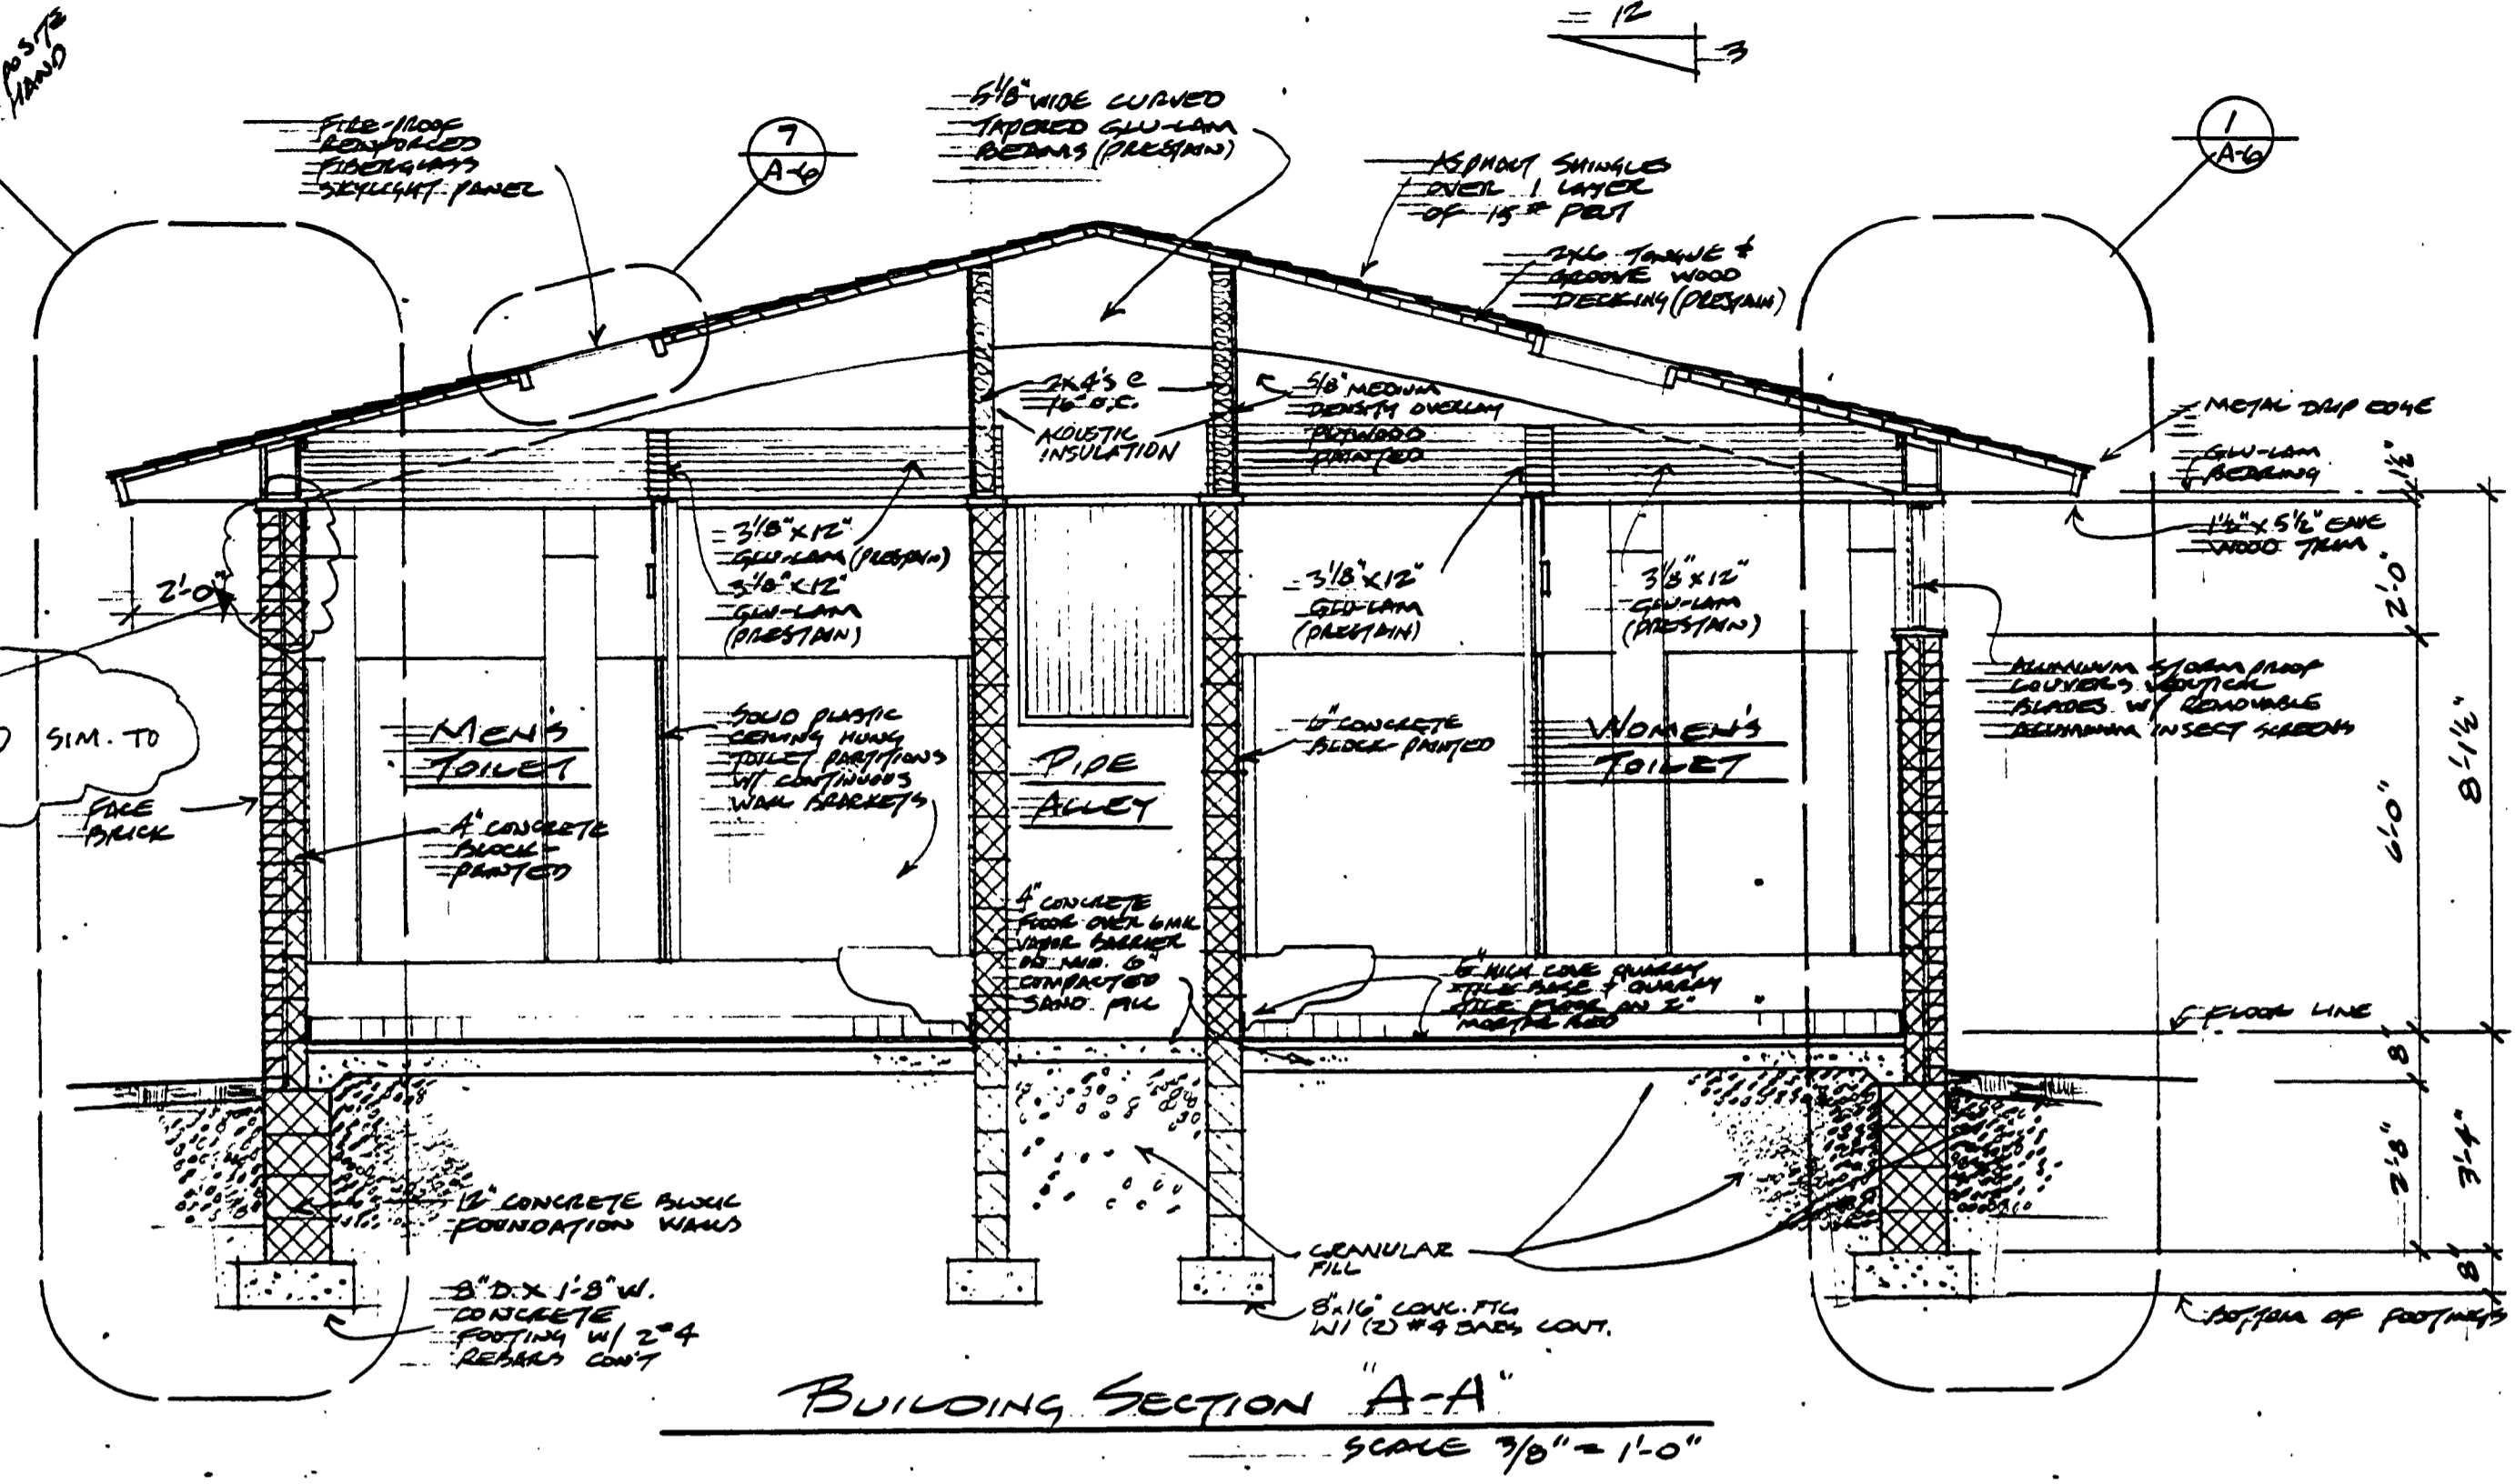

BUILDING SECTION "A-A"
SCALE 3/8" = 1'-0"

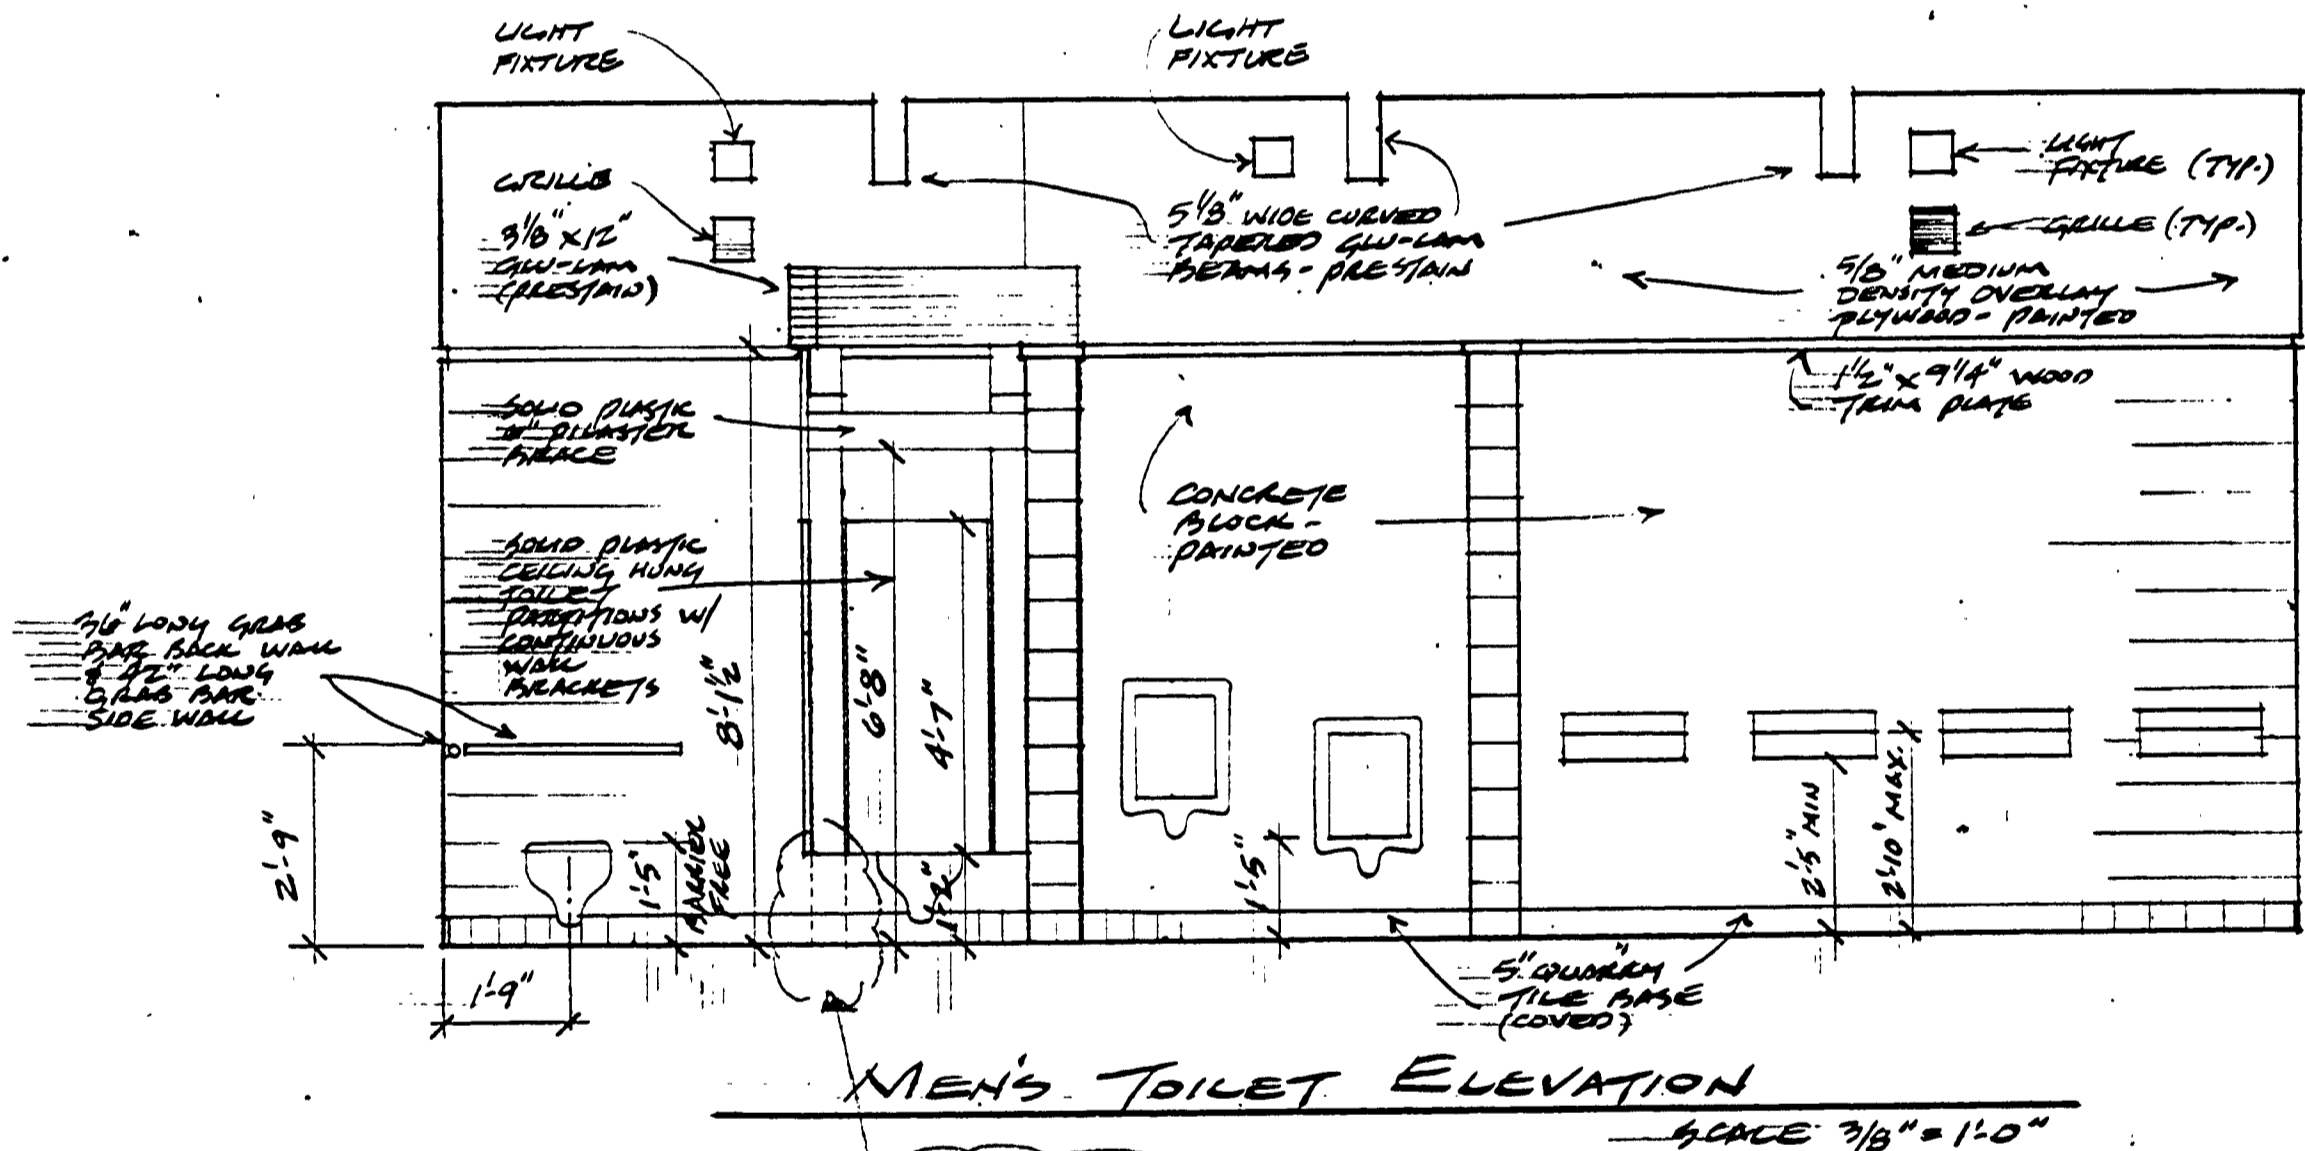

MEN'S TOILET ELEVATION
SCALE 3/8" = 1'-0"

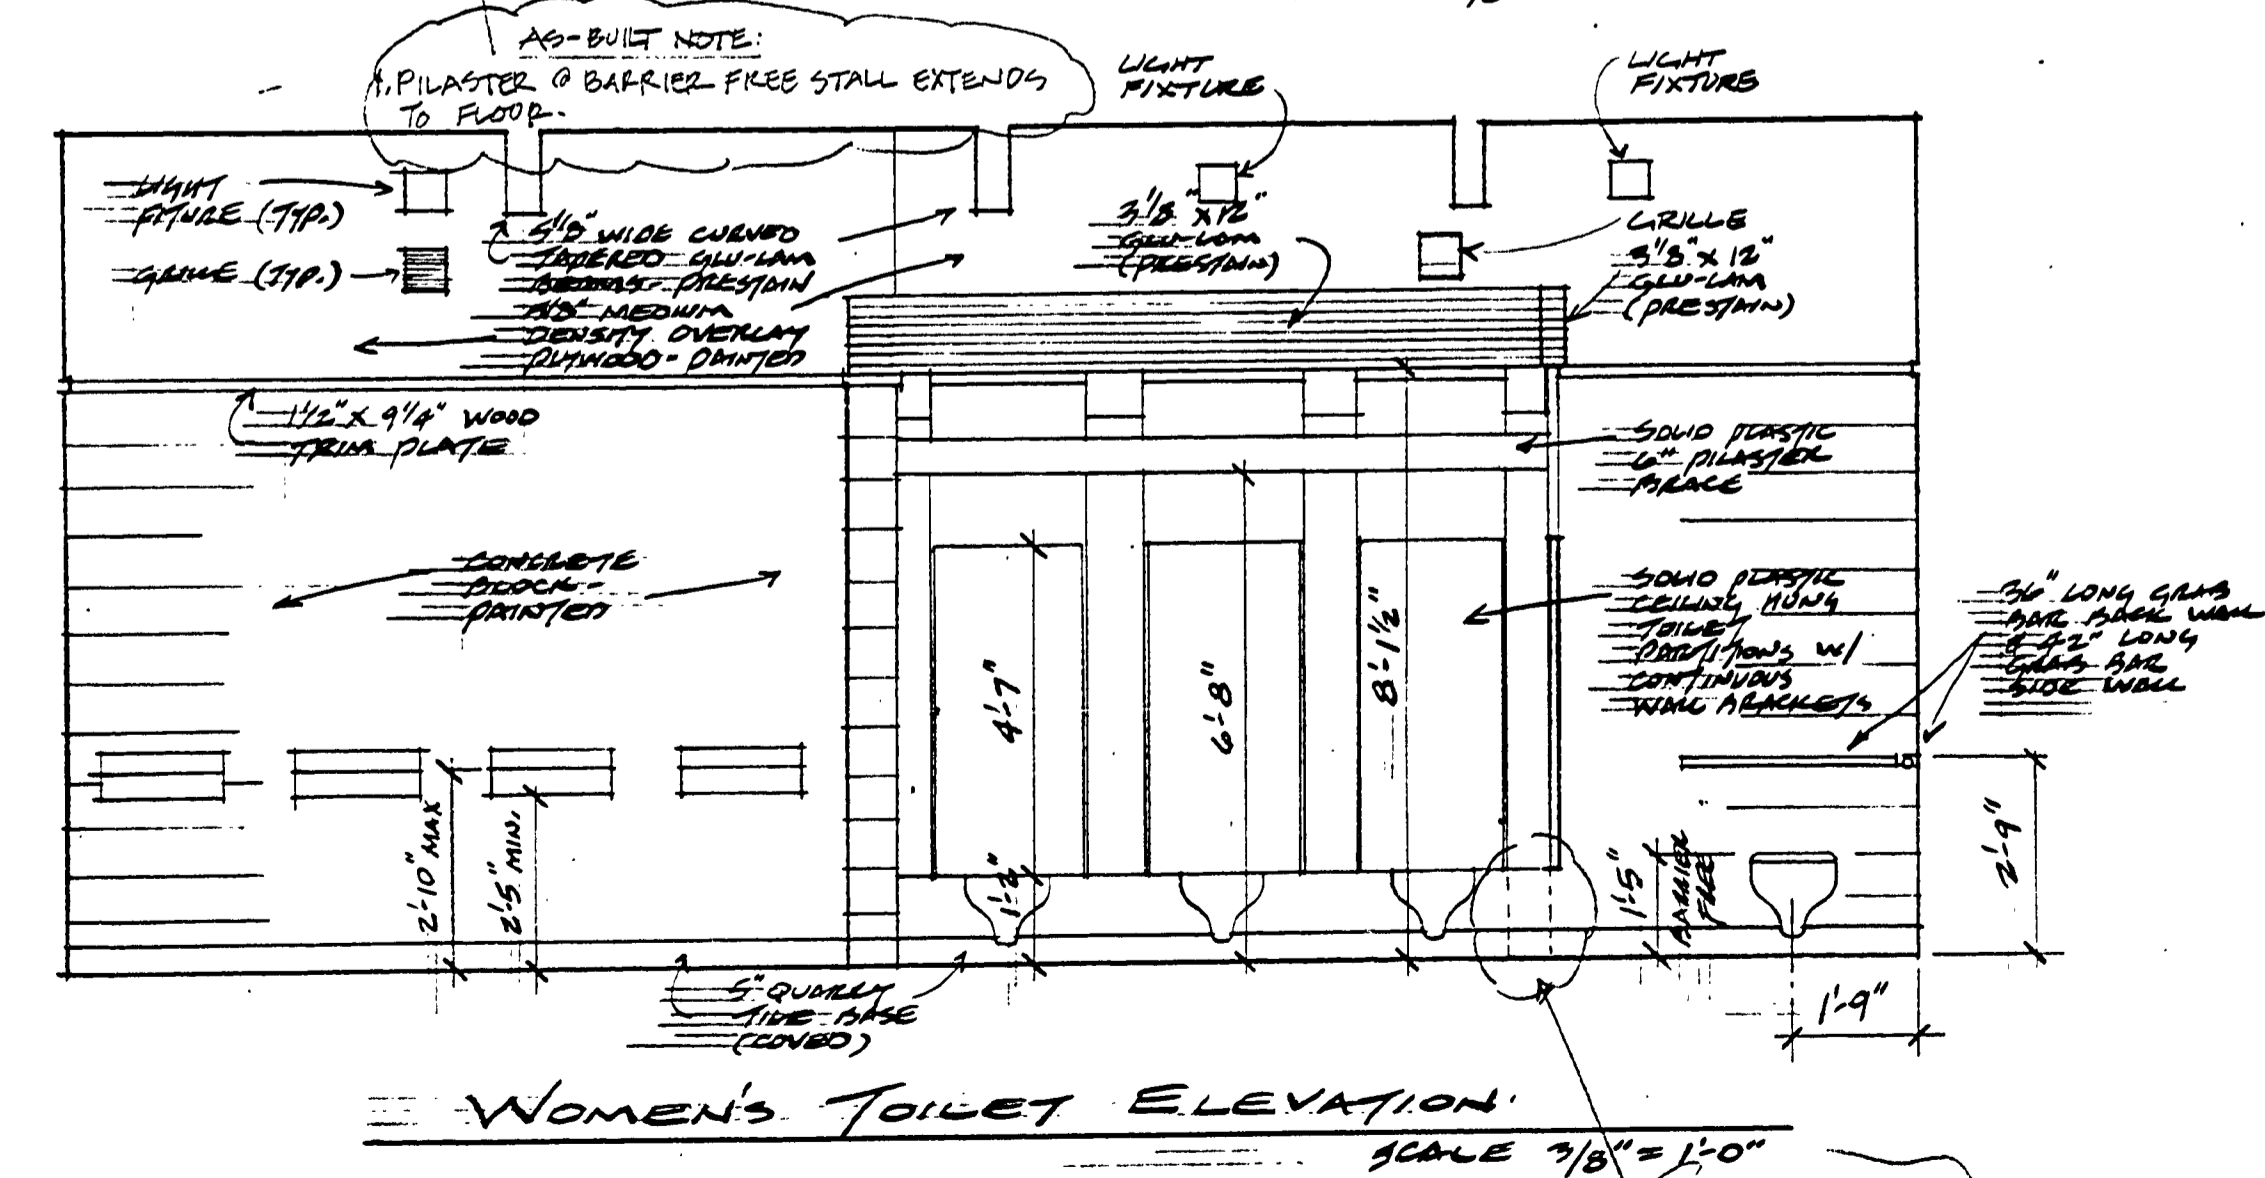

WOMEN'S TOILET ELEVATION
SCALE 3/8" = 1'-0"

Bernath-Coakley Associates, Architects
4104 W. St. Joseph Hwy.
Lansing, Michigan 48917
(517) 321-9525

STATE OF MICHIGAN
DEPARTMENT OF MANAGEMENT AND BUDGET
Office of Facilities

TOILET AND SHELTER BUILDING
BAY CITY STATE PARK
STATE OF MICHIGAN
DEPARTMENT OF NATURAL RESOURCES
PARKS DIVISION

Revisions
AUG. 3, 1970
Date
Comm. No.
9054
Sheet No.

A5
L-123