

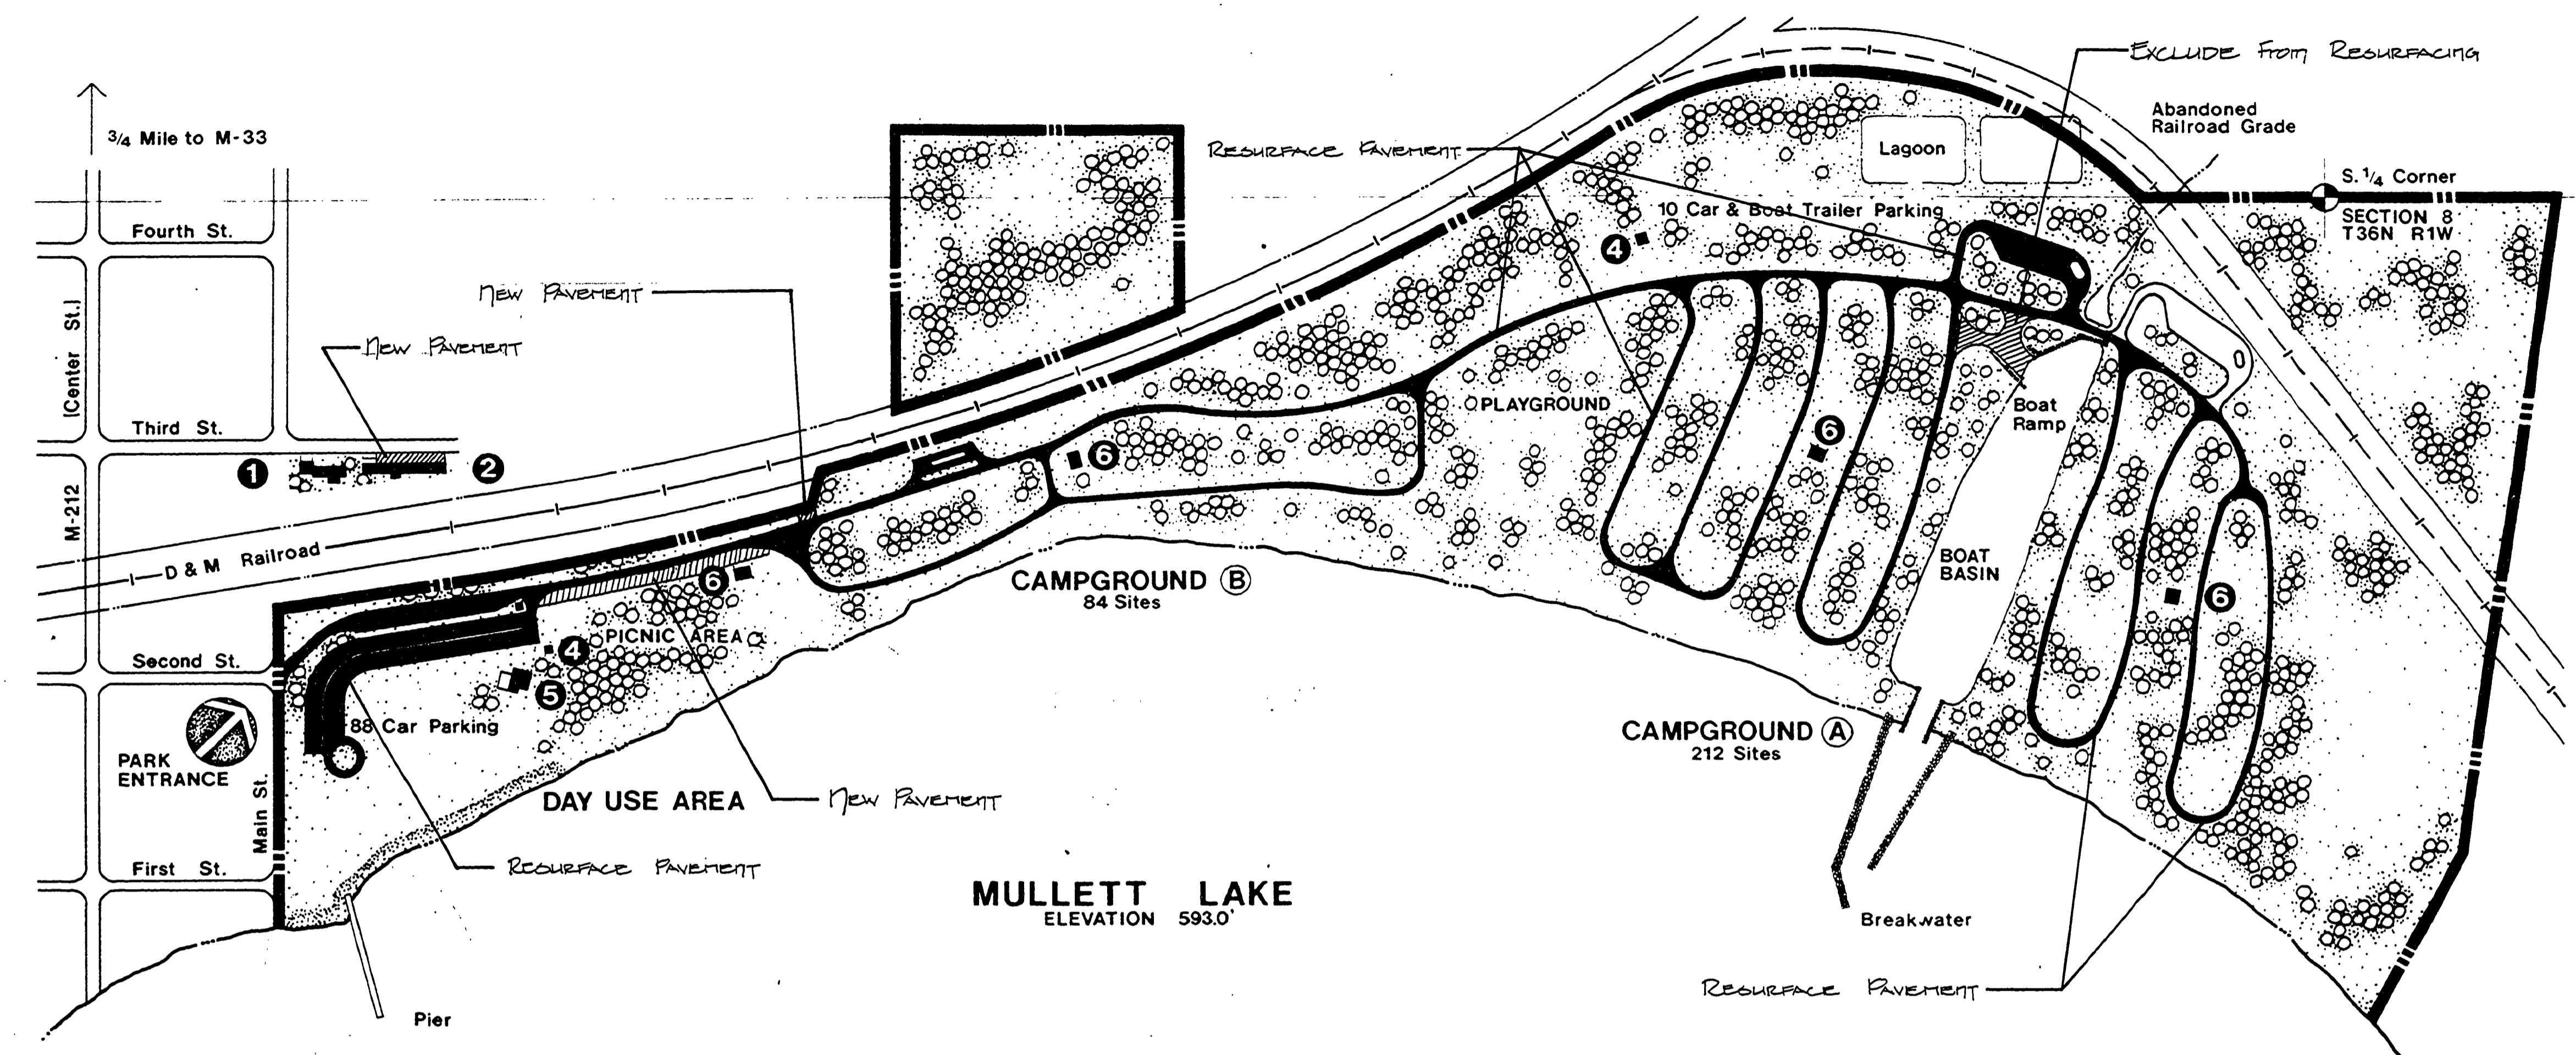
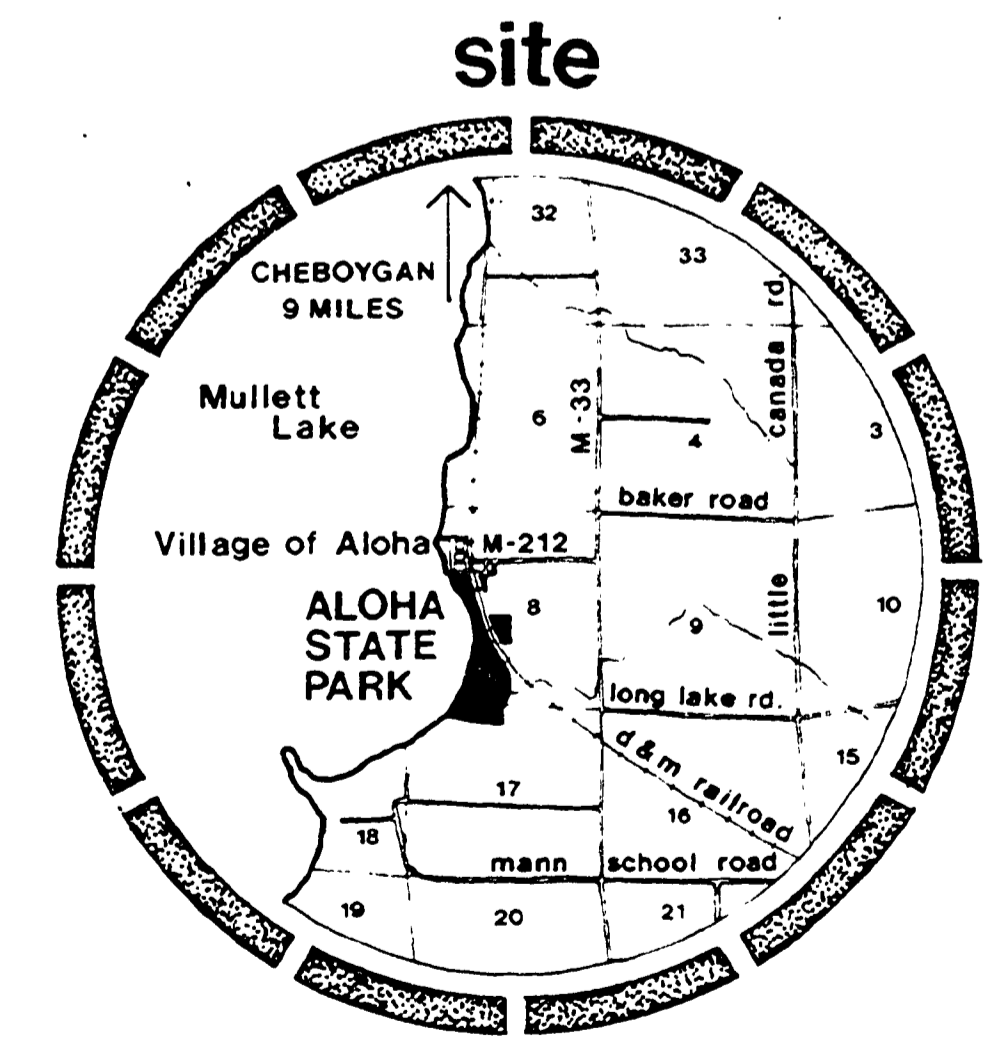
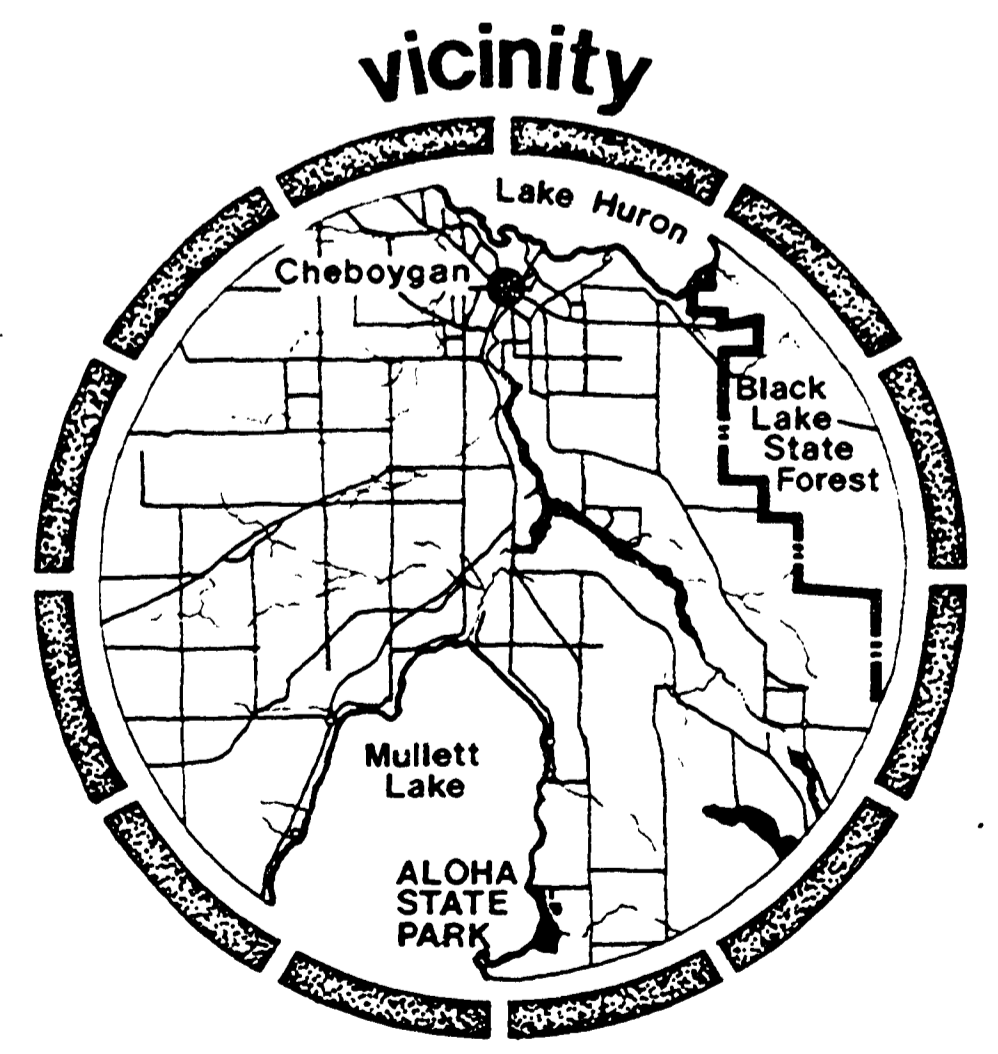


- Building Identification Legend**
- 1 Manager's Residence
 - 2 Park Office, Garage & Workshop
 - 3 Contact Station
 - 4 Pumphouse
 - 5 Picnic Shelter (Proposed Toilet) Building
 - 6 Shower & Toilet Building

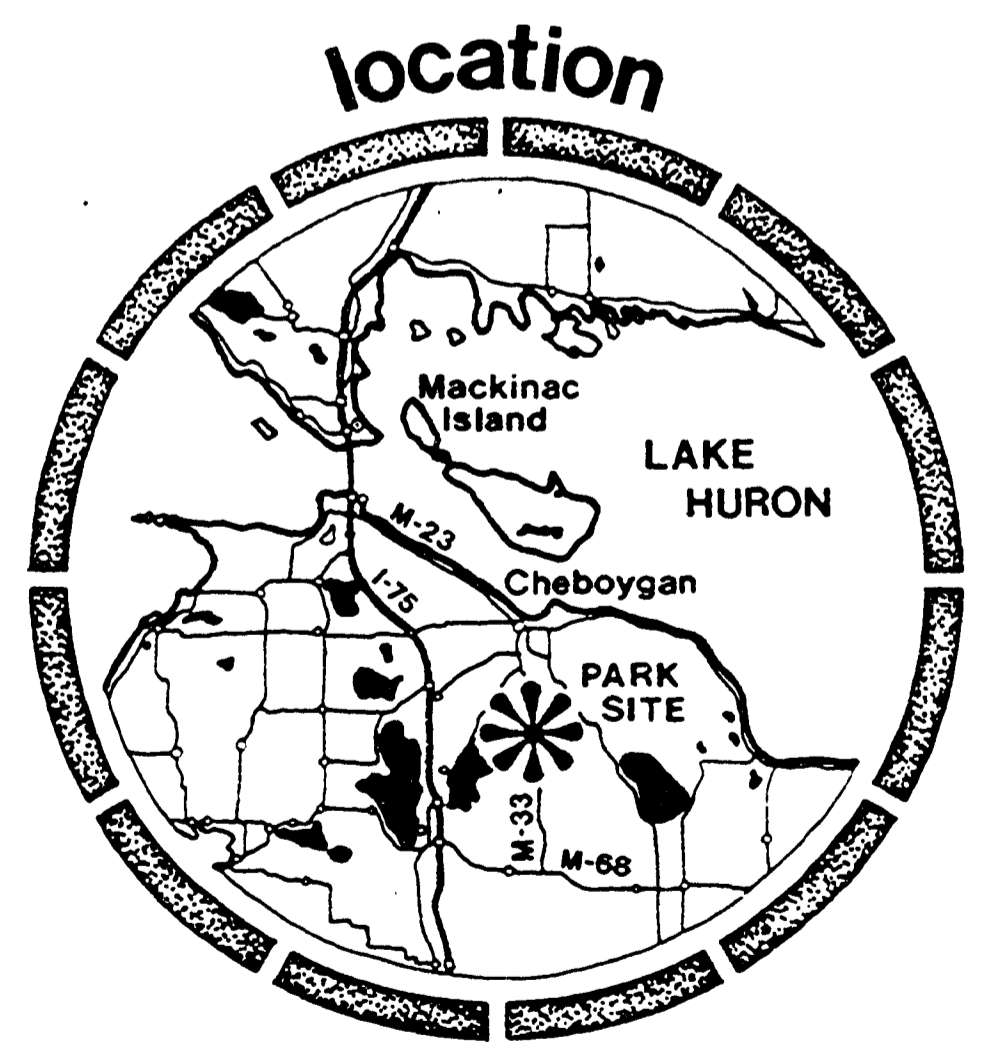

Master Plan Commission Approved 09-18-58

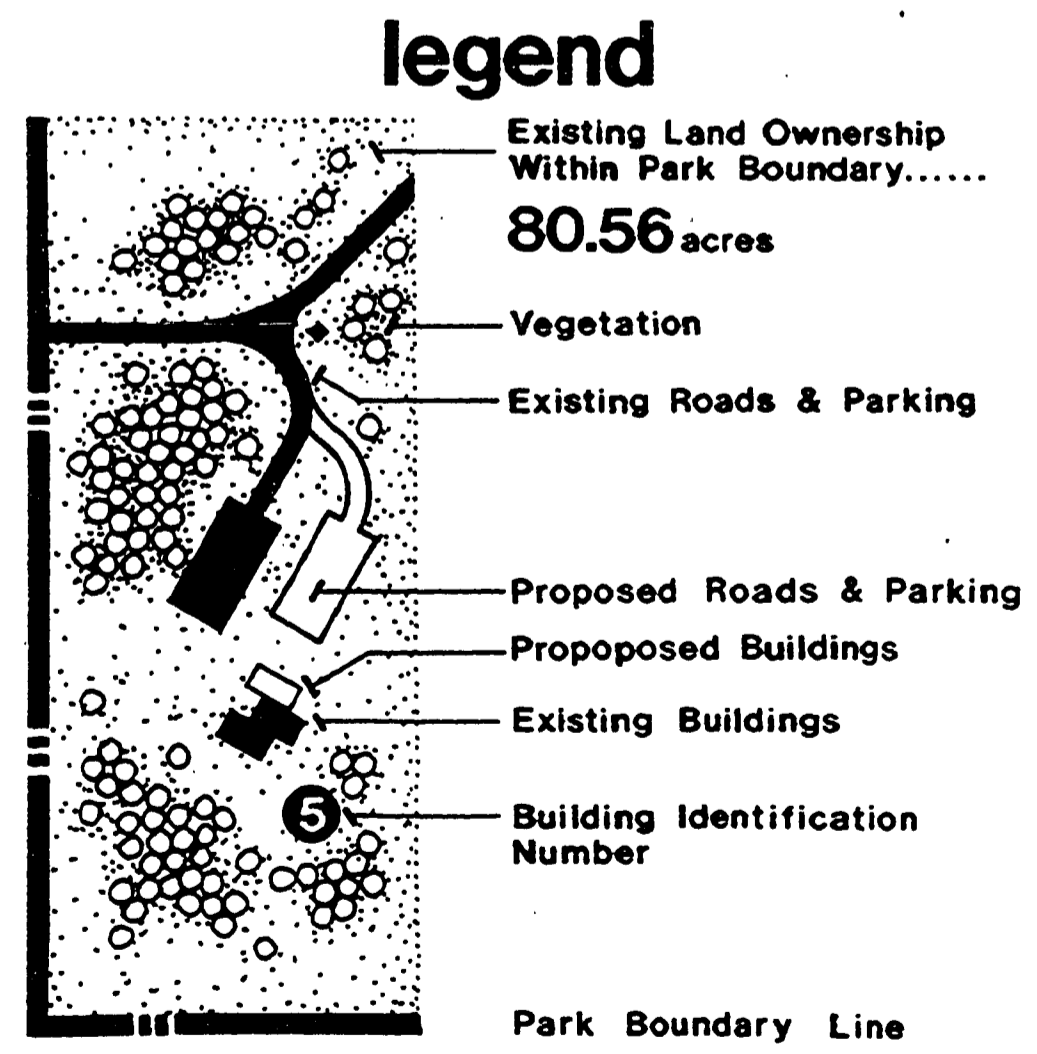

| | | | | | | | | | | | | | |
|-------------|---------------------------|--------|-----|--------|-----|-----------|-----|------|----|-----------|--|-----------|--|
| SURVEYED BY | DRAWN BY machelski | 050979 | NO. | DATE | BY | REVISIONS | NO. | DATE | BY | REVISIONS | MICHIGAN DEPARTMENT OF NATURAL RESOURCES | SITE PLAN | AREA OR PARK ALOHA STATE PARK |
| DESIGNED BY | CHECKED BY | | 1. | 8/9/90 | RJD | | 3. | | | | | | PROJECT PROTECTING MICHIGAN'S FUTURE SHEET 1 OF 1 PLAN NO. L-112 |
| | DATE | | 2. | | | | 4. | | | | | | |