


CONSTRUCTION PLANS FOR SITE UTILITY IMPROVEMENTS ALOHA STATE PARK

QUALITY OF LIFE RECREATION BOND PROGRAM UPPER EAST MICHIGAN REGION

MICHIGAN DEPARTMENT OF NATURAL RESOURCES
PARKS DIVISION
ACCT. NO. 607-75-2450-400

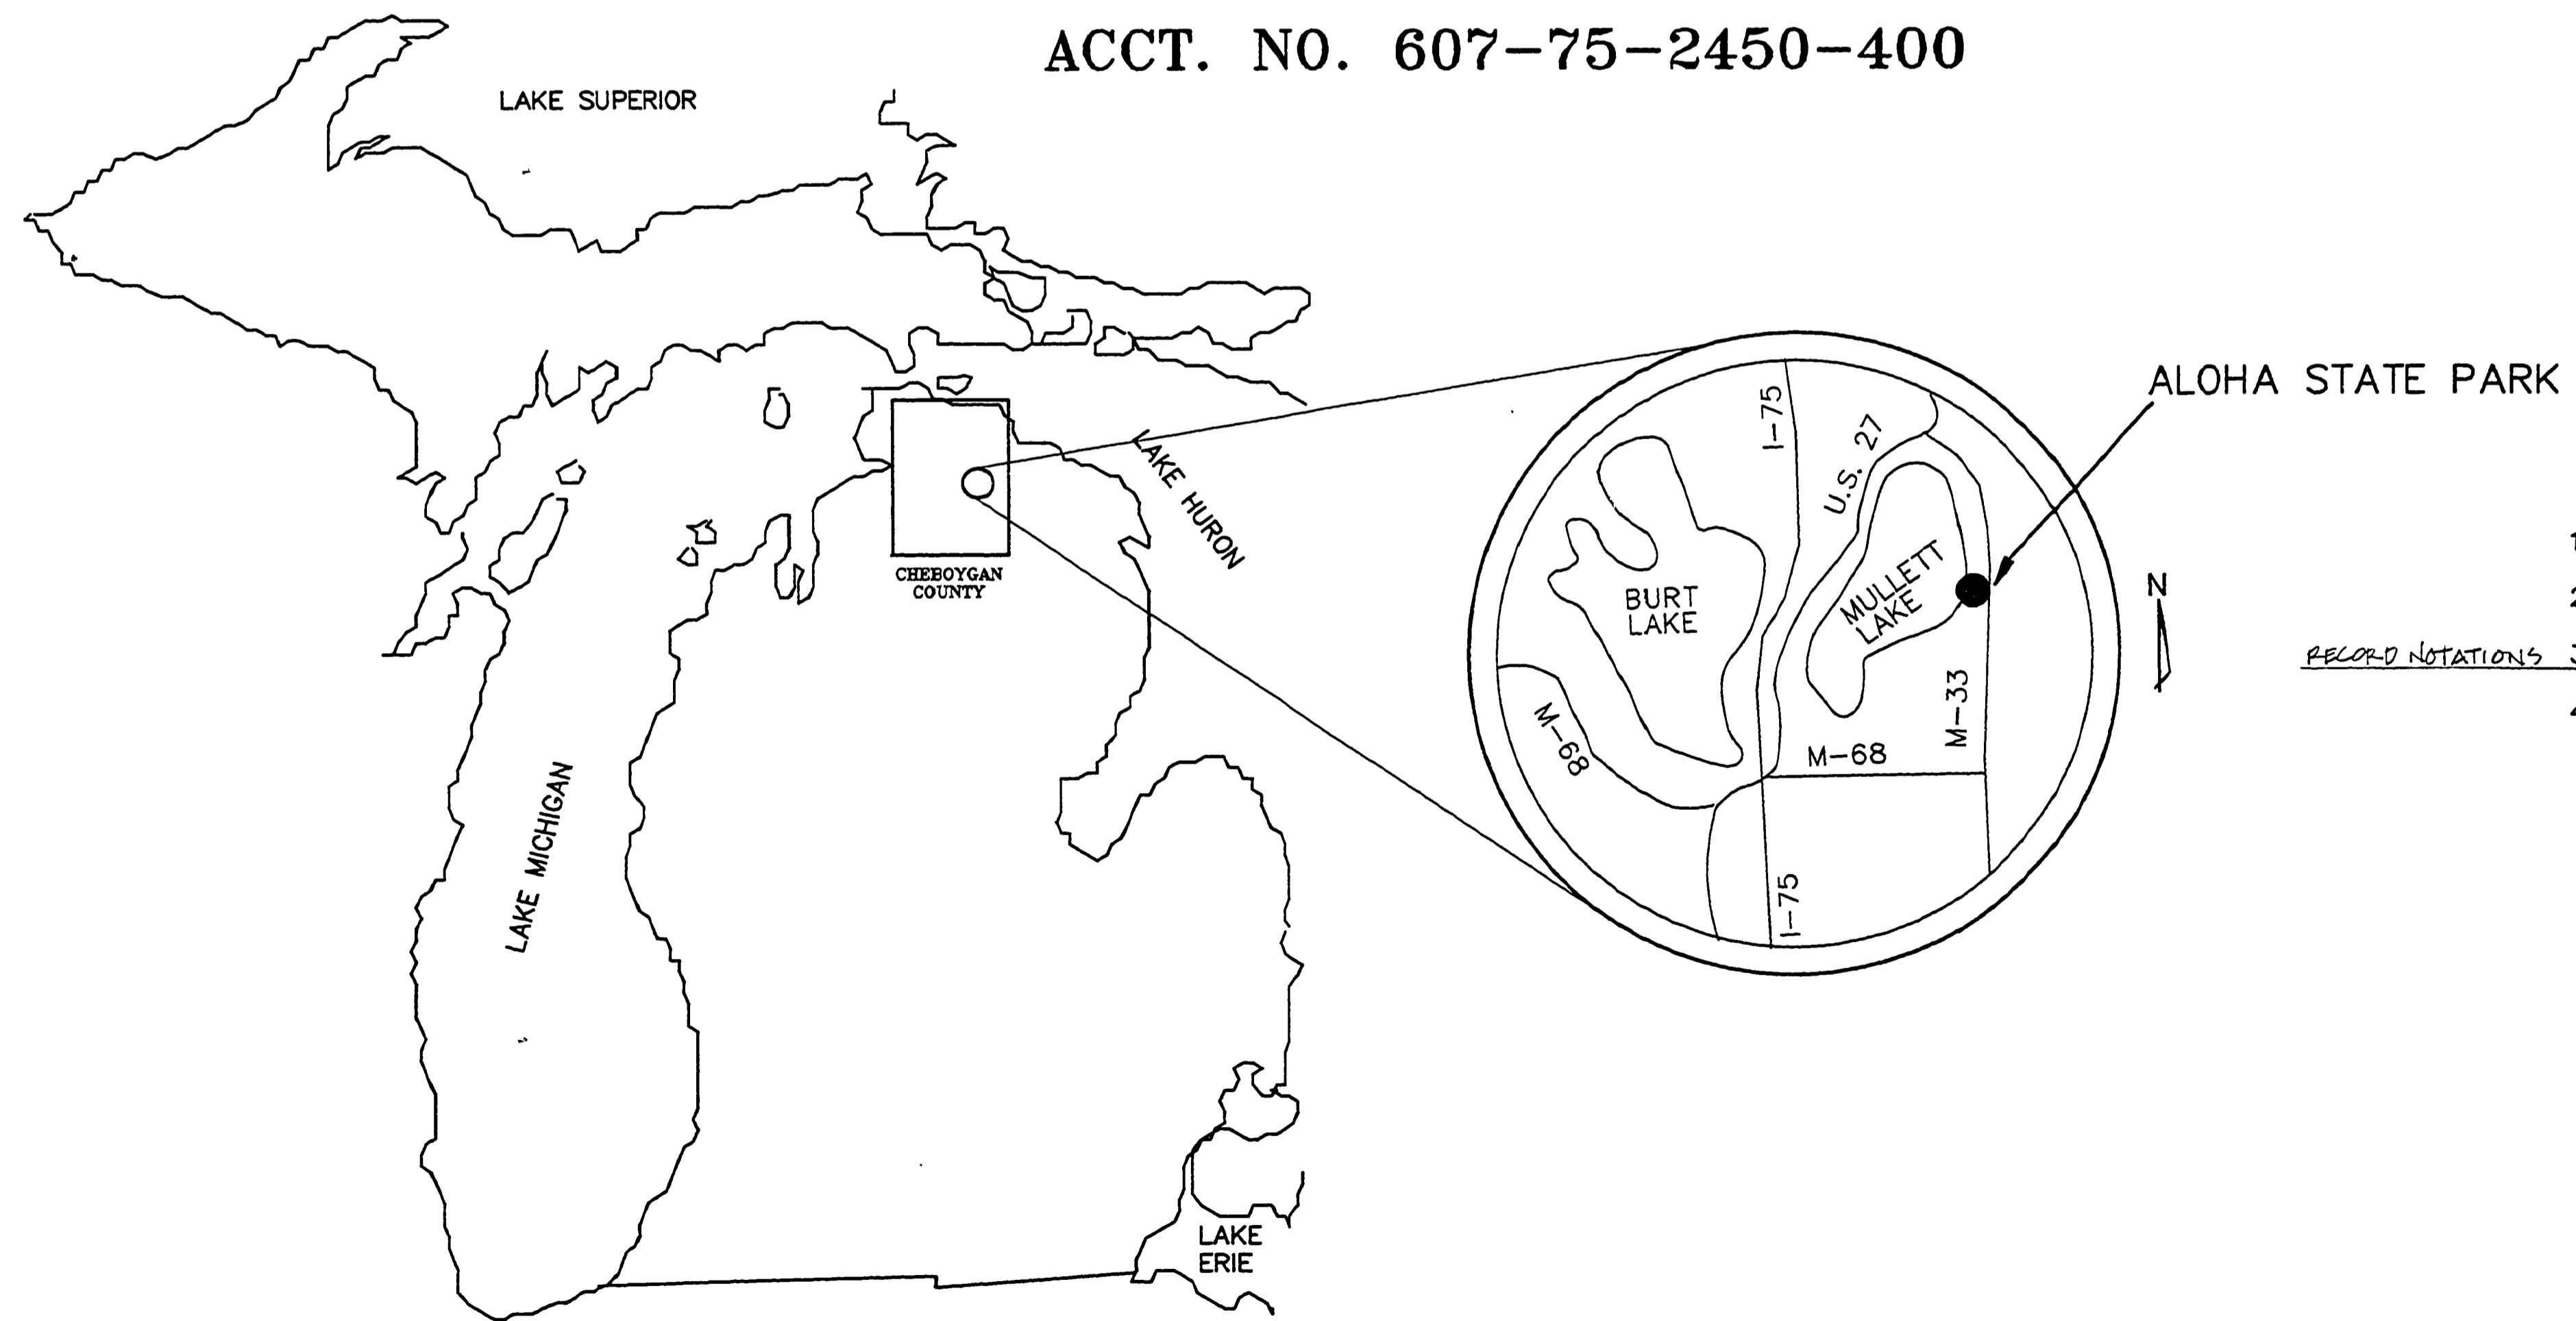

LIST OF DRAWINGS

1. TITLE SHEET
2. PUMP STATION SITE PLAN AND DETAILS PUMP STATION NO. 1
3. PUMP STATION NO. 1 MODIFICATION DETAILS
4. PUMP STATION NO. 1 ELECTRICAL

RECORD NOTATIONS



Heartland Construction Co.
 PROJECT MANAGER
 1800 Michigan National Tower • Lansing, Michigan 48933 • 517-482-6100

Capital Consultants, Inc.
 ENGINEERS
 650 N. WASHINGTON AVE. LANSING, MICHIGAN 48906 TELEPHONE 517-371-1000

STATE OF MICHIGAN
 DEPARTMENT OF MANAGEMENT AND BUDGET
Office of Facilities

STATE OF MICHIGAN
 DEPARTMENT OF NATURAL RESOURCES
 APPROVED BY: *DeWilly J. L. P. Dwyer*
 CHIEF, PARKS DIVISION
 DATE: 2/22/91

L-115
 SHEET
 1 OF 4

ALOHA STATE PARK
 RECORD DRAWING