


CONSTRUCTION PLANS FOR WASTEWATER TREATMENT IMPROVEMENTS ALOHA STATE PARK

QUALITY OF LIFE RECREATION BOND PROGRAM UPPER EAST MICHIGAN REGION

MICHIGAN DEPARTMENT OF NATURAL RESOURCES
PARKS DIVISION

ACCT. NO. 607-75-2450-400

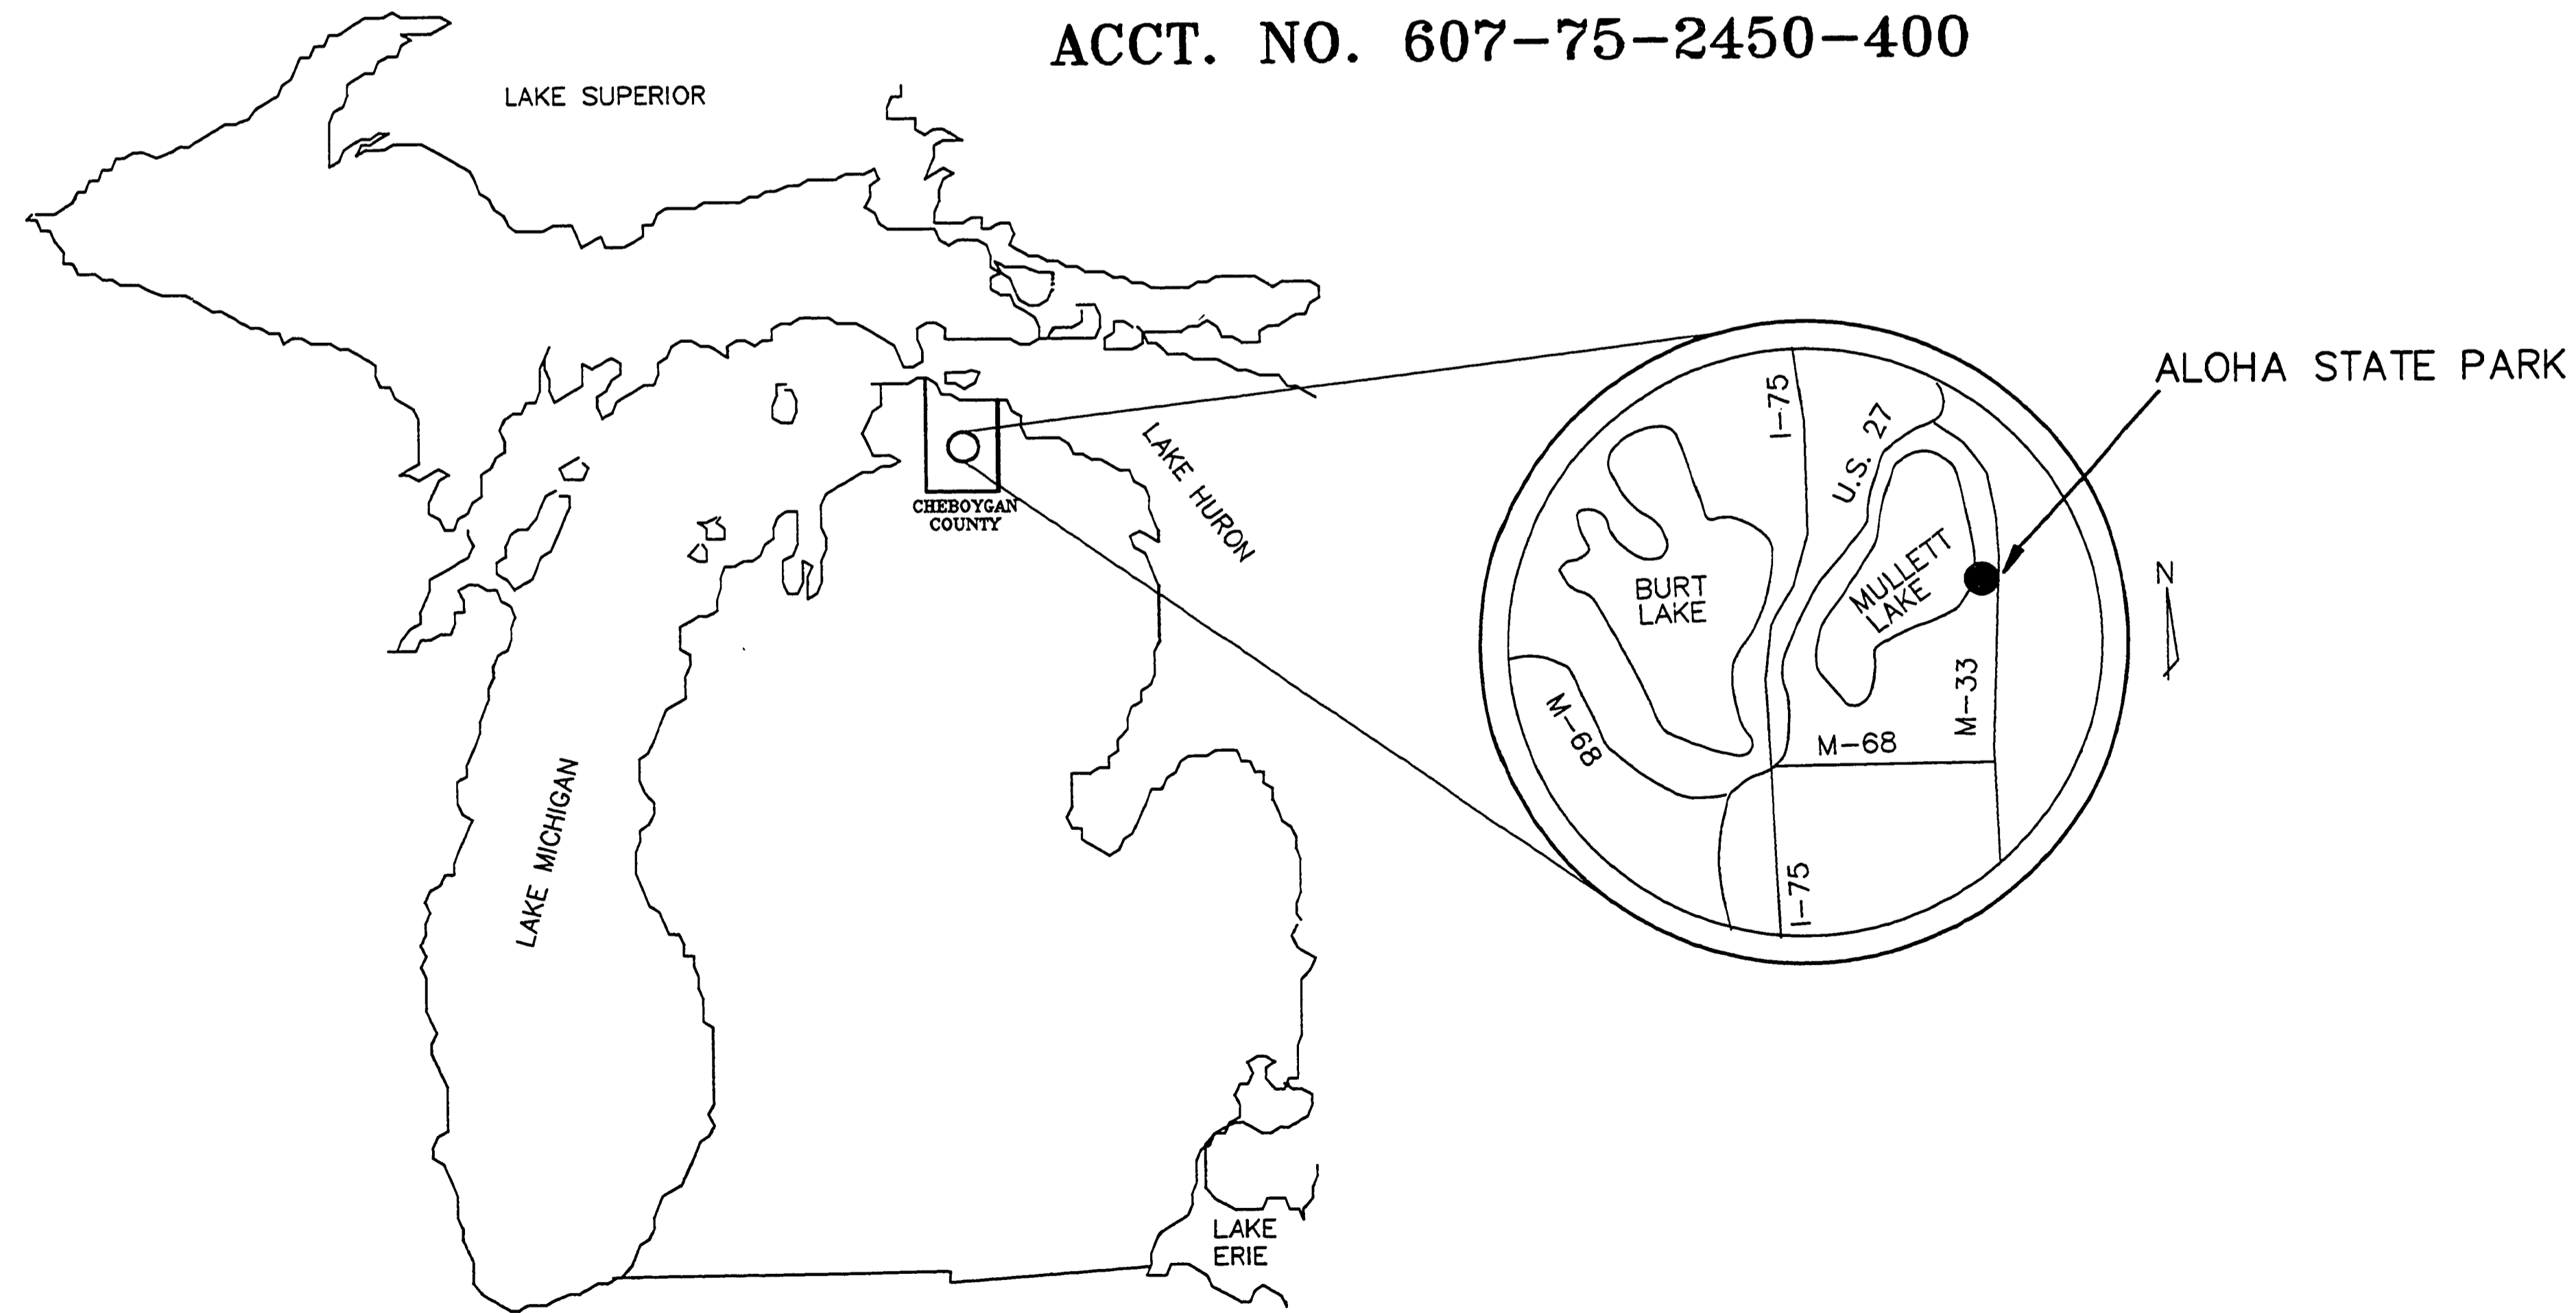

RECORD DRAWINGS

CONTRACTOR: *MANTHEI DEVELOPMENT CORP.*
DATE: *08-10-94*

LIST OF DRAWINGS

1. TITLE SHEET
2. GENERAL SITE PLAN, CONSTRUCTION NOTES AND SCHEDULING
3. EFFLUENT PUMP STATION, ELECTRICAL SITE PLAN AND DETAILS
4. EXISTING EFFLUENT PUMP STATION ABANDONMENT DETAILS AND WASTEWATER LAGOON DEWATERING PLAN
5. MAIN PUMP STATION AND ELECTRICAL MODIFICATION DETAILS
6. FORCEMAIN PLAN AND PROFILE STATION 0+00 TO 11+50
7. FORCEMAIN STATION 11+50 TO 16+69 AND EFFLUENT FORCEMAIN - PLAN AND PROFILES
8. STAKING AND GRADING PLAN
9. STORAGE LAGOON CROSS SECTIONS, ACCESS DRIVE PROFILE & PIPING SECTIONS
10. AERATED PRIMARY TANK DETAILS
11. EFFLUENT PUMP STATION DETAILS
12. EFFLUENT PUMP STATION AND AERATORS ELECTRICAL DETAILS
13. MISCELLANEOUS DETAILS

Heartland
Professional Construction Services, Inc.
1800 Michigan National Tower • Lansing, Michigan 48933 • 517-482-6100

CAPITAL CONSULTANTS ENGINEERS
407 N. WASHINGTON AVE. LANSING, MICHIGAN 48906 TELEPHONE 517-371-1500
111 E. MAIN STREET. LANSING, MICHIGAN 48226 TELEPHONE 517-732-8131

STATE OF MICHIGAN
DEPARTMENT OF MANAGEMENT AND BUDGET
Office of Facilities

STATE OF MICHIGAN
DEPARTMENT OF NATURAL RESOURCES
APPROVED BY: *Robert J. ...* DATE: *12/6/94*
CHIEF, PARKS & RECREATION DIVISION

SHEET
1 of 13

AREA 1C - WASTEWATER TREATMENT IMPROVEMENTS ALOHA STATE PARK

L-116

