


Cross Section of Peat removal in entrance drive & North Campground drive - Bulletin No. 1

FILE NO.: 1165X51
PLOT DATE: 10-26-93
UPDATED BY: LUS

DRN BY:	IDENTIFICATION NO.	ISSUED FOR	DATE	BULLETIN NO. 101
DES. BY: GJF	PROJECT - ALOHA	PRELIMINARY <input checked="" type="checkbox"/>	7-06-92	
CHK. BY: GDA	STATE ACCOUNT	CONSTRUCTION <input checked="" type="checkbox"/>	7-14-93	
APP'D BY:	607-75-2450-400	FINAL RECORD <input type="checkbox"/>		

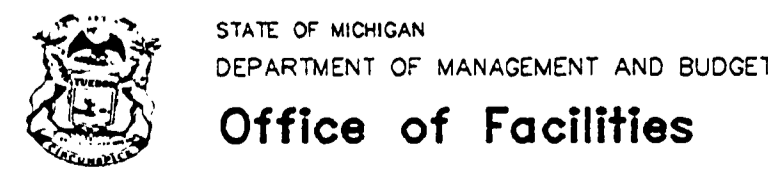

QUALITY OF LIFE RECREATION BOND
MICHIGAN DEPARTMENT OF NATURAL RESOURCES
PARKS DIVISION - STATE ACCT. NO. 607-75-2450-400

ALOHA STATE PARK
ENTRANCE DRIVE PEAT EXCAVATION
CROSS SECTIONS

SCALE: HORIZ. 1"=10'
VERT. 1"=2'
PROJ. NO.: 91165
SHEET 5 OF 10

L-118A