


CONSTRUCTION PLANS FOR CAMPGROUND DRIVES IMPROVEMENTS ALOHA STATE PARK

QUALITY OF LIFE RECREATION BOND PROGRAM UPPER EAST MICHIGAN REGION

MICHIGAN DEPARTMENT OF NATURAL RESOURCES
PARKS DIVISION
ACCT. NO. 607-75-2450-400

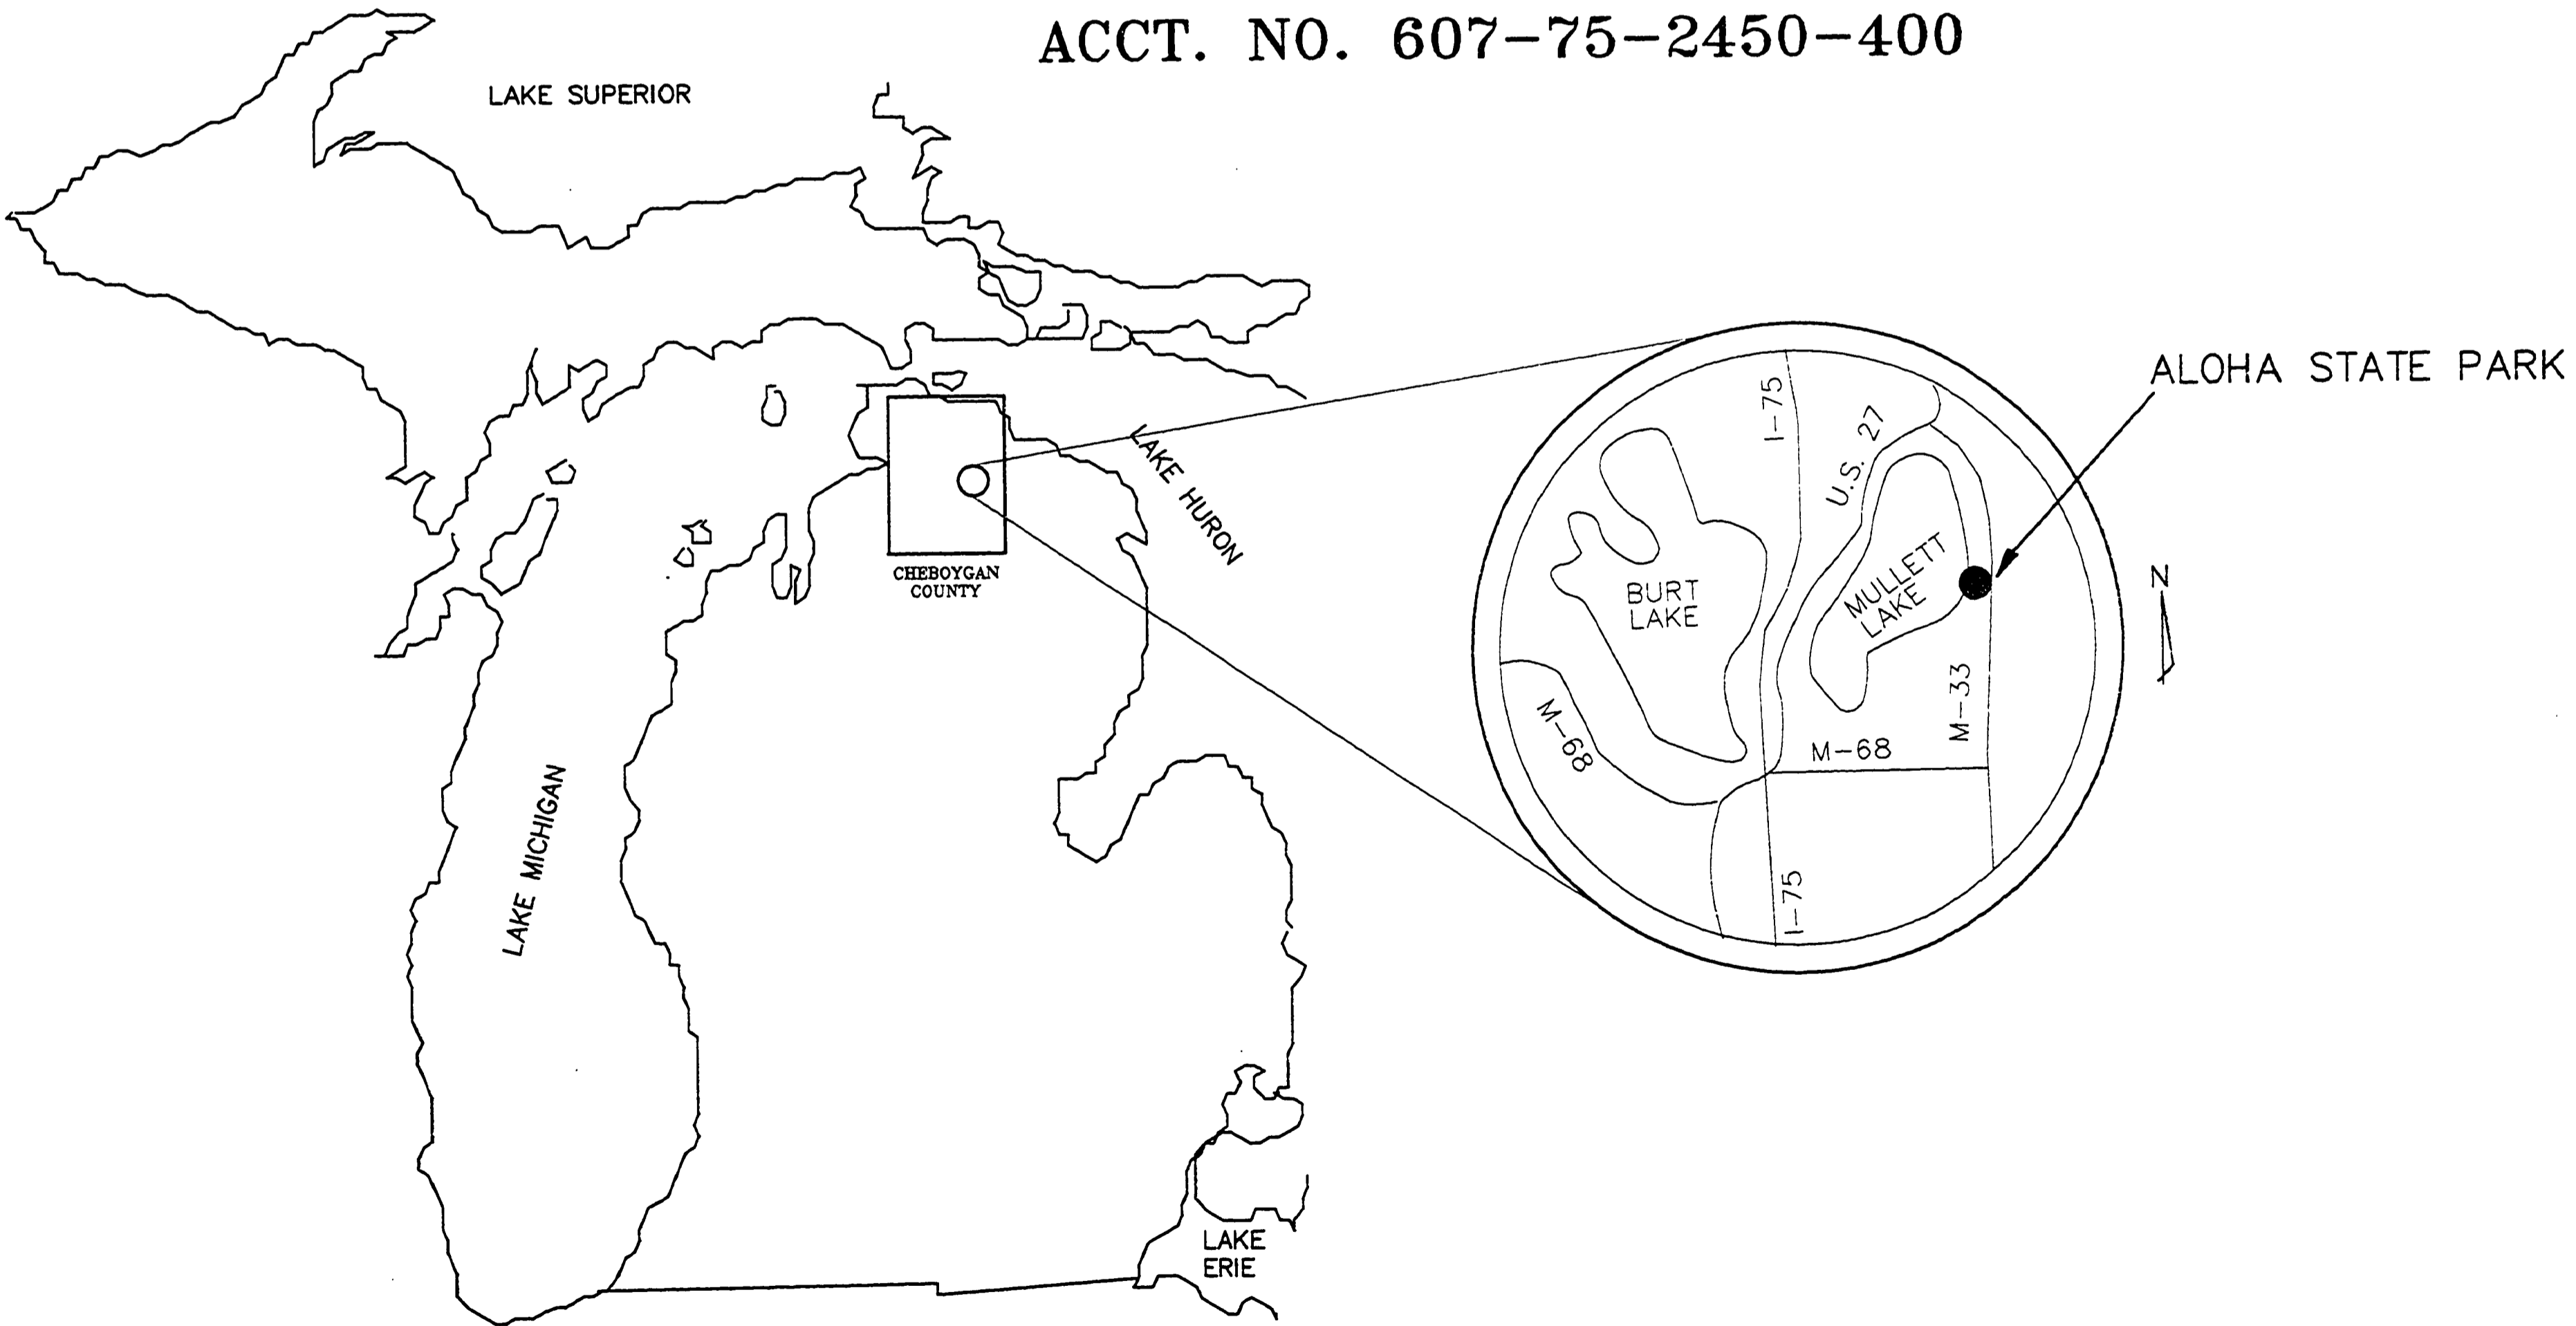

RECORD DRAWINGS
 CONTRACTOR: *Yaker Construction*
 DATE: *06-23-94*
 (Note Attachment to Sheet 11 of 17 - Revised Slope Section Detail)

LIST OF DRAWINGS

1. TITLE SHEET
U.S. Bulletin No. 1 - Sheets 1 to 10
2. GENERAL SITE MAP
3. TYPICAL CROSS SECTIONS & GENERAL NOTES
4. DETAILS
5. MISCELLANEOUS DETAILS
6. ENTRANCE DRIVE - STATION 0+00 TO 9+00
7. ENTRANCE DRIVE - STATION 9+00 TO 18+00
NORTH CAMPGROUND DRIVE STATION 0+00 TO 9+00
8. ENTRANCE DRIVE PROFILE - STA. 9+00 TO 18+00
NORTH CAMPGROUND DRIVE PROFILE STATION 0+00 TO 9+00
9. ENTRANCE DRIVE STA. 18+00 TO 27+00
NORTH CAMPGROUND DRIVE STATION 9+00 TO 14+03
10. ENTRANCE DRIVE PROFILE - STA. 18+00 TO 27+00
NORTH CAMPGROUND DRIVE PROFILE STATION 9+00 TO 14+03
11. ENTRANCE DRIVE STATION 27+00 TO 36+00
12. CENTRAL CAMPGROUND - NORTH LOOP DRIVES PLAN
13. CENTRAL CAMPGROUND - NORTH LOOP DRIVES PROFILES
14. CENTRAL CAMPGROUND - SOUTH LOOP DRIVES PLAN
15. CENTRAL CAMPGROUND - SOUTH LOOP DRIVE PROFILES
16. SOUTH CAMPGROUND DRIVE PLAN
17. SOUTH CAMPGROUND - DRIVE PROFILES

Heartland
Professional Construction Services, Inc.
1800 Michigan National Tower • Lansing, Michigan 48933 • 517-482-6100

Capital
Consultants, Inc.
ENGINEERS
830 N. WASHINGTON AVE. LANSING, MICHIGAN 48906 TELEPHONE 517-371-1500

STATE OF MICHIGAN
DEPARTMENT OF MANAGEMENT AND BUDGET
Office of Facilities

STATE OF MICHIGAN
DEPARTMENT OF NATURAL RESOURCES
APPROVED BY: *Heather M. Kelly* 7/12/94
DATE: 7/12/94
CHIEF, PARKS & RECREATION DIVISION

SHEET
1 of 17

AREA 2C - CAMPGROUND DRIVE IMPROVEMENTS ALOHA STATE PARK