




ENTRANCE DRIVE PROFILE

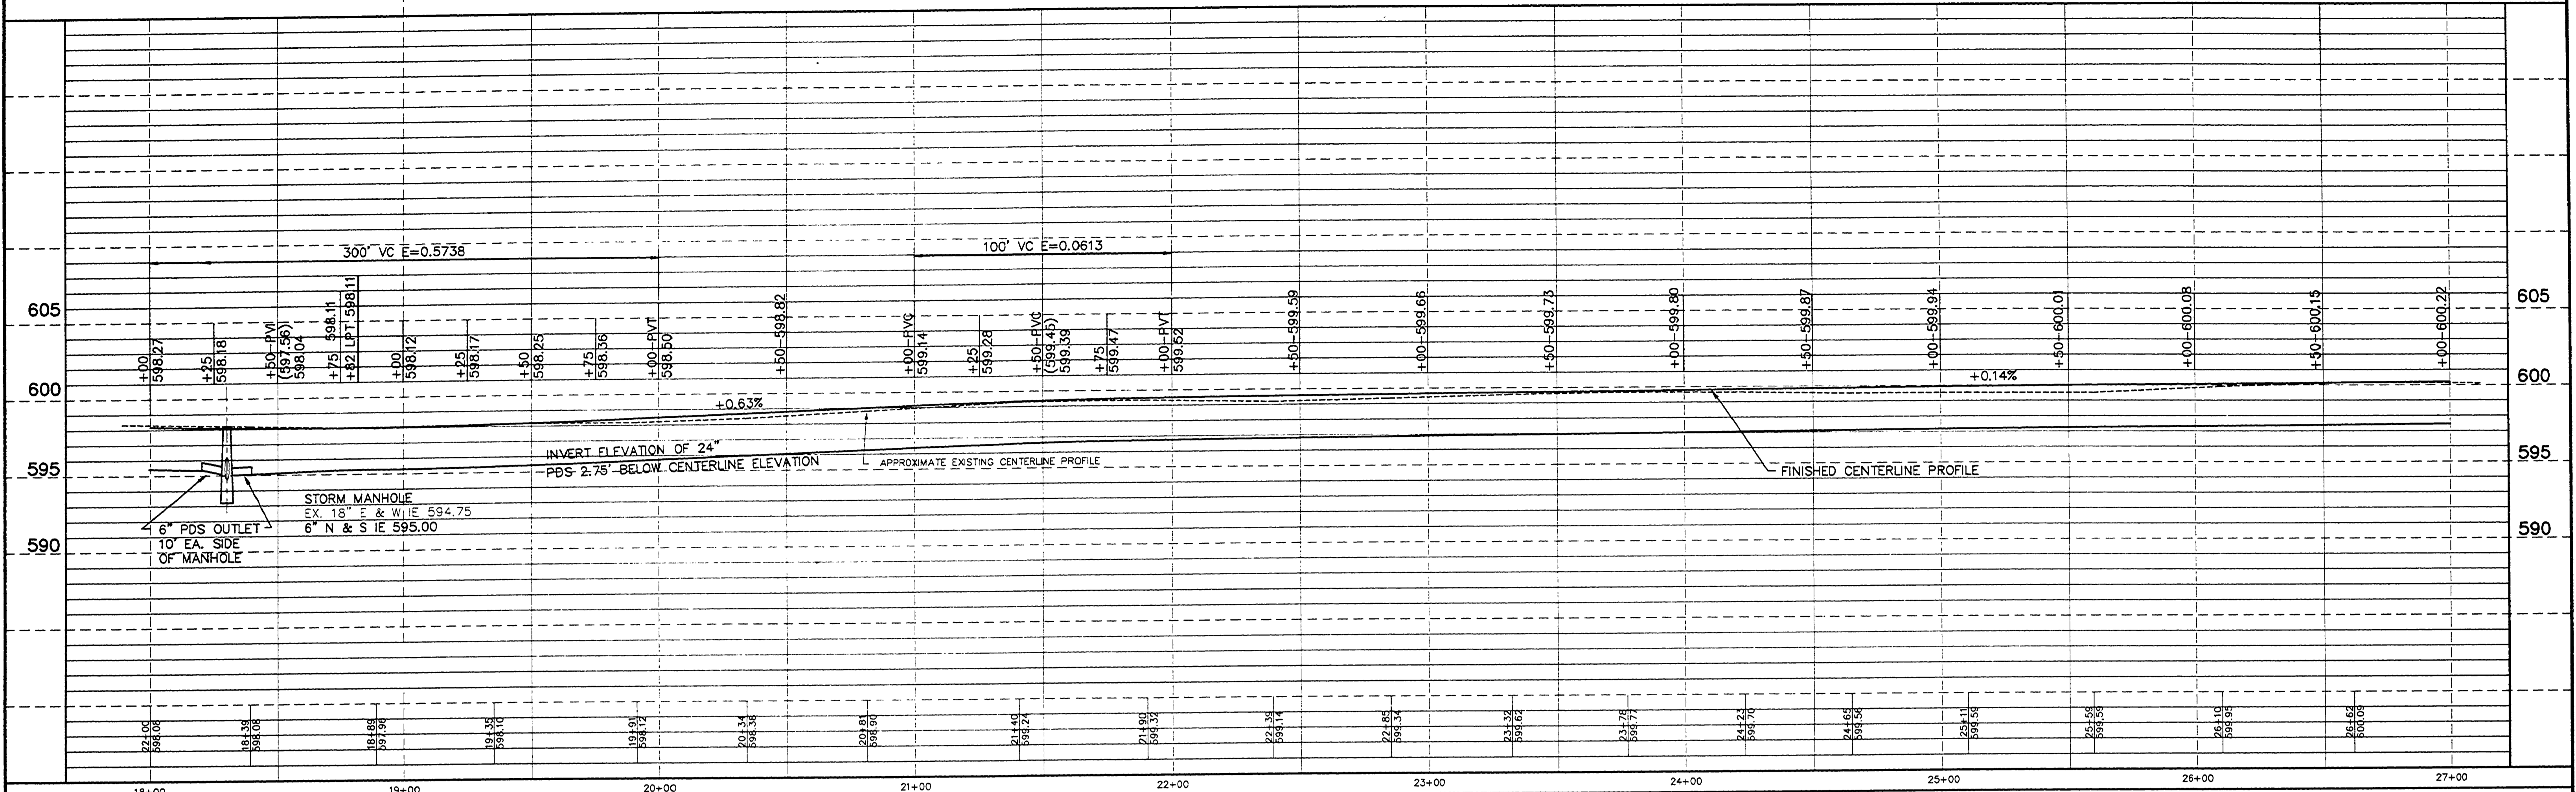

NORTH CAMPGROUND DRIVE PROFILE

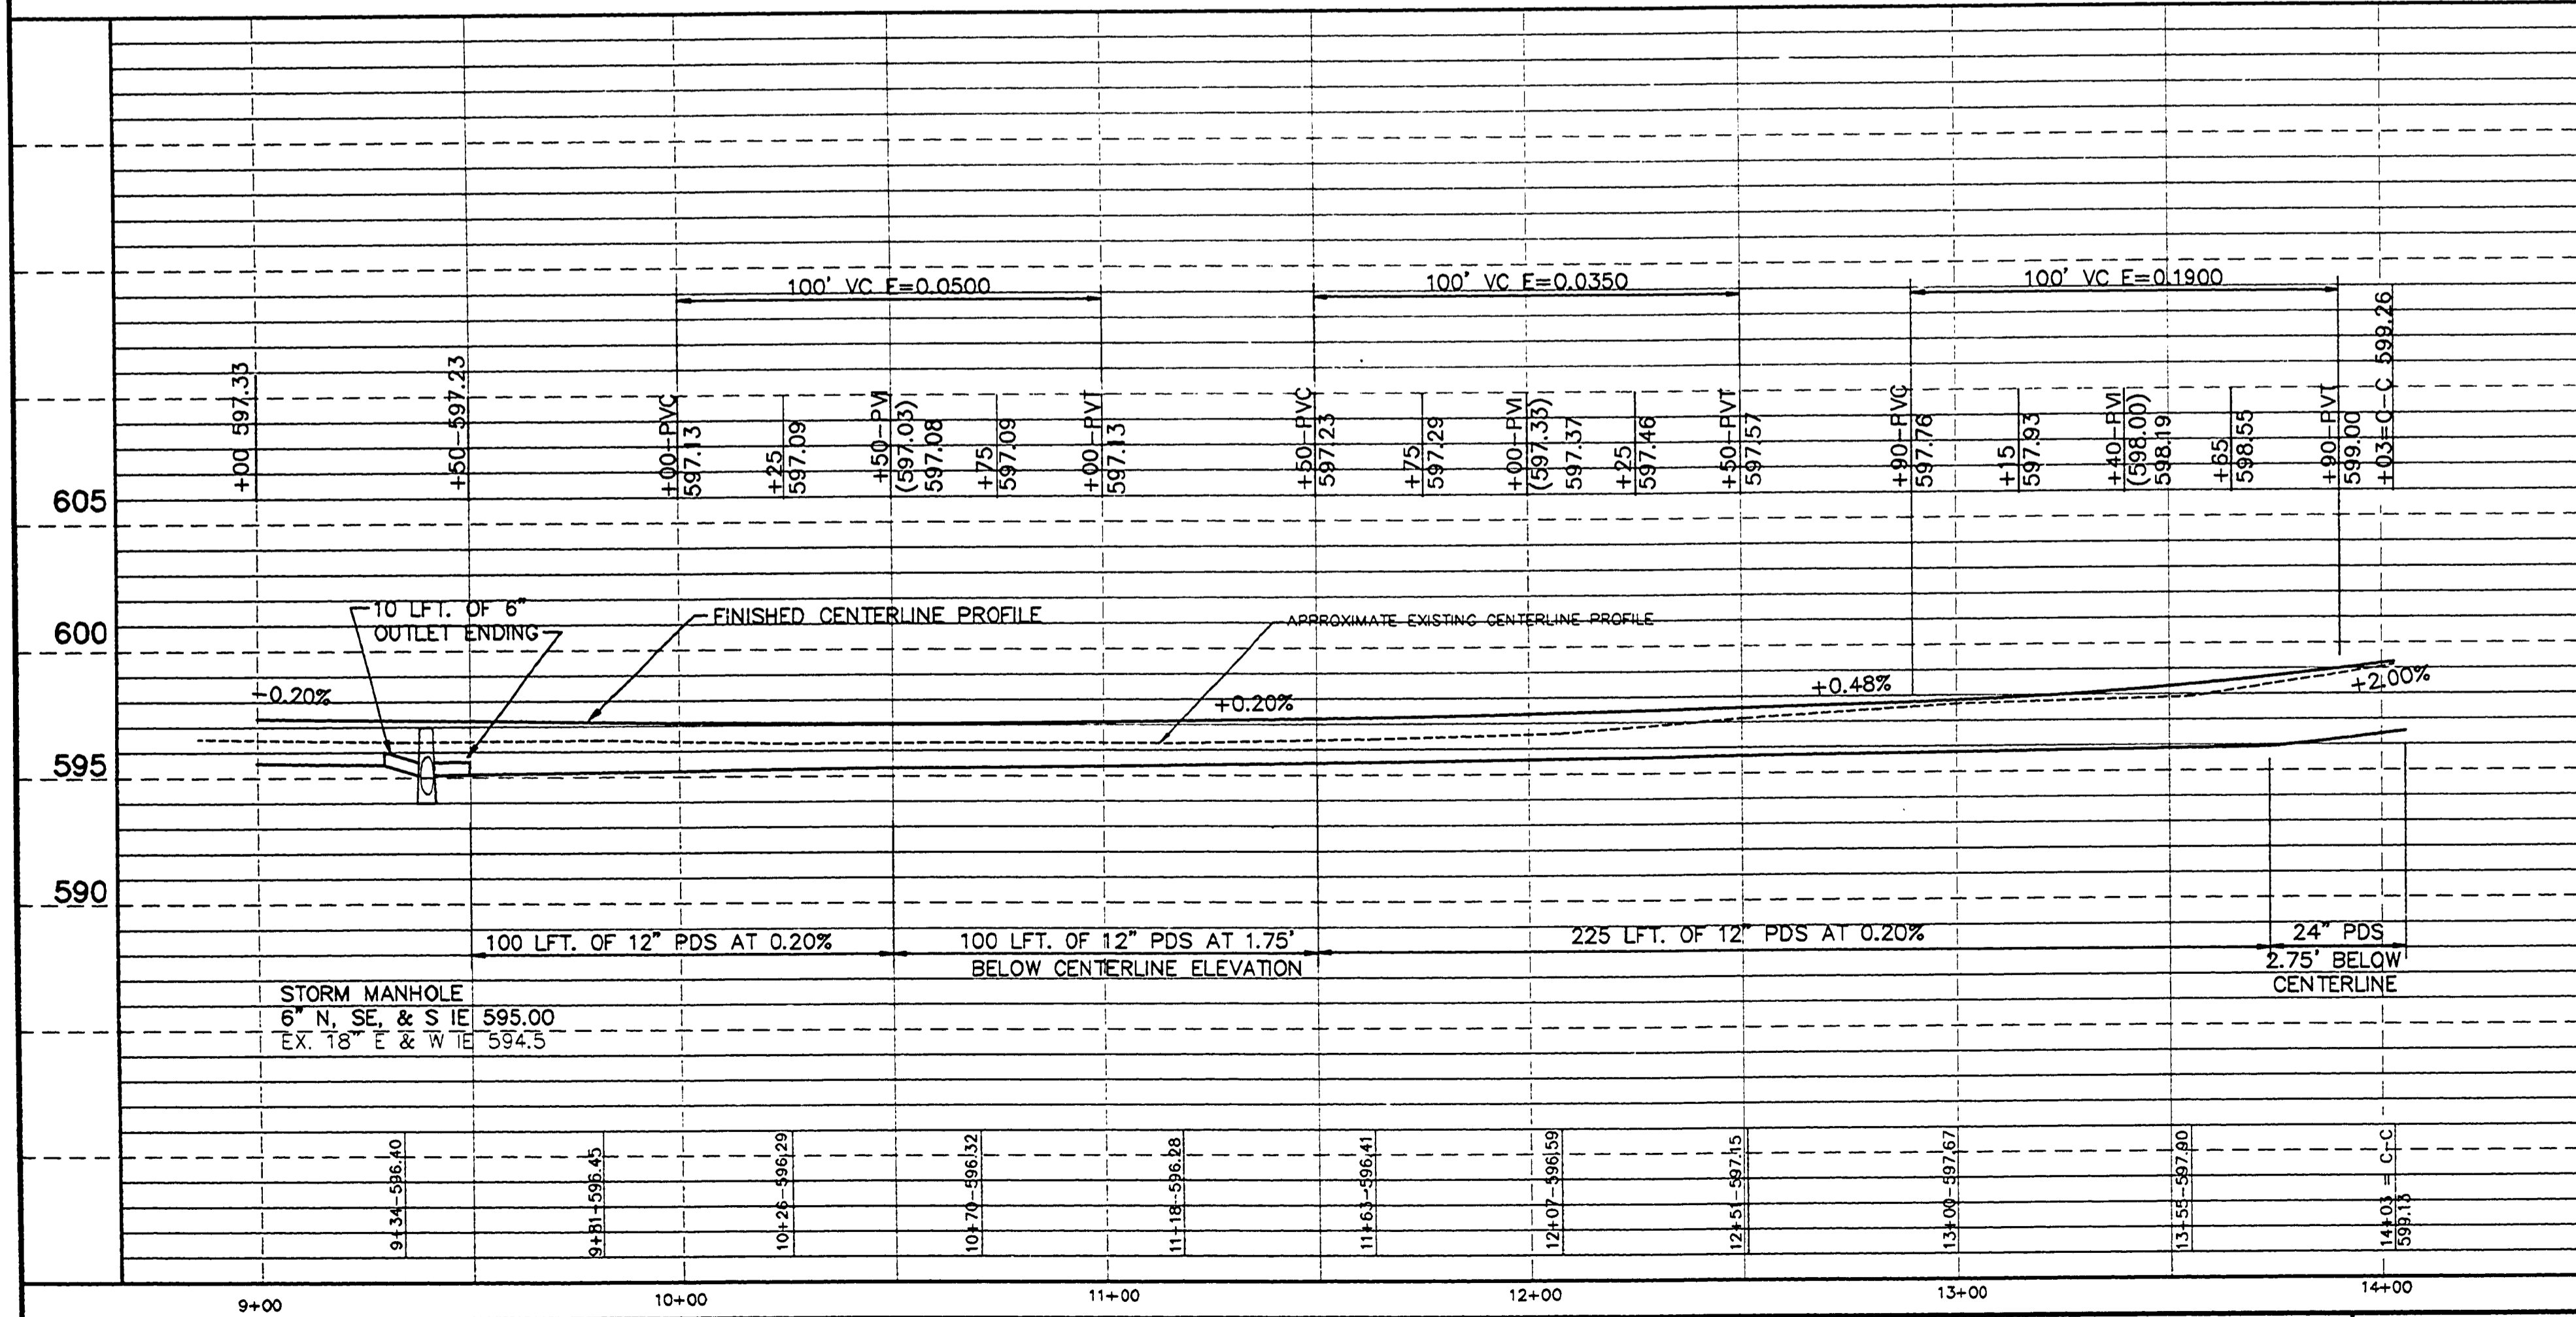

NORTH CAMPGROUND CENTRAL DRIVE PROFILE

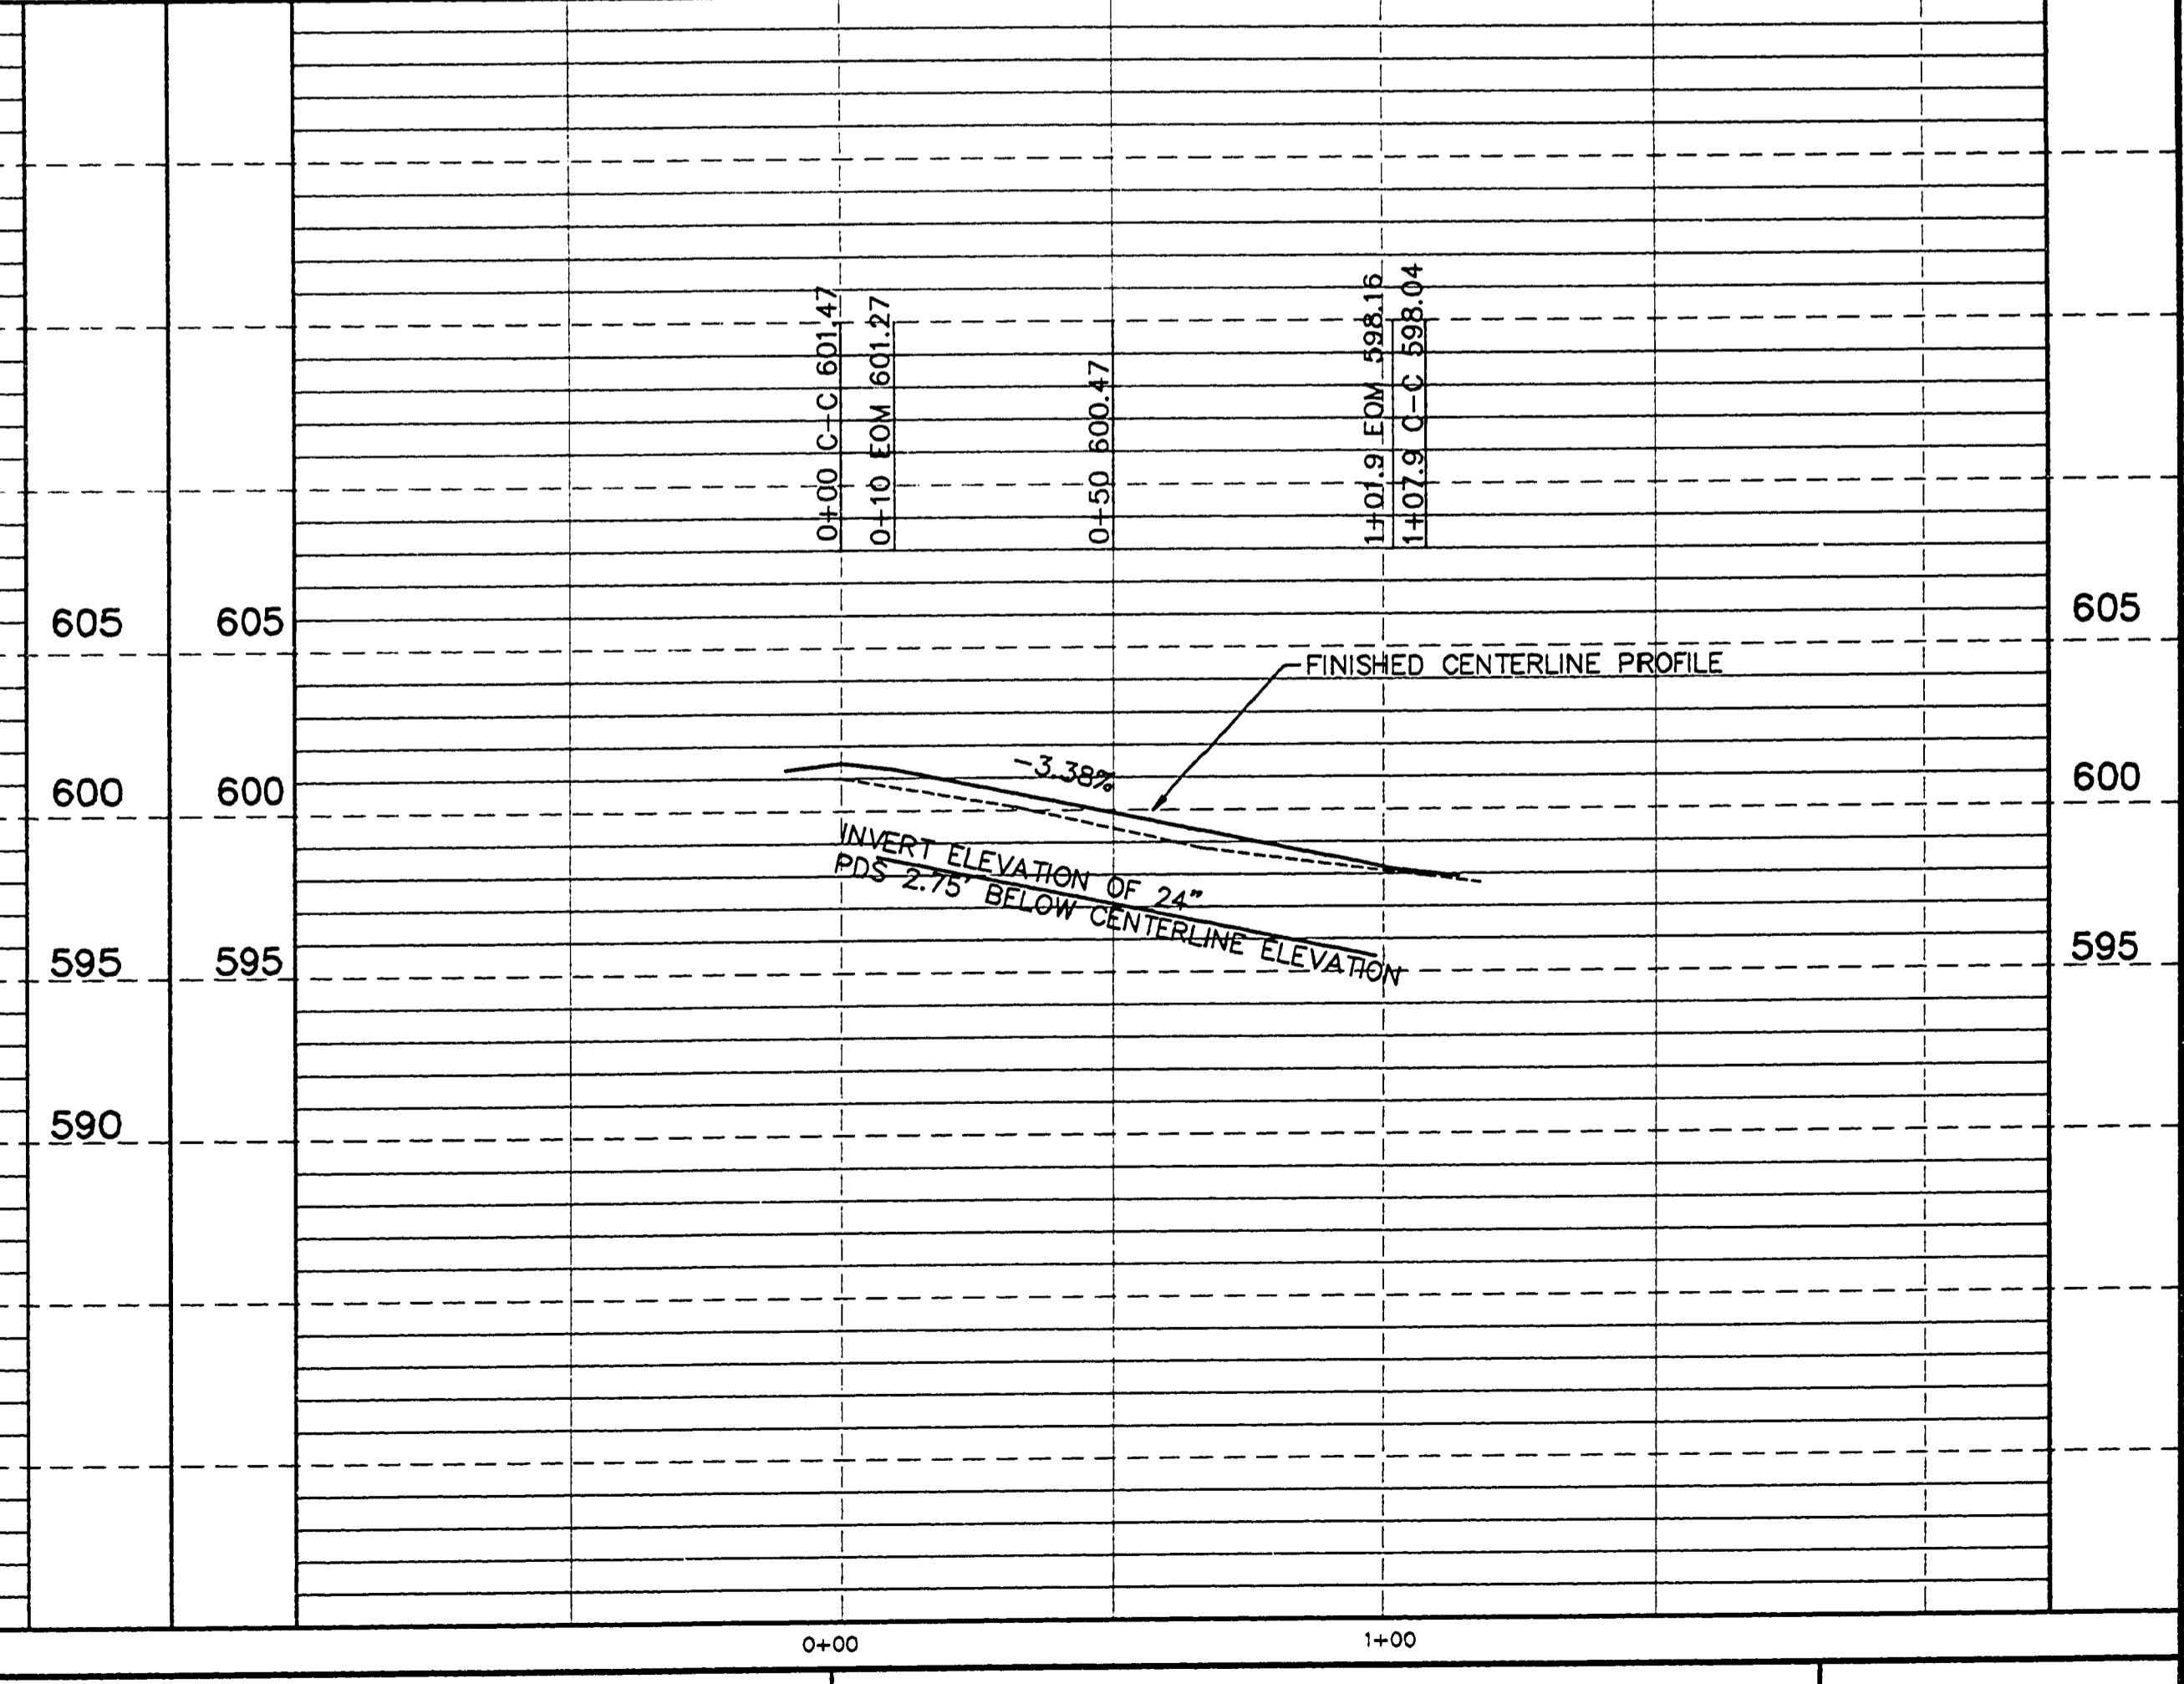

DRN BY: DAF	IDENTIFICATION NO. PROJECT - ALOHA STATE ACCOUNT 607-75-2450-400	ISSUED FOR: PRELIMINARY CONSTRUCTION	DATE: 7-06-92
CHKD BY: GJF		FINAL RECORD	DATE: 7-14-93
APPD BY: GDA			



QUALITY OF LIFE RECREATION BOND
MICHIGAN DEPARTMENT OF NATURAL RESOURCES
PARKS DIVISION - STATE ACCT. NO. 607-75-2450-400

ALOHA STATE PARK
ENTRANCE DRIVE PROFILE STA. 18+00 TO 27+00
NORTH CAMPGROUND DR. PROFILE STA. 9+00 TO 14+03

SCALE: VERT. 1"=5'
PROJ. NO.: 9116503
SHEET 10 OF 17

REFER TO L-118A - SHEET 4 OF 10

L-118

FILE NO.: 1165PR2
PLOT DATE: 7-13-93
UPDATED BY: GJF