




SOUTH CAMPGROUND - SOUTH DRIVES

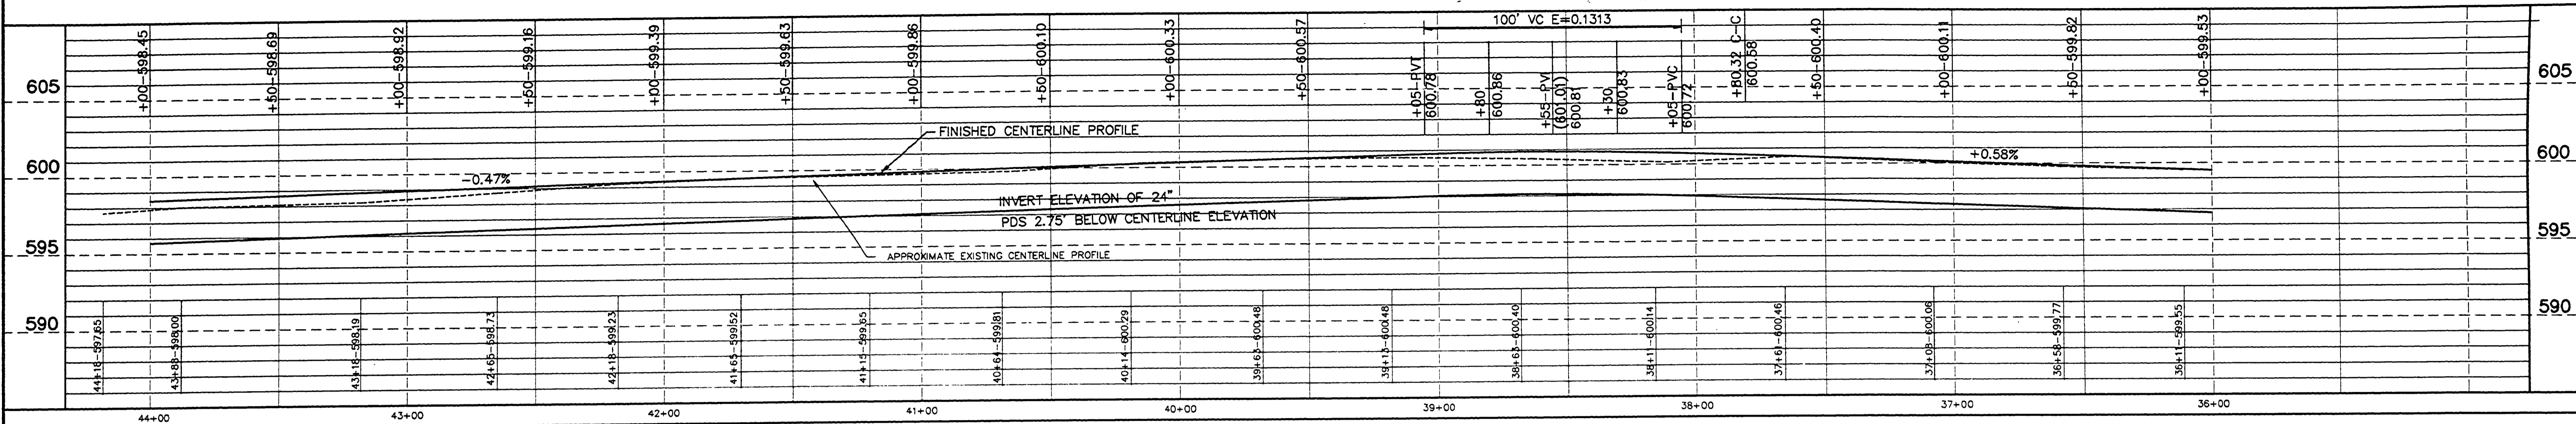


SOUTH CAMPGROUND - SOUTH DRIVES

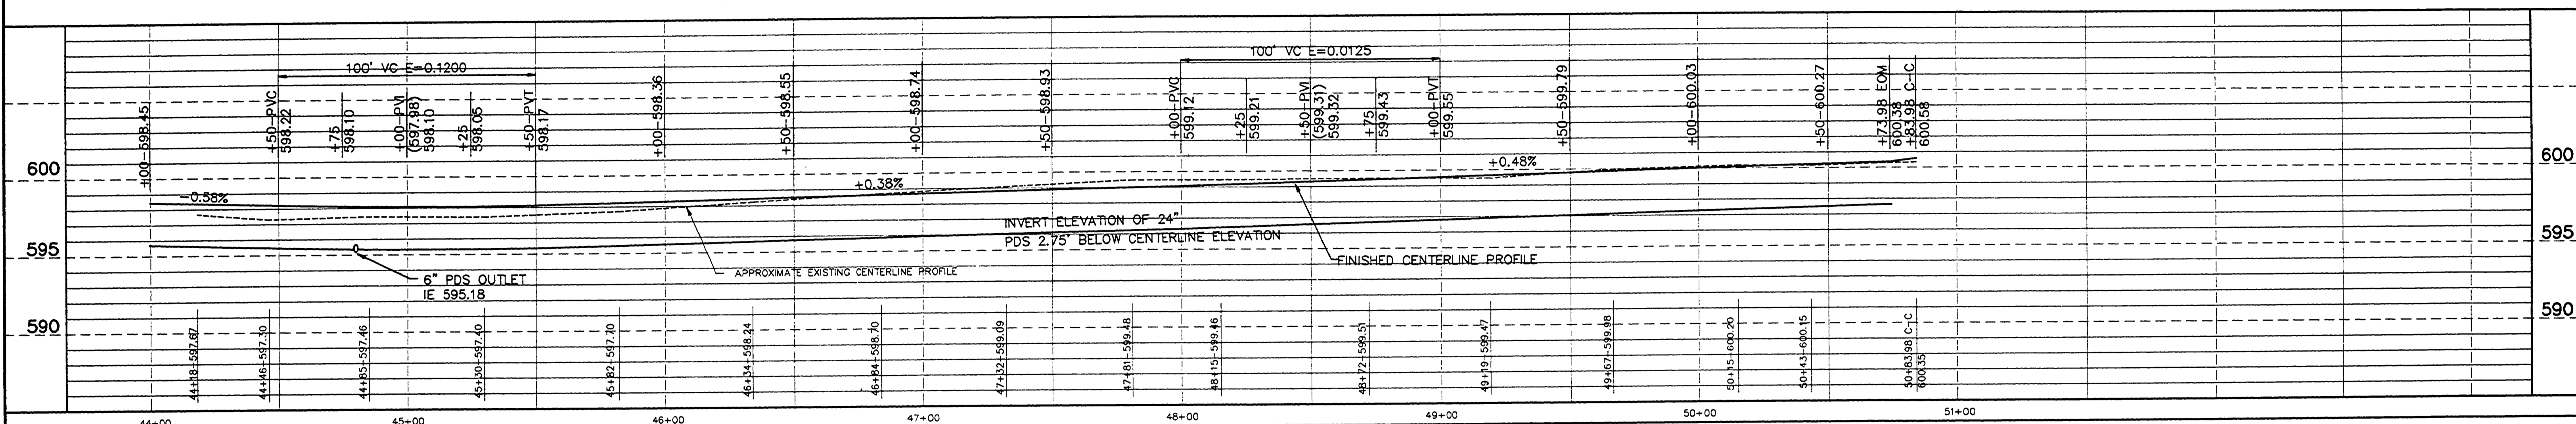

SOUTH CAMPGROUND-NORTH DRIVES

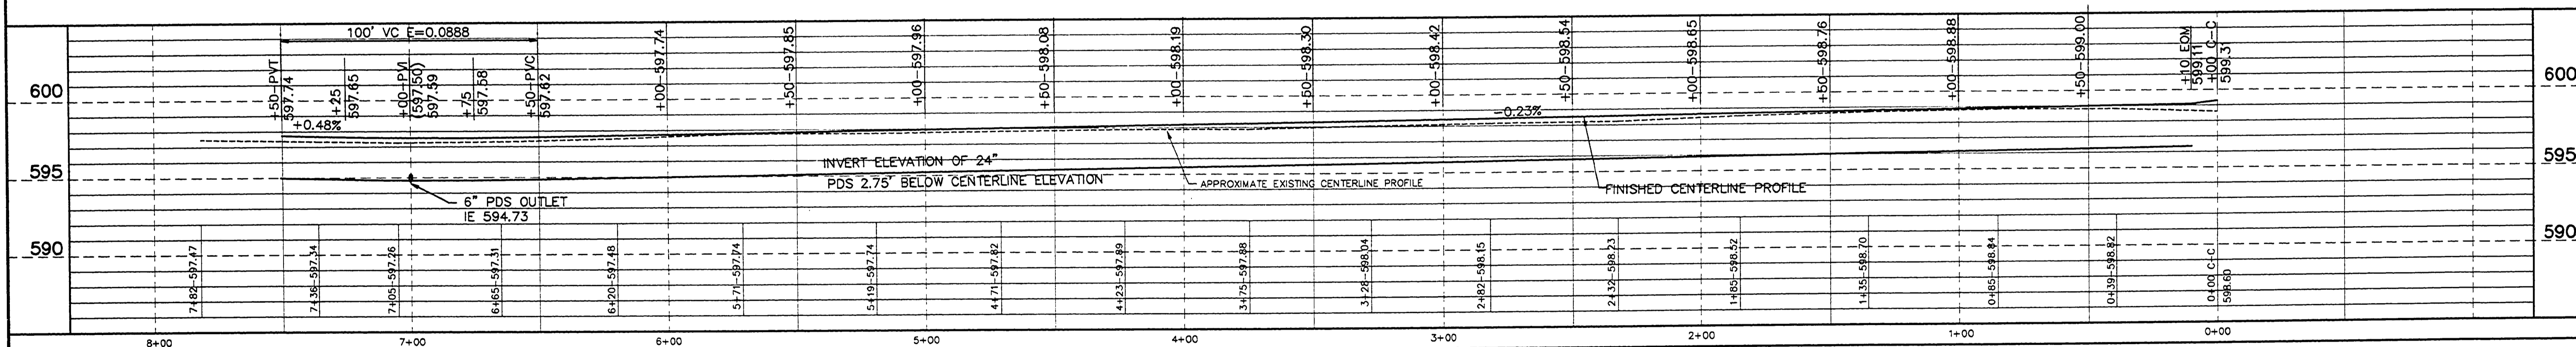


SOUTH CAMPGROUND-NORTH DRIVES

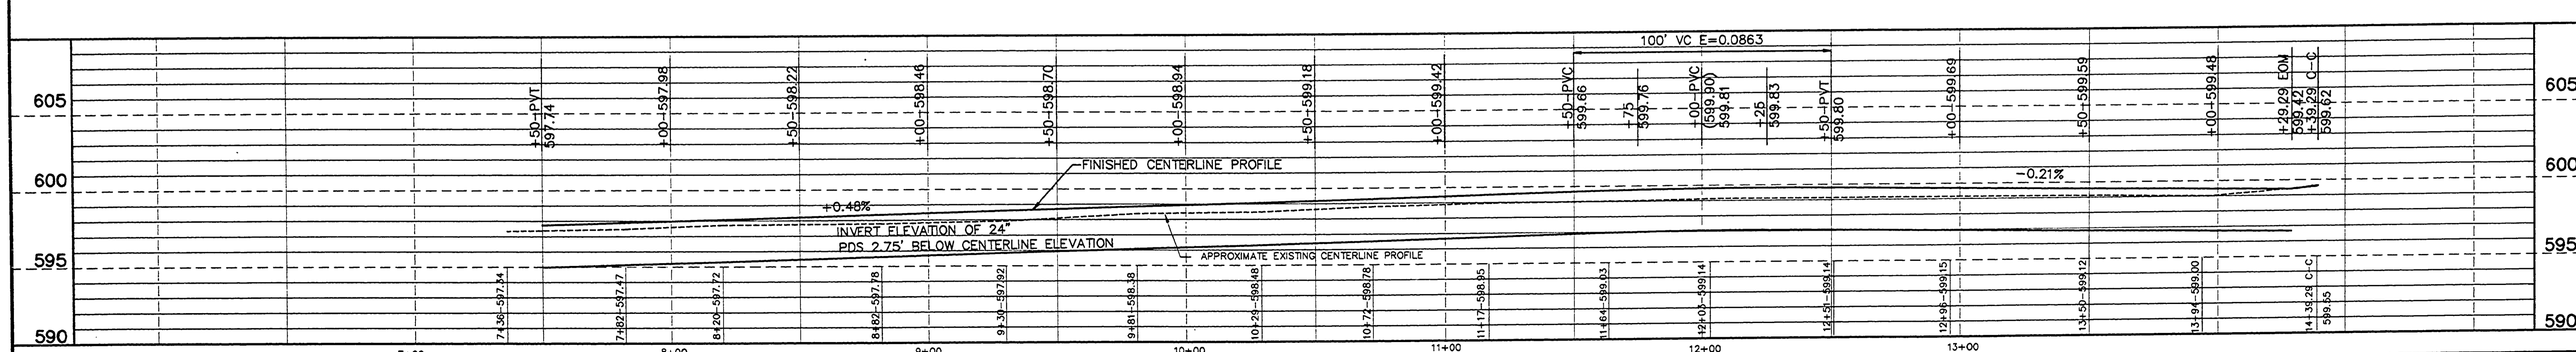

FILE NO: 1165PRS
 PLOT DATE: 7-13-93
 UPDATED BY: GJF

DRN BY: DAF	IDENTIFICATION NO. PROJECT - ALOHA STATE ACCOUNT 607-75-2450-400	ISSUED FOR: PRELIMINARY CONSTRUCTION FINAL RECORD	DATE: 7-06-92 7-14-93
-------------	--	---	-----------------------

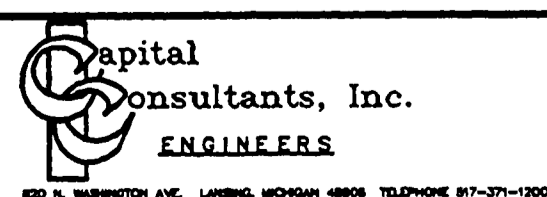

QUALITY OF LIFE RECREATION BOND
 MICHIGAN DEPARTMENT OF NATURAL RESOURCES
 PARKS DIVISION - STATE ACCT. NO. 607-75-2450-400

ALOHA STATE PARK
 SOUTH CAMPGROUND
 DRIVE PROFILES

SCALE: VERT. 1"=5'
 PROJ. NO.: 9116503
 SHEET 17 OF 17

L-118