


BENCH MARK ELEV. 925.20  
PAINTED CIRCLE ON MULLOR  
WOMEN PIT TOILET.  
(CONSULTANT B.M.)


WITNESSES TO POB 2" x 2" ILLUM  
5.94" x 1.83" N.B. SPIKE FLASHER IN S.E. COR.  
3.35" W. 80-2" N.W. COR. MEN PIT TOILET

WITNESSES TO POB 2" x 2" ILLUM  
5.94" x 1.83" N.B. SPIKE FLASHER IN S.E. COR.  
3.35" W. 80-2" N.W. COR. MEN PIT TOILET

BUILD M.H. TO GRADE USING  
BLOCKS IN CEMENT MORTAR  
OR MANHOLE BLOCKS IN  
CEMENT MORTAR.

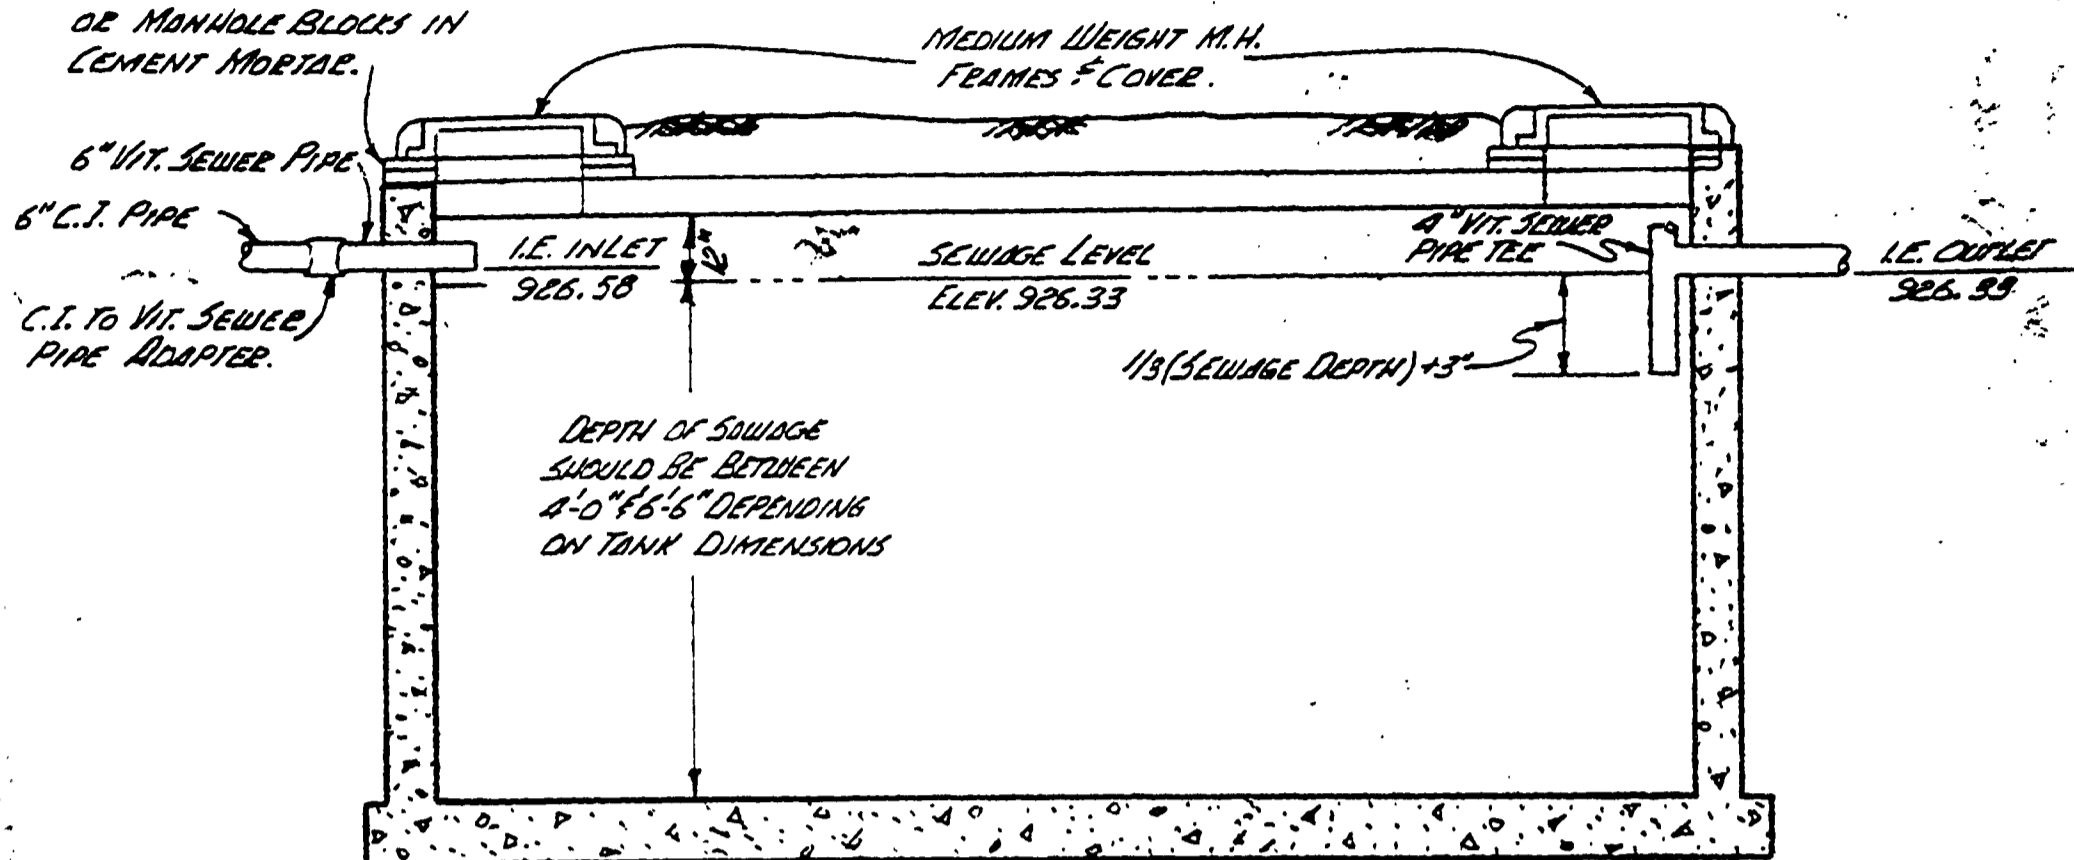


LONGITUDINAL SECTION  
6000 GAL. PRECAST SEPTIC TANK  
(NO SCALE)

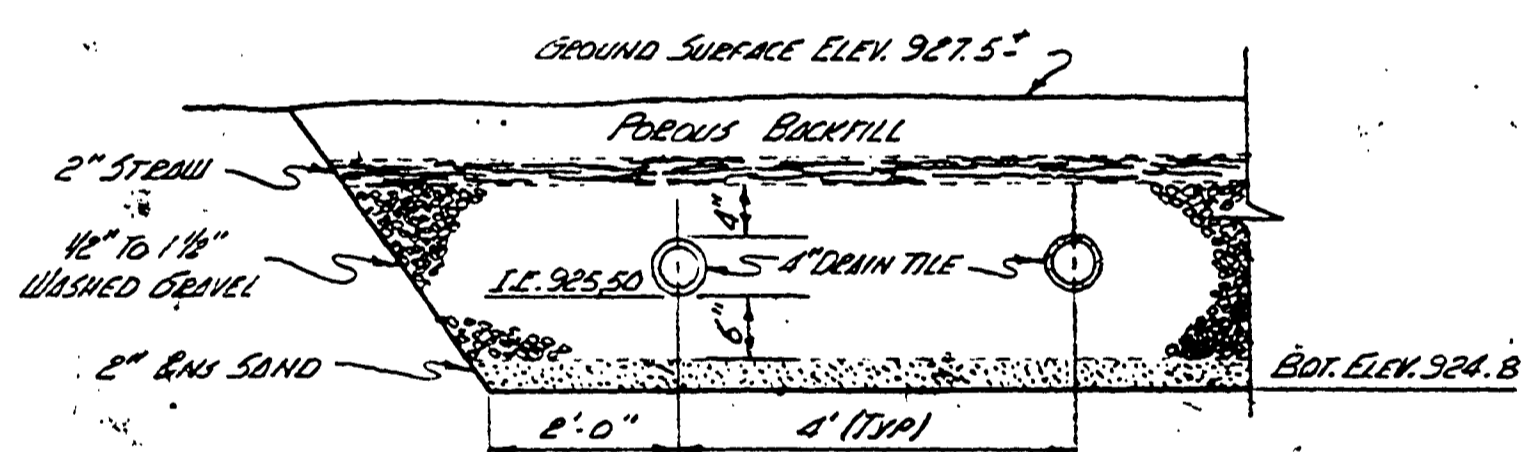

TYPICAL TILE FIELD SECTION

SOIL BORINGS		TEST HOLE #1		TEST HOLE #2		TEST HOLE #3	
(9-21-76)		STA. 0+33 95' LT. ELEV. 929.0		STA. 0+33 35' RT. ELEV. 927.6		STA. 0+33 100' RT. ELEV. 929.4	
0.0' - 0.7'	TOPSOIL	0.0' - 0.7'	SANDY LOAM TOPSOIL	0.0' - 0.3'	TOPSOIL	0.0' - 0.3'	TOPSOIL
0.7' - 1.3'	COARSE SAND & GRAVEL	0.7' - 1.0'	MED. BROWN SAND	0.3' - 1.5'	COARSE SAND	0.3' - 1.5'	COARSE SAND
1.3' - 4.5'	GRAVEL	1.0' - 3.5'	FINE SAND & SILT w/ STONE WELLS QUINNED.	1.5' - 3.0'	DRY MED. SAND	1.5' - 3.0'	DRY MED. SAND
		3.5' - 6.0'	GRAVEL & FINE SAND & SILT	3.0' - 5.0'	BENCH SAND LOAMY LENSES	3.0' - 5.0'	BENCH SAND LOAMY LENSES

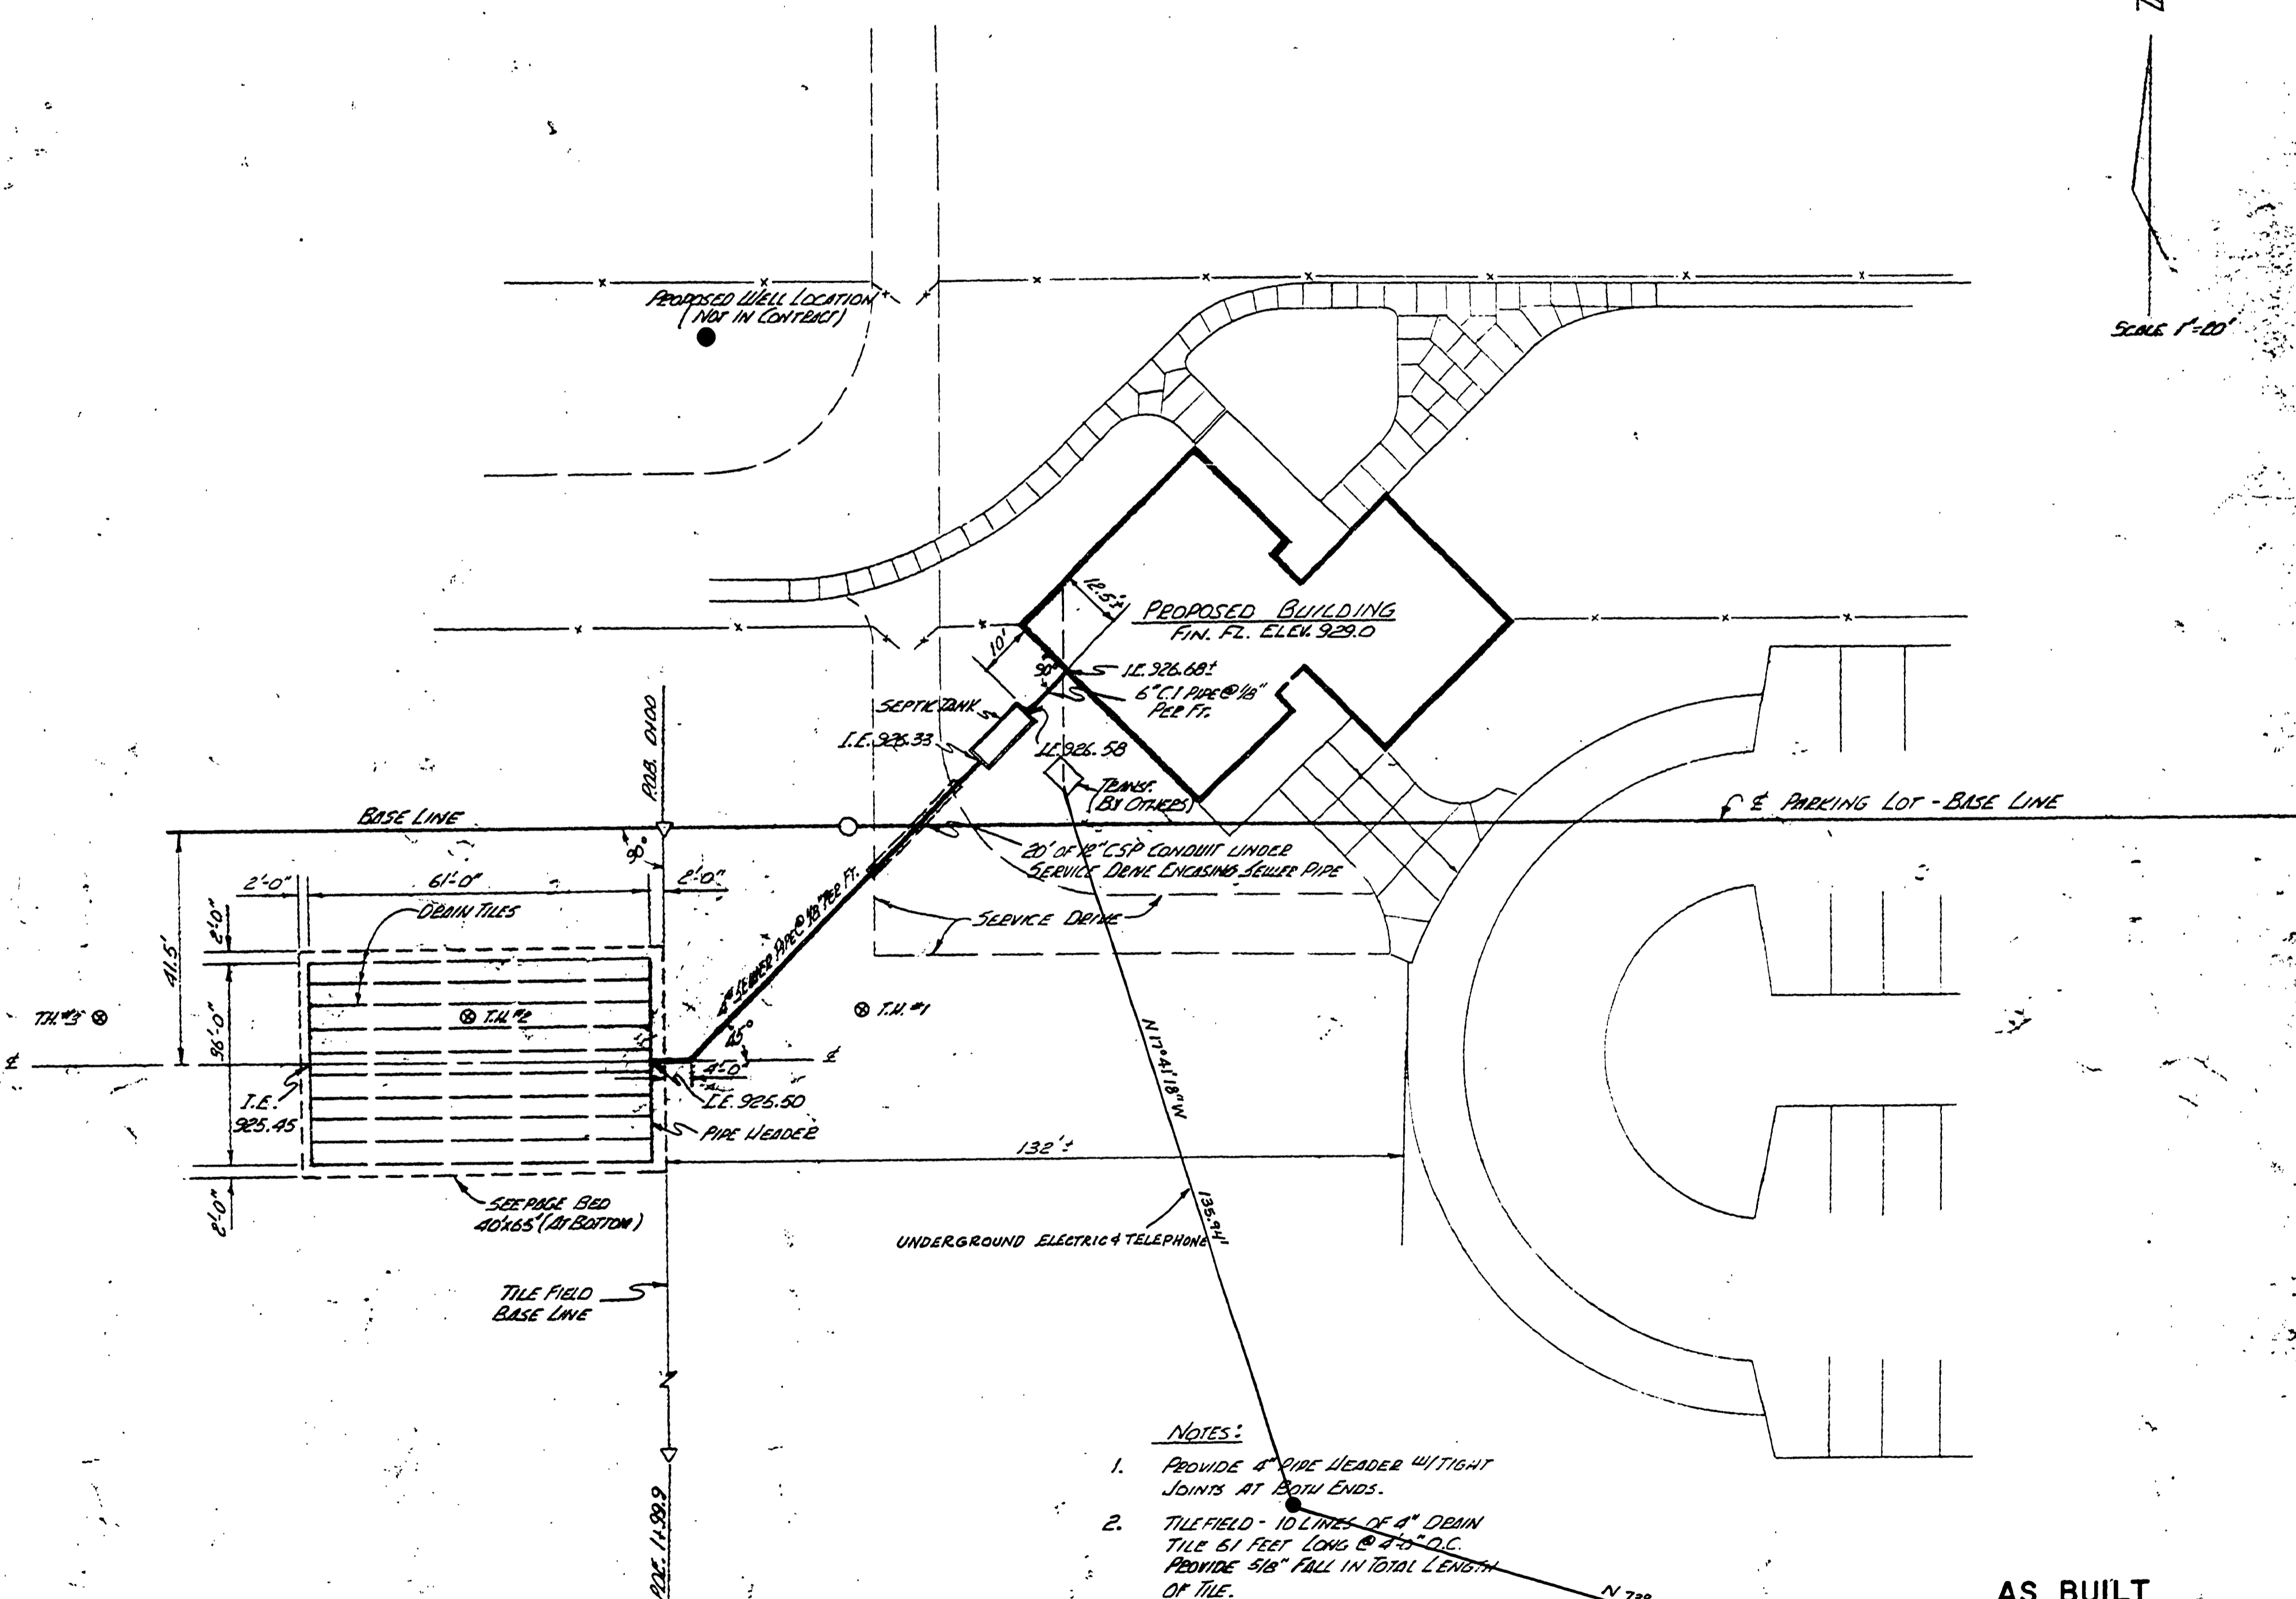

- NOTES:
1. PROVIDE 4\"/>
  2. TILE FIELD - 10 LINES OF 4\"/>

AS BUILT

DESIGNED BY	L. THOMPSON	DATE	9-76	DRAWN BY	J. LEMMON	DATE	12-76	NO.	1	DATE	9-80	BY	D.A.	REVISIONS	AS BUILT	MICHIGAN DEPARTMENT OF NATURAL RESOURCES	SEWAGE SYSTEM DETAILS	BALD MOUNTAIN RECREATION AREA	PROJECT NO.	22-4100	
CHECKED BY	D. GUBALSKI	DATE	12-10-76	CHECKED BY		DATE		NO.	2	DATE		BY		REVISIONS				SCHOOTING RANGE FACILITY	AREA OR PARK	SHEET	15 OF 15