


TYPICAL SECTION PARKING LOT

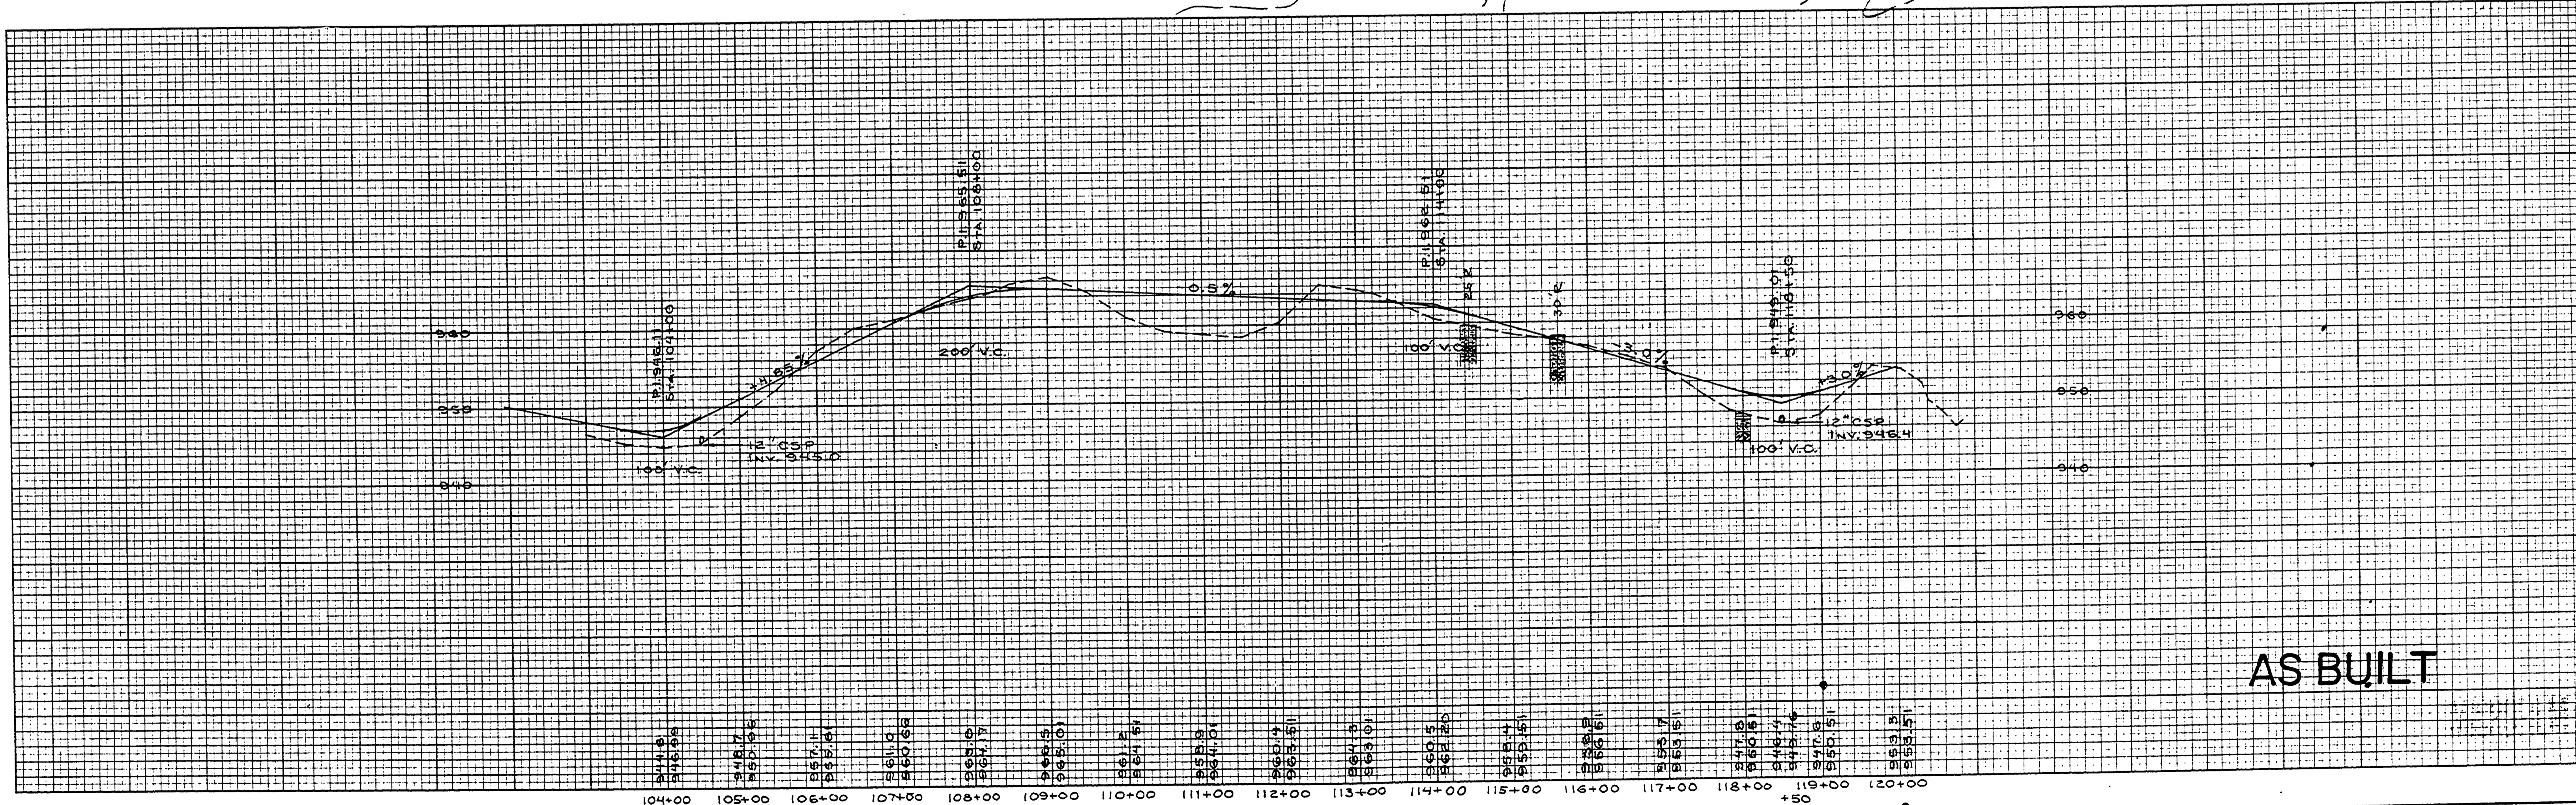

SURVEYED BY	DRAWN BY J. YFMA	MAR. 75	NO. DATE BY	REVISIONS	NO. DATE BY	REVISIONS	MICHIGAN DEPARTMENT OF NATURAL RESOURCES	ENTRANCE ROAD STA. 104+00 TO STA. 120+00	SHEET NO. 4 OF 4	BALD MOUNTAIN RECREATION AREA
DESIGNED BY R. H. MERRILL	CHECKED BY	MAR. 75	1. 6-75 J.Y.	H.C. PARKING ADDED	3.			FOR PROJECT NO. 24-113	SHEET 2 OF 2	PLAN NO. E-105AB
	DATE		2. 8-80 D.B.	AS BUILT WAS 4 OF 4	4.			651 OF 651		