


CONSTRUCTION PLANS FOR SITE AND UTILITY IMPROVEMENTS BAY CITY STATE PARK

QUALITY OF LIFE RECREATION BOND PROGRAM UPPER EAST MICHIGAN REGION

MICHIGAN DEPARTMENT OF NATURAL RESOURCES
PARKS DIVISION

ACCT. NO. 607-75-2450-400

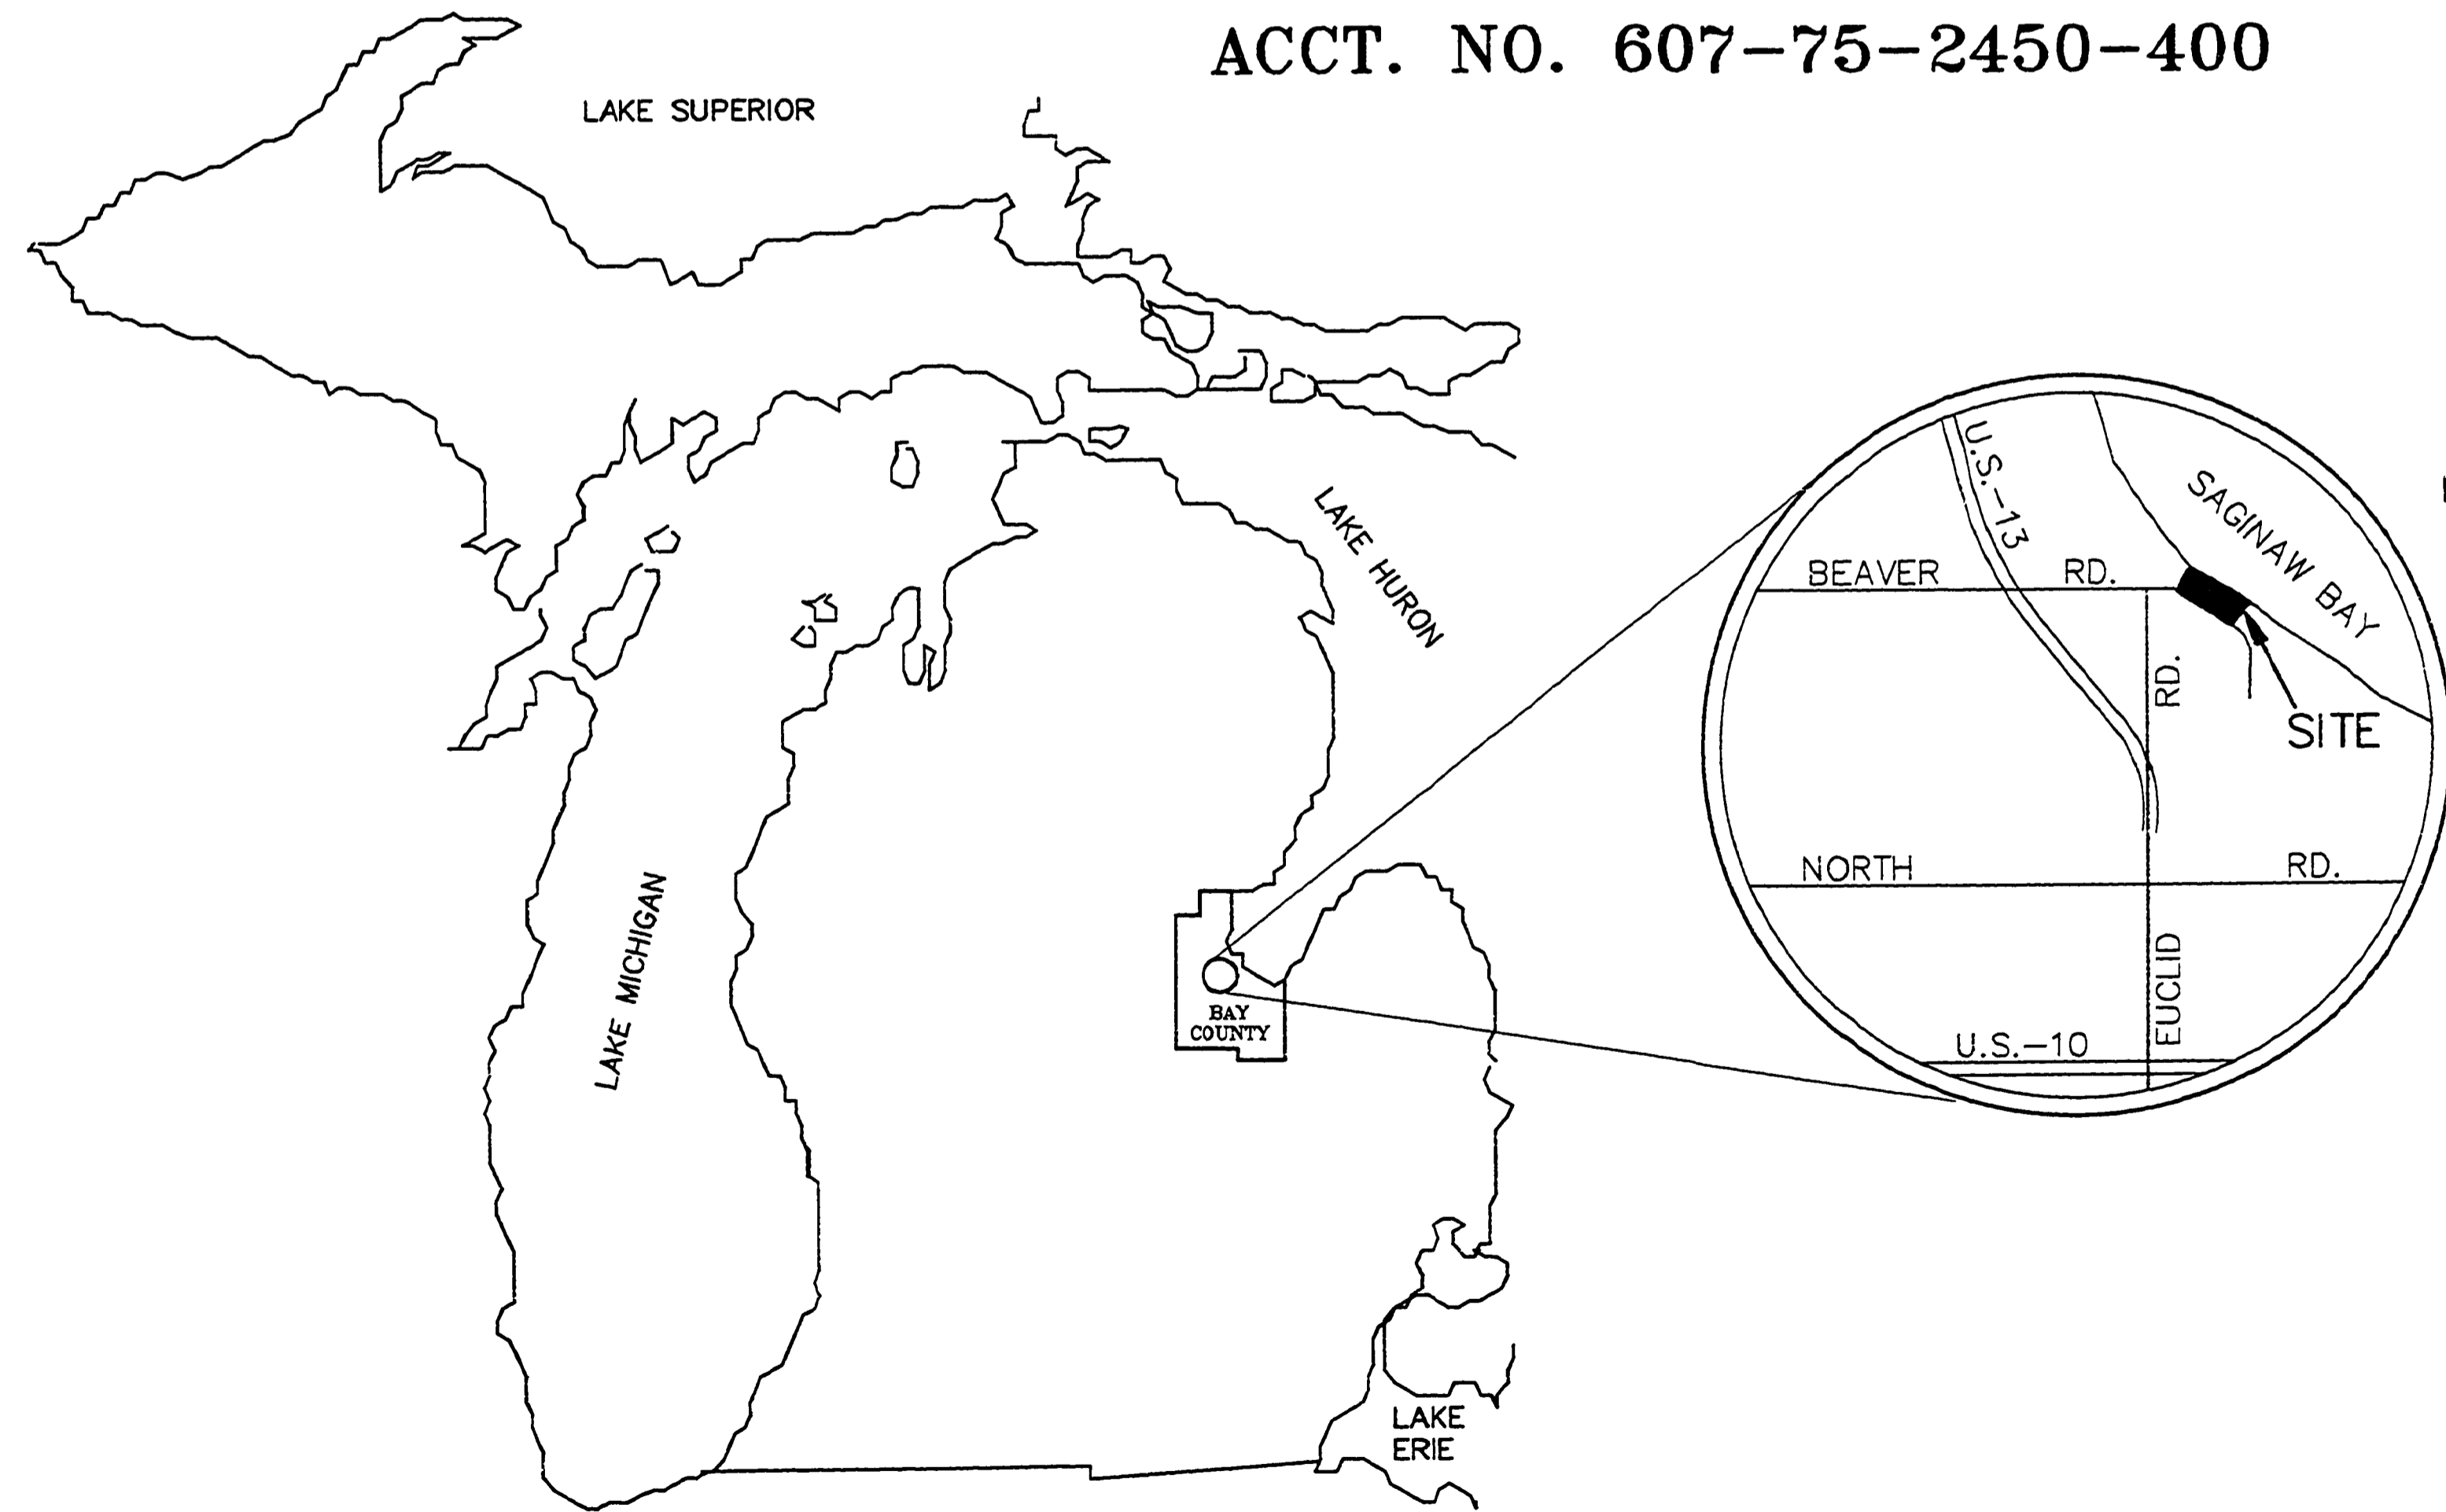

LIST OF DRAWINGS

1. TITLE SHEET
2. TYPICAL CROSS SECTION & GENERAL PLAN NOTES
3. PARKING LOT SITE PLAN
4. PARKING LOT PROFILE
5. PARKING LOT LAYOUT
6. PARKING LOT UTILITIES
7. PARKING LOT CROSS SECTIONS

RECORD DRAWINGS
CONTRACTOR: VALLEY ASPHALT
DATE : 7-16-93



Heartland Construction Co.
PROJECT MANAGER
1800 Michigan National Tower • Lansing, Michigan 48933 • 517-482-6100

Capital Consultants, Inc.
ENGINEERS
1527 W. LANSING ROAD, LANSING, MICHIGAN 48912 TELEPHONE 517-371-1200

STATE OF MICHIGAN
DEPARTMENT OF MANAGEMENT AND BUDGET
Office of Facilities

STATE OF MICHIGAN
DEPARTMENT OF NATURAL RESOURCES
APPROVED BY: *[Signature]*
CHIEF, PARKS DIVISION
DATE: 7/12/93

L 127
SHEET
1 OF 7

AREA 1-C BAY CITY STATE PARK - SITE AND UTILITY IMPROVEMENTS