


VICINITY MAP  
no scale

CONSTRUCTION PLANS FOR  
BAY CITY STATE PARK  
MUNICIPAL SEWER HOOKUP  
PROJECT NO. 24-2491

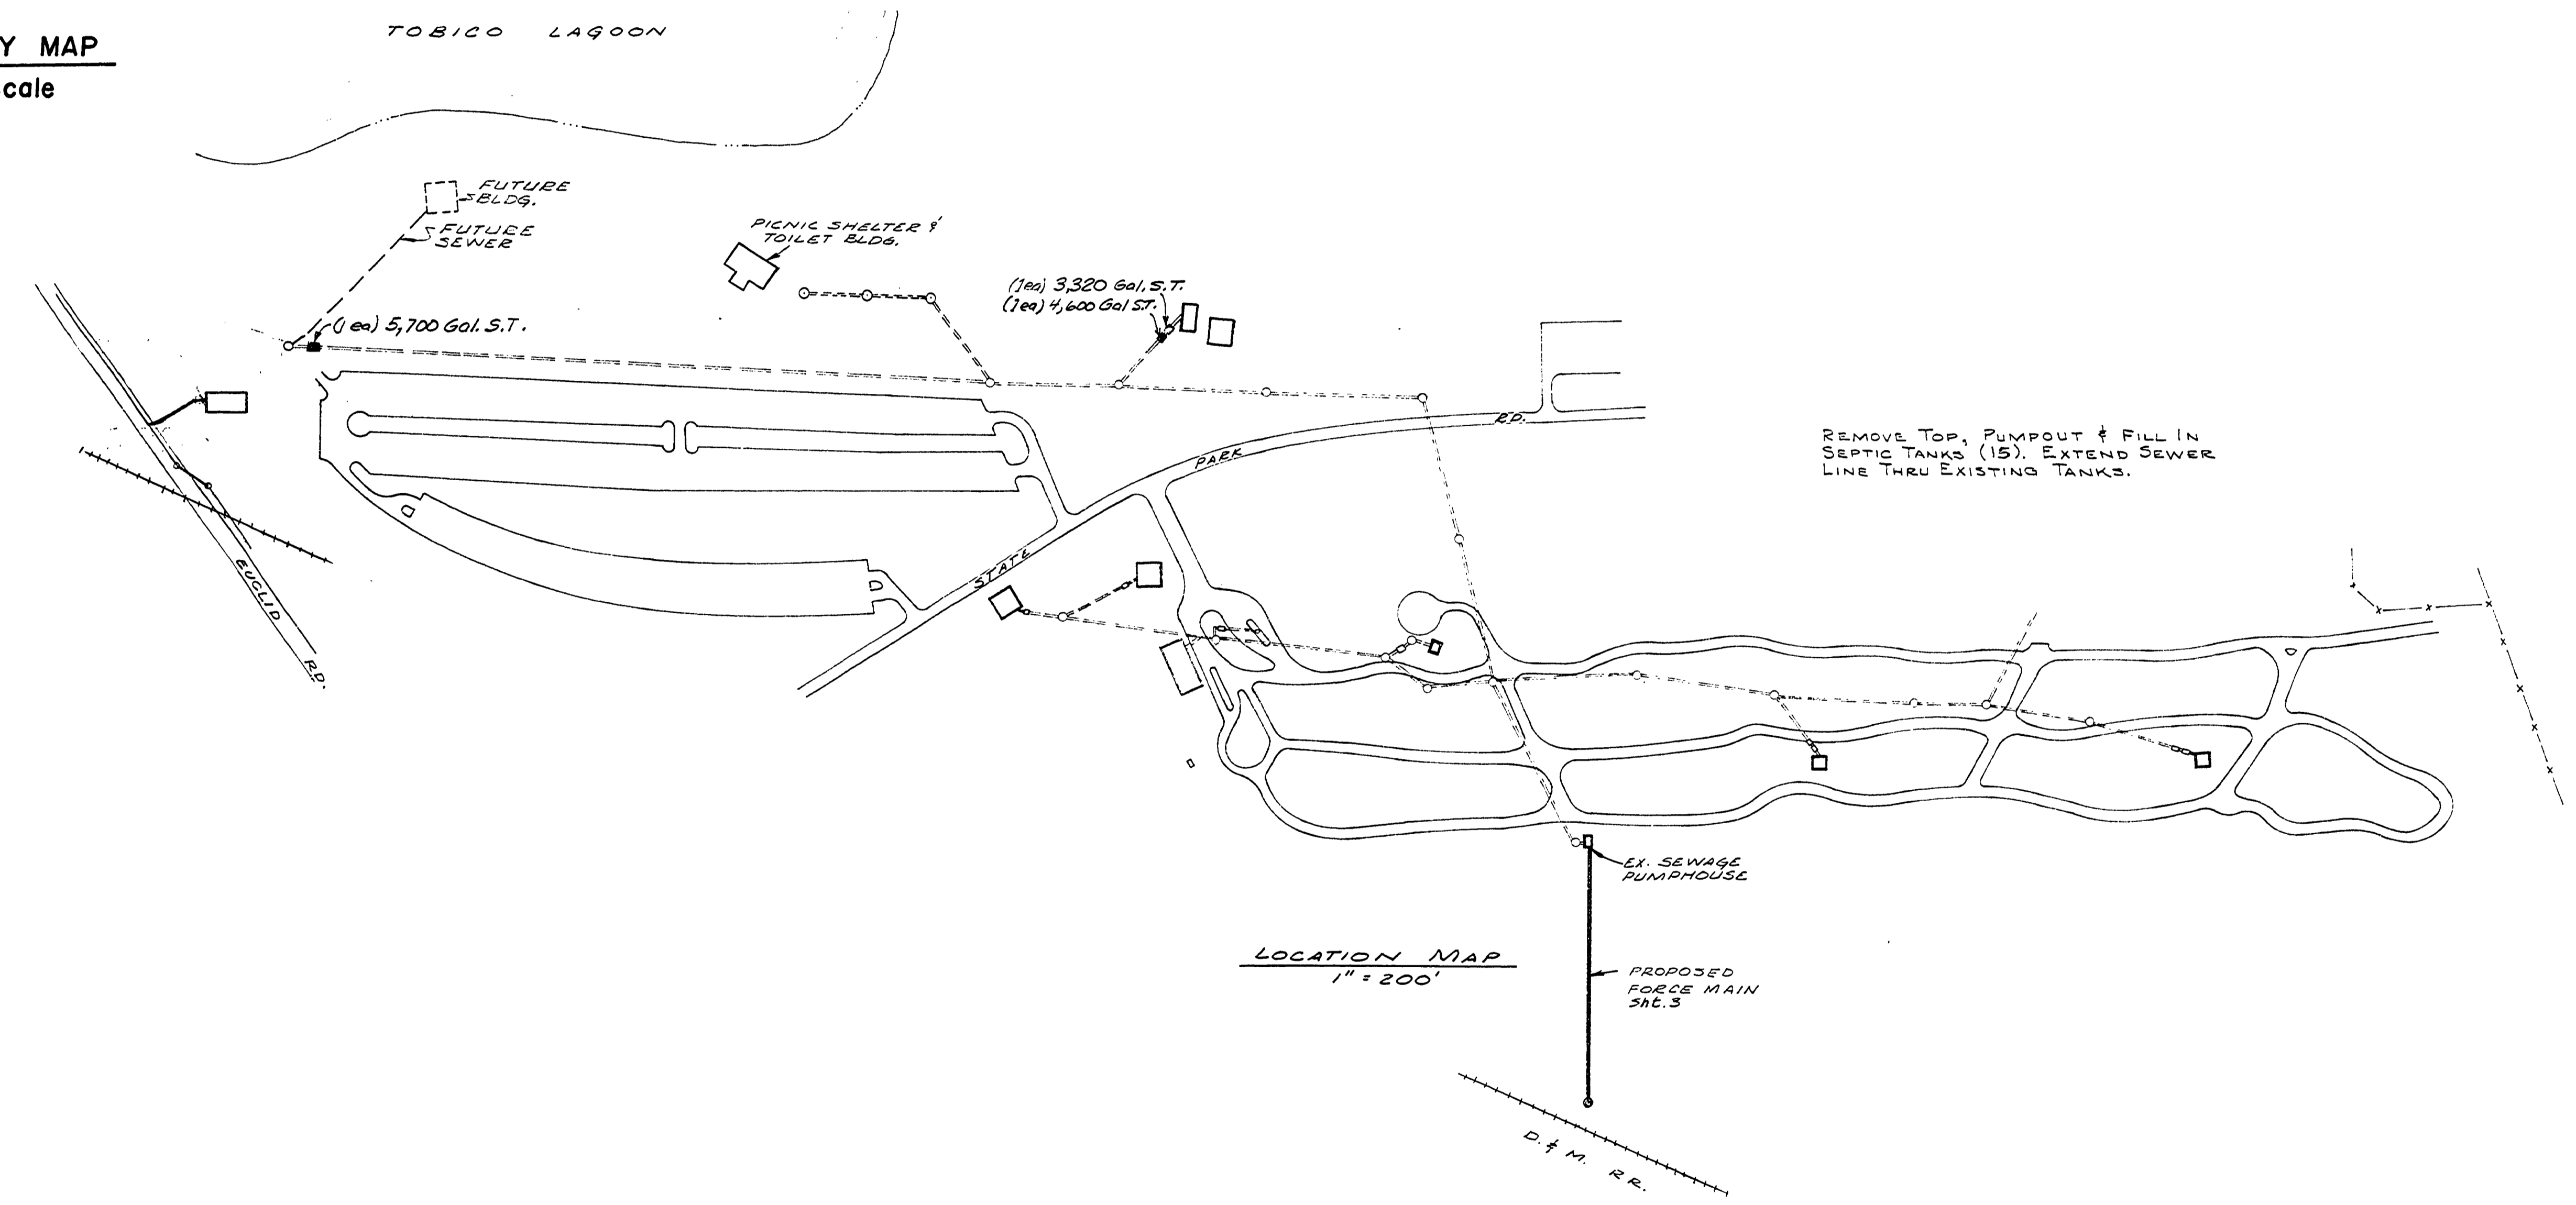

LOCATION MAP  
1" = 200'

REMOVE TOP, PUMPOUT & FILL IN SEPTIC TANKS (15). EXTEND SEWER LINE THRU EXISTING TANKS.

Account No. 110-75-2414-011

BUILDING COMMITTEE APPROVAL	
BY: _____	DATE: _____
RECOMMENDED FOR APPROVAL: _____	
ENGINEERING OR ARCHITECTURAL SUPERVISOR	DATE
RECOMMENDED FOR APPROVAL: _____	DATE
PROGRAM AND PLAN COORDINATOR	DATE
DIVISION / REGION APPROVAL	
BY: _____	DATE: _____
DIVISION CHIEF / REGIONAL MANAGER	DATE
ENGINEERING DIVISION	
APPROVED: _____	DATE: _____
DATE	DATE

SURVEYED BY	DRAWN BY SANDY	10-83	NO.	DATE	BY	REVISIONS	NO.	DATE	BY	REVISIONS
DESIGNED BY MERRILL	CHECKED BY		1.	1-87	Cox	REVISED As BUILT	3.			
			2.				4.			

MICHIGAN  
DEPARTMENT OF NATURAL RESOURCES

COVER SHEET  
SHEET TITLE

BAY CITY STATE PARK  
AREA OR PARK  
MUNICIPAL SEWER HOOKUP  
PROJECT

PROJECT NO. 24-2491  
SHEET 1 OF 4  
PLAN NO. E-120