

ESTIMATED QUANTITIES INDICATED ON THE PLANS ARE INCLUDED FOR GENERAL REFERENCE ONLY. THE CONTRACTOR SHALL USE HIS INDEPENDENT JUDGEMENT AS TO THE ACCURACY OF THE ESTIMATED QUANTITIES STATED ON THE PLANS. THE CONTRACTOR SHALL NOTE THAT NO ADJUSTMENTS TO THE LUMP SUM PRICE WILL BE MADE FOR AS CONSTRUCTED QUANTITIES WHICH ARE IN EXCESS OF THE ESTIMATED QUANTITIES INDICATED ON THE PLANS.

NOTES:


- CONDUCTOR LENGTHS INDICATED ARE APPROXIMATE - FIELD VERIFY.
- CONTRACTOR SHALL ALTERNATE WIRING OF RECEPTACLES IN EACH BRANCH; I.E., ONE OUTLET BOX SHALL HAVE 30A RECEPTACLE WIRED TO PHASE A AND 20A RECEPTACLE WIRED TO PHASE B, AND THE NEXT SHALL HAVE 30A RECEPTACLE WIRED TO PHASE B AND 20A RECEPTACLE WIRED TO PHASE A AND SO ON TO THE END OF THE BRANCH.
- CONTRACTOR SHALL REMOVE EXISTING OUTLET BOXES AND DISTRIBUTION PANELS FROM THE EXISTING CAMPGROUND AND ABANDON UNDERGROUND CONDUCTOR IN PLACE. CONTRACTOR SHALL BE RESPONSIBLE FOR DISPOSAL OF ALL EXISTING ELECTRICAL EQUIPMENT WHICH IS TO BE REMOVED.
- CONTRACTOR SHALL COORDINATE OUTLET BOX LOCATIONS WITH THE MICHIGAN DEPARTMENT OF LABOR ELECTRICAL INSPECTOR AND THE PARK MANAGER PRIOR TO START OF CONSTRUCTION.
- ELECTRICAL SERVICE TO LOWER CAMPGROUND TOILET BUILDING SHALL BE 20' - 3 #3 + 1 #8 GRND.
- LIFT STATION TO BE BUILT BY OTHERS. CONTRACTOR SHALL PROVIDE 2" CONDUIT FOR SERVICE TO LIFT STATION - STUB OUT 5' FROM ENTRANCE RACK AND CAP. CONDUIT SHALL BE RSC OR PVC.

(AS-BUILT NOTES)

○ - 3" SCH. 80 UNDER ROAD
 MARKED W/ ⊕ FOR CONDUIT AND
 CONDUCTOR LOCATION. APPROX.
 3'-4" OFF ROAD EDGE.

LEGEND

- ▲ NEW ENTRANCE RACK
- SITE OUTLET BOX
- ⊕ JUNCTION POST
- ELECTRIC LINES

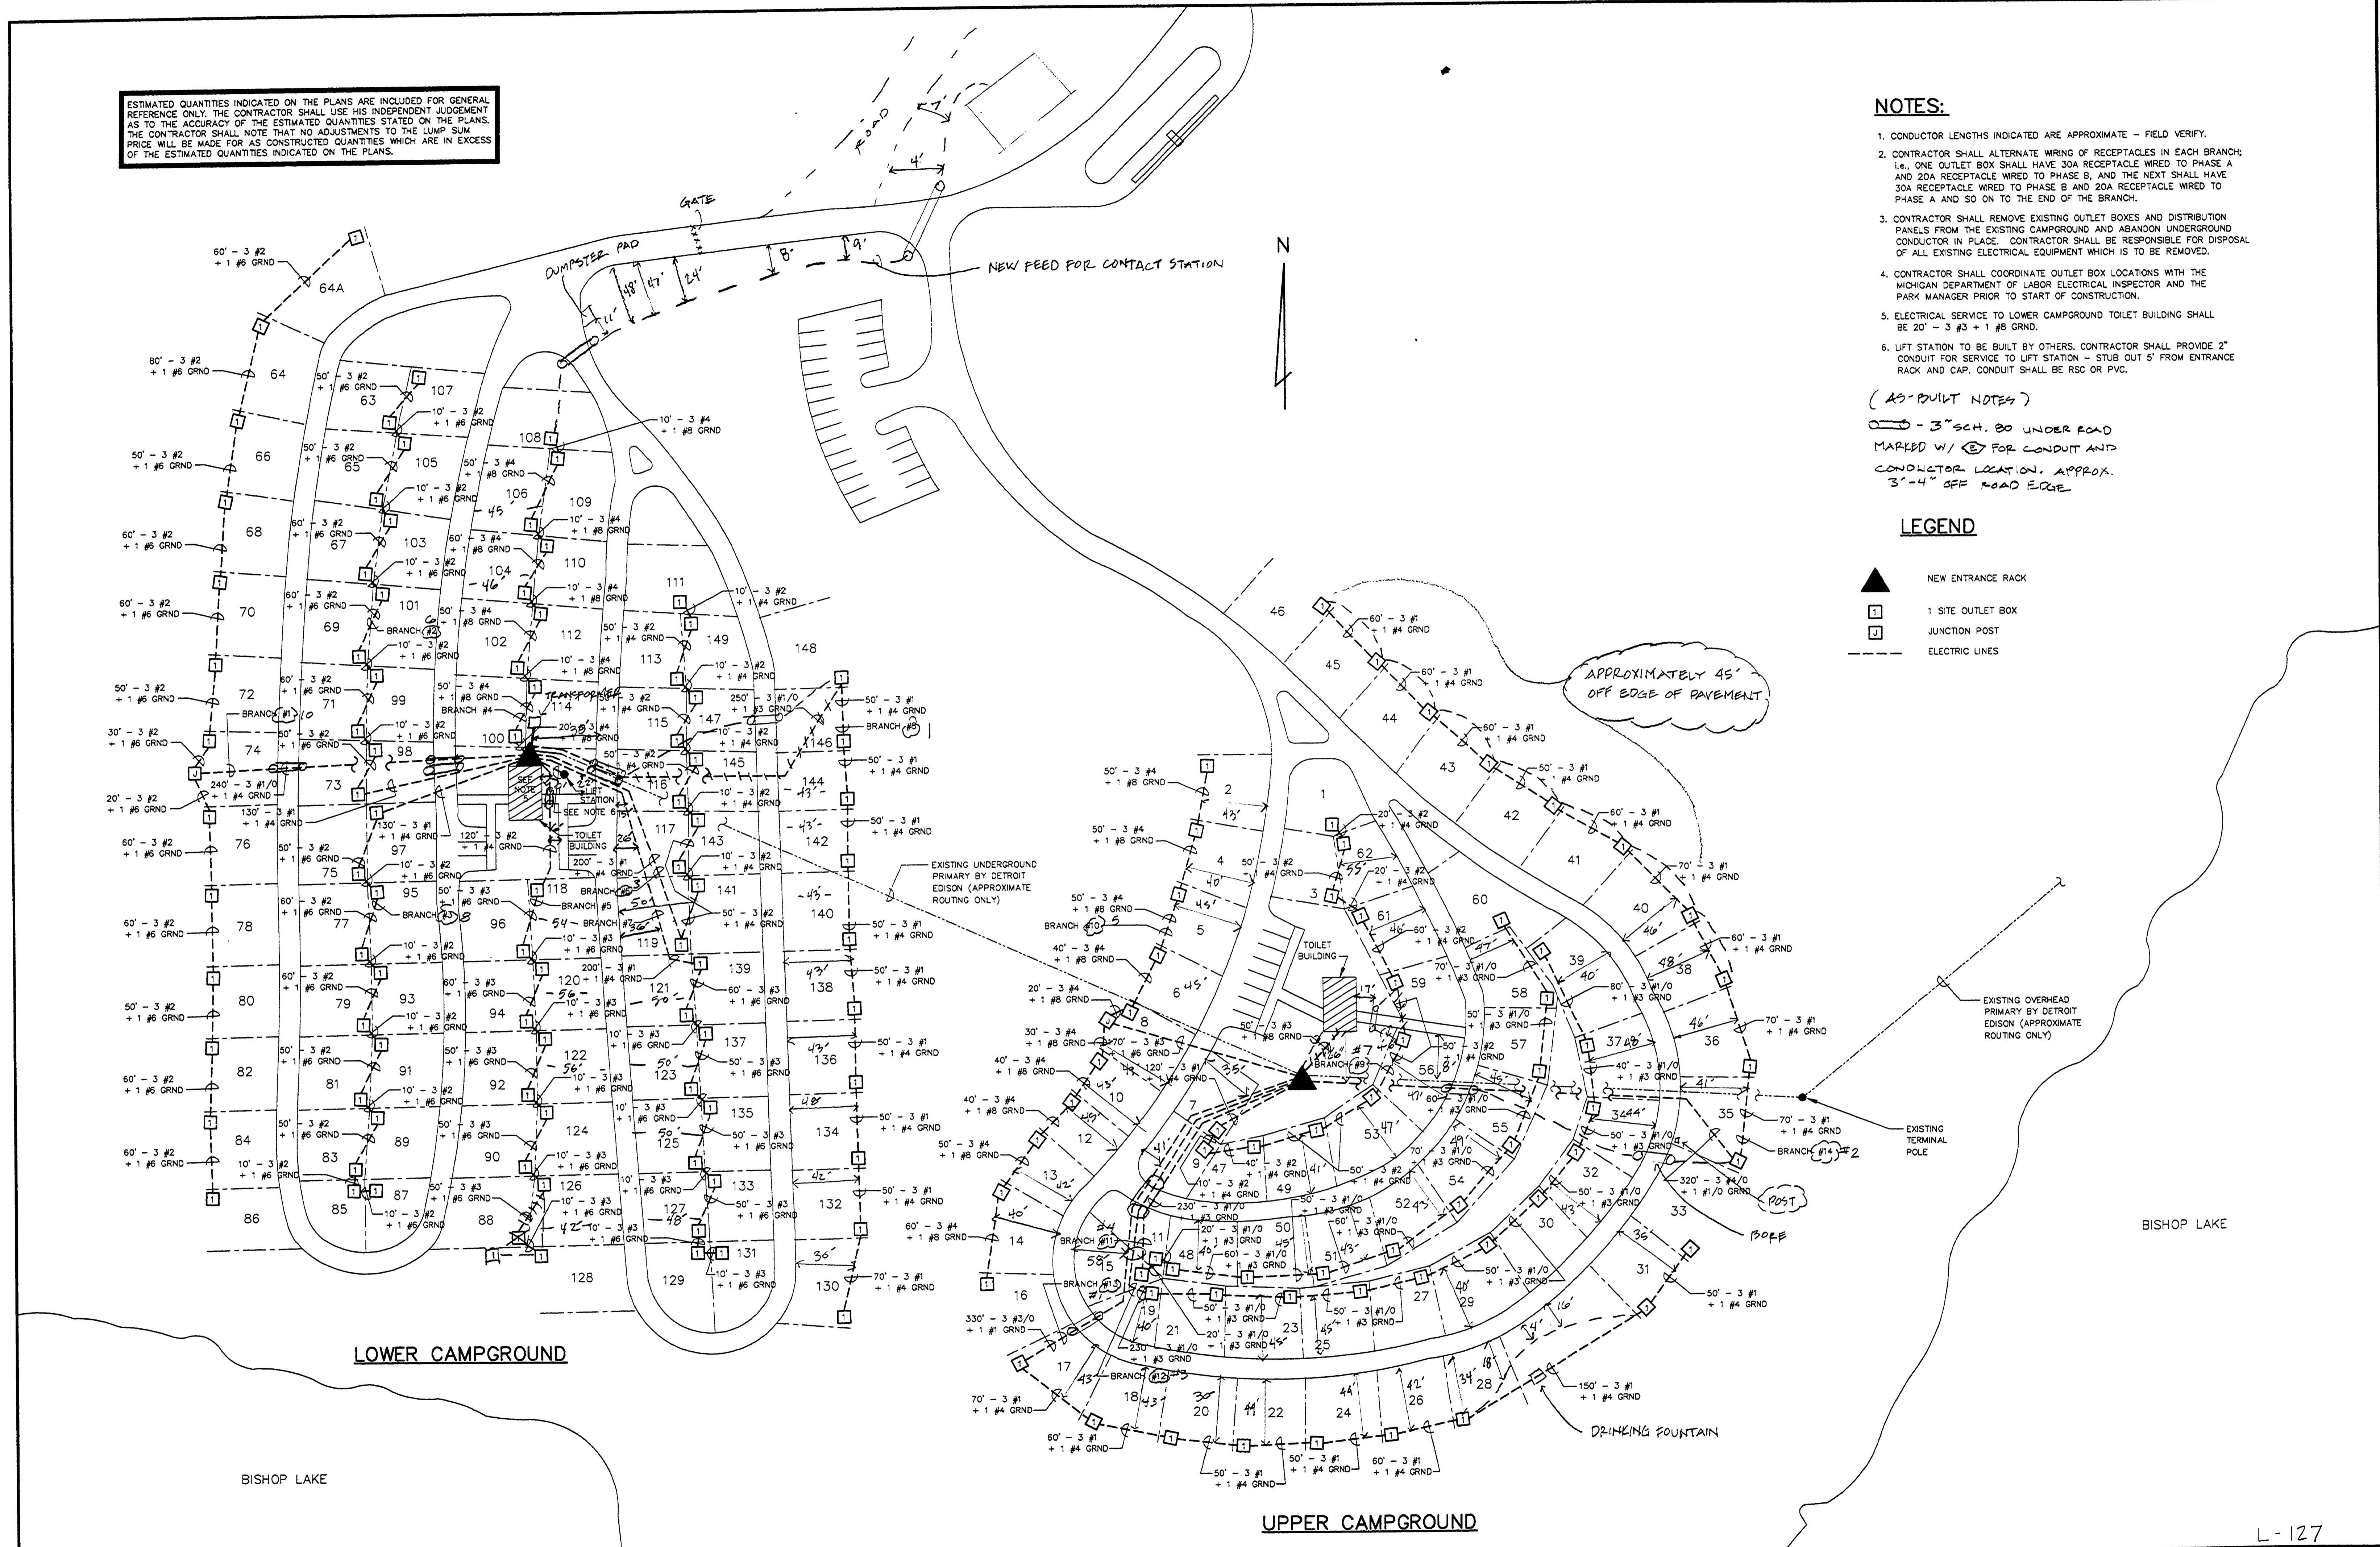

10-16-91
 1180EL1

DRN BY:	BJH
DESIGN BY:	BJH
CHKD BY:	MJJ
APPD BY:	GDA

Capital Consultants, Inc. ENGINEERS	
STATE OF MICHIGAN DEPARTMENT OF MANAGEMENT AND BUDGET Office of Facilities	
QUALITY OF LIFE RECREATION BOND MICHIGAN DEPARTMENT OF NATURAL RESOURCES PARKS DIVISION - STATE ACCT. NO. 607-75-2450-400	
BRIGHTON RECREATION AREA BISHOP LAKE CAMPGROUND ELECTRICAL PLAN	
SCALE: 1"=50' PROJ. NO.: 91180 SHEET 2 OF 3	

L-127