


CONSTRUCTION PLANS
FOR
BRIGHTON RECREATION AREA
BISHOP LAKE PUMP STATION IMPROVEMENTS

QUALITY OF LIFE RECREATION BOND PROGRAM
SOUTHEAST LOWER MICHIGAN REGION

MICHIGAN DEPARTMENT OF NATURAL RESOURCES
PARKS DIVISION
ACCT. NO. 607-75-2450-400

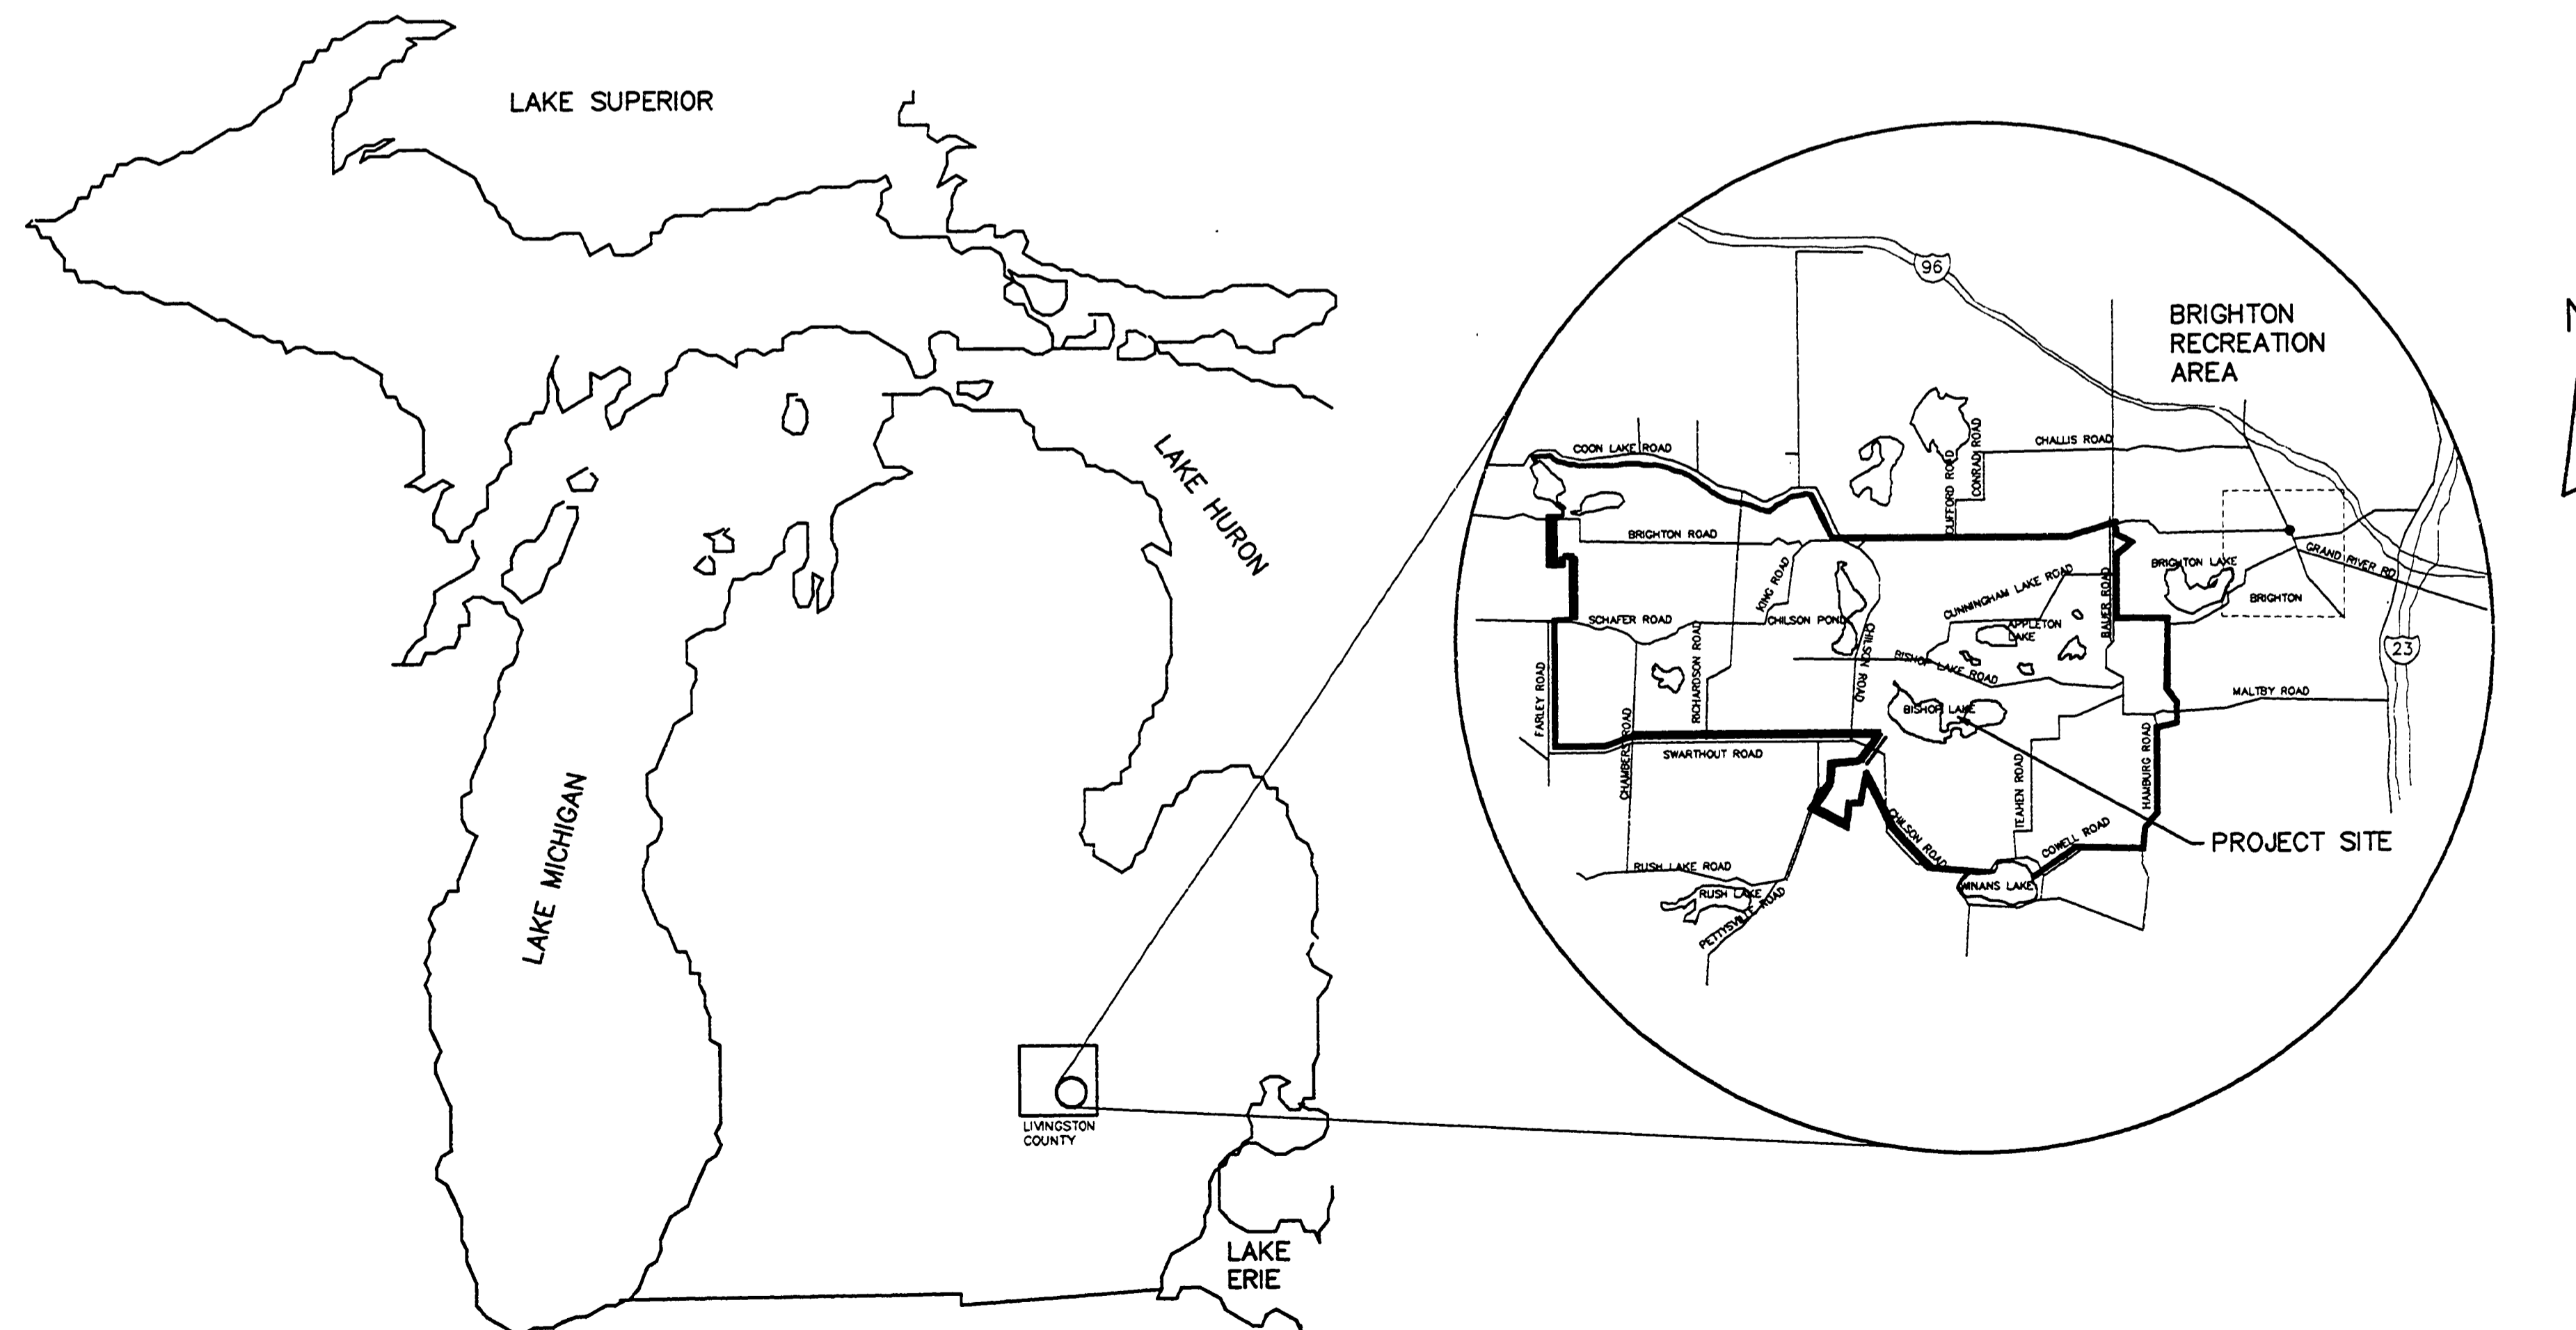

LIST OF DRAWINGS

AS-BUILT DRAWINGS

1. TITLE SHEET
2. BISHOP LAKE CAMPGROUND - EXISTING PUMP STATION
3. BISHOP LAKE CAMPGROUND - PROPOSED PUMP STATION
4. BISHOP LAKE CAMPGROUND - PUMP STATION ELECTRICAL



FILE NO. 100000
PLOT DATE: 10-18-91
UPDATED BY: GJF

Heartland
Professional Construction Services, Inc.
1800 Michigan National Tower • Lansing, Michigan 48933 • 517-482-6100

Capital Consultants, Inc.
ENGINEERS
800 N. WASHINGTON AVE. LANSING, MICHIGAN 48906 TELEPHONE 517-371-1500

STATE OF MICHIGAN
DEPARTMENT OF MANAGEMENT AND BUDGET
Office of Facilities

STATE OF MICHIGAN
DEPARTMENT OF NATURAL RESOURCES
APPROVED BY: *[Signature]* 11/6/79 DATE
CHIEF, PARKS DIVISION

SHEET
1 of 4

BRIGHTON RECREATION AREA - BISHOP LAKE PUMP STATION IMPROVEMENTS

L-128