

SURVEY & REMONUMENTATION

FEB 07 2001

2000 ALCONA COUNTY REMONUMENTATION CORNER

LAND CORNER RECORDATION CERTIFICATE Filing Requirement of Act 74, Mich. P.A. 1970

SECTION

For corners in

Alcona
(County)

Located in:

Corner Code #

1. Public Land Survey

T 26NR 7E

A-3, Millen Twp. ✓

T 26NR 6E

M-3, Millen Twp.

T R

T R

2. Property Controlling
in Section

S

T R

S

T R

3. Miscellaneous
Property in Sec.

S

T R

S

T R

Alcona County
Remonumentation

Liber 2 Page 82

Filed for Record in
ALCONA COUNTY MICHIGAN
DORIS A GAUTHIER
On 09-20-2000 At 09:42 am.
LAND CORNER 9.00

Register of Deeds Stamp & File Number

4. Lot No. _____, Recorded Plat _____

5. Private Claims _____

I, Thomas L. Fabis, in a field survey on Sept. 8, 2000 do hereby state that under requirements of P.A. 74, Michigan P.A. of 1970, the corner points mentioned in lines 1 and 2 above were in conformance with regulations and rules therefore as required in the current manual of survey instructions of the United States Department of the Interior, Bureau of Land Management or by a decree of a Court of Law and/or that the corner points mentioned in lines 3, 4 and 5 above were in conformance with the rules of the Michigan Board of Land Surveyors or by a Decree of a Court of Law, established, re-established, monumented, recovered, found as expressed below:

NOTE: Not more than 2 corners, all in the same town and range, may be recorded on this certificate.

T26N-R7E

| | A | B | C | D | E | F | G | H | I | J | K | L | M |
|----|----|---|---|----|---|---|----|---|---|----|---|----|----|
| 1 | | | | | | | | | | | | | |
| 2 | 6 | | | 5 | | | 4 | | | 3 | | 2 | 1 |
| 3 | | | | | | | | | | | | | |
| 4 | 7 | | | 8 | | | 9 | | | 10 | | 11 | 12 |
| 5 | | | | | | | | | | | | | |
| 6 | 18 | | | 17 | | | 16 | | | 15 | | 14 | 13 |
| 7 | | | | | | | | | | | | | |
| 8 | 19 | | | 20 | | | 21 | | | 22 | | 23 | 24 |
| 9 | | | | | | | | | | | | | |
| 10 | 30 | | | 29 | | | 28 | | | 27 | | 26 | 25 |
| 11 | | | | | | | | | | | | | |
| 12 | 31 | | | 32 | | | 33 | | | 34 | | 35 | 36 |
| 13 | | | | | | | | | | | | | |

A. Description of original monument and accessories and/or subsequent restoration:

- 1838: G.L.O. Survey Lewis Clason set post & referenced: Y. Pine 18 S19W 40, W. Pine 24 N36W 57
- 1908: County Survey Edw. Chapelle visits corner from the West.
- 1977: L.C.R.C. Liber 1 Page 48 John Oliver Fnd. 1/2" Iron Pipe & referenced.
- 1990, 1991, & 1993: R.S.Scott Surveys L.244 P.119-123 & L.271 P.102-104 by David Guthrie Ex. 3/4" Iron Pipe & referenced.
- 1997: U.S.D.A. Forest Service Survey L.314 P.129-130 and L.C.R.C. L.2 P.61 by Robert Mitchell Fnd. 3/4" iron pipe and replaced with 2 1/2"x30" galv. iron pipe w/3" brass cap and referenced.

B. Description of corner evidence found and/or method applied in restoring or reestablishing corner:

- 2000: Found Forest Service Brass Cap 1' West of centerline of N-S (gravel surface) O'Donnell Road. Found blazed trees with spikes with tags #28417: N22W 13" Oak 85.49, N45E 12" Oak 40.53, S24E 6" Oak 77.16, S50W 11" R. Pine 108.89

The position of this corner is compatible with Federal, county and local surveys and is accepted as a careful and faithful perpetuation of the position of the original corner.

C. Description of monument for corner and accessories established to perpetuate locating the position of the corner:


- 2000: Existing Forest Service Brass Cap over iron pipe. Witnesses are blazed trees with spikes w/tags #28417:
13" Oak N22W 85.49
12" Oak N45E 40.53
6" Oak S24E 77.16
11" R. Pine S50W 108.89

APPROVED LAND CORNER
P A 345 of 1990
ALCONA COUNTY
Date 8-28-2000
County Rep. [Signature]

Signed by

Thomas L. Fabis

Surveyor's Michigan License No. 31591

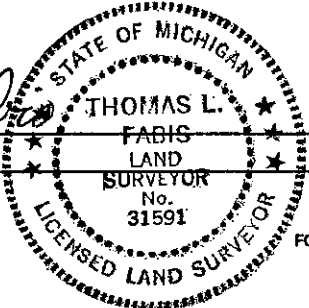

Date September 12, 2000